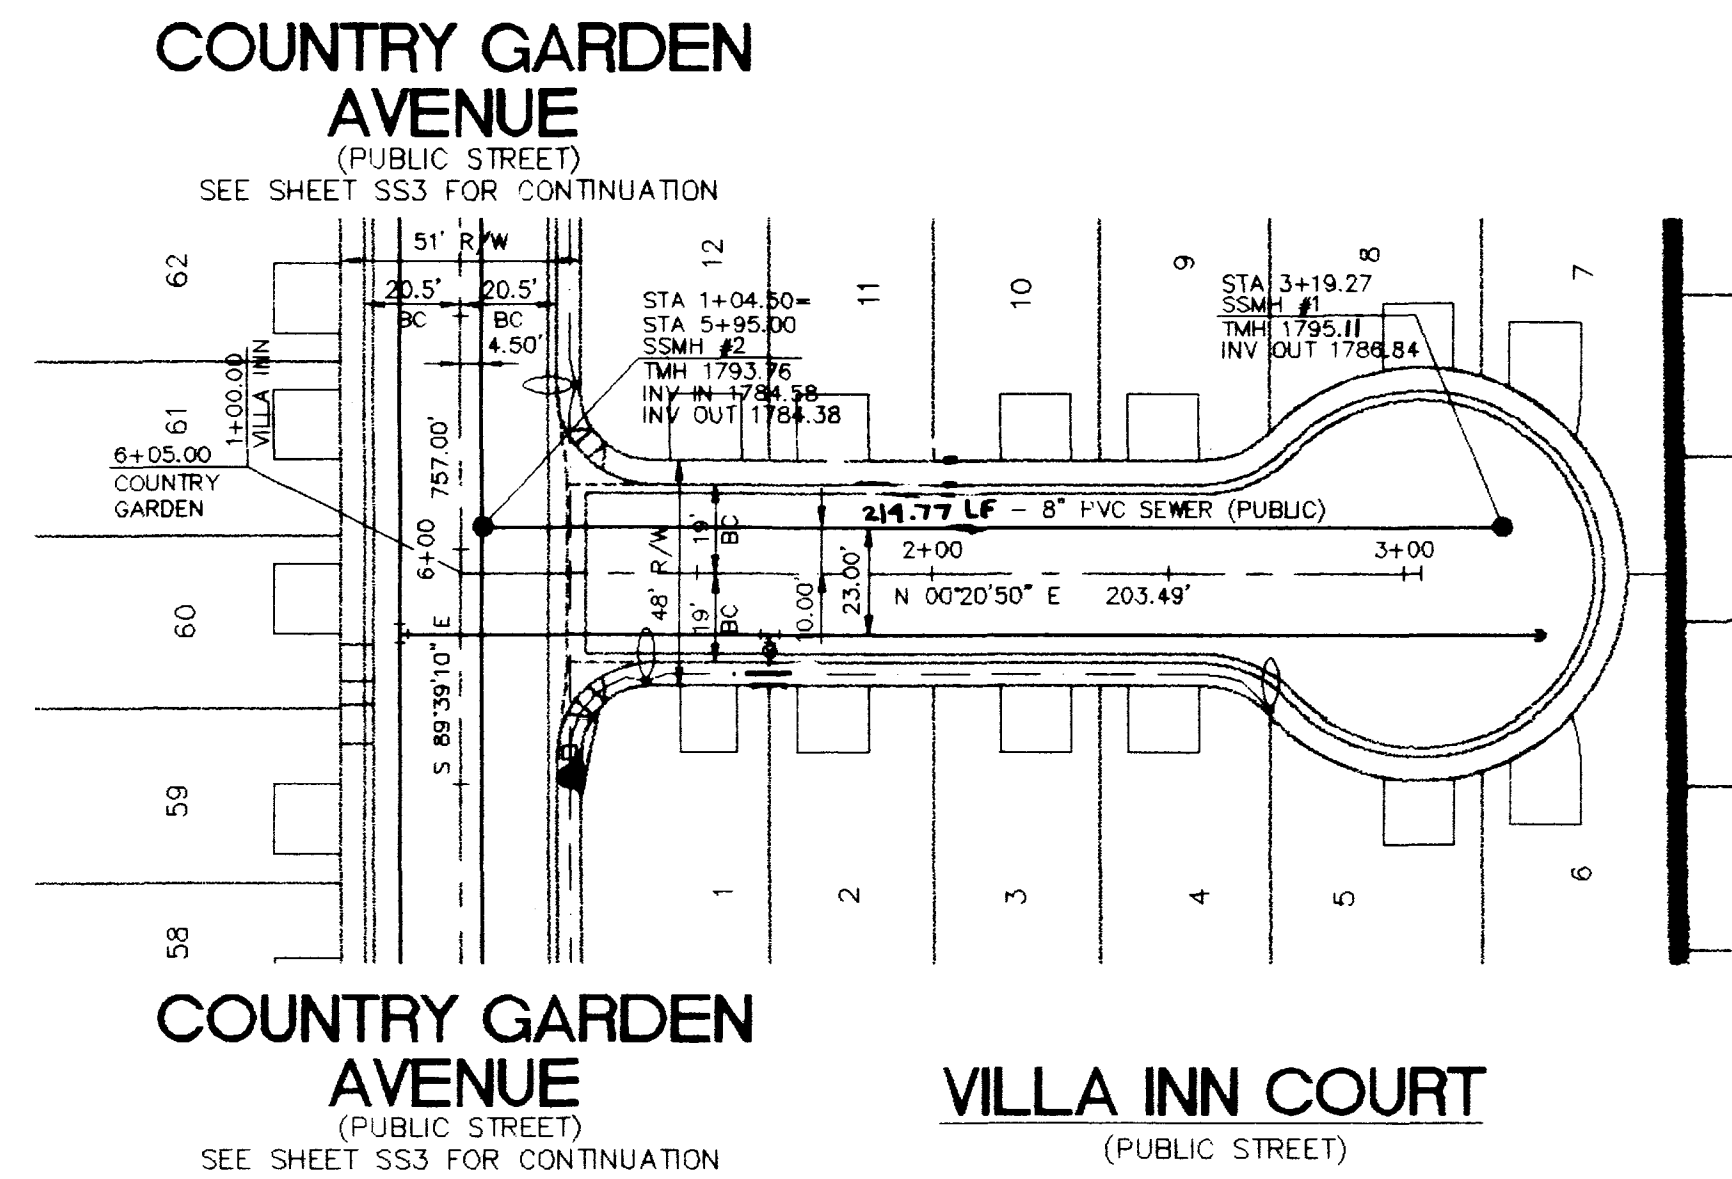
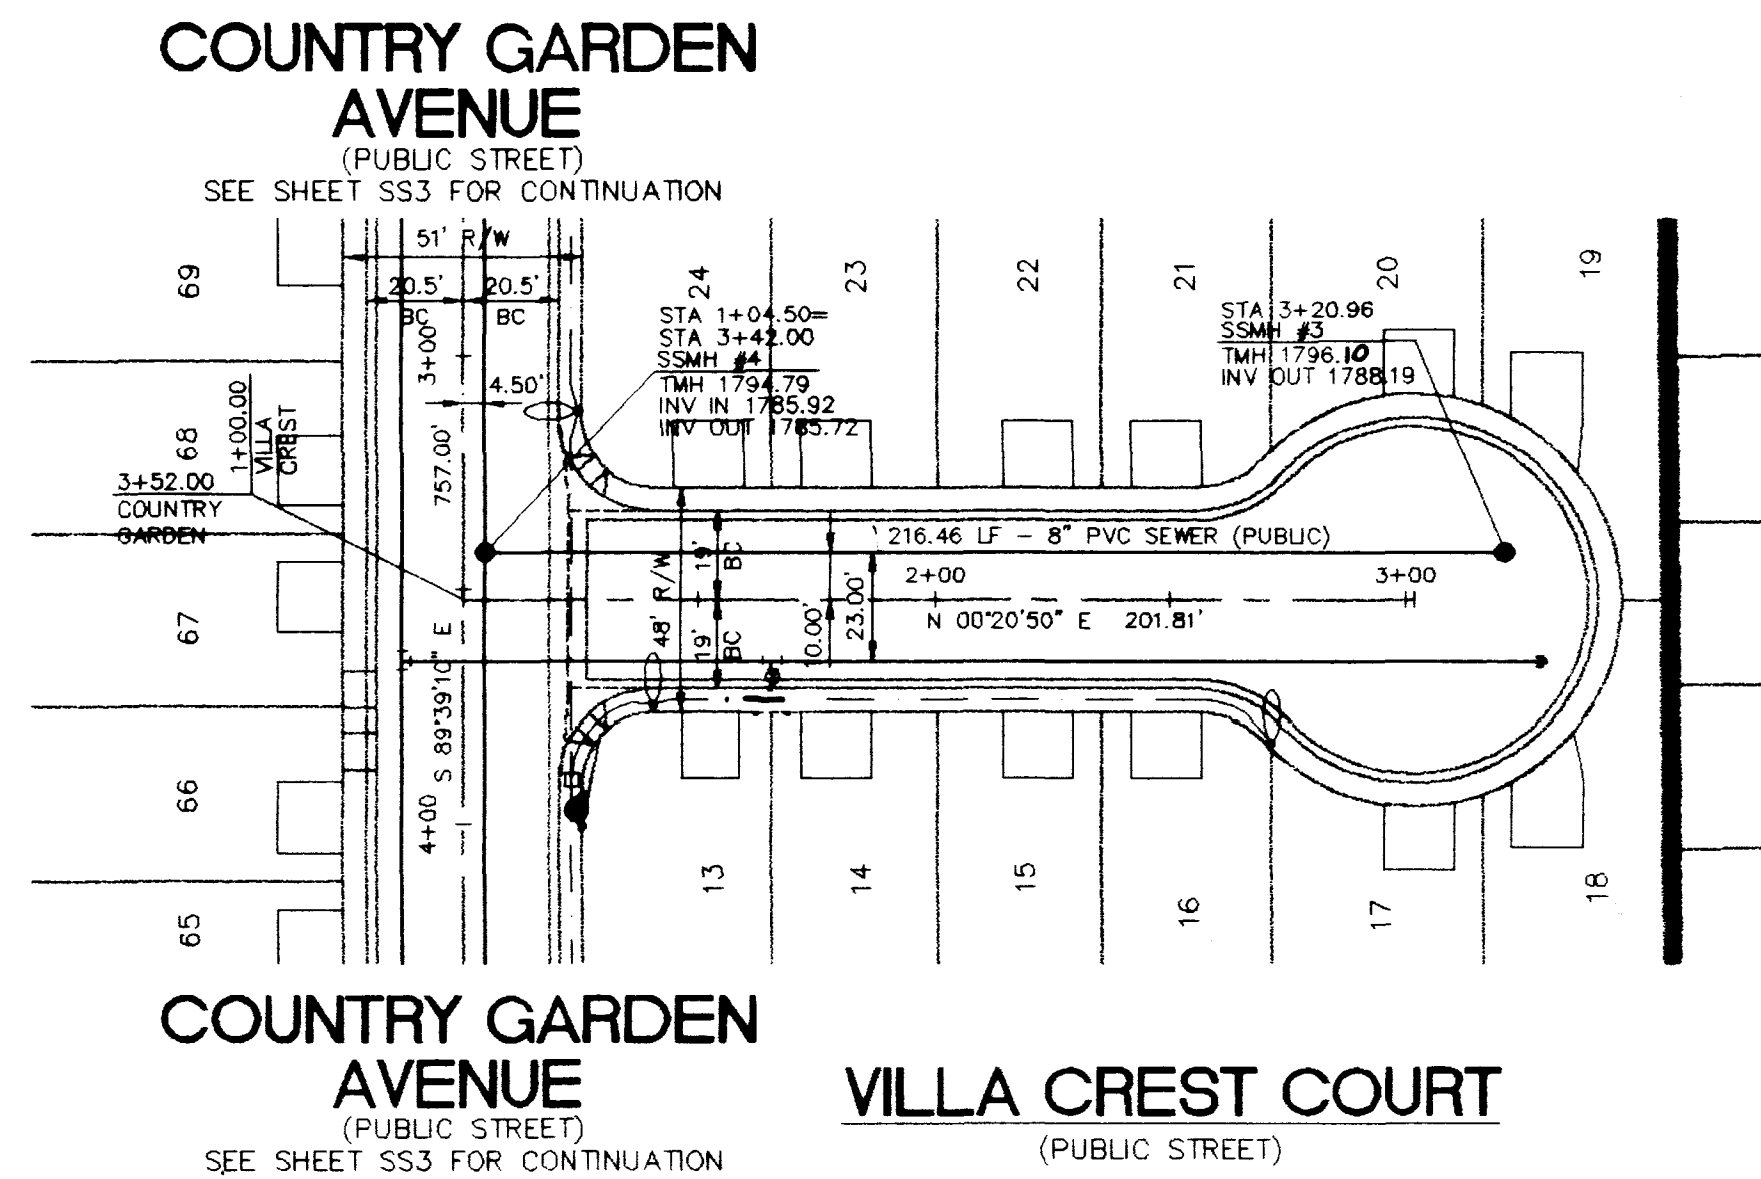





BASIS OF BEARINGS

BEING THE SOUTH LINE OF THE SOUTHEAST QUARTER (SE 1/4) OF THE NORTHEAST QUARTER (NE 1/4) OF SECTION 30, T.20S., R.62E., M.D.M., CITY OF LAS VEGAS, CLARK COUNTY, NEVADA. SAID LINE BEARS N. 89°53'26" E.

BENCHMARK

NORTH AMERICAN VERTICAL DATUM 1988 (NAVD88)
B.M. NO. 14 STATION 2LVO2 3056
FOUND RIVET AND SQUARE ALUMINUM PLATE IN TOP OF CURB, IN THE SOUTHWEST CORNER OF SANDHILL RD. AND HARRIS AVE.

ELEVATION = 1785.134 FEET
544.8623 METERS

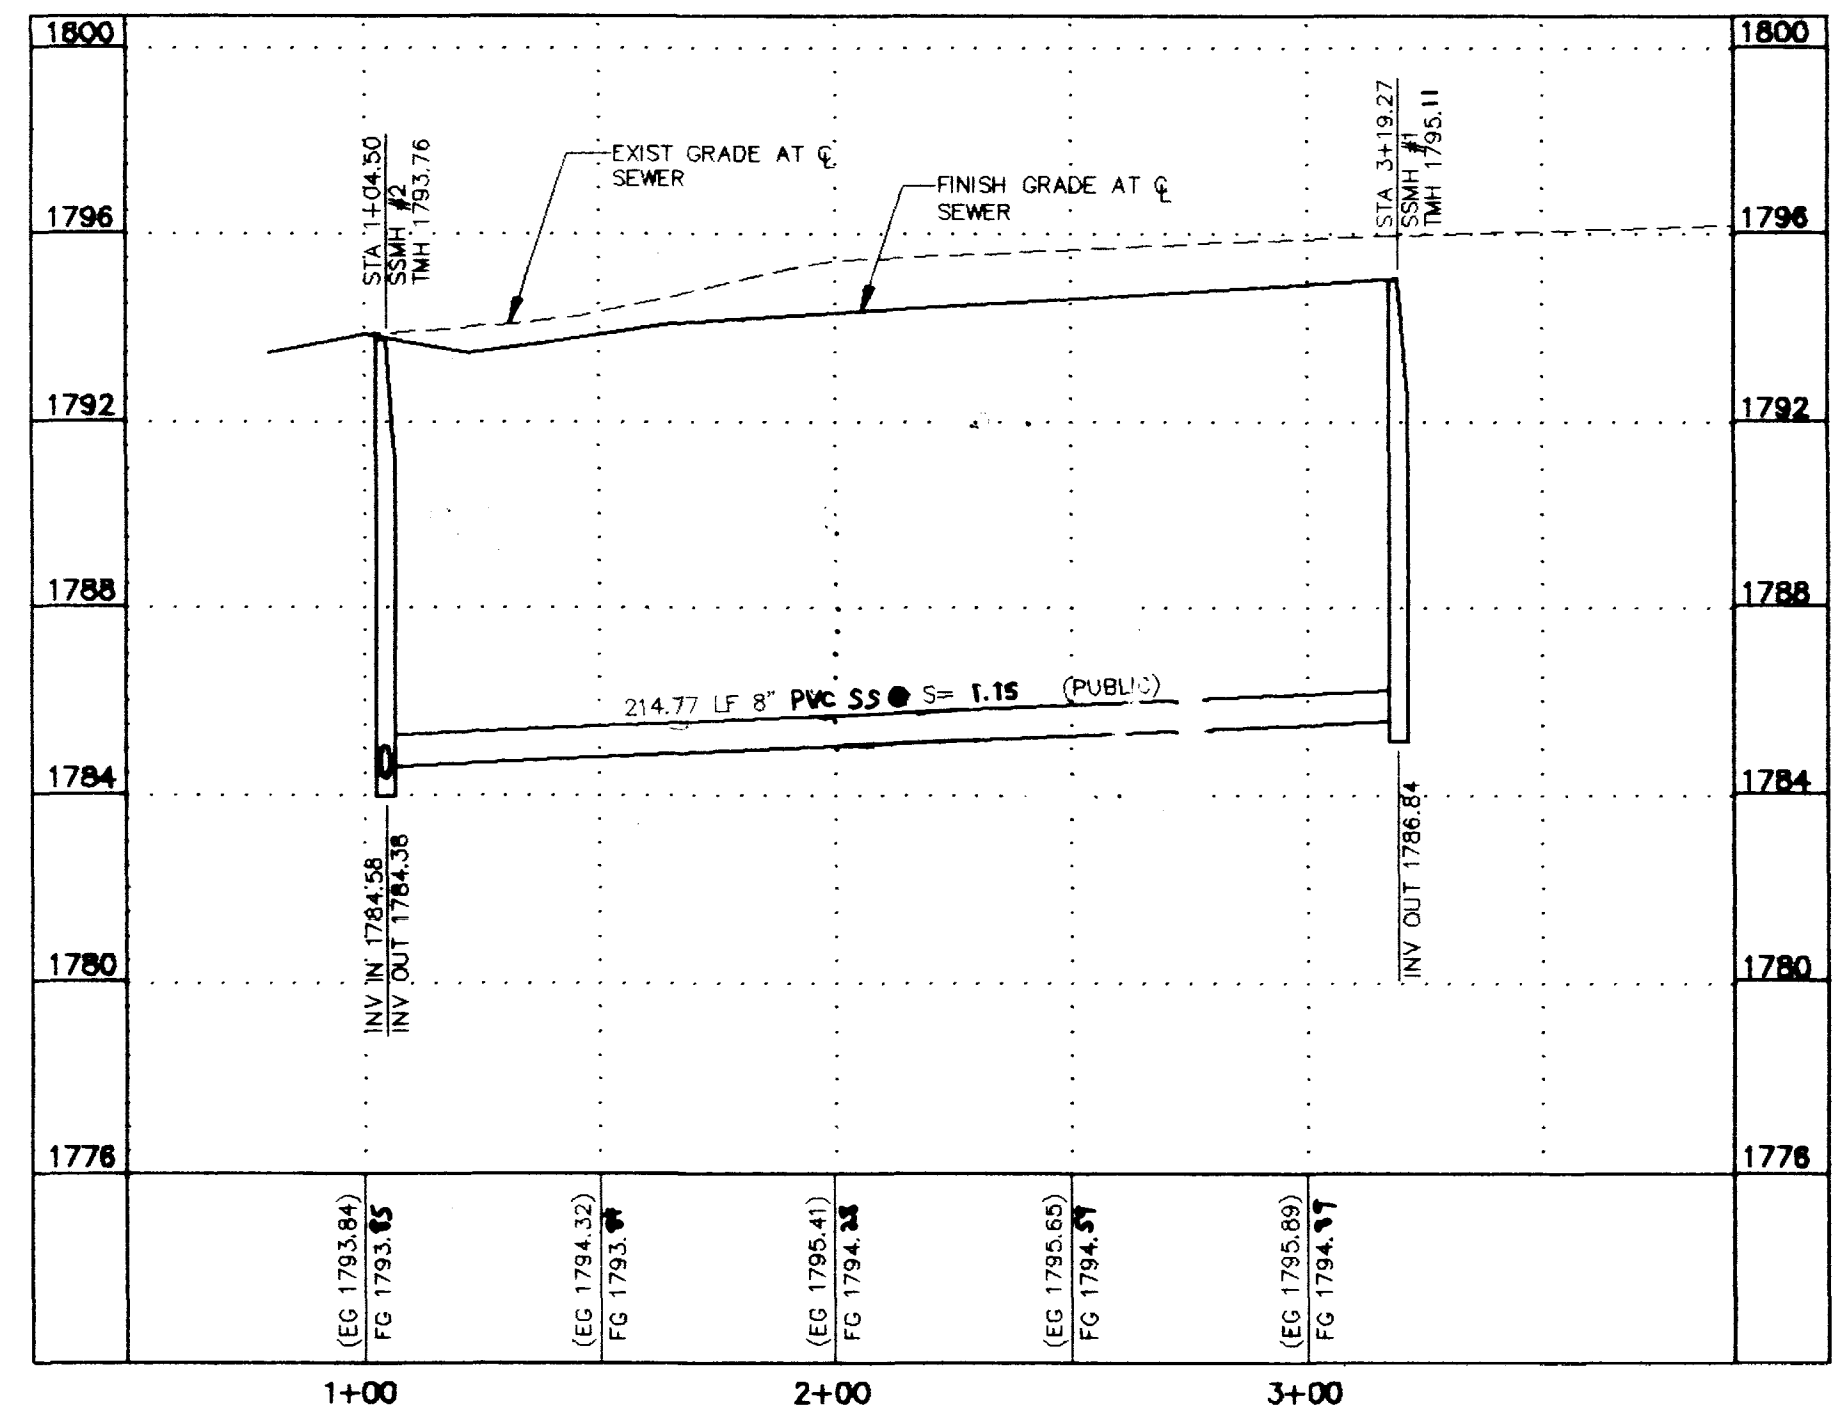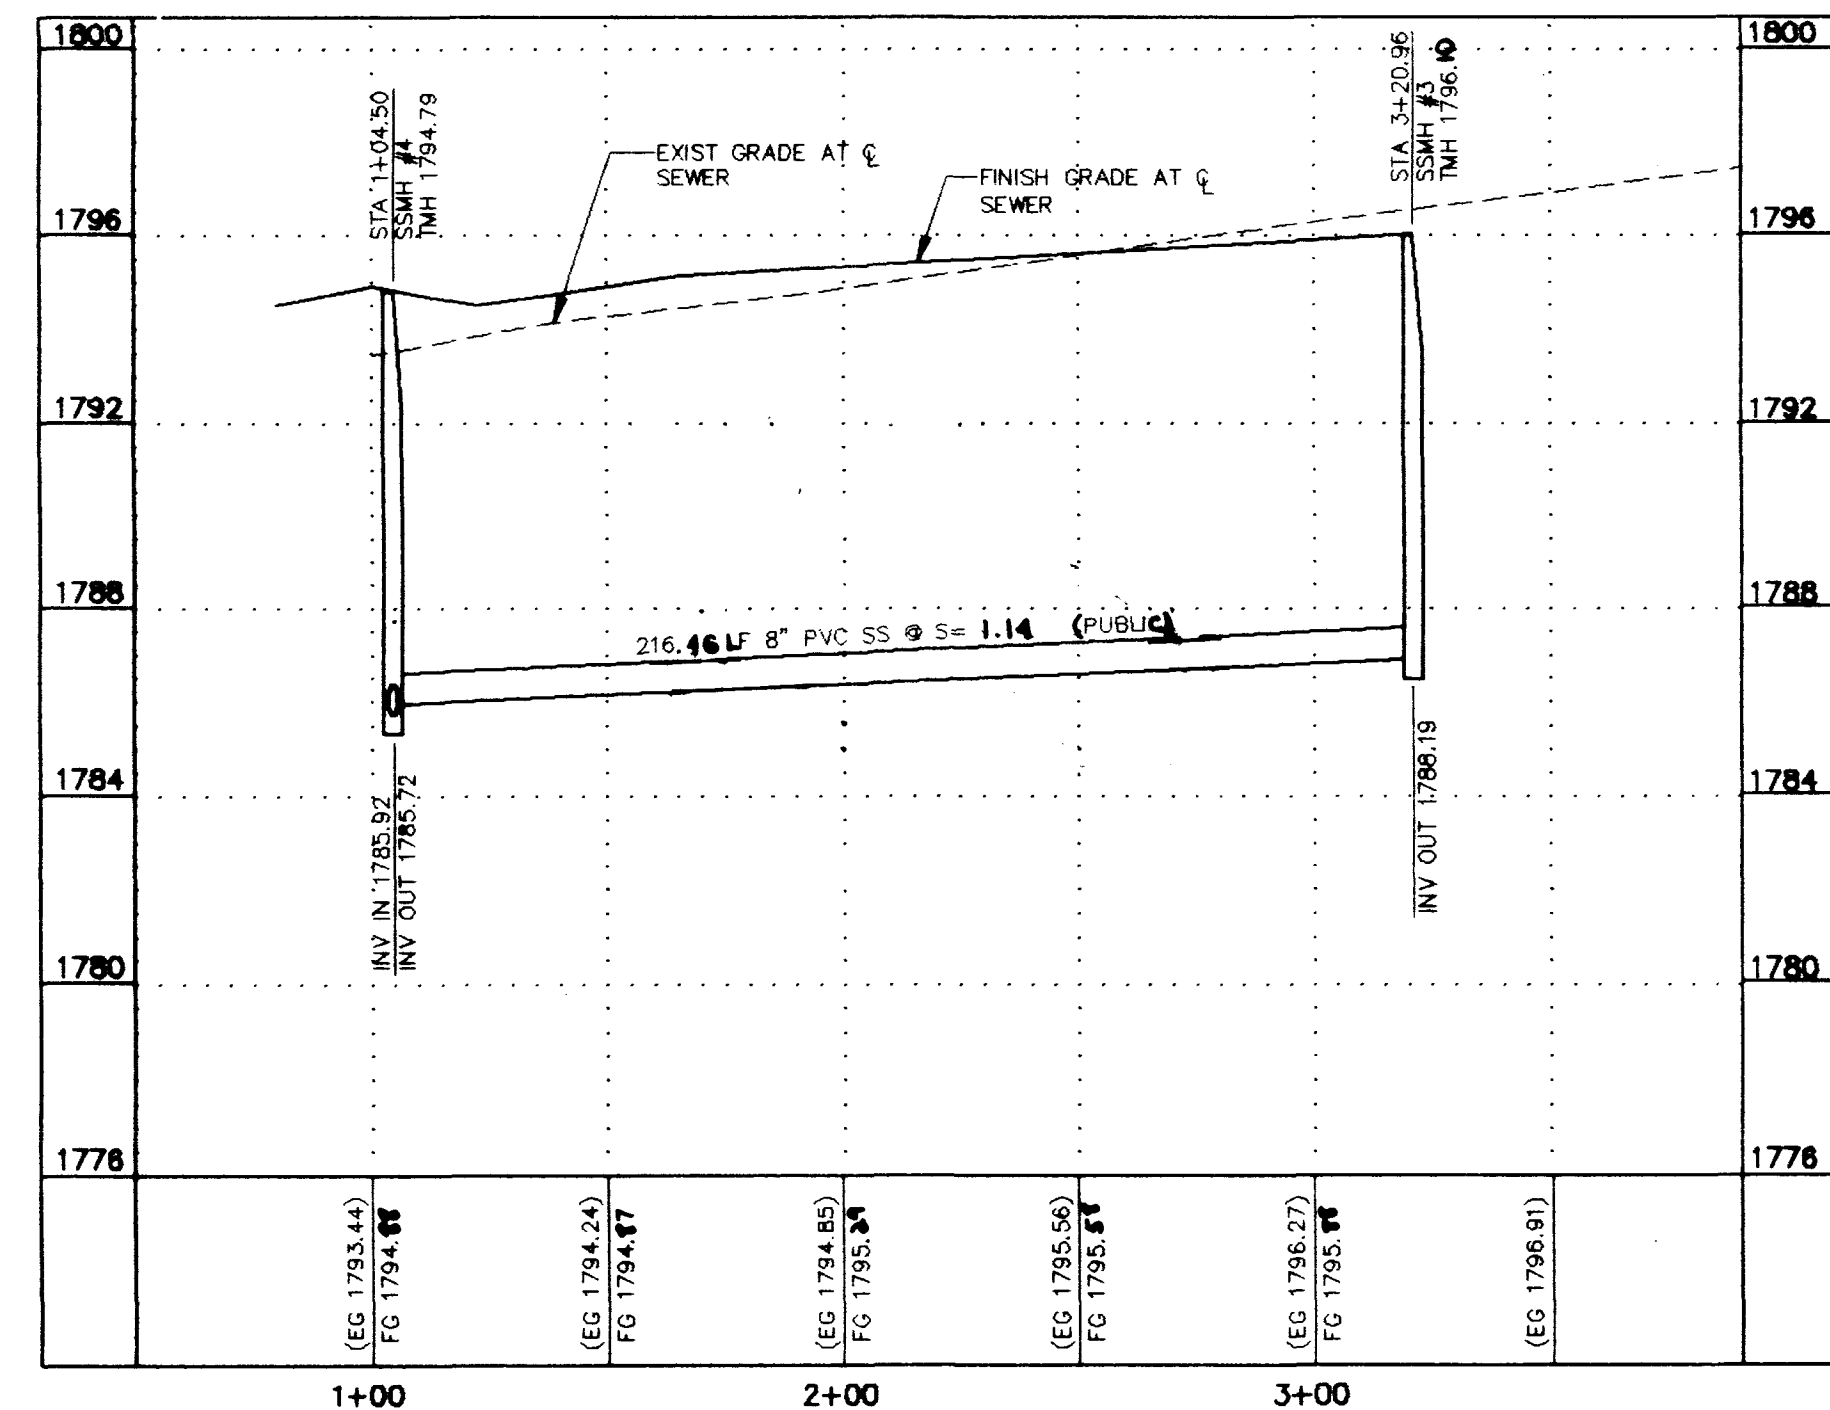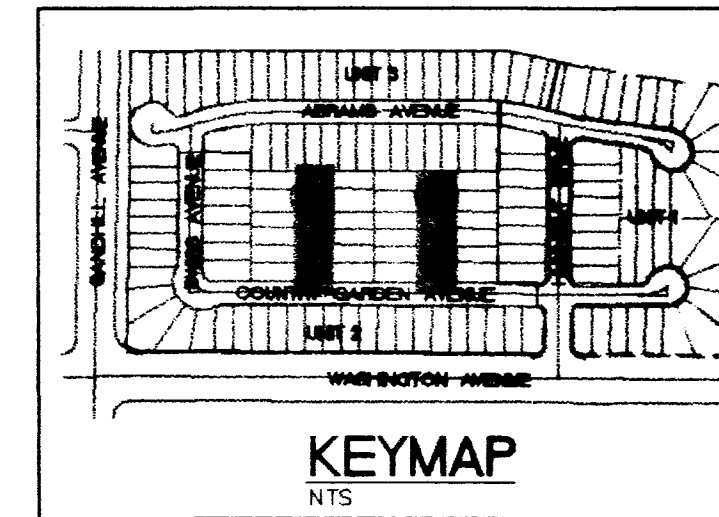

DISCLAIMER NOTE

UTILITY LOCATIONS SHOWN HEREON ARE APPROXIMATE ONLY. IT SHALL BE THE CONTRACTOR'S RESPONSIBILITY TO DETERMINE THE EXACT HORIZONTAL AND VERTICAL LOCATION OF ALL EXISTING UNDERGROUND OR OVERHEAD UTILITIES PRIOR TO COMMENCING CONSTRUCTION. NO REPRESENTATION IS MADE THAT ALL EXISTING UTILITIES ARE SHOWN HEREON. THE ENGINEER ASSUMES NO RESPONSIBILITY FOR UTILITIES NOT SHOWN OR UTILITIES NOT SHOWN IN THEIR PROPER LOCATION.

Avoid cutting underground utility lines. If's costly.
Call before you Dig
1-800-227-2600
UNDERGROUND SERVICE (USA)

Avoid overhead power line contact.
Call before you Overhead
1-702-593-6111
Nevada Power Corporation
(SEE SAFETY SERVICE INFORMATION)

HELLER DEVELOPMENT COMPANIES


CLARK COUNTY, NEVADA
84403 RESERVE BLVD
LAS VEGAS, NEVADA 89120
(702) 739-5921 FAX (702) 739-5929

ORION ENGINEERING AND SURVEYING, INC.
3088 E. SUNSET ROAD, SUITE 9
LAS VEGAS, NEVADA 89120
(702) 739-5921 FAX (702) 739-5929

VILLA CREST & VILLA INN
SEWER PLAN AND PROFILE
STA 1+00.00 TO 3+20.96

Washington & Sandhill - Unit 2

DRAWN BY: RGP
DESIGNED BY: RGP
CHECKED BY: MAB
PROJECT NO: 020-8601

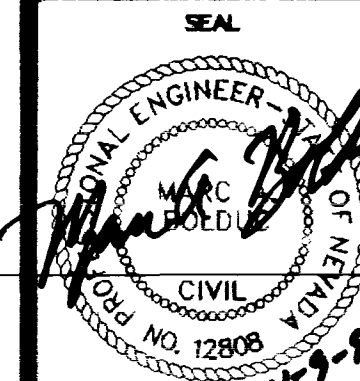

SHEET
SS2
OF 16 SHEETS
DRAWING NO.
307Y-4556-2

