
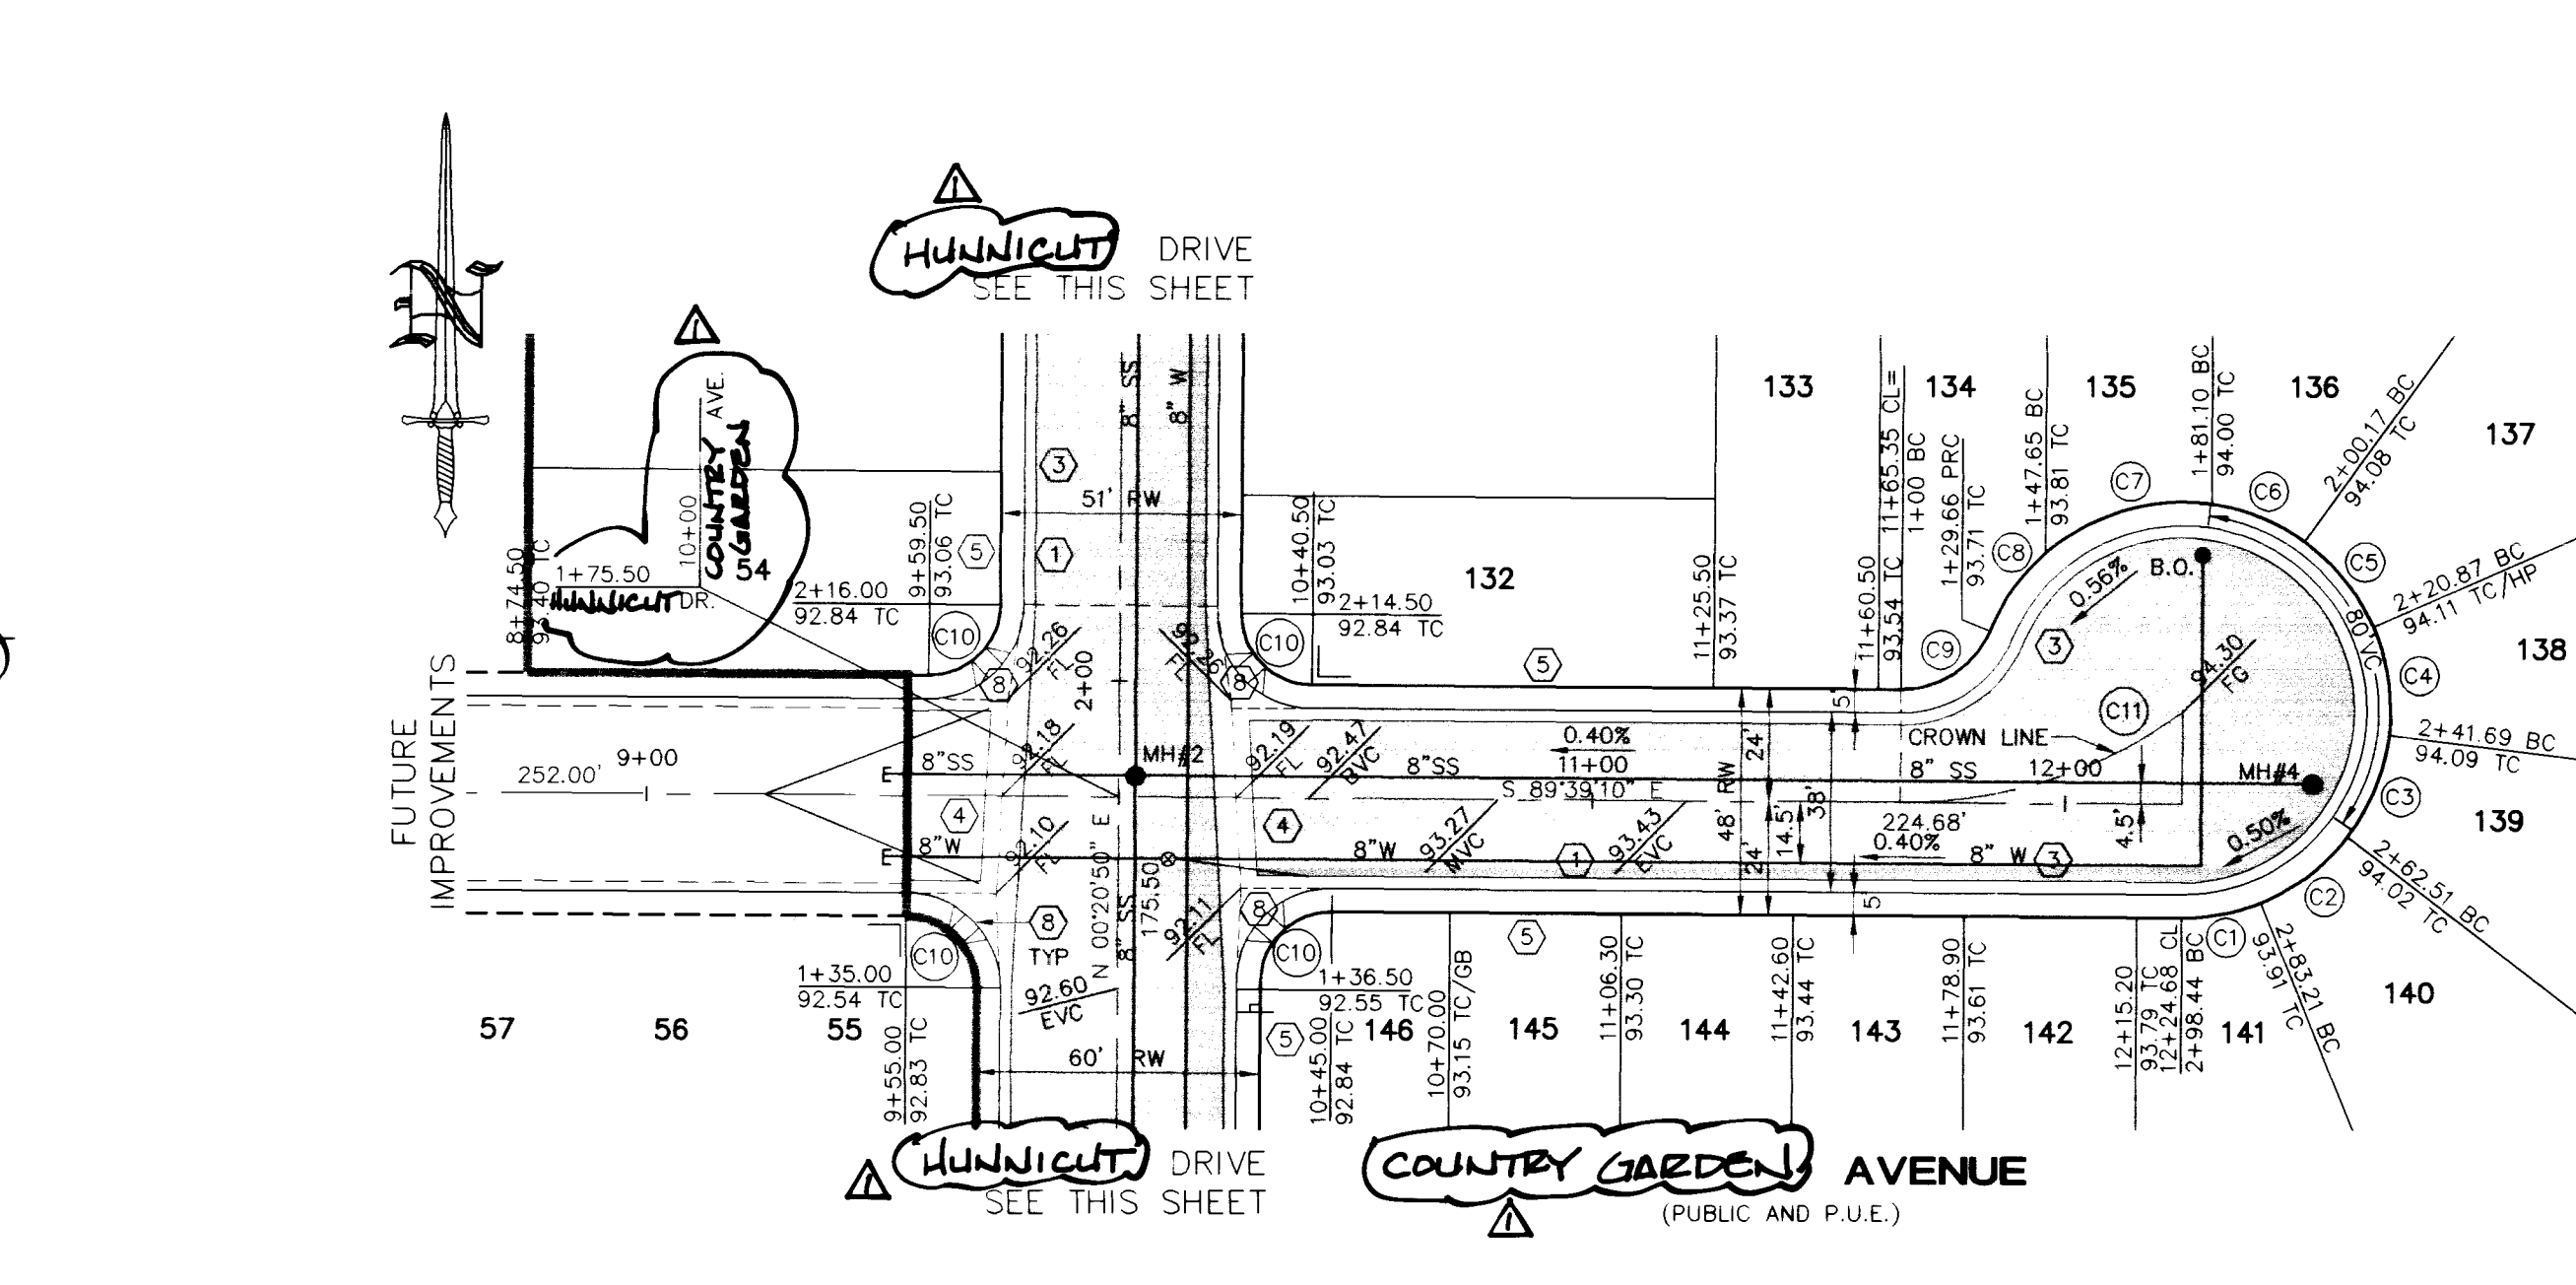
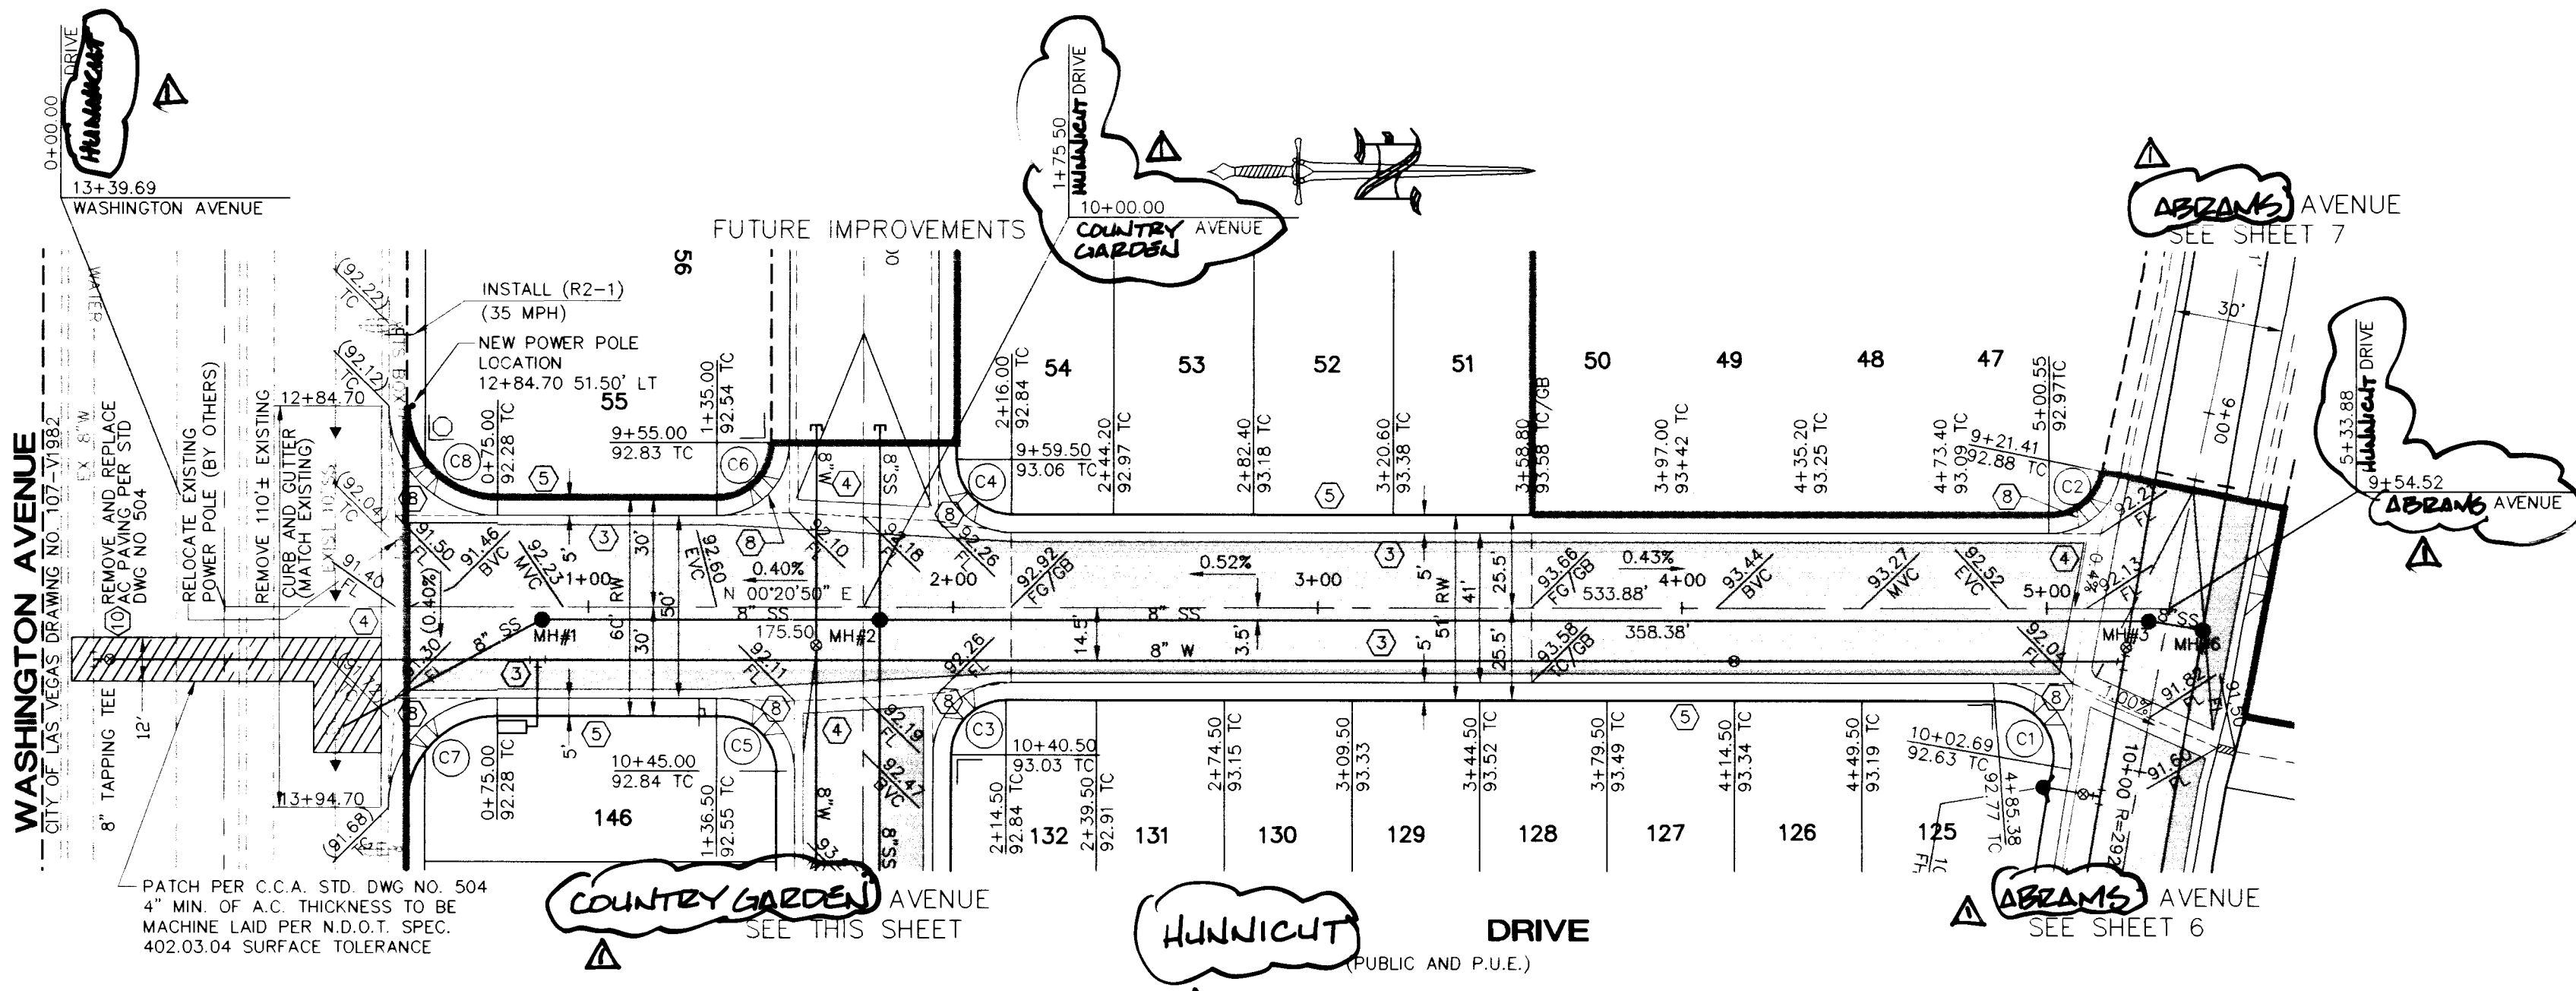
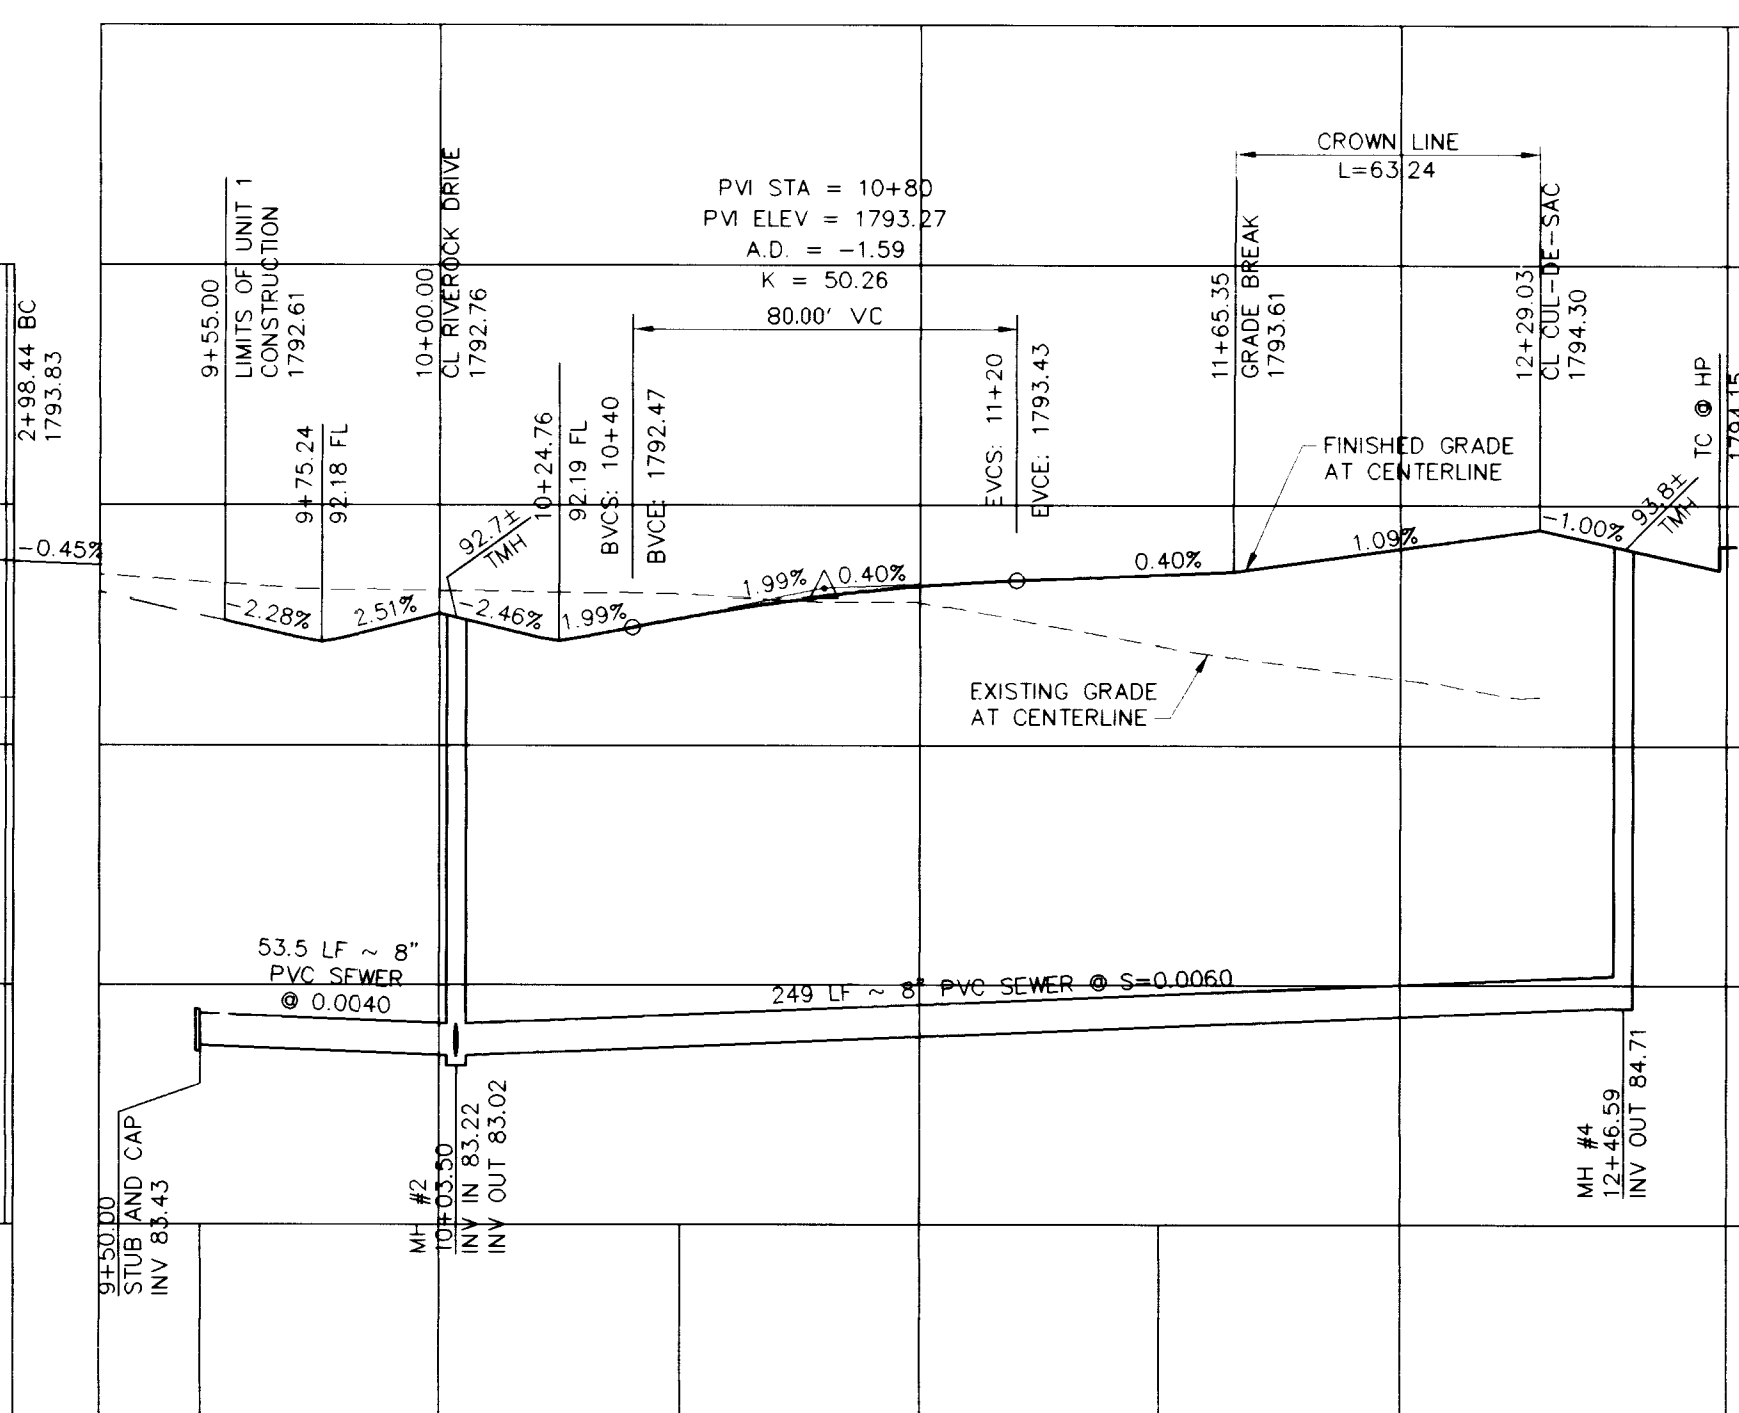
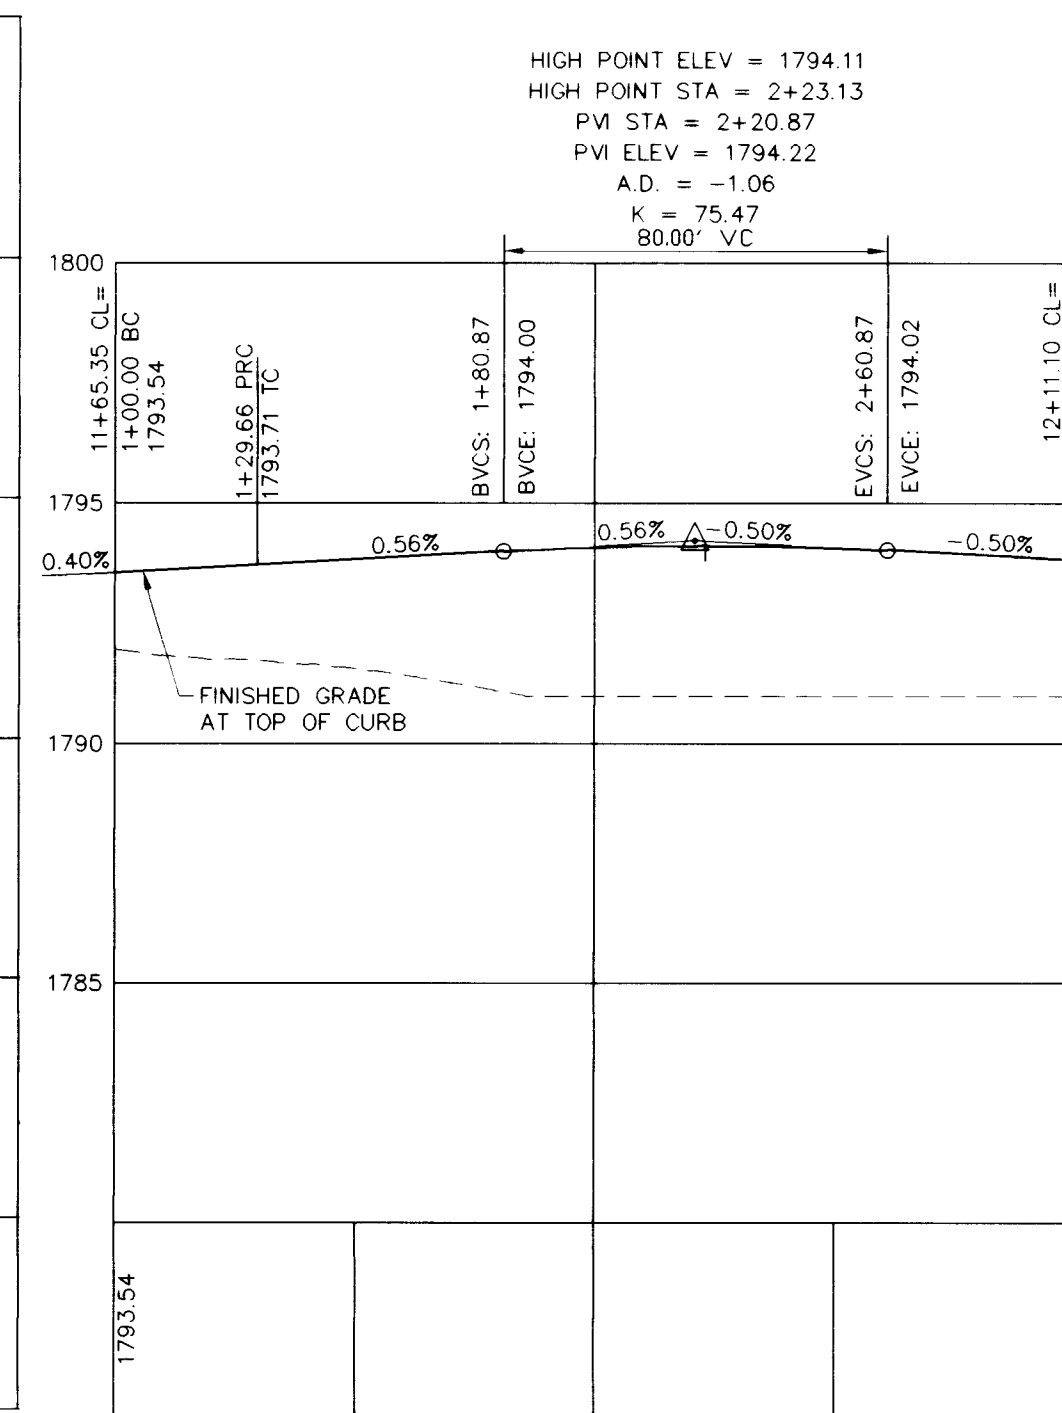


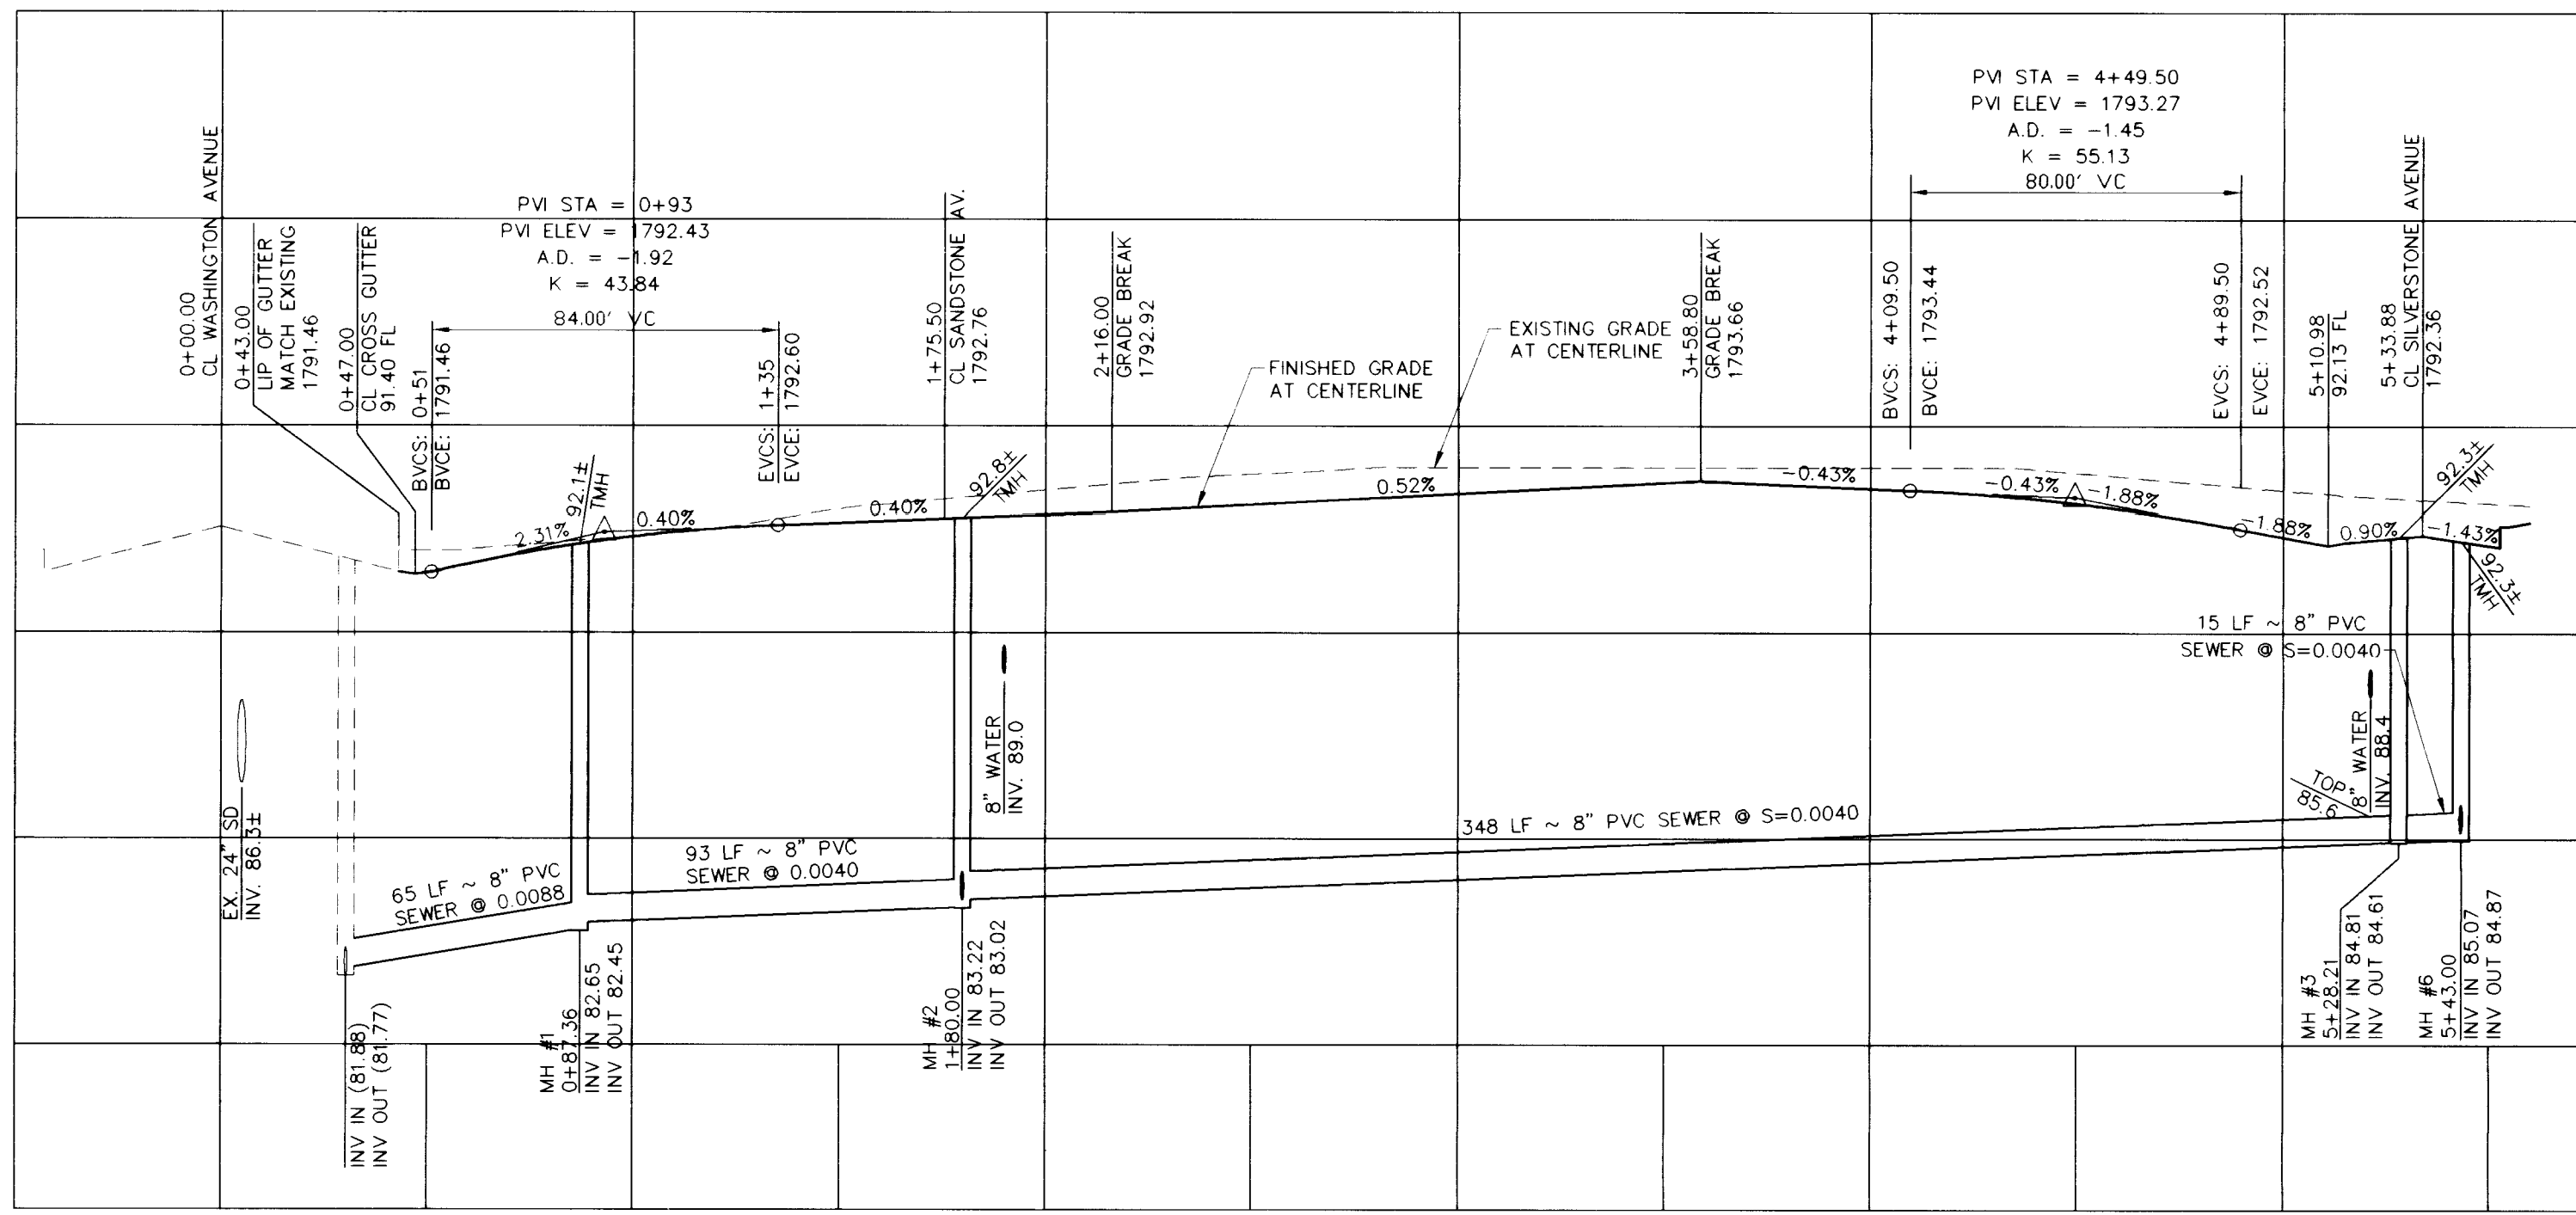

DISCLAIMER NOTE

UTILITY LOCATIONS SHOWN HEREON ARE APPROXIMATE ONLY. IT SHALL BE THE CONTRACTOR'S RESPONSIBILITY TO DETERMINE THE EXACT HORIZONTAL AND VERTICAL LOCATION OF ALL EXISTING UNDERGROUND OR OVERHEAD UTILITIES PRIOR TO COMMENCING CONSTRUCTION. NO REPRESENTATION IS MADE THAT ALL EXISTING UTILITIES ARE SHOWN HEREON. THE ENGINEER ASSUMES NO RESPONSIBILITY FOR UTILITIES NOT SHOWN OR UTILITIES NOT SHOWN IN THEIR PROPER LOCATION.

Call before you Dig
1-800-227-2600
UNDERGROUND SERVICE (USA)


Call before you Overhead
1-702-593-6111
AND SAFETY SERVICES DEPARTMENT

BACK OF CURB DATA

CURVE	RADIUS	LENGTH	TANGENT	DELTA
C1	20.00'	34.84'	23.75'	99°48'36"
C2	20.00'	27.44'	16.37'	78°35'45"
C3	20.00'	31.42'	20.00'	90°00'00"
C4	20.00'	31.42'	20.00'	90°00'00"
C5	20.00'	31.42'	20.00'	90°00'00"
C6	20.00'	31.42'	20.00'	90°00'00"
C7	30.00'	47.12'	30.00'	90°00'00"
C8	30.00'	47.12'	30.00'	90°00'00"


CONSTRUCTION NOTES

- CONSTRUCT 2" AC PAVEMENT OVER 12" GRAVEL BASE
- CONSTRUCT 3" AC PAVEMENT OVER 14" GRAVEL BASE
- CONSTRUCT ROLL CURB AND GUTTER PER STD. DWG #217A
- 8" CROSS GUTTER PER STD. DWG #228
- CONSTRUCT 5' SIDEWALK PER STD. DWG #234
- CONSTRUCT SIDEWALK RAMP PER STD. DWG # 235, CASE 1, A=8 AND B=8
- CONSTRUCT INTERURB GRASS ACCESS ROAD PER STD. DWG #209
- 6" TYPE II OVER 6" TYPE I AGGREGATE BASE
- 4" MIN. AC. MUST BE MACHINE LAID ACCORDANCE TO SURFACE TOLERANCE ON NDOT SPEC 402.03.04.

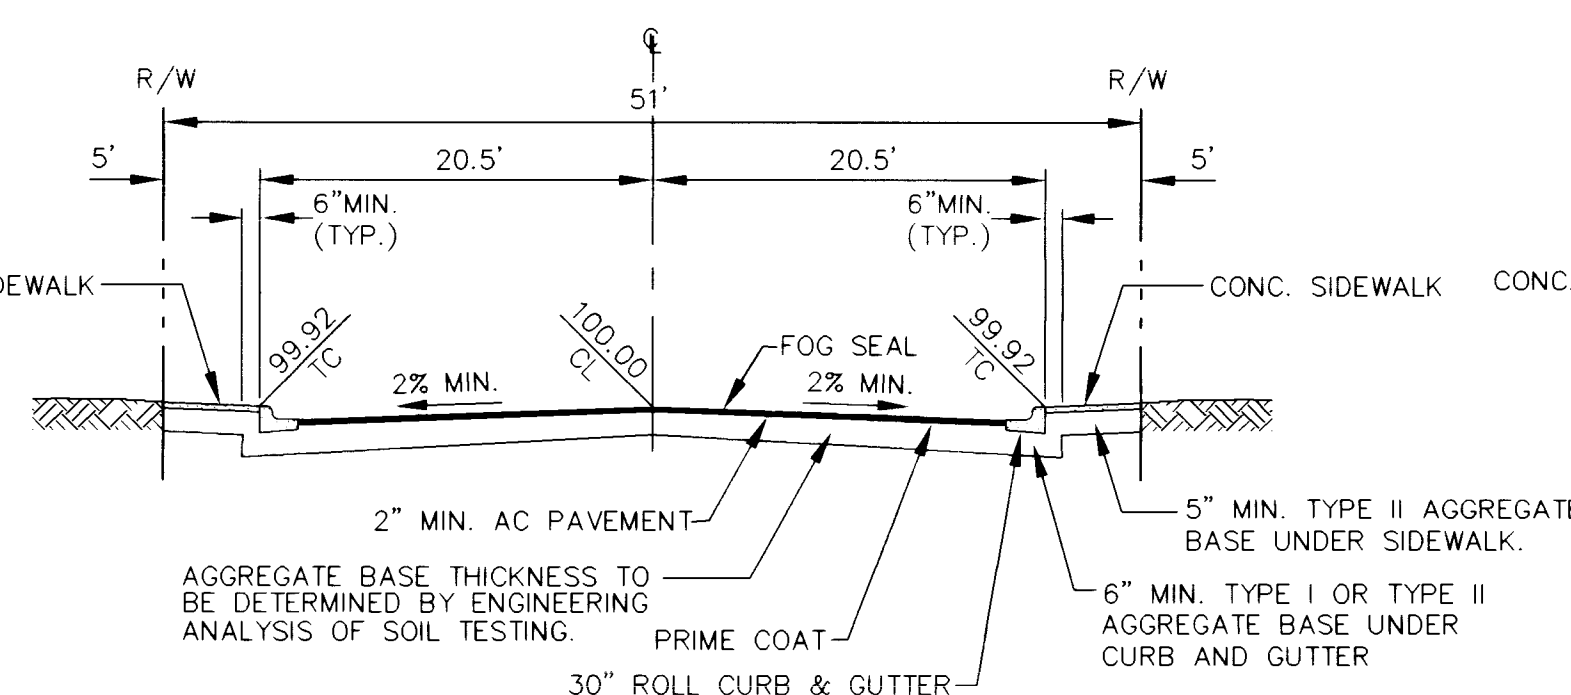

51' TYPICAL STREET SECTION

NO SCALE

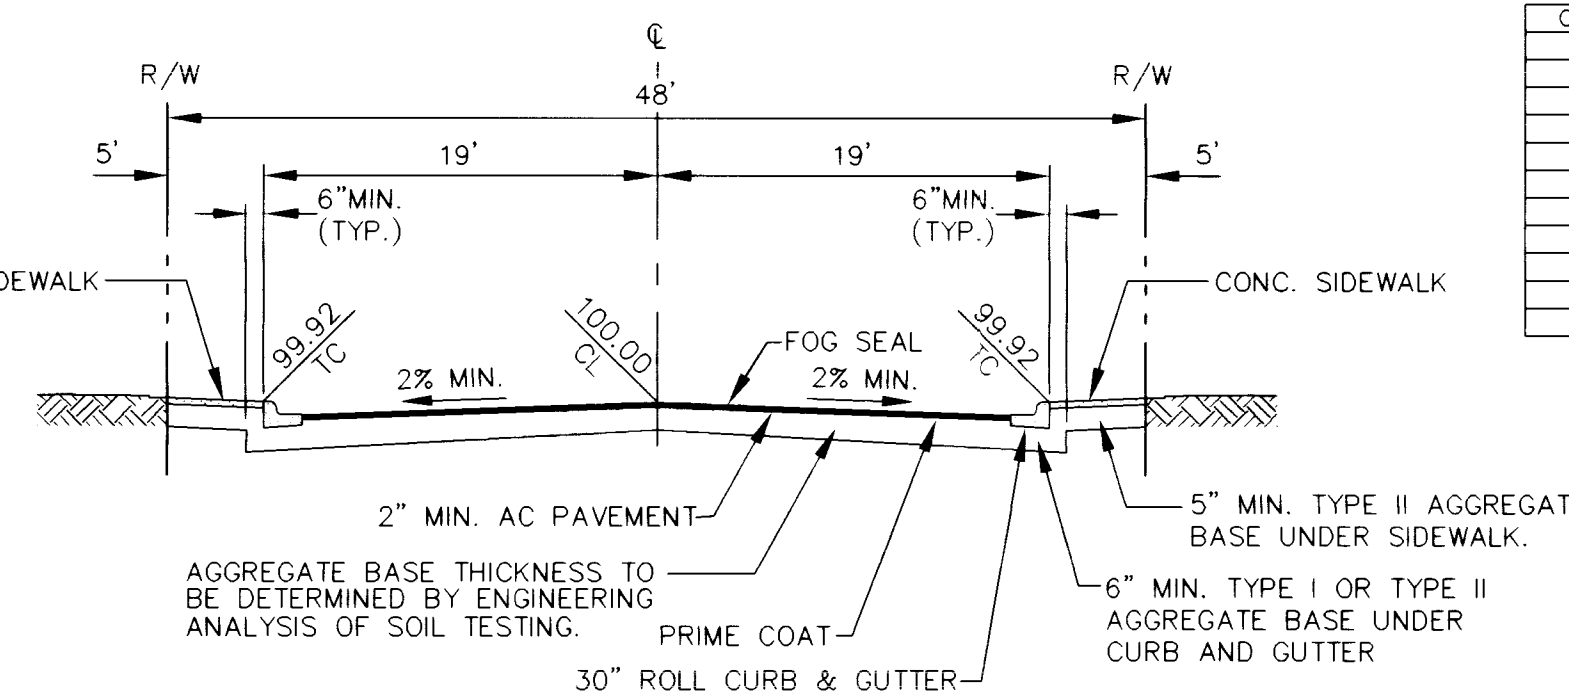

48' TYPICAL STREET SECTION


NO SCALE

BACK OF CURB DATA

CURVE	RADIUS	LENGTH	TANGENT	DELTA
C1	39.00'	15.23'	7.71'	22°22'23"
C2	39.00'	20.70'	10.60'	30°25'03"
C3	39.00'	20.82'	10.66'	30°35'10"
C4	39.00'	20.82'	10.66'	30°35'10"
C5	39.00'	20.70'	10.60'	30°25'03"
C6	39.00'	19.07'	9.73'	28°00'59"
C7	39.00'	33.45'	17.83'	49°08'35"
C8	39.00'	17.99'	9.16'	26°26'09"
C9	25.00'	29.66'	16.86'	67°58'32"
C10	20.00'	31.42'	20.00'	90°00'00"
C11	100.00'	63.68'	32.96'	57°17'45"

BENCHMARK


(N.A.V.D. 88)
B.M. NO. 26 STATION 0020 2105WS
FOUND RIVET AND SQUARE ALUMINUM PLATE IN TOP
OF CURB, N NORTHEAST CORNER OF OWENS AVENUE
AND LAMB BOULEVARD, NEAR THE PC OF OWENS AVENUE
ELEVATION = 1792.13 (546.2440m) (NAVD88 DATUM)

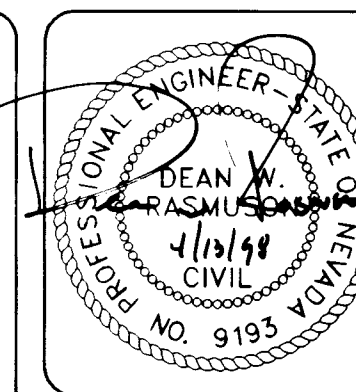






DESIGNED BY:	DRAWN BY:	DATE:
CHECKED BY:	JOB NUMBER: 020-6001	BY:
NO.	REVISION	DATE
40P	REVISE STREET NAMES PER TALL MAP	5/1/18

HUNNICUTT & COUNTRY GARDEN
WASHINGTON & SANDHILL
UNIT 1
REX & FRAN CALLAWAY FAMILY TRUST
CITY OF LAS VEGAS, NEVADA

ORION ENGINEERING AND SURVEYING, INC.
2700 CHANDLER AVENUE, SUITE B-1
LAS VEGAS, NEVADA 8920
(702) 739-5921 FAX (702) 739-5929

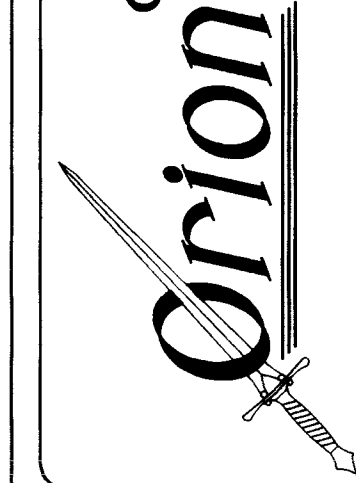

SHEET 5
of 9

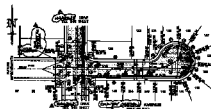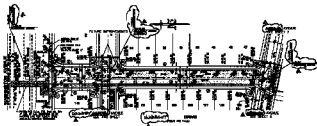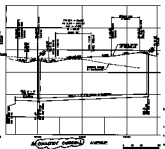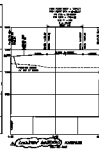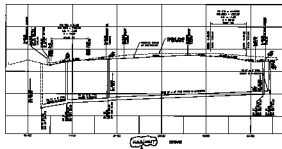












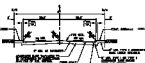

51' TYPICAL STREET SECTION

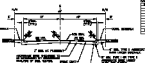

48' TYPICAL STREET SECTION







1	2	



Orion

