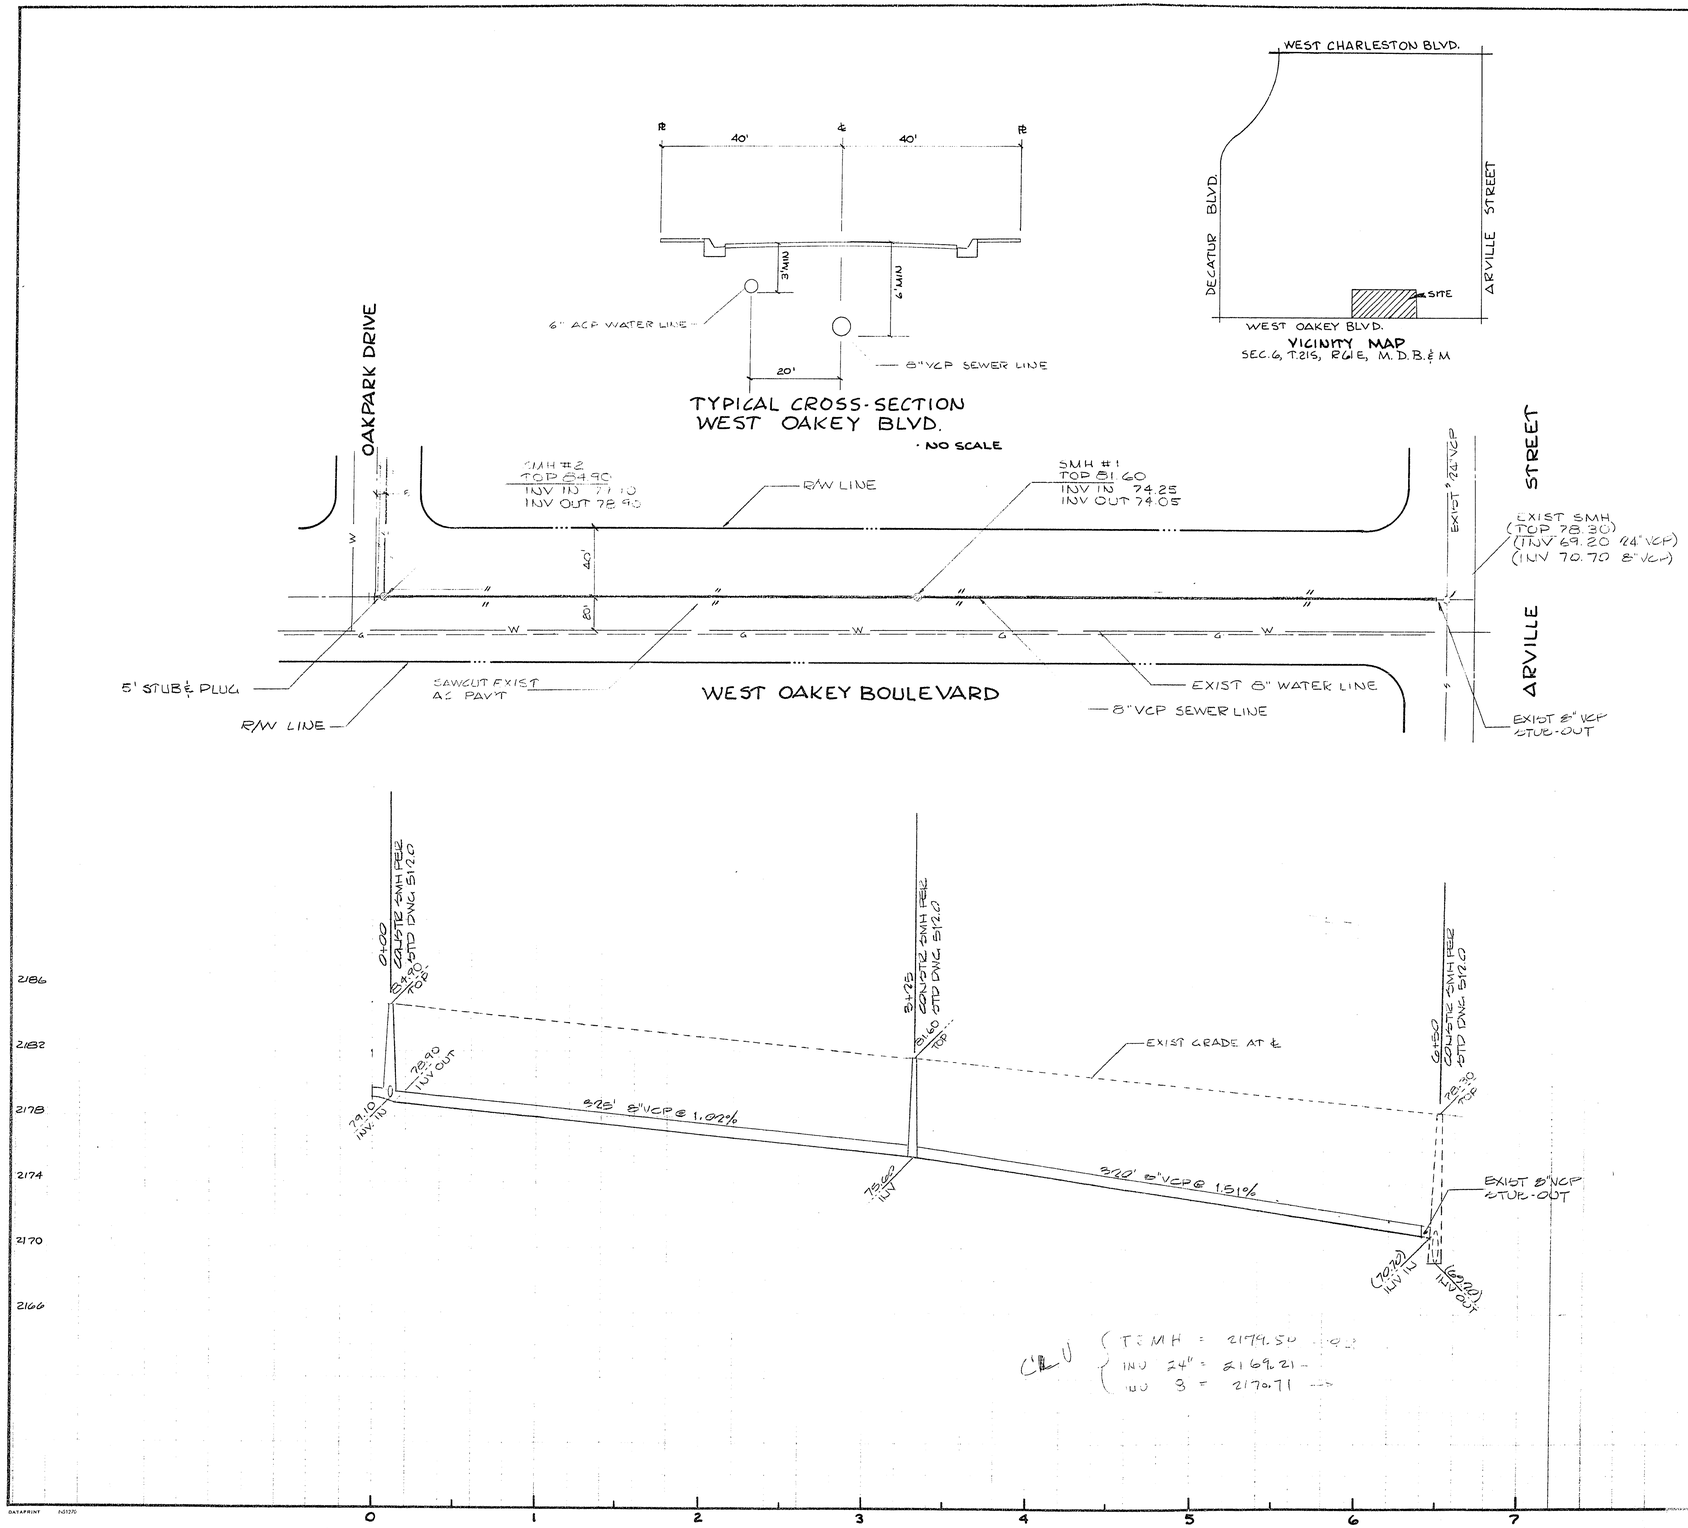

N

SCALE: HOR 1" = 40'
VERT 1" = 4'

ESTIMATED QUANTITIES

8" VCP SEWER LINE	650 LF
STANDARD MANHOLES	2 EA
STUB & CAP	1 EA

BENCH MARK

CLV BENCH MARK #161622 - BOLT & PLATE IN TOP OF CURB @ THE SOUTHWEST RETURN CORNER OF OAKEY BLVD. & BROCKWOOD DR. ELEVATION = 2181.93 C.C.E.D. DATUM

APPROVALS

CLV SANITATION ENGINEER	1-4-79 DATE
CLV QUALITY CONTROL ENGINEER	1-9-79 DATE
CLV FIELD OPERATIONS ENGINEER	1-9-79 DATE
CLV ENGINEER	1/10/79 DATE

12-26-78

DATE	NO.	REVISIONS	APP'D

PREPARED FOR: DELUXE OAKLEY

DATE OCTOBER 1978
DESIGN DTM
DRAWN DTM
CHECK RJB
SCALE H 1" = 40' V 1" = 4'

BALGHMAN & TURNER
CIVIL ENGINEERS MINING ENGINEERS
LAND SURVEYORS
2325 WEST CHARLESTON BOULEVARD
LAS VEGAS, NEVADA 89102
702 - 870-8271

SEWER DESIGN
WEST OAKEY BOULEVARD
SECTION 6, TOWNSHIP 21 SOUTH, RANGE 61 EAST M.D.B.&M.
CITY OF LAS VEGAS
WESTOAK PARK
NEVADA

SHEET 3 OF 3
PROJ. NO FB124 P8

DATAPRINT 1-01270

1074-32.79

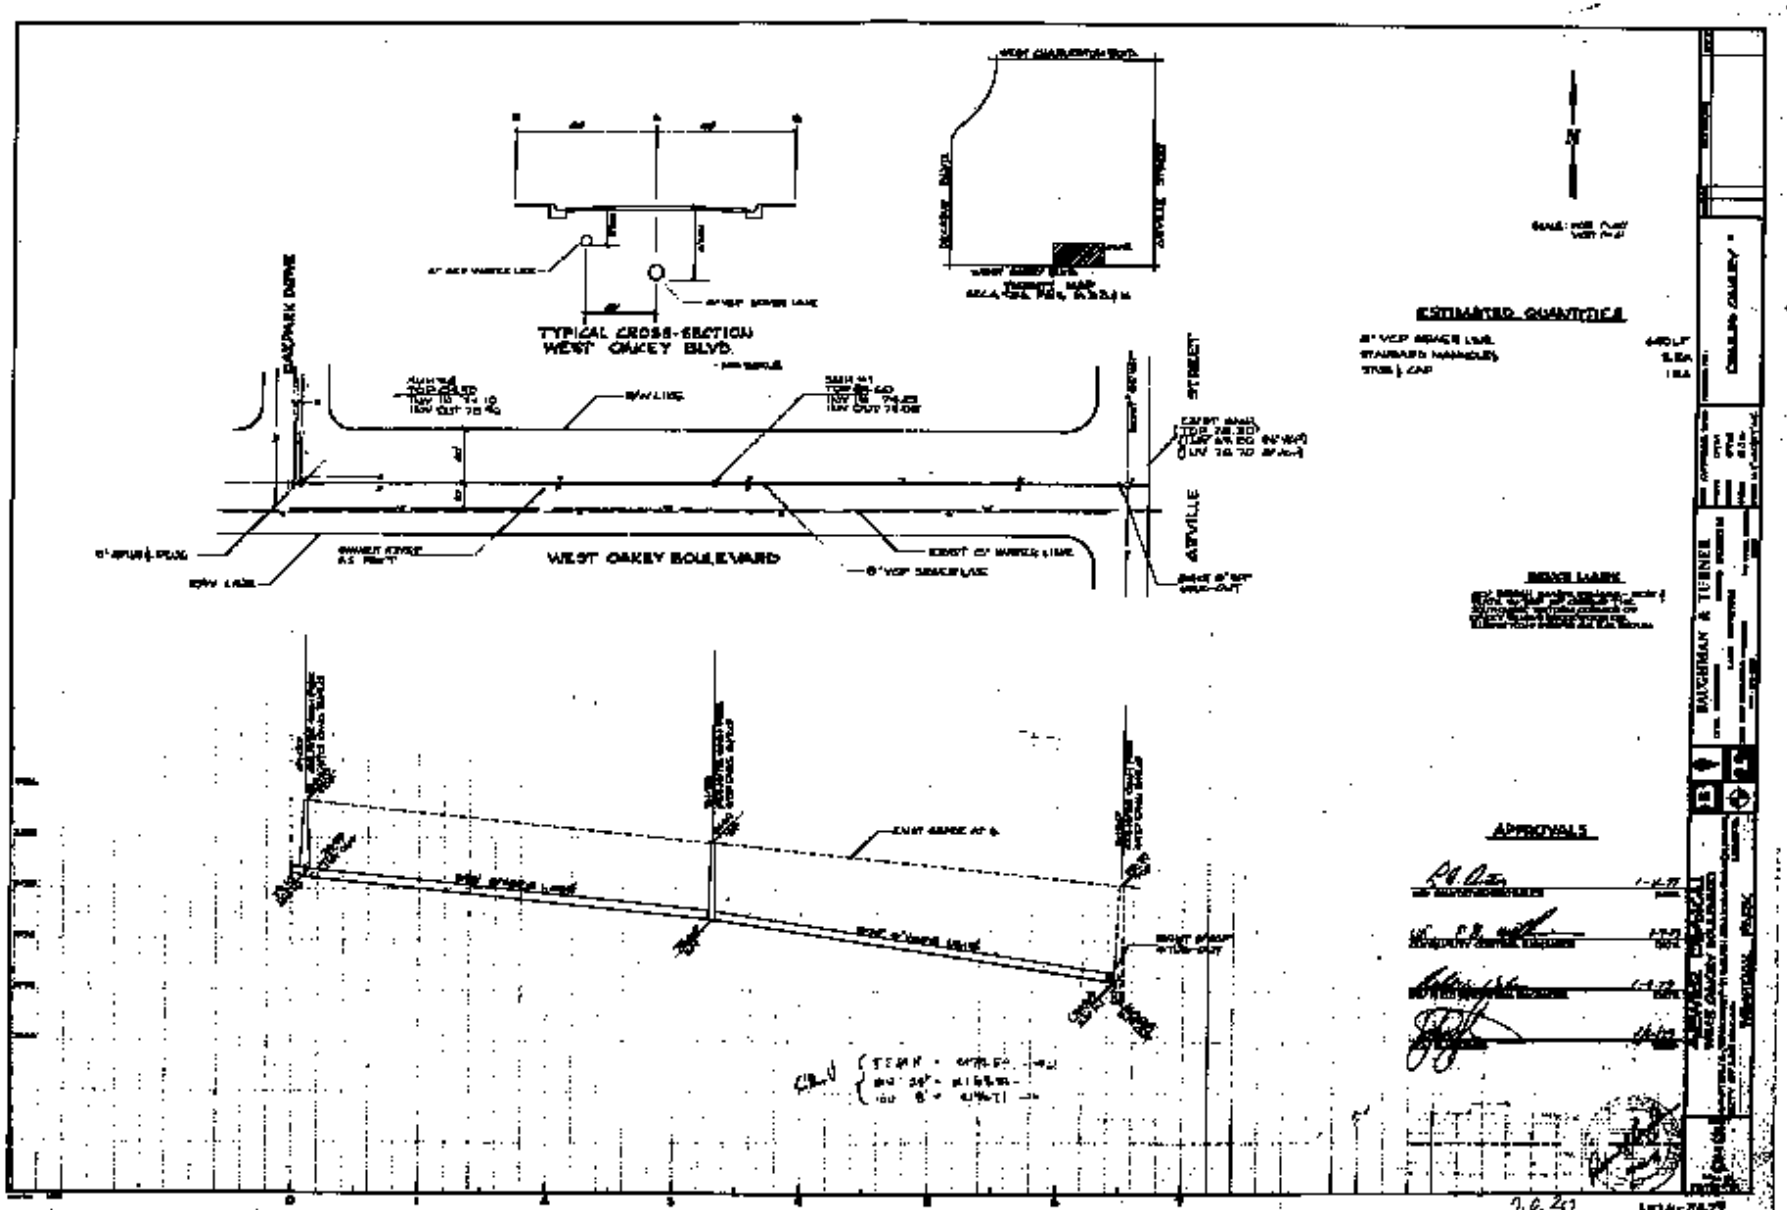
TYPICAL CROSS-SECTION
WEST OAKEY BLVD.
WEST OAKEY BOULEVARD
ESTIMATED QUANTITIES
APPROVALS
BAUCHMAN & TURNER