
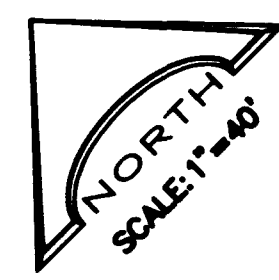


LATEST PLOT DATE 9-14-98

DRAWING NAME RB-TM.DWG

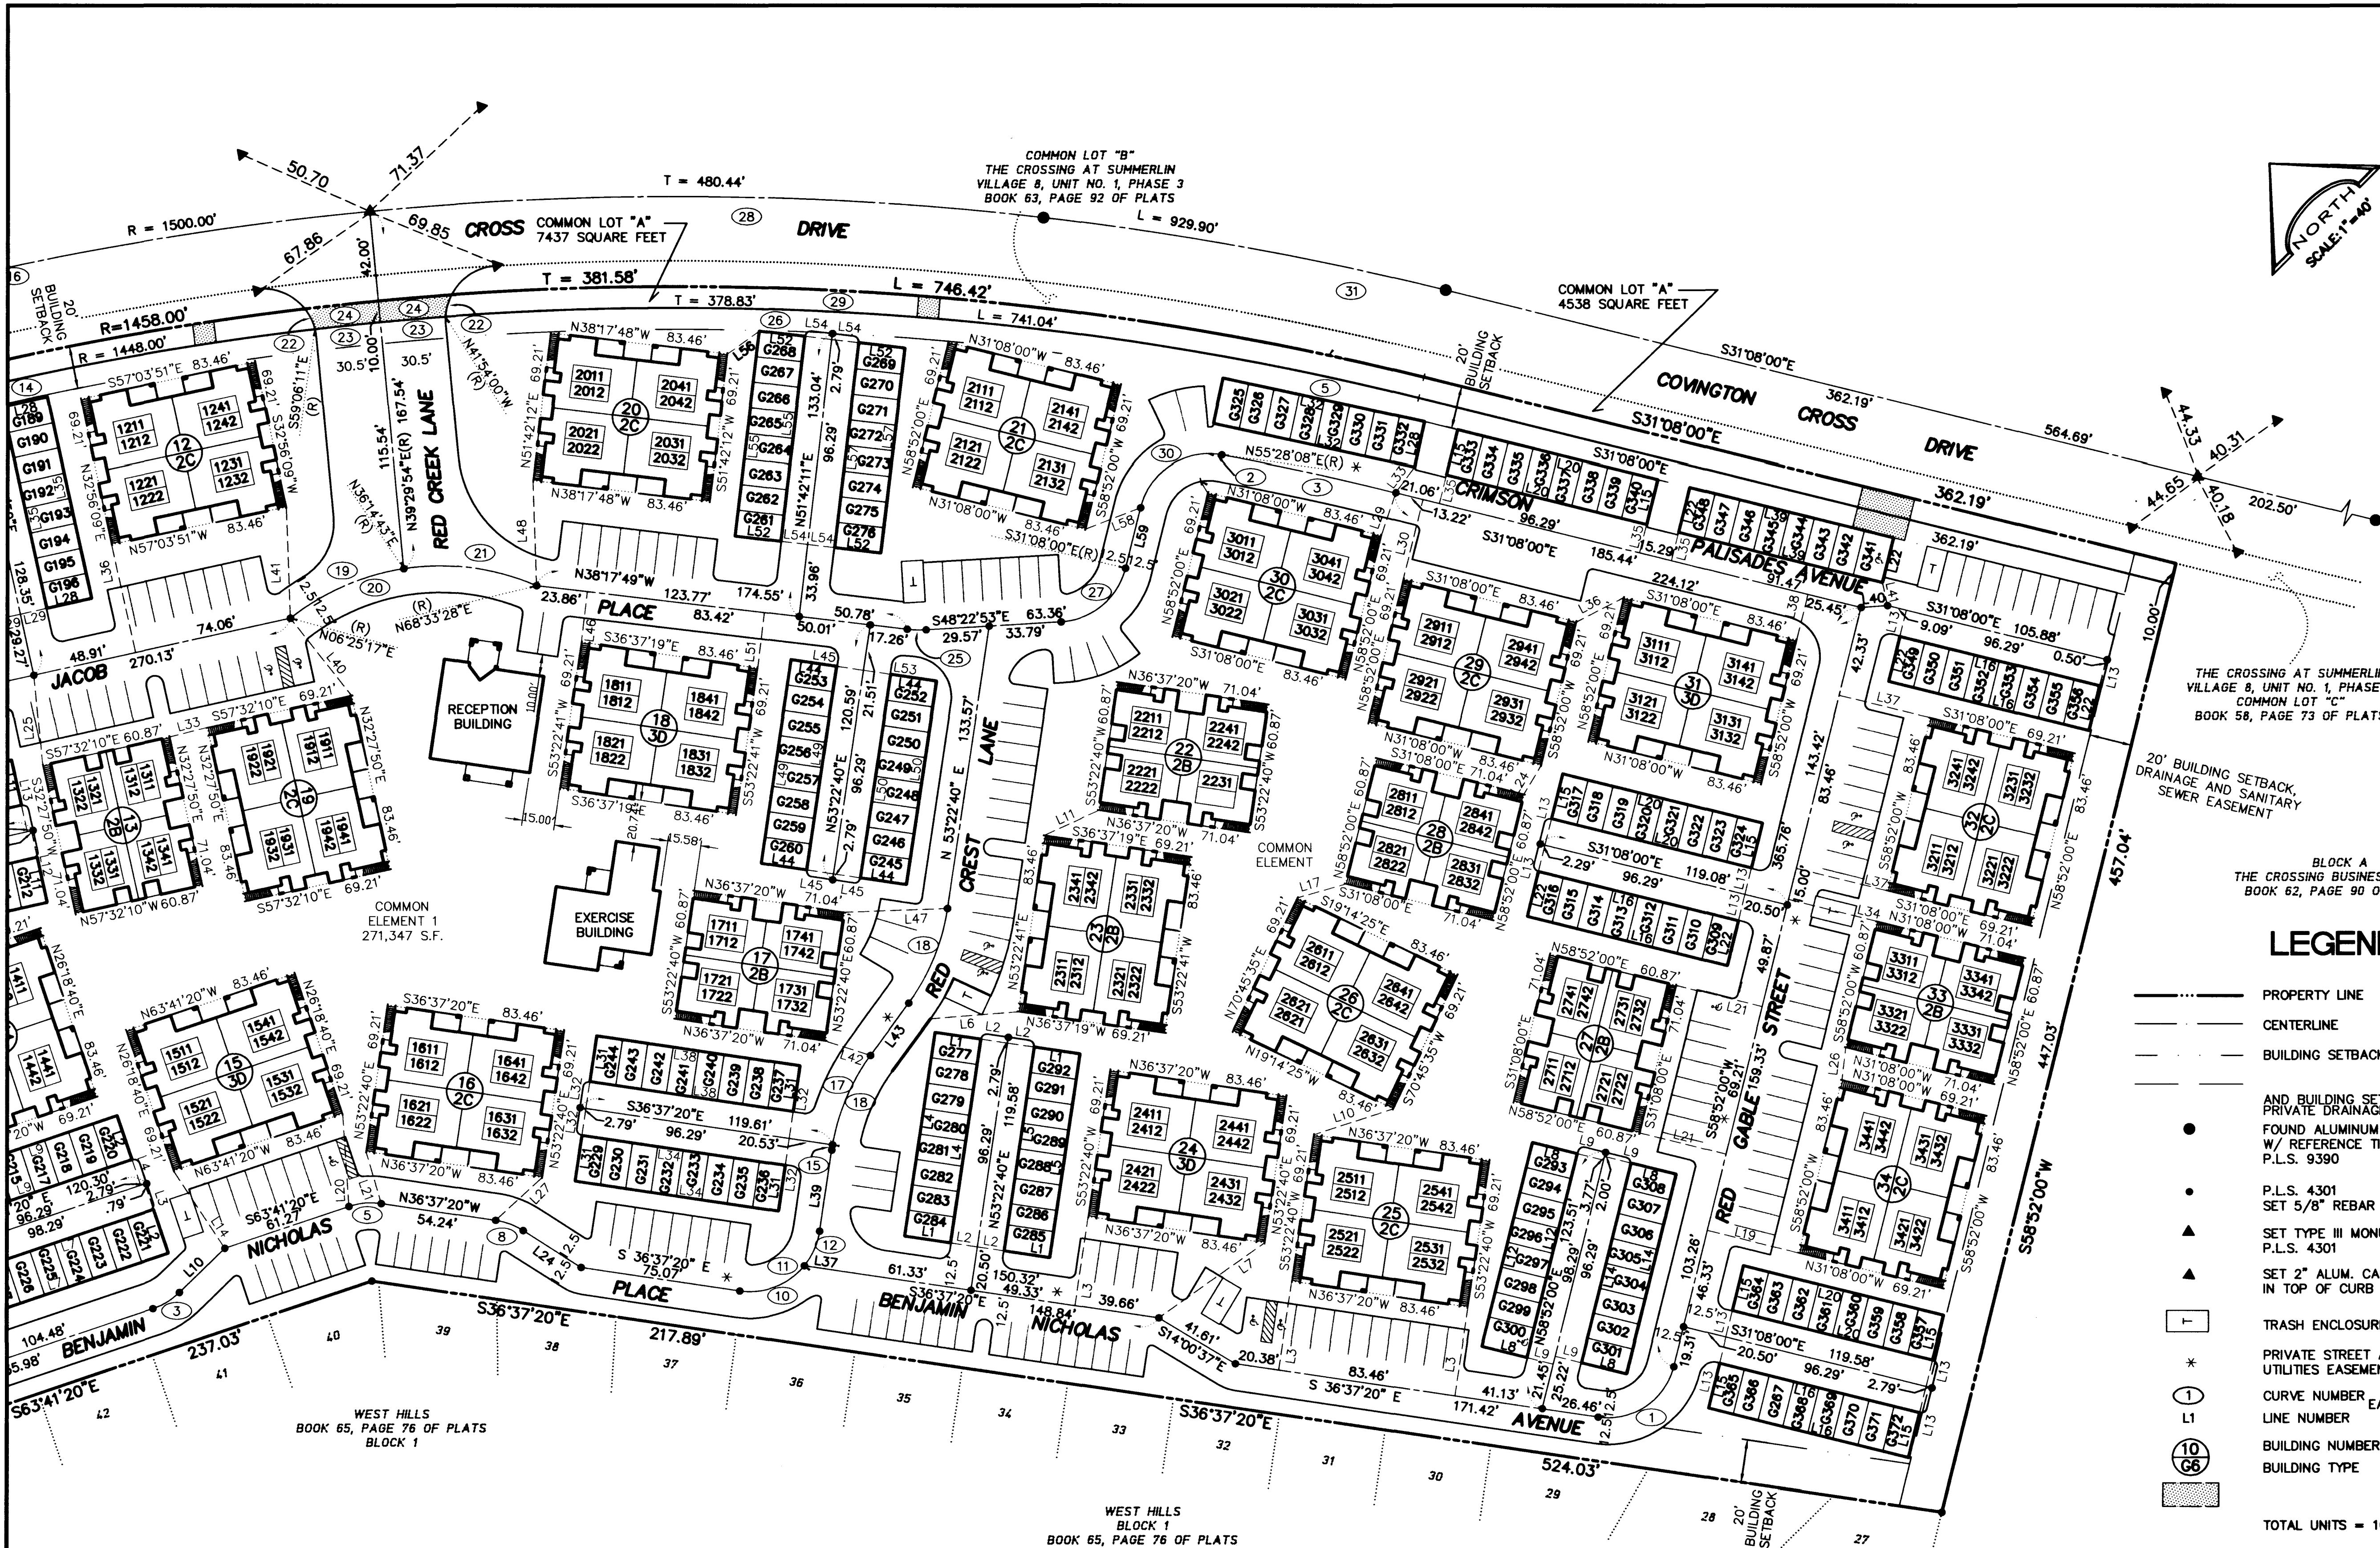


LEGEND

- PROPERTY LINE
- CENTERLINE
- BUILDING SETBACK LINE
- AND BUILDING SETBACK LINE
- PRIVATE DRAINAGE EASEMENT LINE
- FOUND ALUMINUM CAP W/ REFERENCE TIES P.L.S. 9390
- P.L.S. 4301 SET 5/8" REBAR & ALUMINUM CAP
- SET TYPE III MONUMENT P.L.S. 4301
- SET 2" ALUM. CAP MARKED R.M. PLS 4301 IN TOP OF CURB W/ EPOXY IN DRILL HOLE
- TRASH ENCLOSURE
- PRIVATE STREET AND PUBLIC UTILITIES EASEMENT
- CURVE NUMBER EASEMENT HEREBY GRANTED
- LINE NUMBER
- BUILDING NUMBER
- BUILDING TYPE
- TOTAL UNITS = 104

SURVEYOR'S CERTIFICATE:

I, BRENT ROSS WOOLSEY A PROFESSIONAL LAND SURVEYOR, REGISTERED IN THE STATE OF NEVADA, CERTIFY THAT THE MONUMENTS ARE OF THE CHARACTER SHOWN AND OCCUPY THE POSITIONS INDICATED HEREON.

BRENT ROSS WOOLSEY
PROFESSIONAL LAND SURVEYOR
NEVADA CERTIFICATE NO. 4301

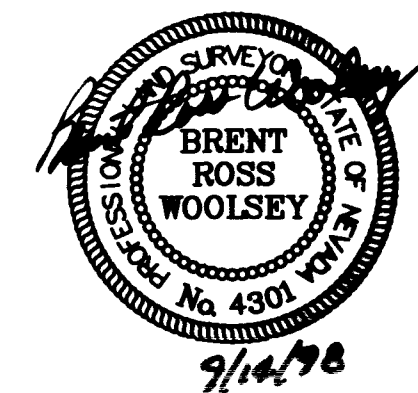

DESIGNED BY:	DRAWN BY:	CHKD BY:
JOB NUMBER: 218-067-953	DATE: 9-14-98	
REVISION	DATE	APPL
NO.		

L. R. NELSON CONSULTING ENGINEERS, INC.
3035 East Patrick Lane Suite 9
Las Vegas, Nevada 89120
(702) 798-7978
(702) 451-2296 FAX


• STRUCTURAL
• CIVIL
• SURVEY

MONUMENT TIE MAP
OF
RED BLUFFS
BOOK 77, PAGE 15 OF PLATS
RV JONES

CLARK COUNTY NEVADA

SHEET NUMBER
2
OF 2 SHEETS
218-067-953

058-4493-1

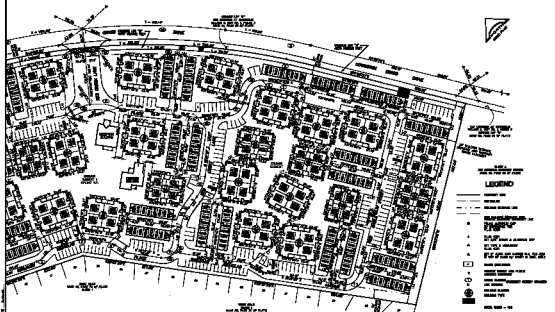



