


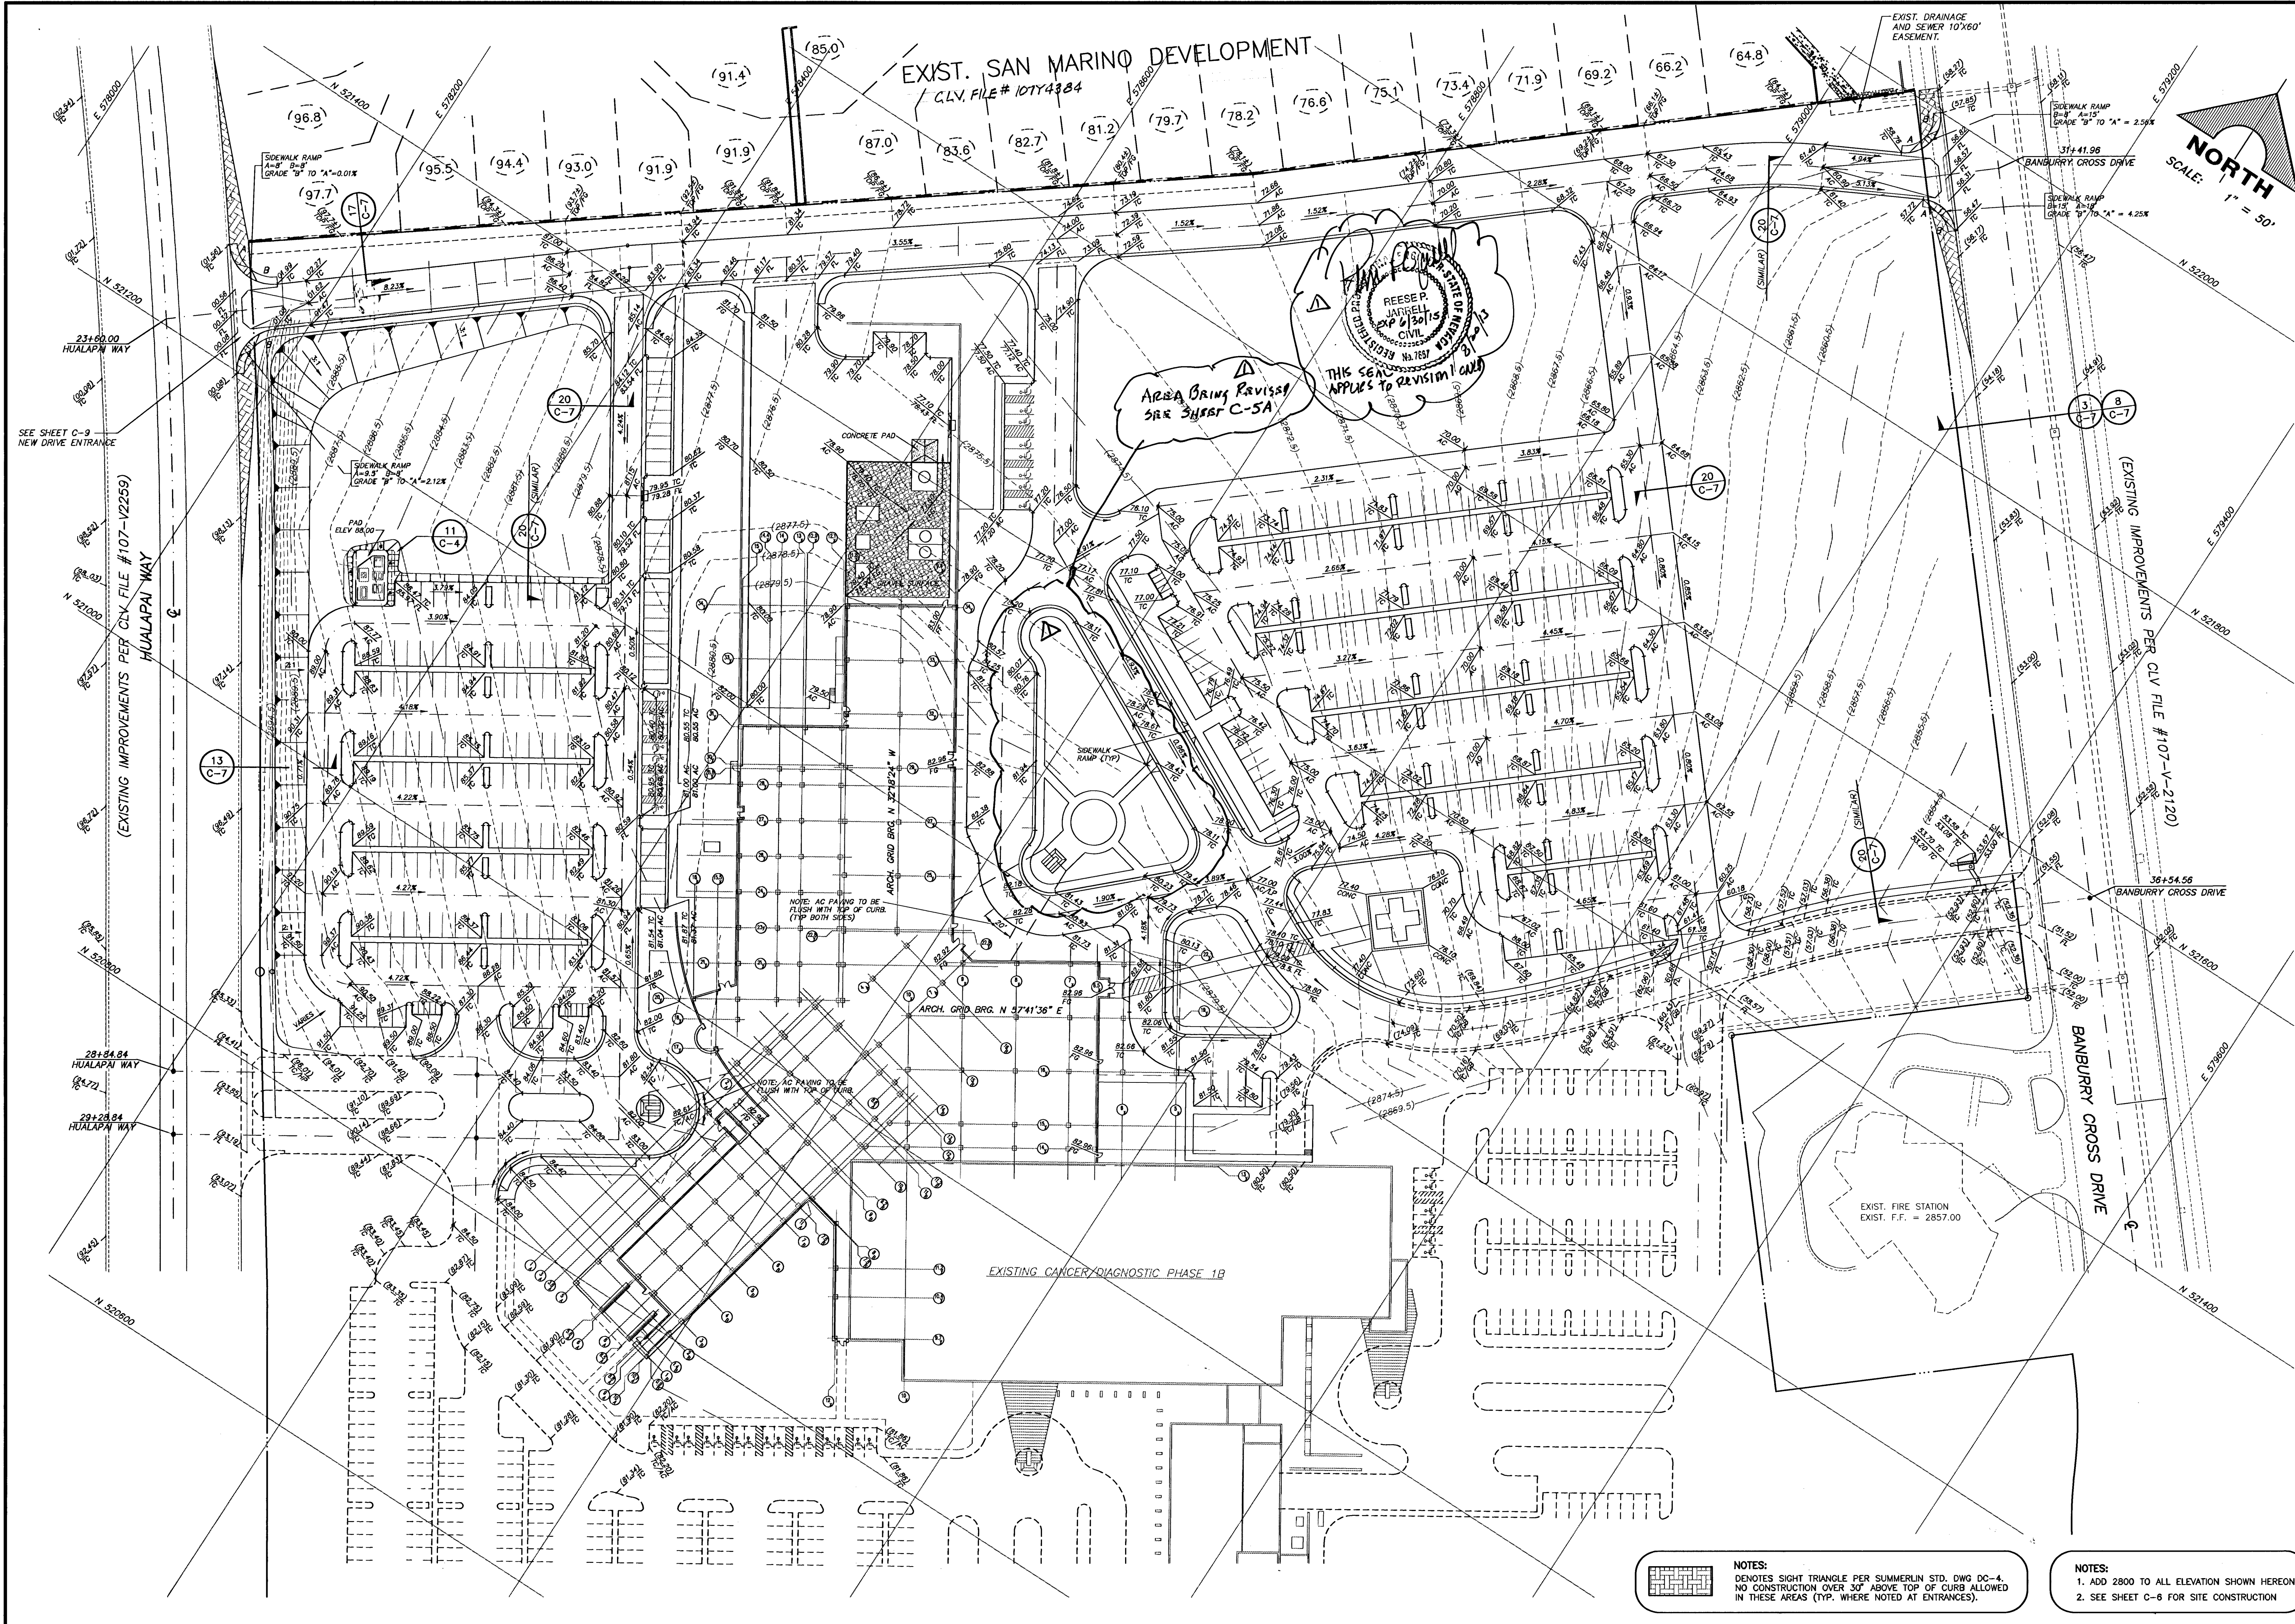

NOTES:
1. ADD 2800 TO ALL ELEVATION SHOWN HEREON
2. SEE SHEET C-6 FOR SITE CONSTRUCTION

NOTES:
1. ADD 2800 TO ALL ELEVATION SHOWN HEREON
2. SEE SHEET C-6 FOR SITE CONSTRUCTION

UNIVERSAL HEALTH SERVICES, INC.
SUMMERLIN MEDICAL CENTER
PHASE II IMPROVEMENTS
SITE GRADING PLAN

G.C. WALLACE, INC.
Engineering/Architecture
1535 SOUTH RANCHO BLVD LAS VEGAS, NEVADA 89102

STATE OF NEVADA
REGISTERED PROFESSIONAL ENGINEER
No. 10111
G.C. WALLACE, INC.

SHEET
C-5
OF 9 SHEETS

JOB NO 398.056
MED-SHOS.DWG