STREET STRIPING AND SIGNAGE NOTES

1 SS — ALL STREET SIGNS SHALL BE IN CONFORMANCE WITH THE MANUAL OF UNIFORM TRAFFIC CONTROL DEVICES (MUTCD) LATEST EDITION.

3 SS — INSTALL 2 EA. R2-1 (24" X 30") 25 M.P.H. SPEED LIMIT SIGN.

4 SS — INSTALL 296.00 LF 4" SOLID WHITE BIKE LANE STRIPE

7 SS — INSTALL 440.00 SF CROSSWALK PER S.I.S. STD. NO. S-78.

8 SS — INSTALL CONTINUOUS 2000.00 LF LEFT TURN LANE LINE

NOTE:
ALL STRIPING SHOWN IS FUTURE AND NOT IN THIS CONTRACT. STRIPING TO BE INSTALLED AFTER FINAL 1" OVERLAY.

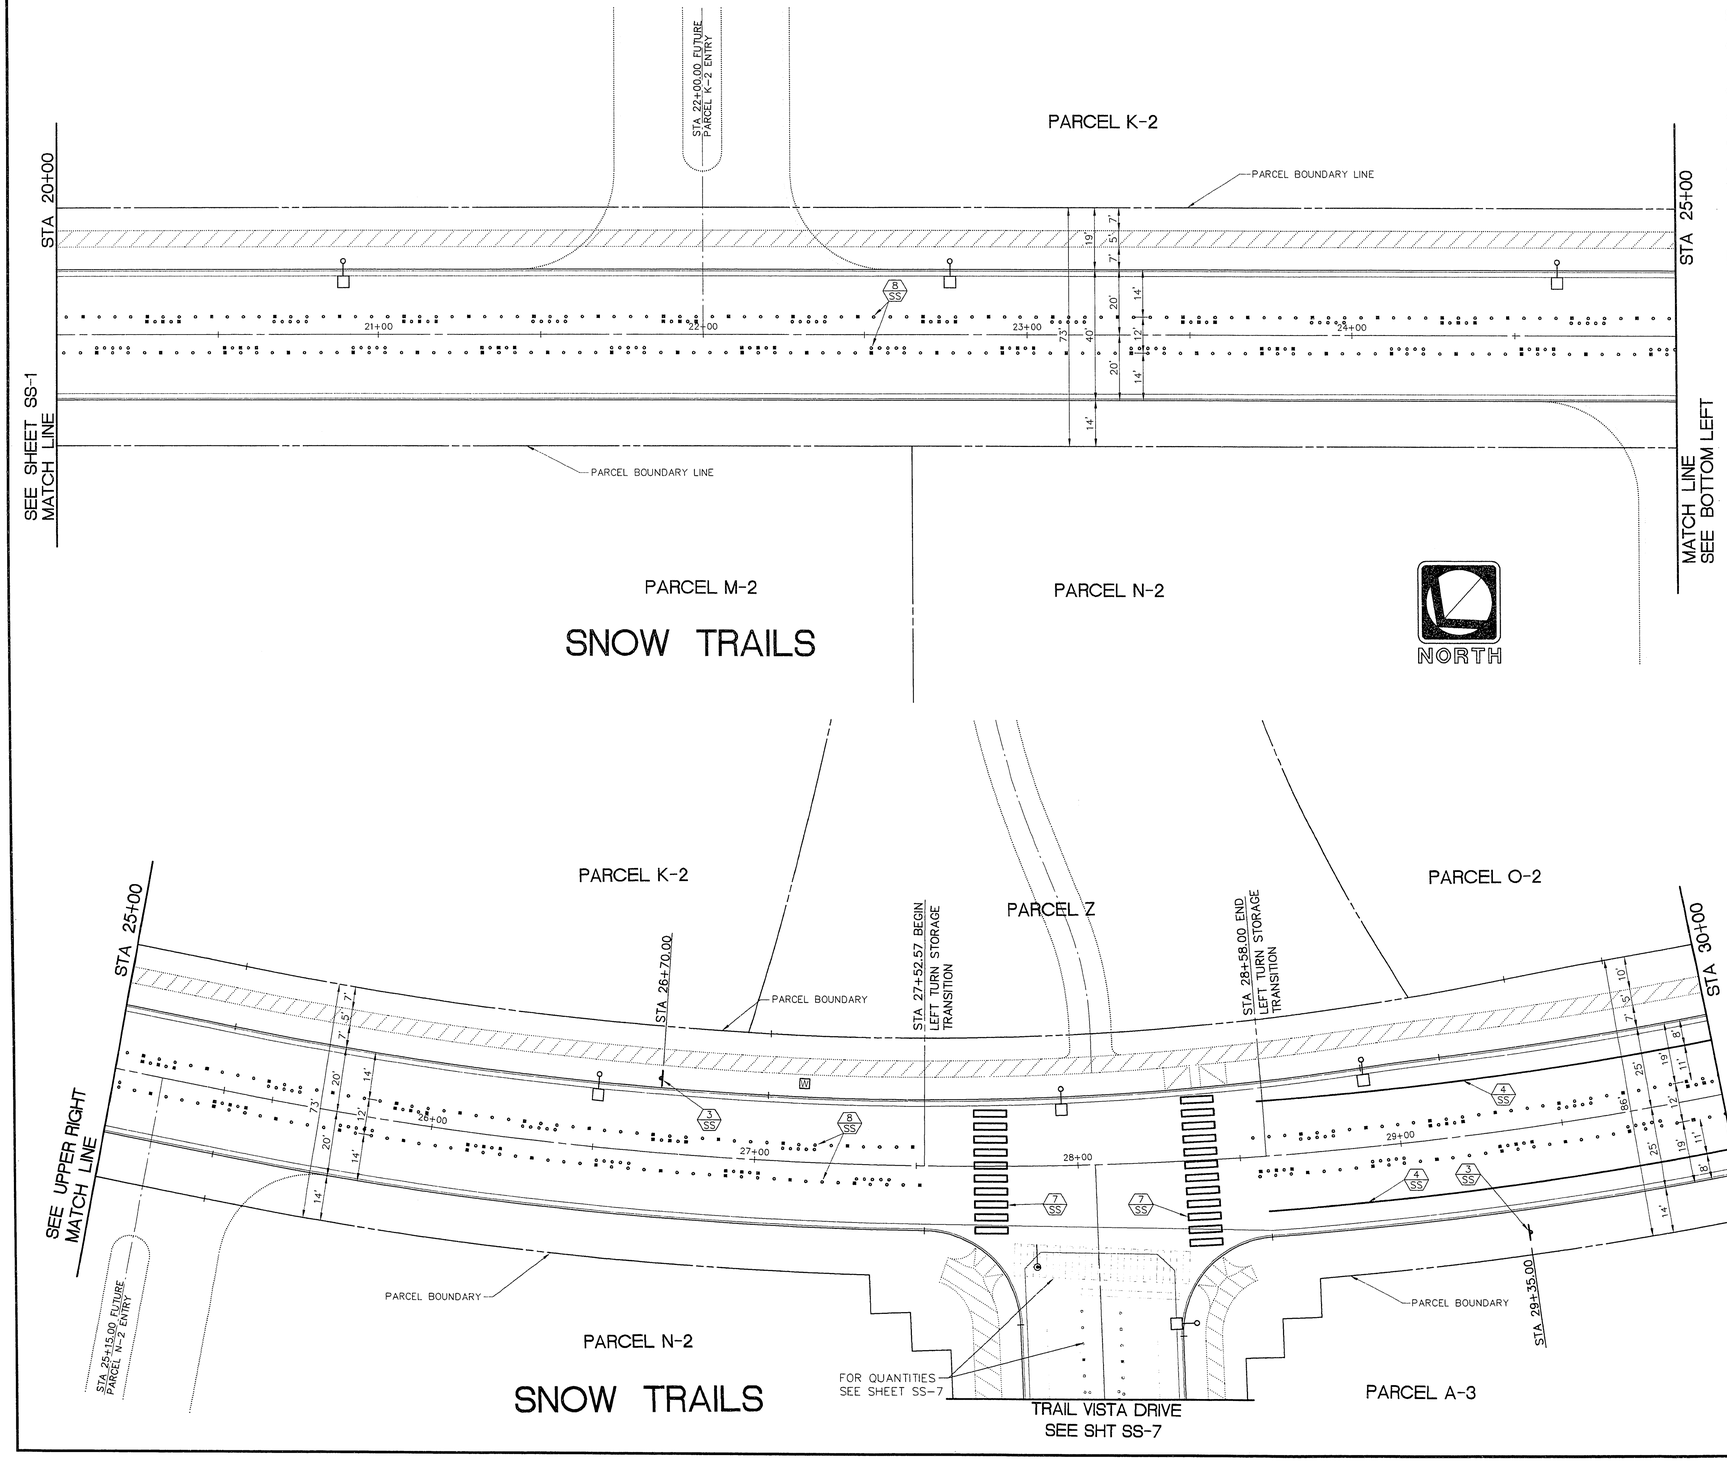

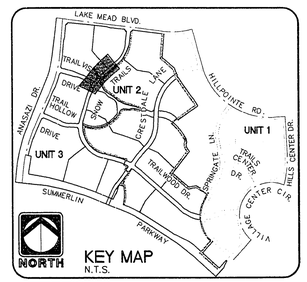

RECORD DRAWING
RECORD INFORMATION PROVIDED BY FIELD CONTRACTOR

RECOMMENDED
GARY R. BUSBY 10584 R.P.E.
5/19/97 DATE

REV.	DATE	DESCRIPTION	DATE	APPROVAL

ENGINEER
THE KEITH COMPANIES NEVADA
4662 SO. INDUSTRIAL RD. LAS VEGAS, NV. 89103

HOWARD HUGHES PROPERTIES
SUMMERLIN VILLAGE 7 - THE TRAILS - UNIT 3
SNOW TRAILS
SIGNING AND STRIPING
STA 20+00 - STA 30+00

SHEET
SS-2
SHT 48 OF 54

107Y-4271-3

D:\SUM407\PLAN\407SS02 Wed Jul 20 10:15:53 1994 SHADED 1-0 WHITEOUT 10. SOLID 11 0 UP= 486-50410
HP DesignJet 600: HP-GL/2 ADI 4.2 plotter driver by Hewlett-Packard 1.0