STREET STRIPING AND SIGNAGE NOTES

1 SS — ALL STREET SIGNS SHALL BE IN CONFORMANCE WITH THE MANUAL OF UNIFORM TRAFFIC CONTROL DEVICES (MUTCD) LATEST EDITION.

3 SS — INSTALL 1 EA. R2-1 (24" X 30") 25 M.P.H. SPEED LIMIT SIGN

4 SS — INSTALL 2000.00 LF 4" SOLID WHITE BIKE LANE STRIPE

8 SS — INSTALL 2000 LF CONTINUOUS LEFT TURN LANE LINE PER S.I.S. STD. NO. S-90.

9 SS — INSTALL 2000 LF BROKEN LANE LINE PER S.I.S. STD. NO. S-89.

NOTE:
ALL STRIPING SHOWN IS FUTURE AND NOT IN THIS CONTRACT. STRIPING TO BE INSTALLED AFTER FINAL 1" OVERLAY.

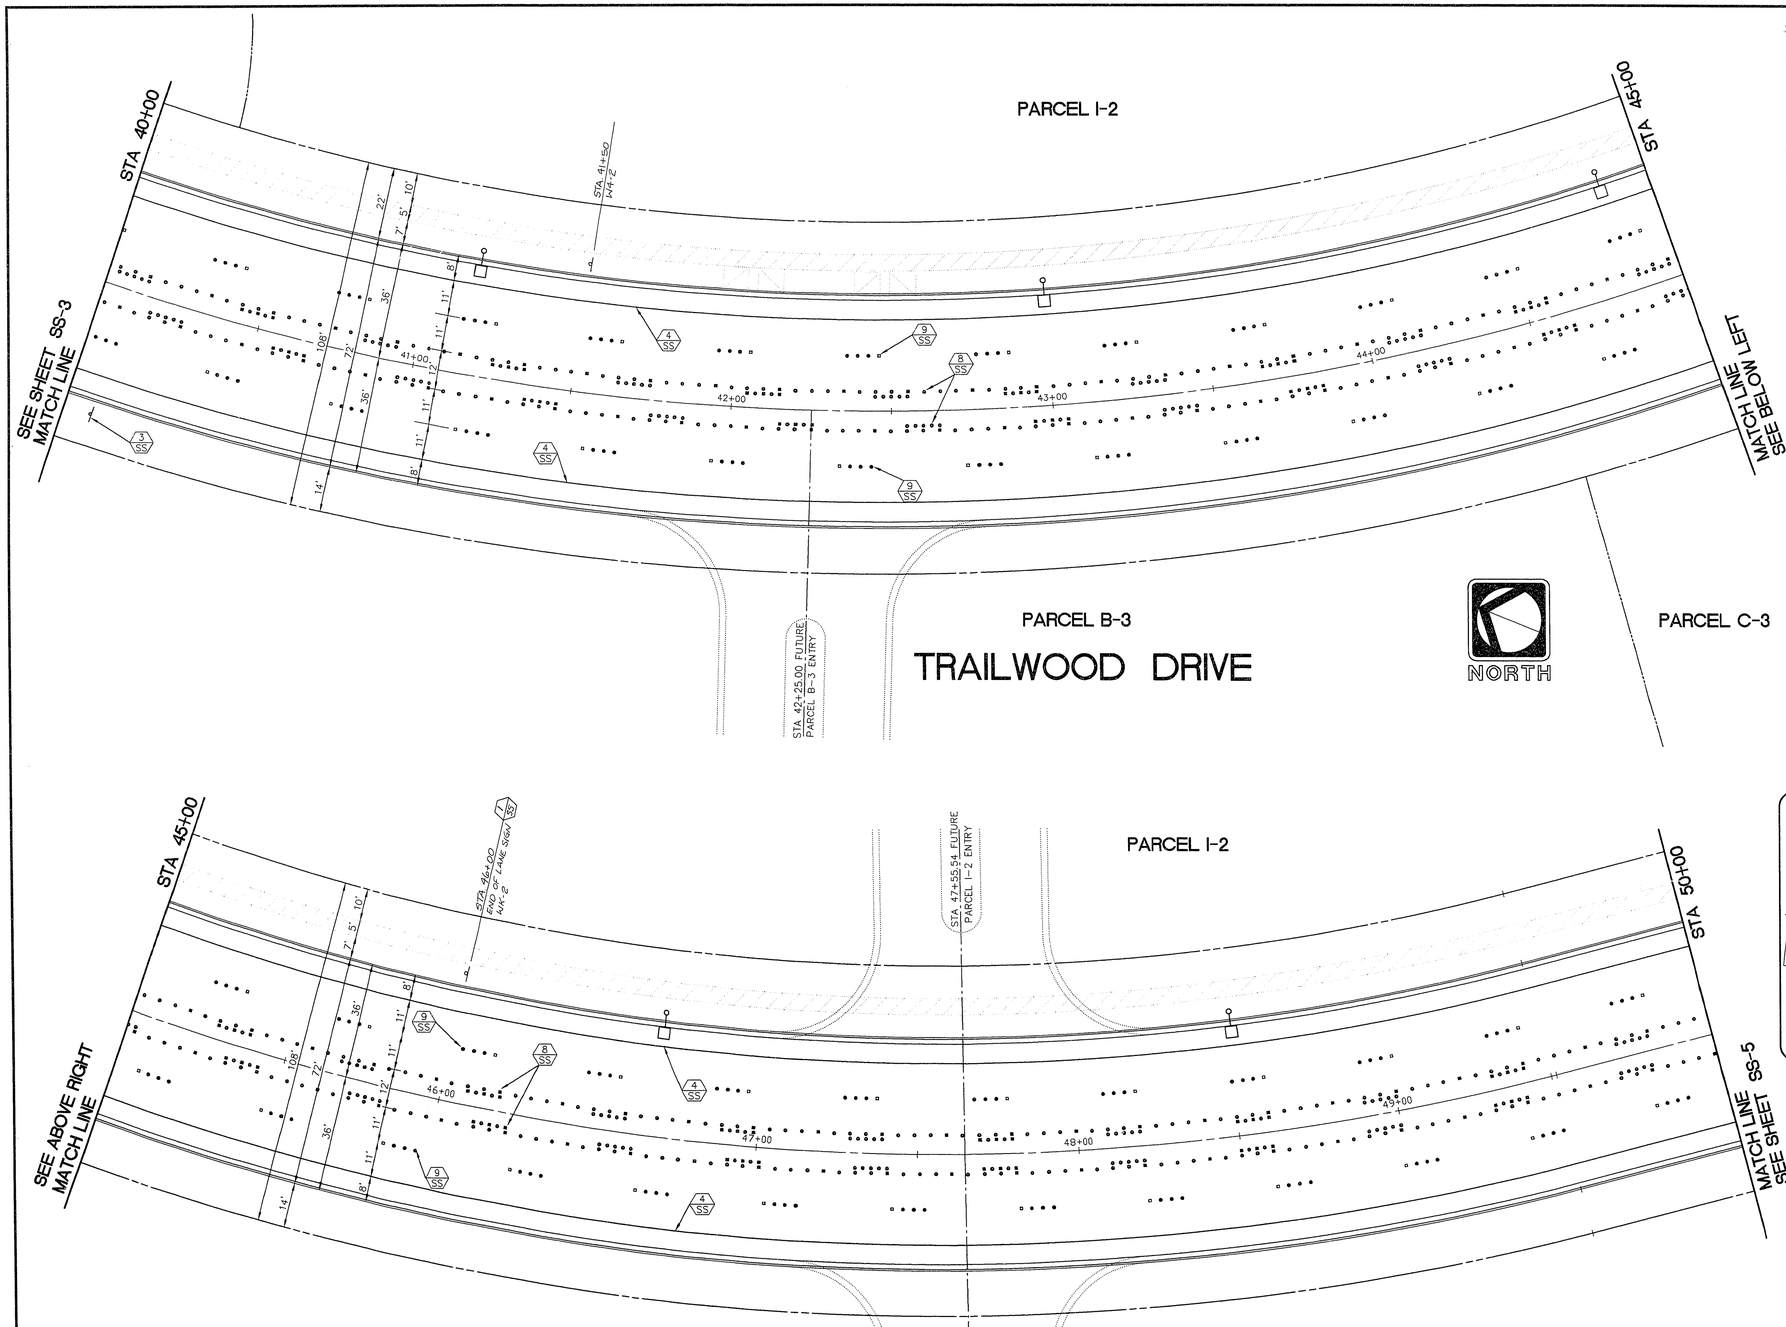

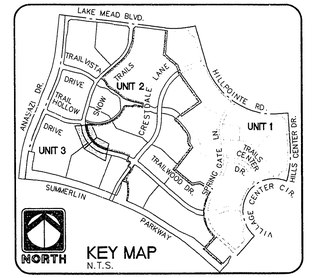

RECORD DRAWING
RECORD INFORMATION PROVIDED BY FIELD CONTRACTOR

REV.	DATE	DESCRIPTION	DATE	APPROVAL

RECOMMENDED
GARY R. BUSBY
10584 R.P.E.
2/19/24 DATE

ENGINEER
THE KEITH COMPANIES NEVADA
4055 SO. INDUSTRIAL RD. LAS VEGAS, NV. 89103
• PLANNING
• CIVIL ENGINEERING
• LANDSCAPE ARCHITECTURE
• LAND SURVEYING
• CONSTRUCTION MANAGEMENT
LAS VEGAS, NV. 89103 (702) 733-0550

HOWARD HUGHES PROPERTIES
SUMMERLIN VILLAGE 7 - THE TRAILS - UNIT 3
TRAIL WOOD DRIVE
SIGNING AND STRIPING
STA. 40+00 - STA. 50+00

SHEET
SS-4
SHT 50 OF 54

107Y-4271-3

Q:\SAM4071P\4075SD4 Tue Jul 19 17:21:34 1994 SHADED 1-9,WHITEOUT 10, SOLID 11 & UP- 486-50#1
HP Designjet 600: HP-GL/2 ADI 4.2 plotter driver by Hewlett-Packard 1.0