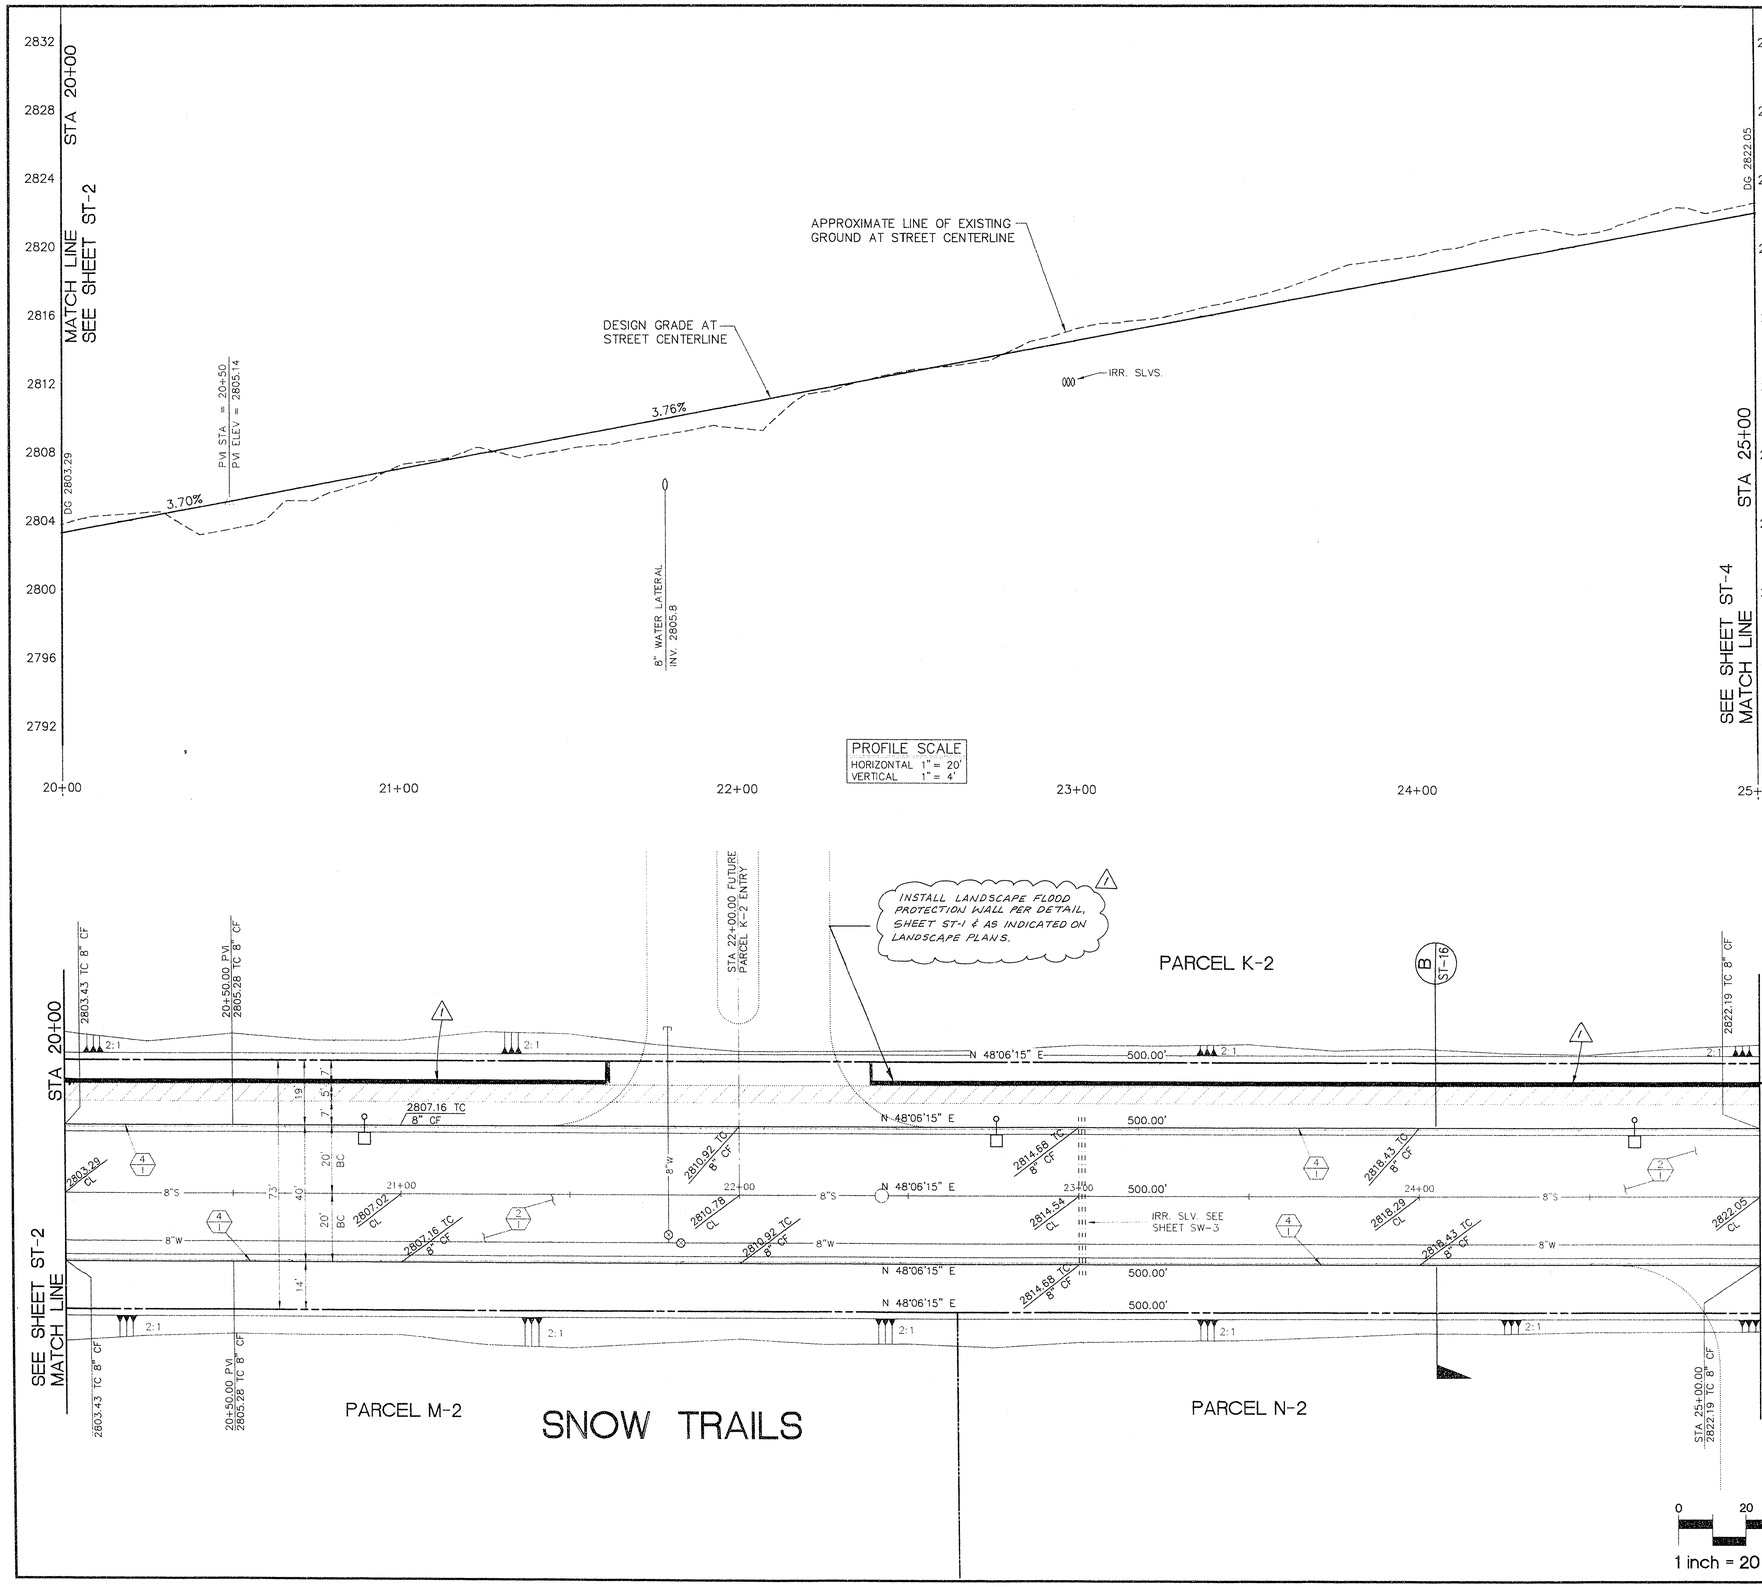

IMPROVEMENTS

1. CONSTRUCT 2000.00 S.Y. OF 2" ASPHALT PAVEMENT WITH A 1" OVERLAY OVER 4" TYPE II AGGREGATE BASE
2. INSTALL 1000.00 L.F. OF 8" "L" TYPE CURB AND GUTTER

STREET LIGHTING AND ELECTRICAL

(SHOW FOR REFERENCE ONLY; SEE SHEETS SL-1 & SL-2 FOR STREET LIGHTING INSTALLATION)

(SEE NEVADA POWER CO. DWGS. FOR ELECTRICAL DISTRIBUTION)

BENCHMARK

RIVET AND PLATE IN TOP OF CURB NW SIDE OF TOWN CENTER DRIVE AND SOUTH ROUNDABOUT ISLAND
ELEVATION = 2725.923
PER CITY OF LAS VEGAS DATUM STATION: OLVOO 1954

SEE SHEET CG-3 FOR LOCATION

10/12/95
FOR 1 ONLY

RECORD DRAWING

RECORD INFORMATION PROVIDED BY FIELD CONTRACTOR

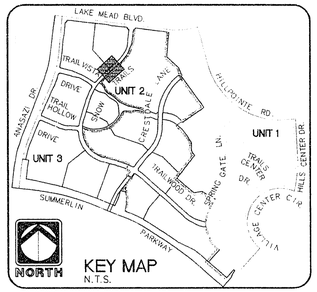

Call before you Dig.
1-800-227-2600
UNDERGROUND SERVICE ALERT

REV.	DATE	DESCRIPTION	APPROVAL
1	10.12.95	ADD FLOOD PROTECTION WALL	

RECOMMENDED
GARY R. GOSSETT
R.P.E. 10584
DATE 7/19/94

ENGINEER
THE KEITH COMPANIES NEVADA
4850 S. INTERBAY RD. LAS VEGAS, NV. 89103 (702) 739-9580

HOWARD HUGHES PROPERTIES
SUMMERLIN VILLAGE 7 - THE TRAILS - UNIT 3
SNOW TRAILS
PLAN AND PROFILE
STA 20+00 - STA 25+00

SHEET
ST-3
SHT 12 OF 54

107Y-4271-3

11-2-11