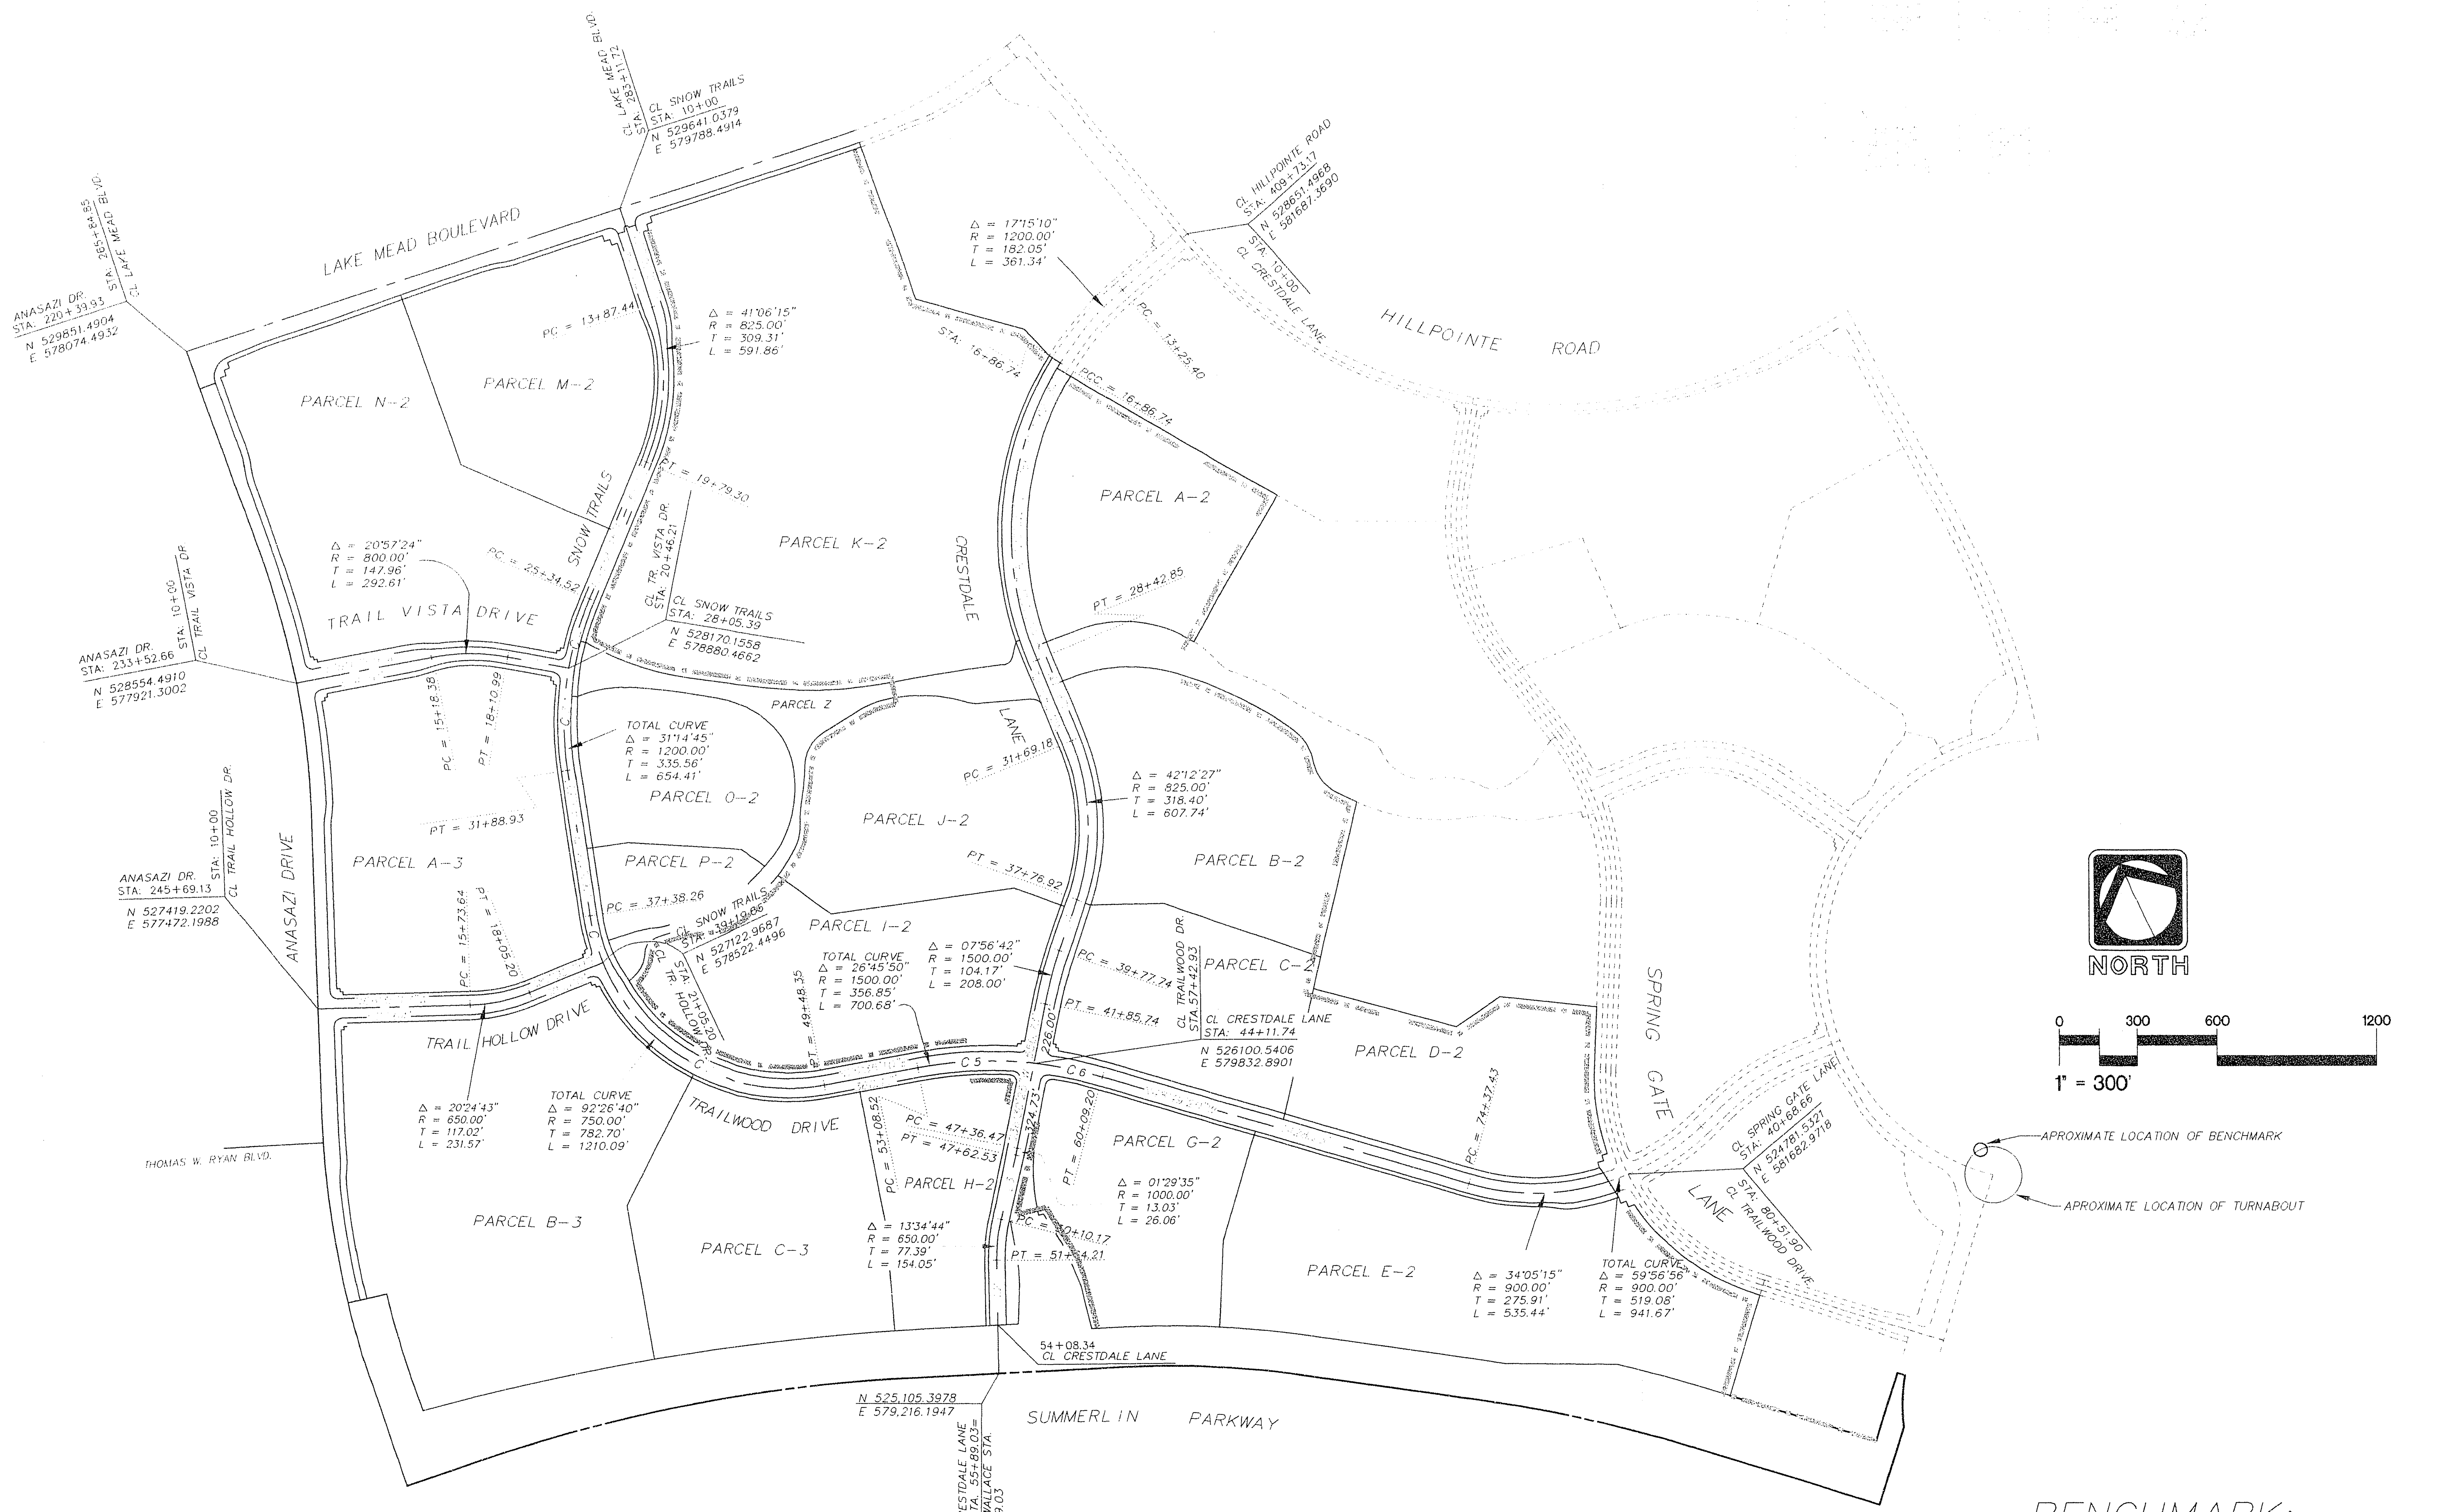

BASIS OF BEARINGS

NORTH 42°00'00" EAST, BEING THE CENTERLINE OF TOWN CENTER DRIVE AS SHOWN BY MAP THEREOF ON FILE IN BOOK 59, PAGE 11 OF PLATS, IN THE OFFICE OF THE CLARK COUNTY RECORDER.

BENCHMARK:

RIVET & PLATE IN TOP OF CURB NW SIDE OF TOWN CENTER DRIVE AND ROUNDABOUT.
ELEVATION = 2725.923
PER CITY OF LAS VEGAS DATUM
STATION : OLVOO 1954

RECORD DRAWING
RECORD INFORMATION PROVIDED BY FIELD CONTRACTOR

HOWARD HUGHES PROPERTIES
SUMMERLIN VILLAGE 7 - THE TRAILS - UNIT 3
HORIZONTAL CONTROL PLAN

ENGINEER: THE KEITH COMPANIES NEVADA
4052 SO. INDUSTRIAL RD. LAS VEGAS, NV 89103 (702) 733-0350
PLANNING • CIVIL ENGINEERING • LANDSCAPE ARCHITECTURE • LAND SURVEYING • CONSTRUCTION MANAGEMENT

RECOMMENDED
GARY R. BUSBY 10584 7/19/94
R.F.E. DATE

REV.	DATE	DESCRIPTION	DATE	APPROVAL

SHEET CG-3
SHT 3 OF 54

107Y-4271-3