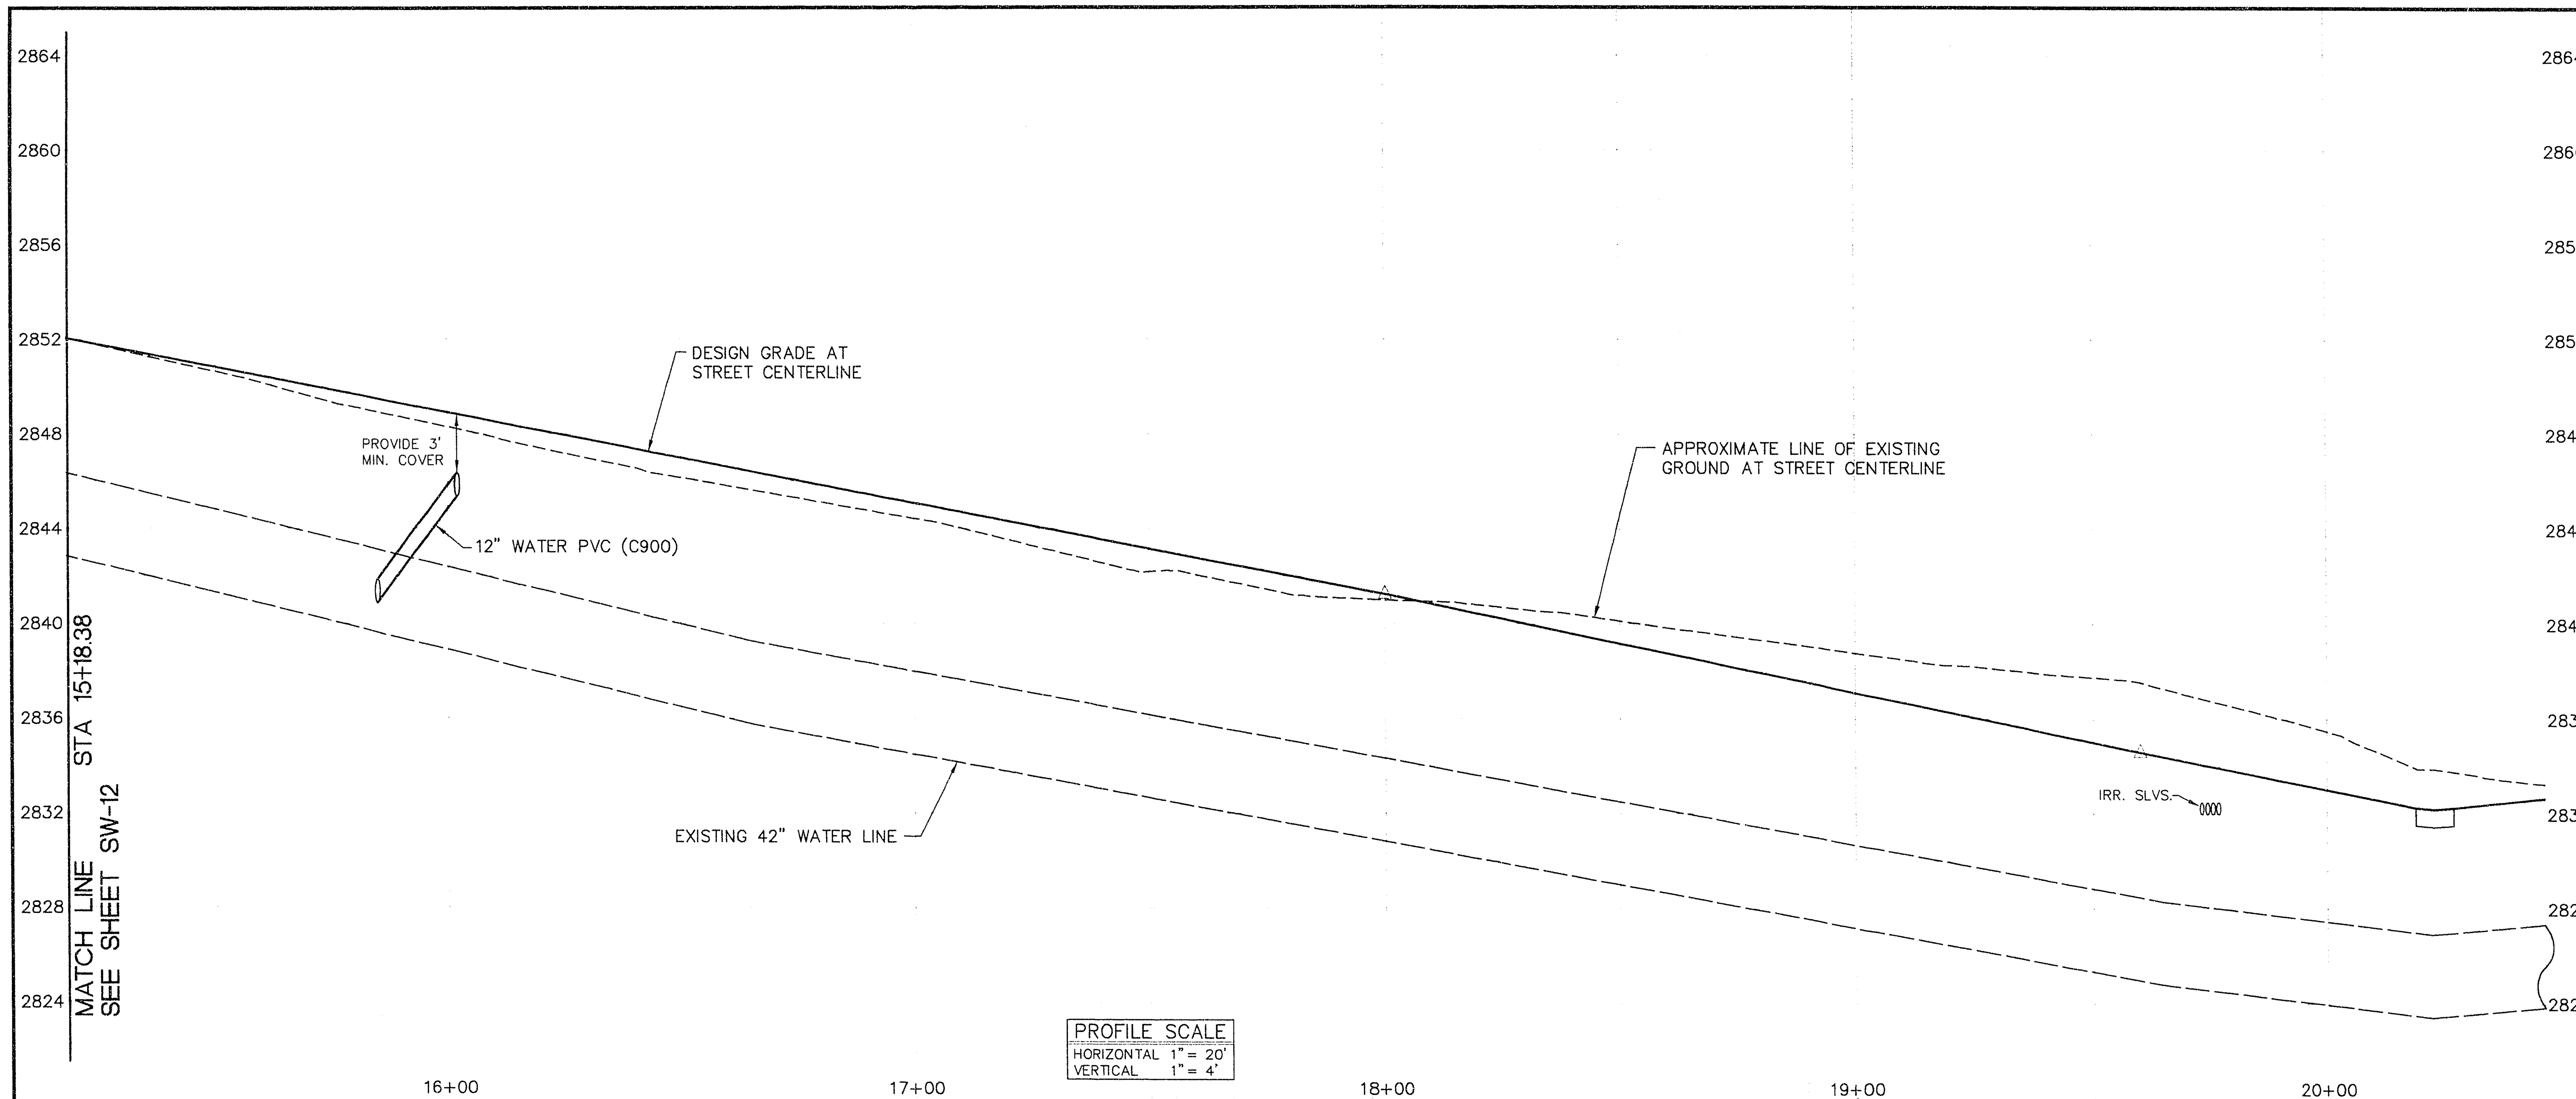

CONSTRUCTION NOTES (WATER)

- 1/W — INSTALL ALL WATER MAINS AND APPURTENANCES PER L.V.V.W.D. STD. PLATES.
- 3/W — INSTALL 112.66 L.F. 8" PVC (C-900) WATER PIPE.
- 4/W — INSTALL 11.43 L.F. 12" PVC (C-900) WATER PIPE.
- 5/W — INSTALL 2 EA. 8" GATE VALVE.
- 7/W — INSTALL 2 EA. END CAP AND CORP STOP (LVVWD STD. PLATE NO. 4)
- 9/W — INSTALL 1 EA. 12" X 8" TEE AND THRUST BLOCK PER L.V.V.W.D. STD. PLATE NO. 5.
- 11/W — INSTALL 1 EA. 2 - 6" PVC AND 2 - 4" PVC (SDR-35) SLEEVES FOR FUTURE ELECTRICAL OR IRRIGATION PURPOSES.
- 18/W — INSTALL 2 EA. 12" TO 8" REDUCER
- 19/W — REMOVE 1 EA. END CAP AND CONNECT TO EXIST. 12" WATER PIPE.
- 23/W — INSTALL 12" X 90° FITTING AND THRUST BLOCK PER L.V.V.W.D. STD. PLATE NO. 5.

RECORD DRAWING

RECORD INFORMATION PROVIDED BY FIELD CONTRACTOR

10584 R.P.E. 7/19/94 DATE

RECOMMENDED GARY R. BUSBY

LVVWD 7/21/94 DATE

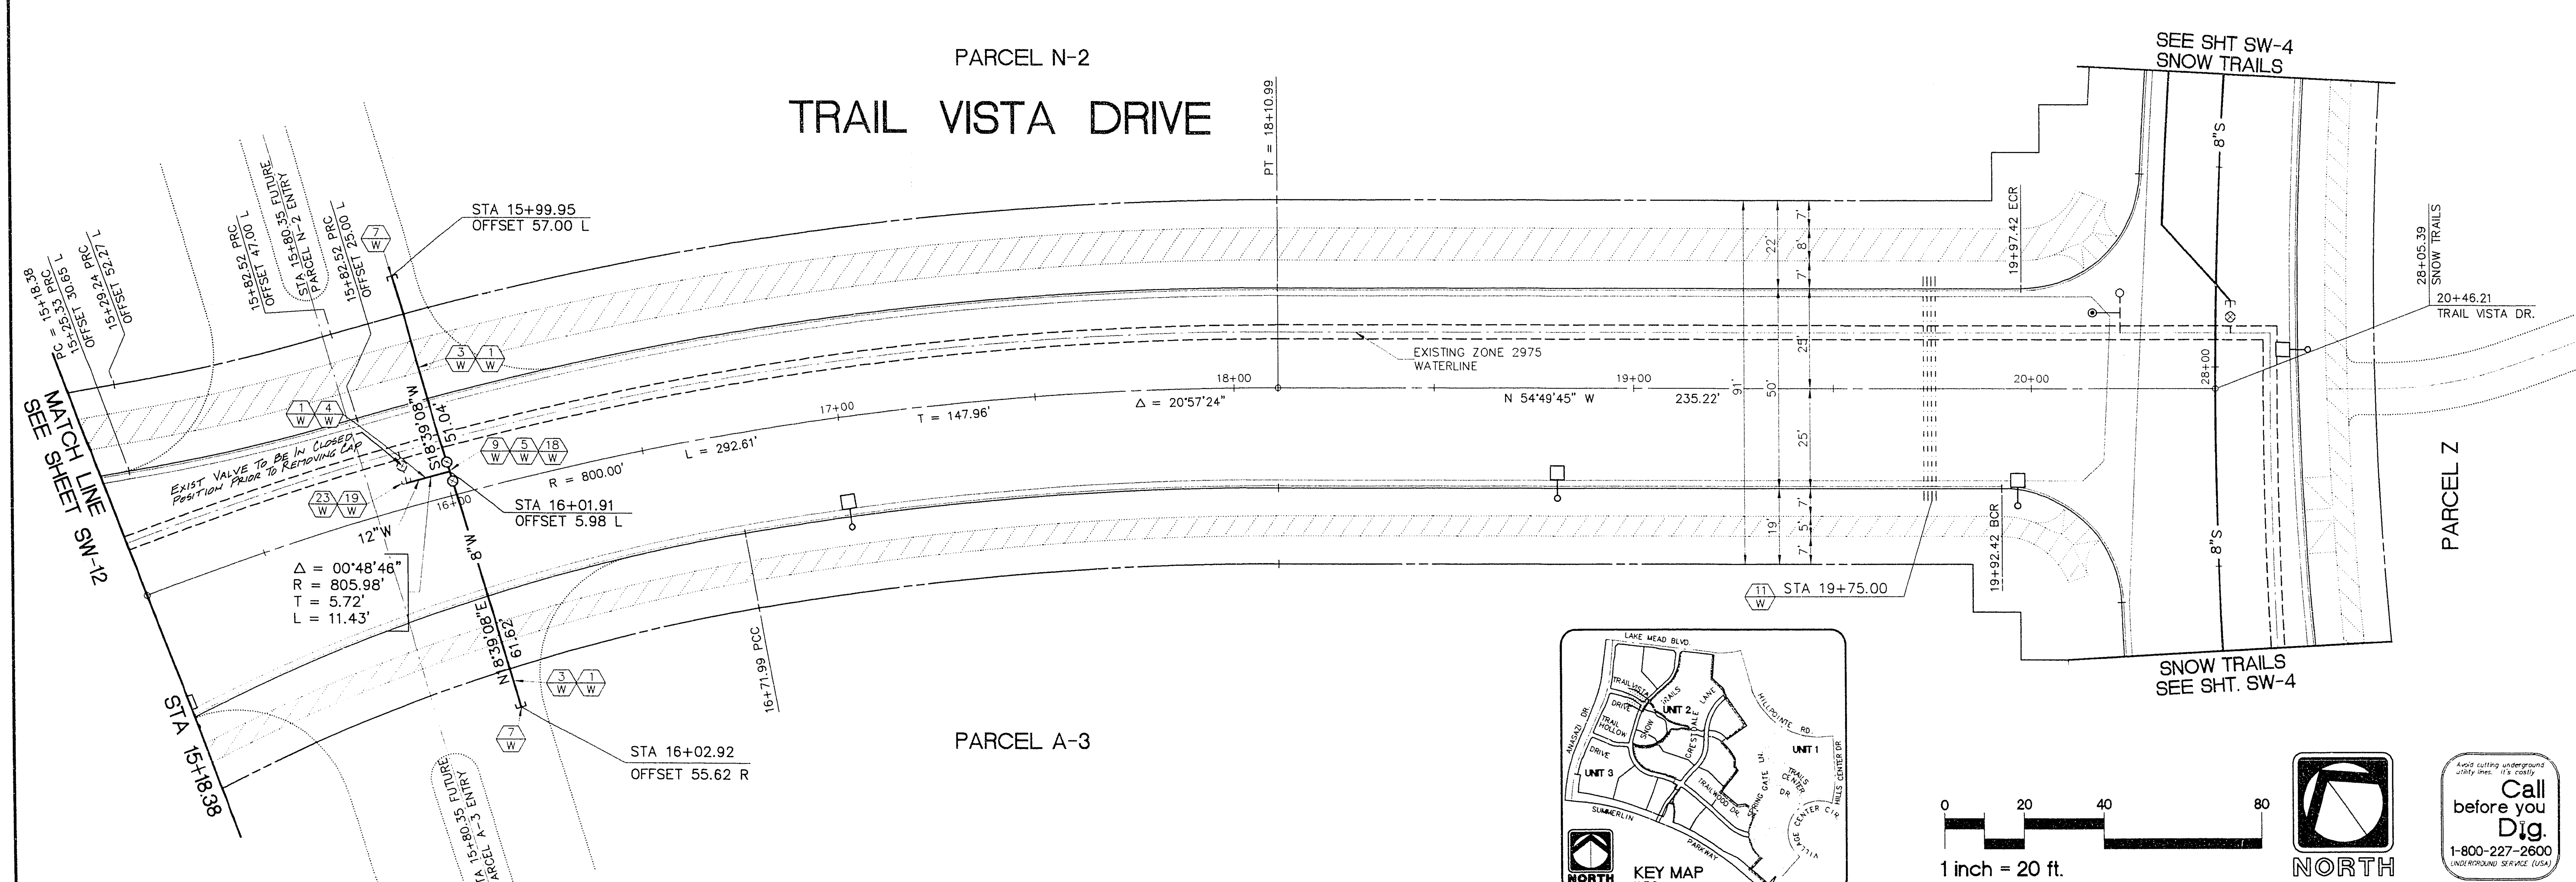

ENGINEER

THE KEITH COMPANIES NEVADA

HOWARD HUGHES PROPERTIES

SUMMERLIN VILLAGE 7 - THE TRAILS - UNIT 3

TRAIL VISTA DRIVE

SEWER AND WATER

STA 15+18.38 - STA 20+46.21

SHEET SW-13

SHT 42 OF 54

307Y-4271-3

11-2-41