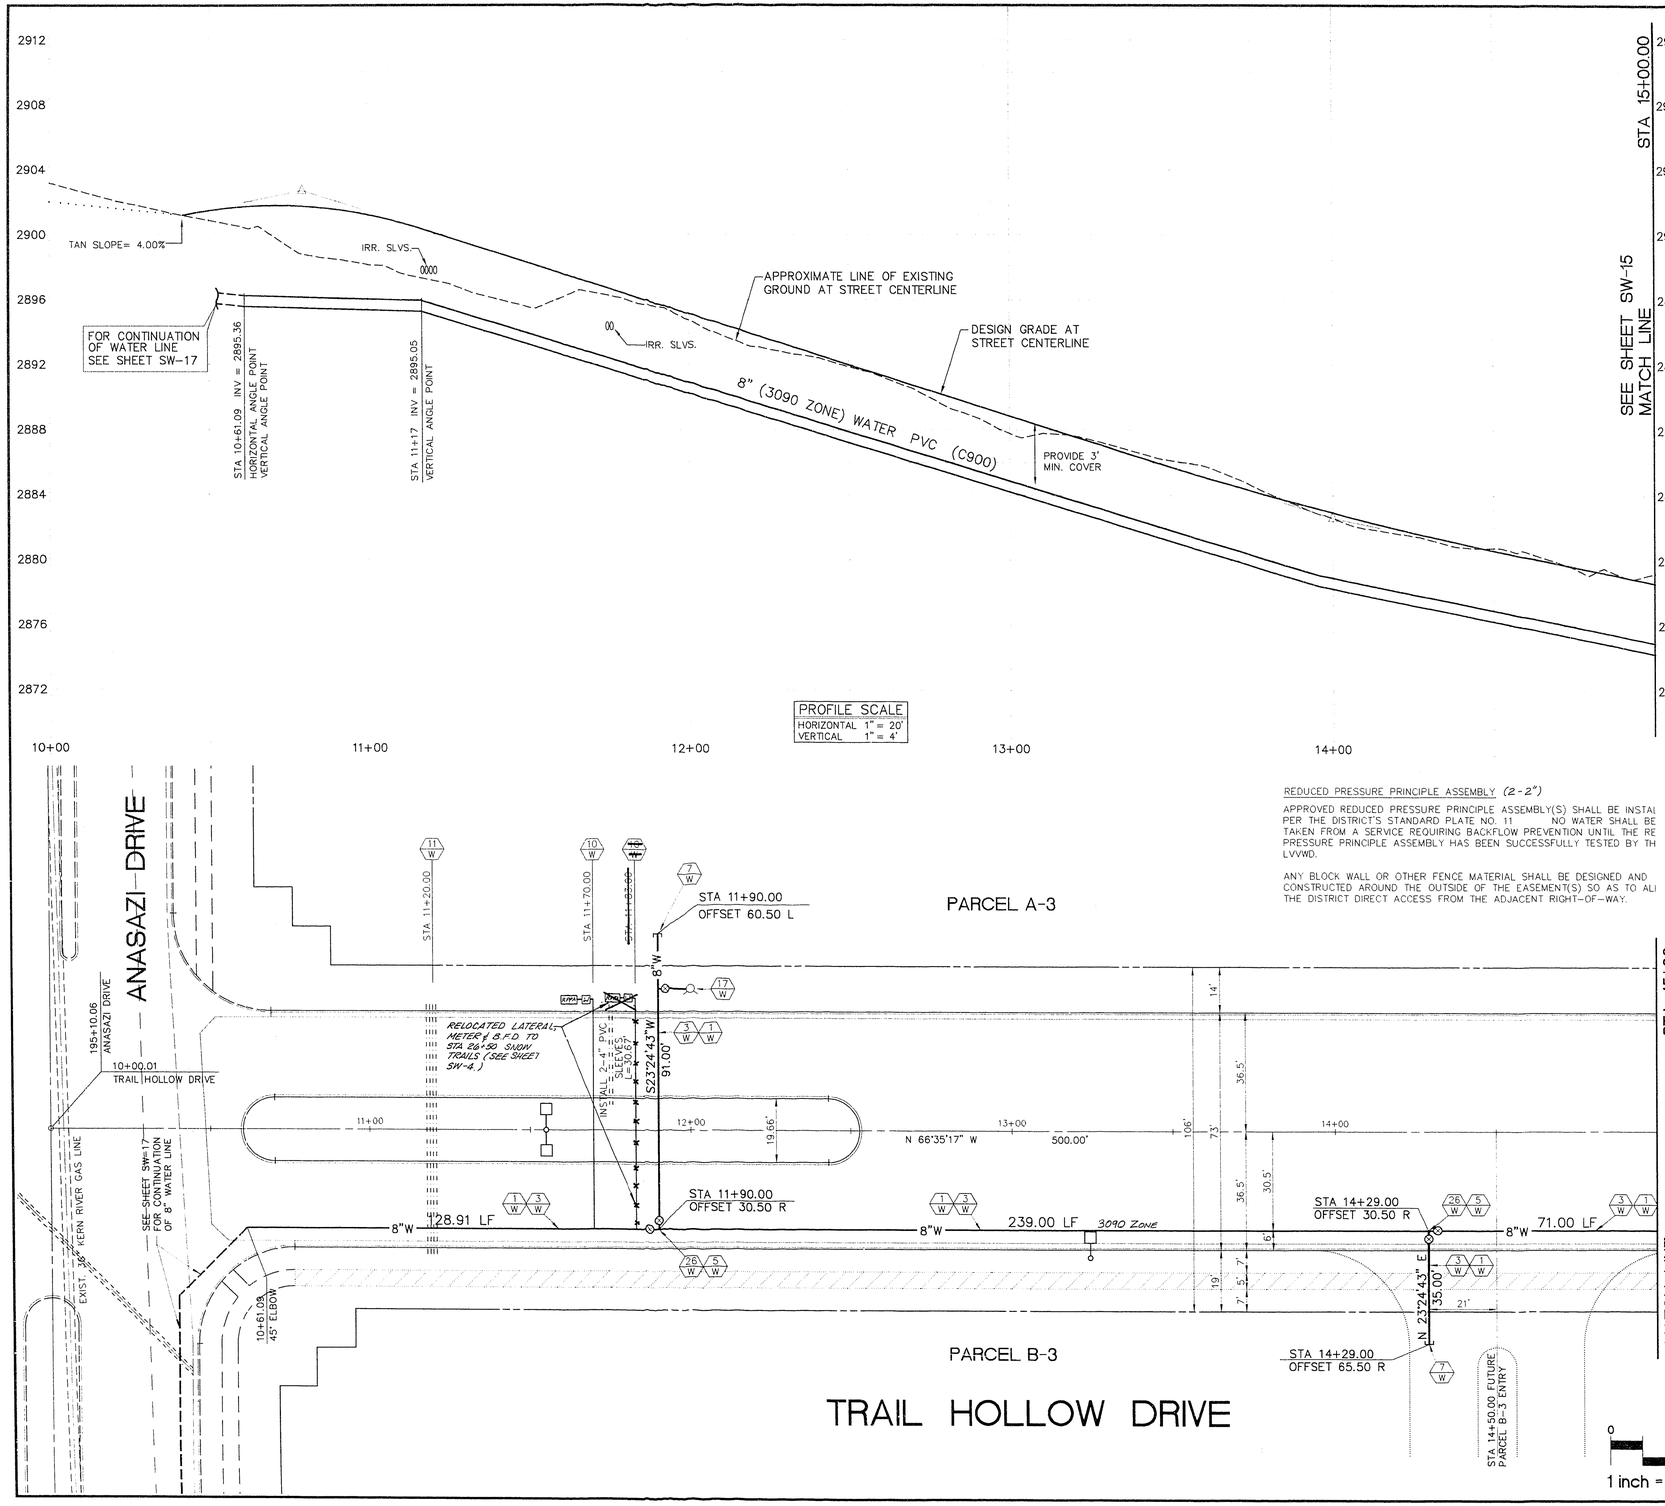

CONSTRUCTION NOTES (WATER)

1 W — INSTALL ALL WATER MAINS AND APPURTENANCES PER L.V.V.W.D. STD. PLATES.

3 W — INSTALL 564.91 L.F. 8" PVC (C-900) WATER PIPE.

5 W — INSTALL 4 EA. 8" GATE VALVE.

7 W — INSTALL 2 EA. END CAP AND CORP STOP (LVVWD STD PLATE NO 4)

10 W — INSTALL 1 EA. 2" METER AND SERVICE LATERAL WITH BACKFLOW PREVENTION DEVICE. PARALLEL TO CURB (LVVWD STD. PLATE NO 11)

11 W — INSTALL 1 SET 2-6" PVC AND 2-4" PVC (SDR-35) SLEEVES FOR FUTURE ELECTRICAL OR IRRIGATION PURPOSES.

17 W — INSTALL 1 EA. FIRE HYDRANT INSTALLATION PER L.V.V.W.D. PLATE NO. 7.

26 W — INSTALL 2 EA. 8" X 8" TEE AND THRUST BLOCK

REDUCED PRESSURE PRINCIPLE ASSEMBLY (2-2")

APPROVED REDUCED PRESSURE PRINCIPLE ASSEMBLY(S) SHALL BE INSTAL PER THE DISTRICT'S STANDARD PLATE NO. 11 NO WATER SHALL BE TAKEN FROM A SERVICE REQUIRING BACKFLOW PREVENTION UNTIL THE RE PRESSURE PRINCIPLE ASSEMBLY HAS BEEN SUCCESSFULLY TESTED BY TH LVVWD.

ANY BLOCK WALL OR OTHER FENCE MATERIAL SHALL BE DESIGNED AND CONSTRUCTED AROUND THE OUTSIDE OF THE EASEMENT(S) SO AS TO ALI THE DISTRICT DIRECT ACCESS FROM THE ADJACENT RIGHT-OF-WAY.

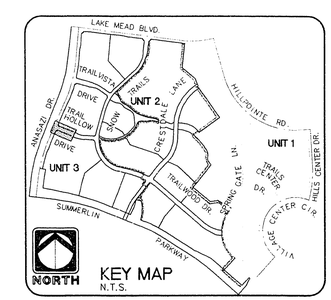

APPROVED FOR CONSTRUCTION

LVVWD 7/21/94 DATE

Avoid cutting underground utility lines. It's costly.
Call before you Dig.
1-800-227-2600
UNDERGROUND SERVICE (USA)

RECORD DRAWING
RECORD INFORMATION PROVIDED BY FIELD CONTRACTOR

RECOMMENDED

- PLANNING
- CIVIL
- STRUCTURAL
- LANDSCAPE
- ARCHITECTURE
- MAPPING
- CONSTRUCTION MANAGEMENT

GARY R. BUSBY
10584 R.P.E.
9/15/94 DATE

REV.	DATE	DESCRIPTION	DATE	APPROVAL

ENGINEER
THE KEITH COMPANIES NEVADA
4962 SO. INDUSTRIAL RD. LAS VEGAS, NV 89103

HOWARD HUGHES PROPERTIES
SUMMERLIN VILLAGE 7 - THE TRAILS - UNIT 3
TRAIL HOLLOW DRIVE
SEWER AND WATER
STA 10+00 - STA 15+00.00

SHEET
SW-14
SHT 43 OF 54

307Y-4271-3

11-2-92