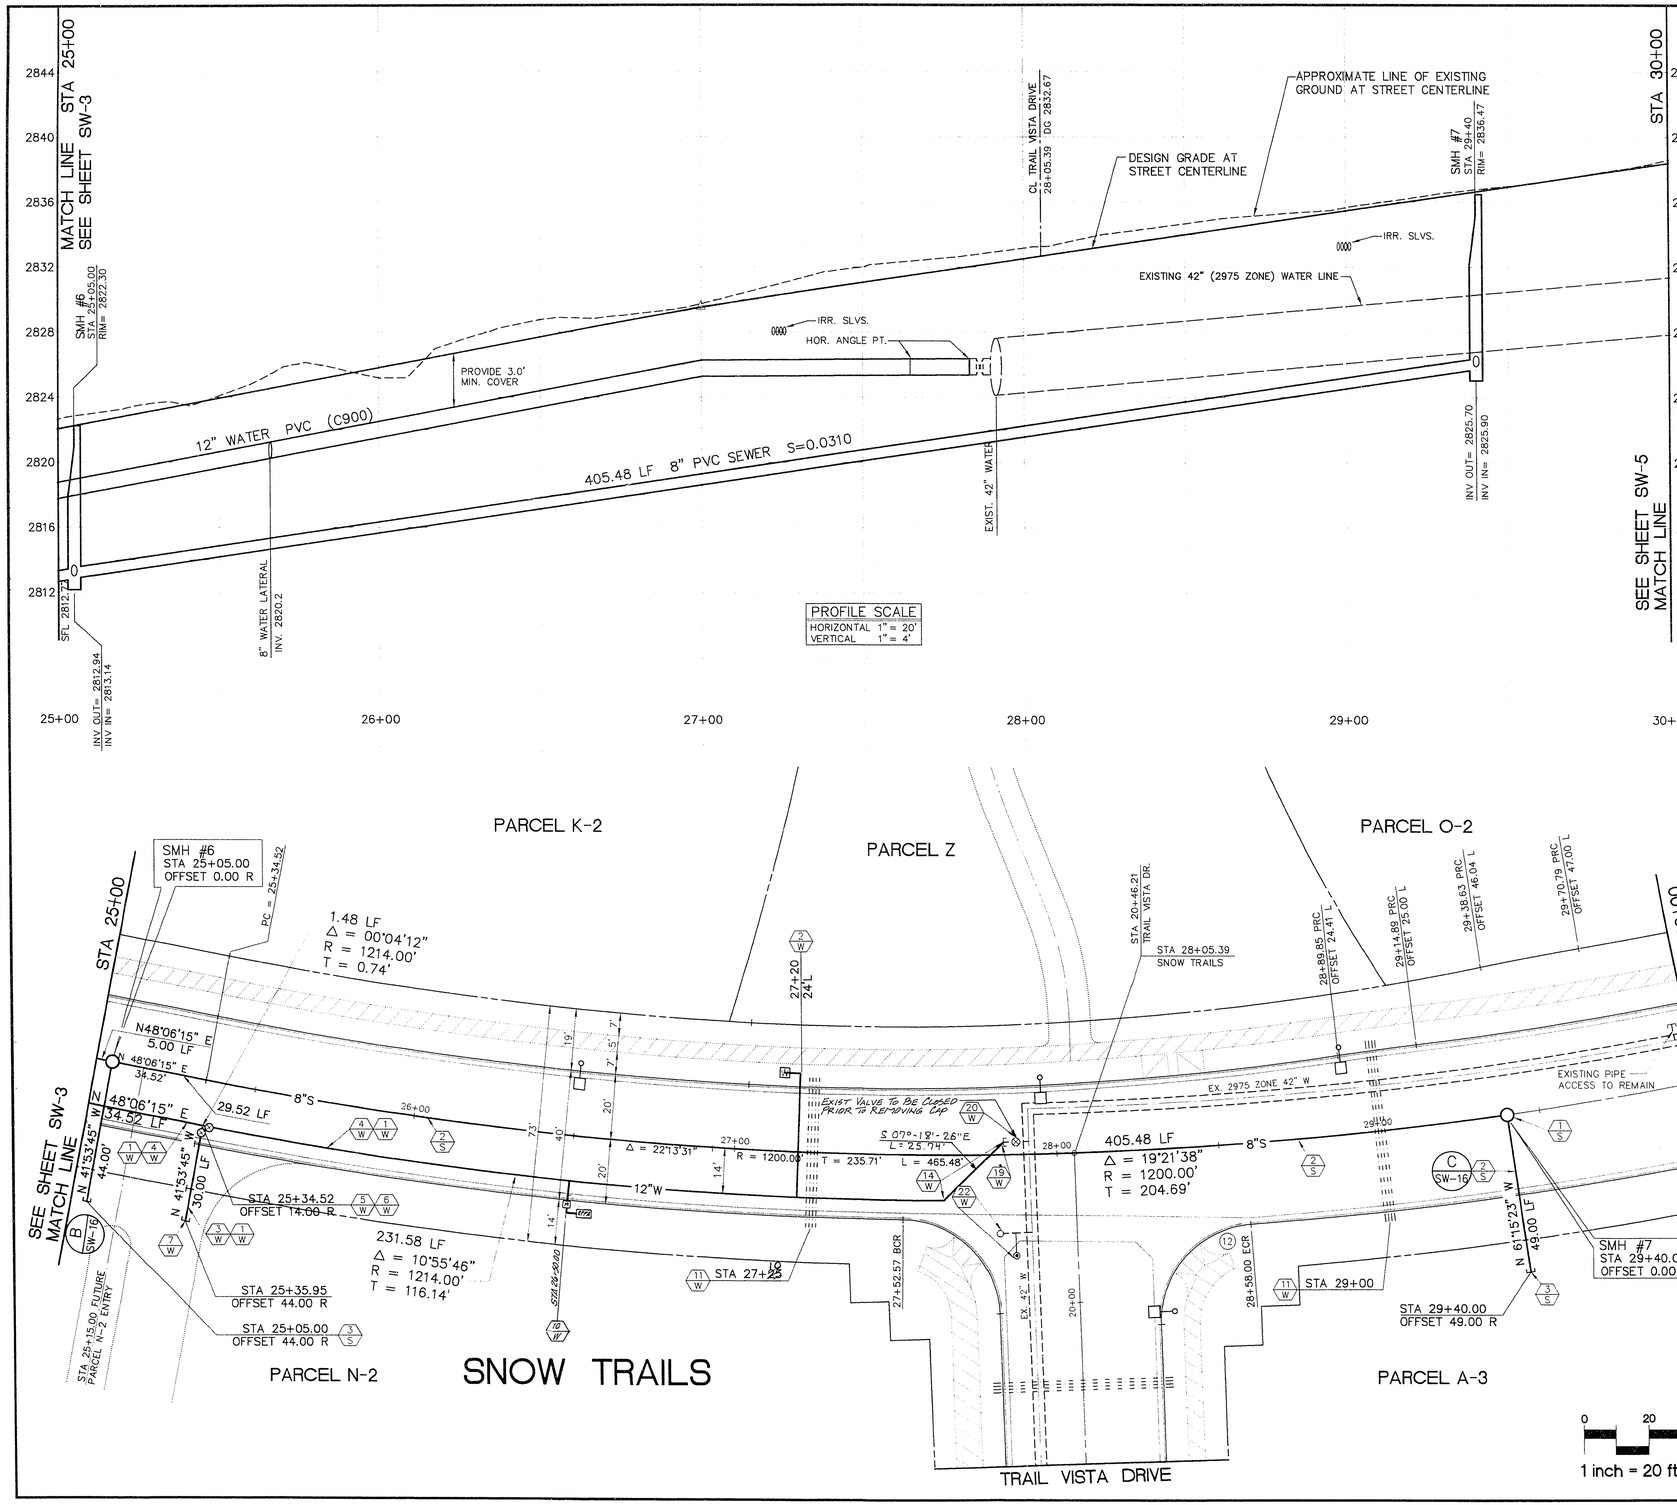

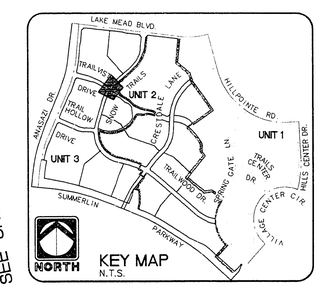

CONSTRUCTION NOTES (SEWER)

1/S INSTALL 2 EA. STANDARD 4' SEWER MANHOLE PER S.I.S. D-2 OR CLARK COUNTY SANITATION DISTRICT STANDARD DRAWINGS.

2/S INSTALL 533.00 L.F. 8" PVC (SDR-35) SEWER LINE.

3/S INSTALL 2 EA. 8" PVC PLUG STUB-OUT PLUG AND CAP.

CONSTRUCTION NOTES (WATER)

1/W INSTALL ALL WATER MAINS AND APPURTENANCES PER L.V.V.W.D. STD. PLATES.

2/W INSTALL 1 EA. 3/4" POTABLE WATER METER PER LVVWD STD. PLATE NO. 2

3/W INSTALL 30.00 L.F. 8" PVC (C-900) WATER PIPE.

4/W INSTALL 1764.40 L.F. 12" PVC (C-900) WATER PIPE.

5/W INSTALL 1 EA. 8" GATE VALVE.

6/W INSTALL 1 EA. 12" GATE VALVE.

7/W INSTALL 1 EA. END CAP AND CORP STOP PER LVVWD STD PL. NO 4.

11/W INSTALL 2 EA. SET 2-6" PVC AND 2-4" PVC (SDR-35) SLEEVES FOR FUTURE ELECTRICAL OR IRRIGATION PURPOSES.

14/W INSTALL 2 EA. 12" X 45° FITTING AND THURST BLOCKS PER L.V.V.W.D.

19/W REMOVE 1 EA. END CAP AND CONNECT TO EXIST. 12" WATER PIPE.

20/W ADJUST 1 EA. EXISTING VALVE COVER TO GRADE

22/W RELOCATE AND ADJUST 1 EA. EXISTING BLOW OFF COVER TO GRADE

10/W INSTALL 1 EA. 2" METER AND SERVICE LATERAL WITH BACKFLOW PREVENTION DEVICE PARALLEL TO CURB (L.V.V.W.D. STD. PLATE No. 11)

REV.	DATE	DESCRIPTION	DATE	APPROVAL

10584 7/19/94
R.P.E. DATE

RECOMMENDED

LVVWD 7/21/94 DATE

RECORD DRAWING
RECORD INFORMATION PROVIDED BY FIELD CONTRACTOR

ENGINEER
THE KEITH COMPANIES NEVADA
4052 S0. INDUSTRIAL RD. LAS VEGAS, NV. 89103
• PLANNING
• CIVIL
• ENGINEERING
• SURVEYING
• ARCHITECTURE
• LAND SURVEYING
• CONSTRUCTION MANAGEMENT
(702) 733-0350

HOWARD HUGHES PROPERTIES
SUMMERLIN VILLAGE 7 - THE TRAILS - UNIT 3
SNOW TRAILS
SEWER AND WATER
STA 25+00 - STA 30+00

SHEET
SW-4
SHT 33 OF 54

11-2-32

307Y-4271-3