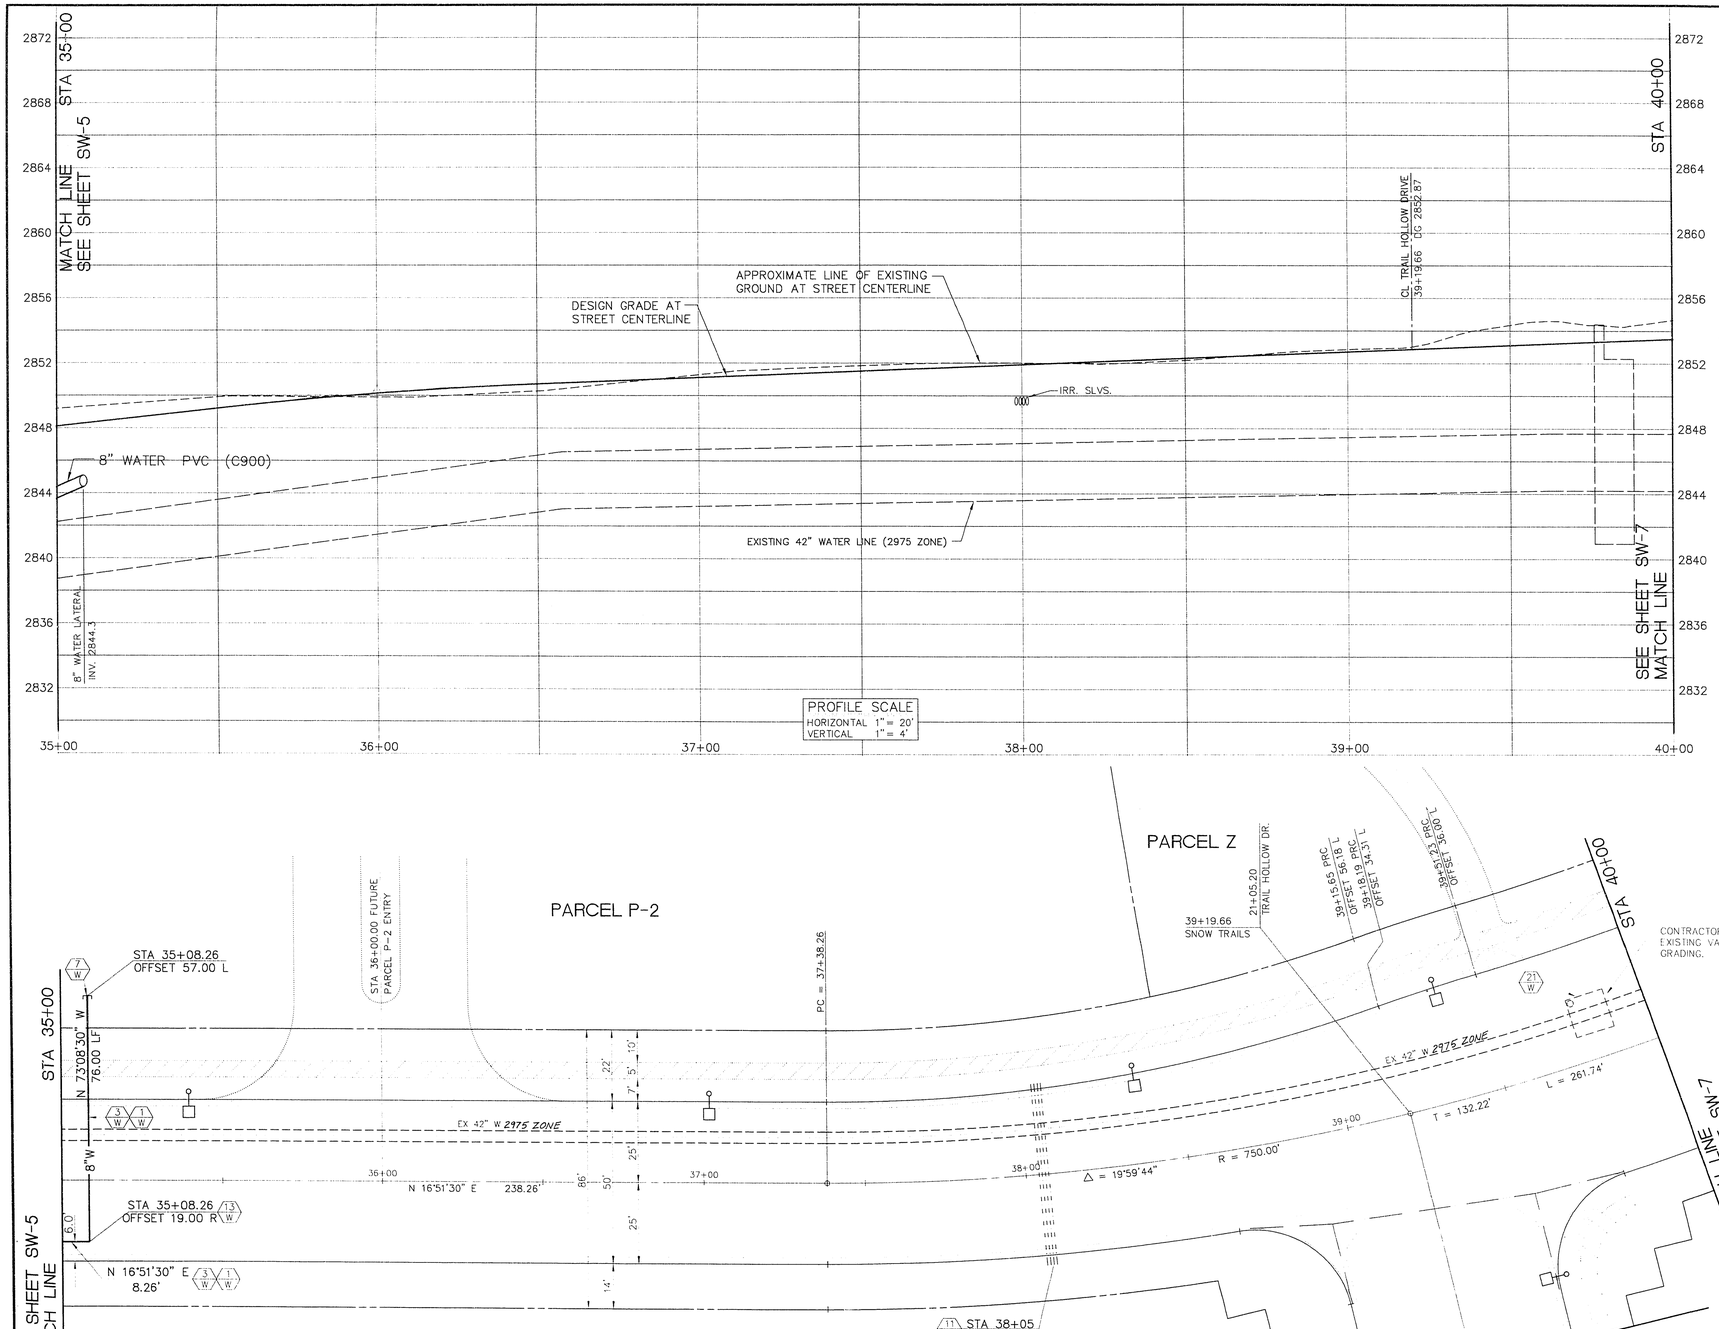

CONSTRUCTION NOTES (WATER)

1 W — INSTALL ALL WATER MAINS AND APPURTENANCES PER L.V.V.W.D. STD. PLATES.

3 W — INSTALL 84.26 L.F. 8" PVC (C-900) WATER PIPE.

7 W — INSTALL 1 EA. END CAP AND CORP STOP (LVVWD STD. PLATE NO. 4)

11 W — INSTALL 1 EA. SET 2-6" PVC AND 2-4" PVC (SDR-35) SLEEVES FOR FUTURE ELECTRICAL OR IRRIGATION PURPOSES.

13 W — INSTALL 1 EA. 8" X 90° FITTING AND THRUST BLOCK PER L.V.V.W.D. STD. PLATE NO. 5.

21 W — ADJUST 1 EA. EXISTING MANHOLE LID TO GRADE

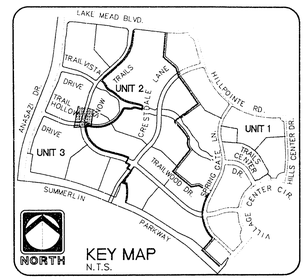

LVVWD 7/21/94 DATE

Call before you Dig. 1-800-227-2600

RECORD DRAWING

RECORD INFORMATION PROVIDED BY FIELD CONTRACTOR

RECOMMENDED

10584 7/19/94
R.P.E. DATE

REV.	DATE	DESCRIPTION	DATE	APPROVAL

PLANNING
LAND DEVELOPMENT
ENGINEERING
ARCHITECTURE
LANDSCAPE ARCHITECTURE
SURVEYING
MANAGEMENT

ENGINEER
THE KEITH COMPANIES NEVADA
8050 W. ROBINDALE RD. LAS VEGAS, NV 89113 (702) 735-0050

HOWARD HUGHES PROPERTIES
SUMMERLIN VILLAGE 7 - THE TRAILS - UNIT 3
SNOW TRAILS
SEWER AND WATER
STA 35+00 - STA 40+00

SHEET
SW-6
SHT 35 OF 54

307Y-4271-3

11-2-94