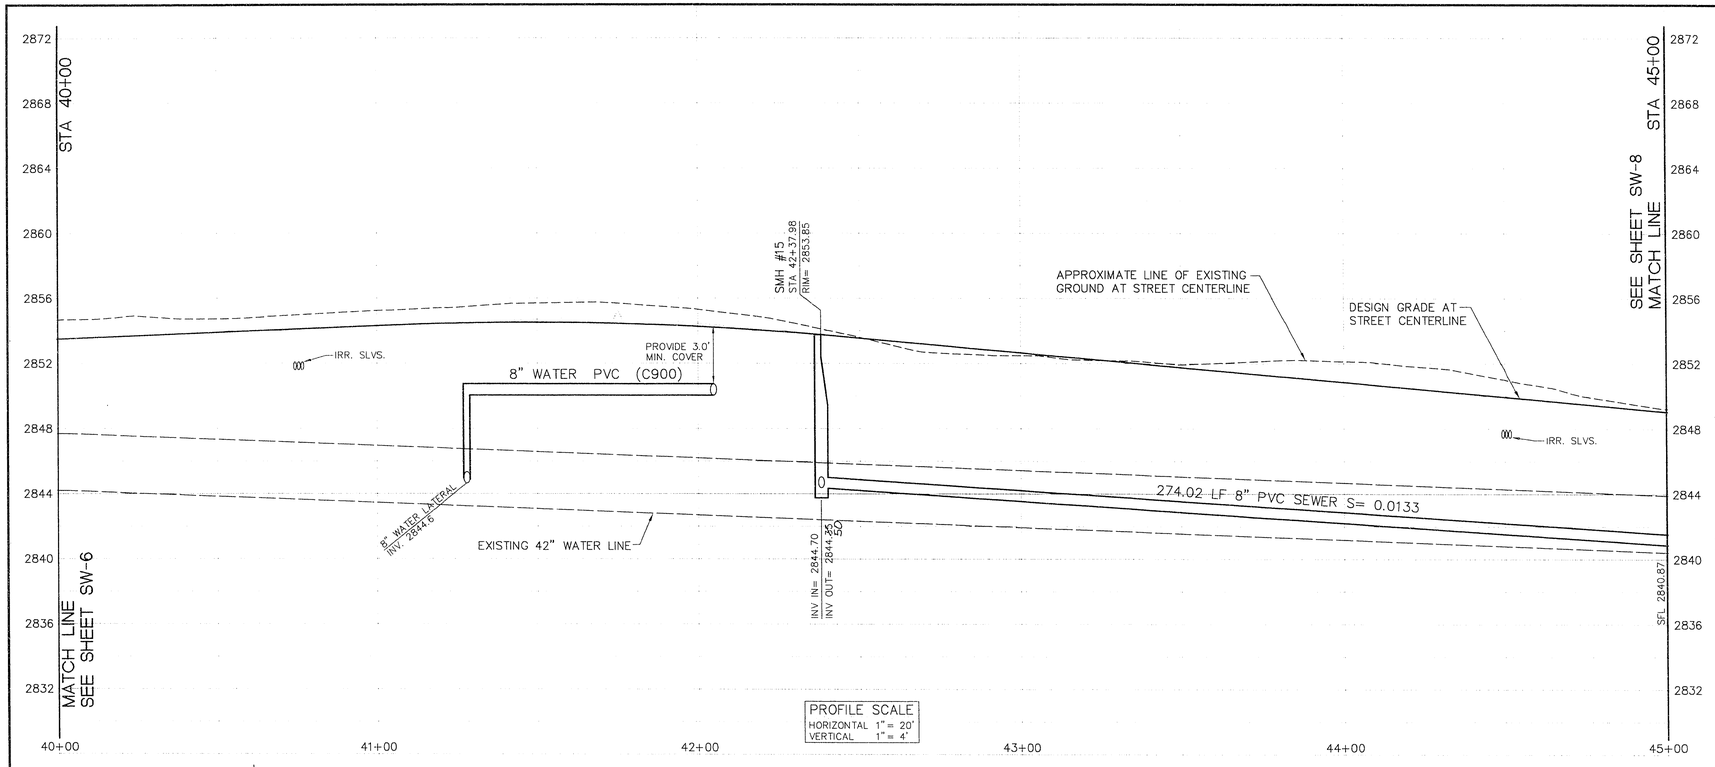

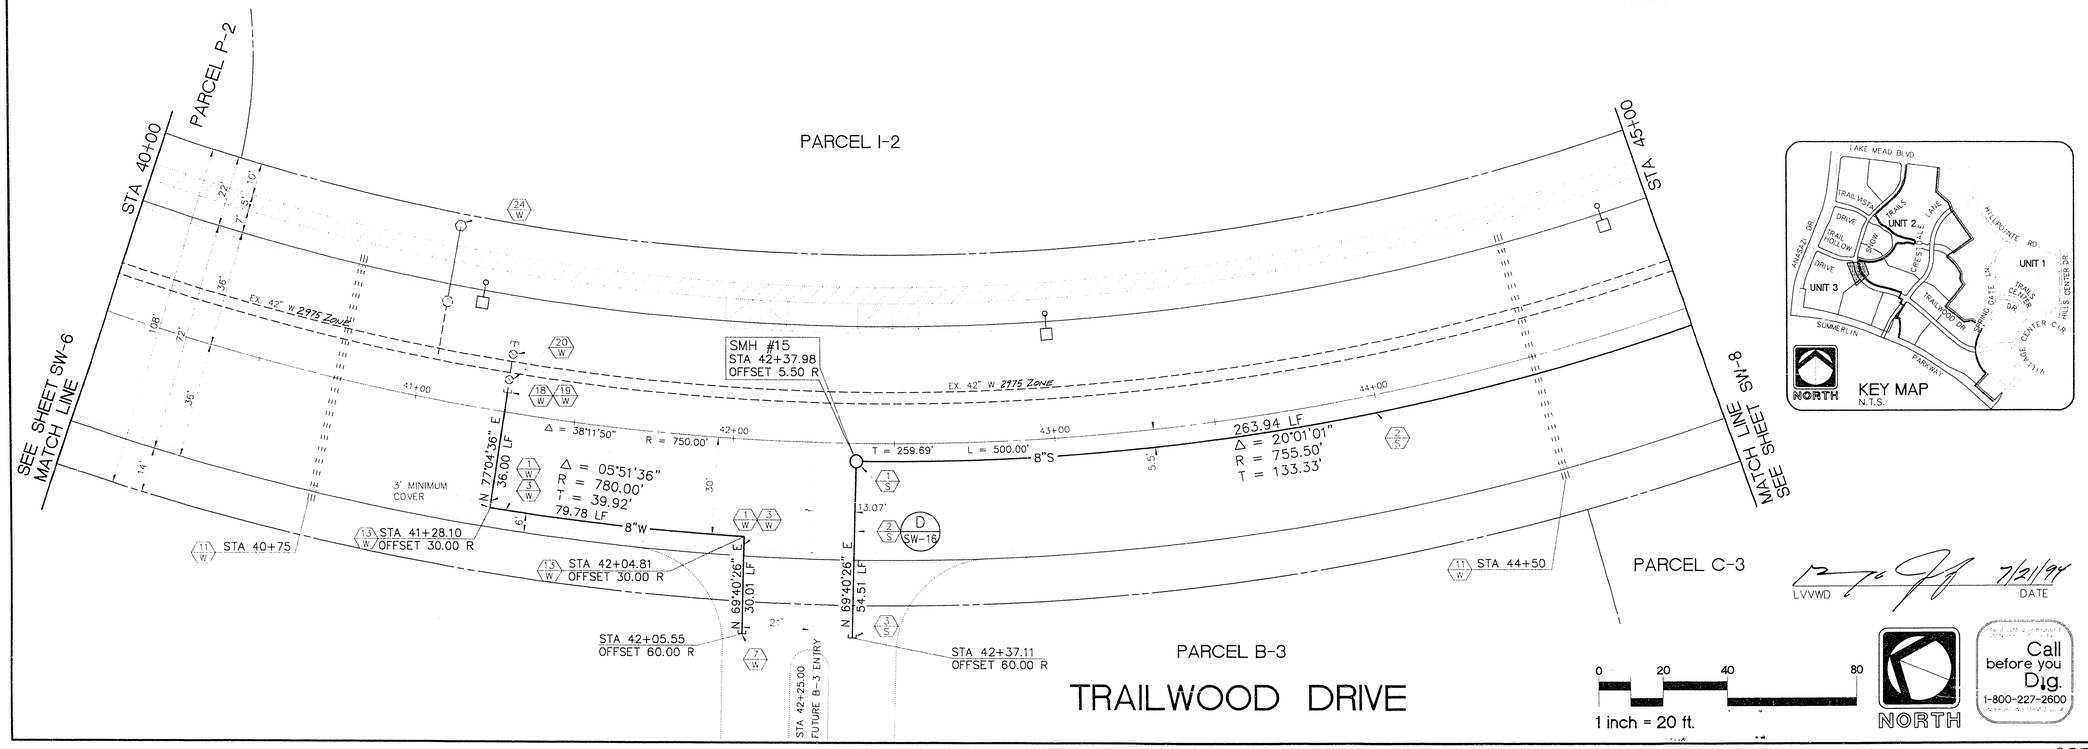

CONSTRUCTION NOTES (SEWER)

1 S — INSTALL 1 EA. STANDARD 4' SEWER MANHOLE PER S.I.S. D-2 OR CLARK COUNTY SANITATION DISTRICT STANDARD DRAWINGS.

2 S — INSTALL 318.45 L.F. 8" PVC (SDR-35) SEWER LINE.

3 S — INSTALL 1 8" PVC PLUG STUB-OUT PLUG AND CAP.

CONSTRUCTION NOTES (WATER)

1 W — INSTALL ALL WATER MAINS AND APPURTENANCES PER L.V.V.W.D. STD. PLATES.

3 W — INSTALL 145.79 L.F. 8" PVC (C-900) WATER PIPE.

7 W — INSTALL 1 EA. END CAP AND CORP STOP (LVVWD STD. PLATE NO. 4)

11 W — INSTALL 2 EA. SET 1-6" PVC AND 2-4" PVC (SDR-35) SLEEVES FOR FUTURE ELECTRICAL OR IRRIGATION PURPOSES.

12 W — INSTALL 2 EA. 8" X 90° FITTING AND THRUST BLOCK PER L.V.V.W.D. STD. PLATE NO. 5.

18 W — INSTALL 1 EA. 12" X 8" REDUCER.

19 W — REMOVE 1 EA. END CAP AND CONNECT TO EXIST. 12" WATER PIPE

20 W — ADJUST 2 EA. EXISTING VALVE COVER TO GRADE

24 W — RELOCATE 1 EA. EXISTING TEST STATION (SEE DETAIL ON SW-5)

RECORD DRAWING
RECORD INFORMATION PROVIDED BY FIELD CONTRACTOR

RECOMMENDED

10584 5/19/94
R.P.E. DATE

LVVWD 7/21/94 DATE

REV.	DATE	DESCRIPTION	DATE	APPROVAL

PLANNING
ENGINEERING
SURVEYING
ARCHITECTURE
ASSET PROTECTING
ASSET MANAGEMENT

ENGINEER
THE KEITH COMPANIES NEVADA

HOWARD HUGHES PROPERTIES
SUMMERLIN VILLAGE 7 - THE TRAILS - UNIT 3
TRAILWOOD DRIVE
SEWER AND WATER
STA 40+00 - STA 45+00

Call before you Dig. 1-800-227-2600

SHEET
SW-7
SHT 36 OF 54

307Y-4271-3

11-2-3-