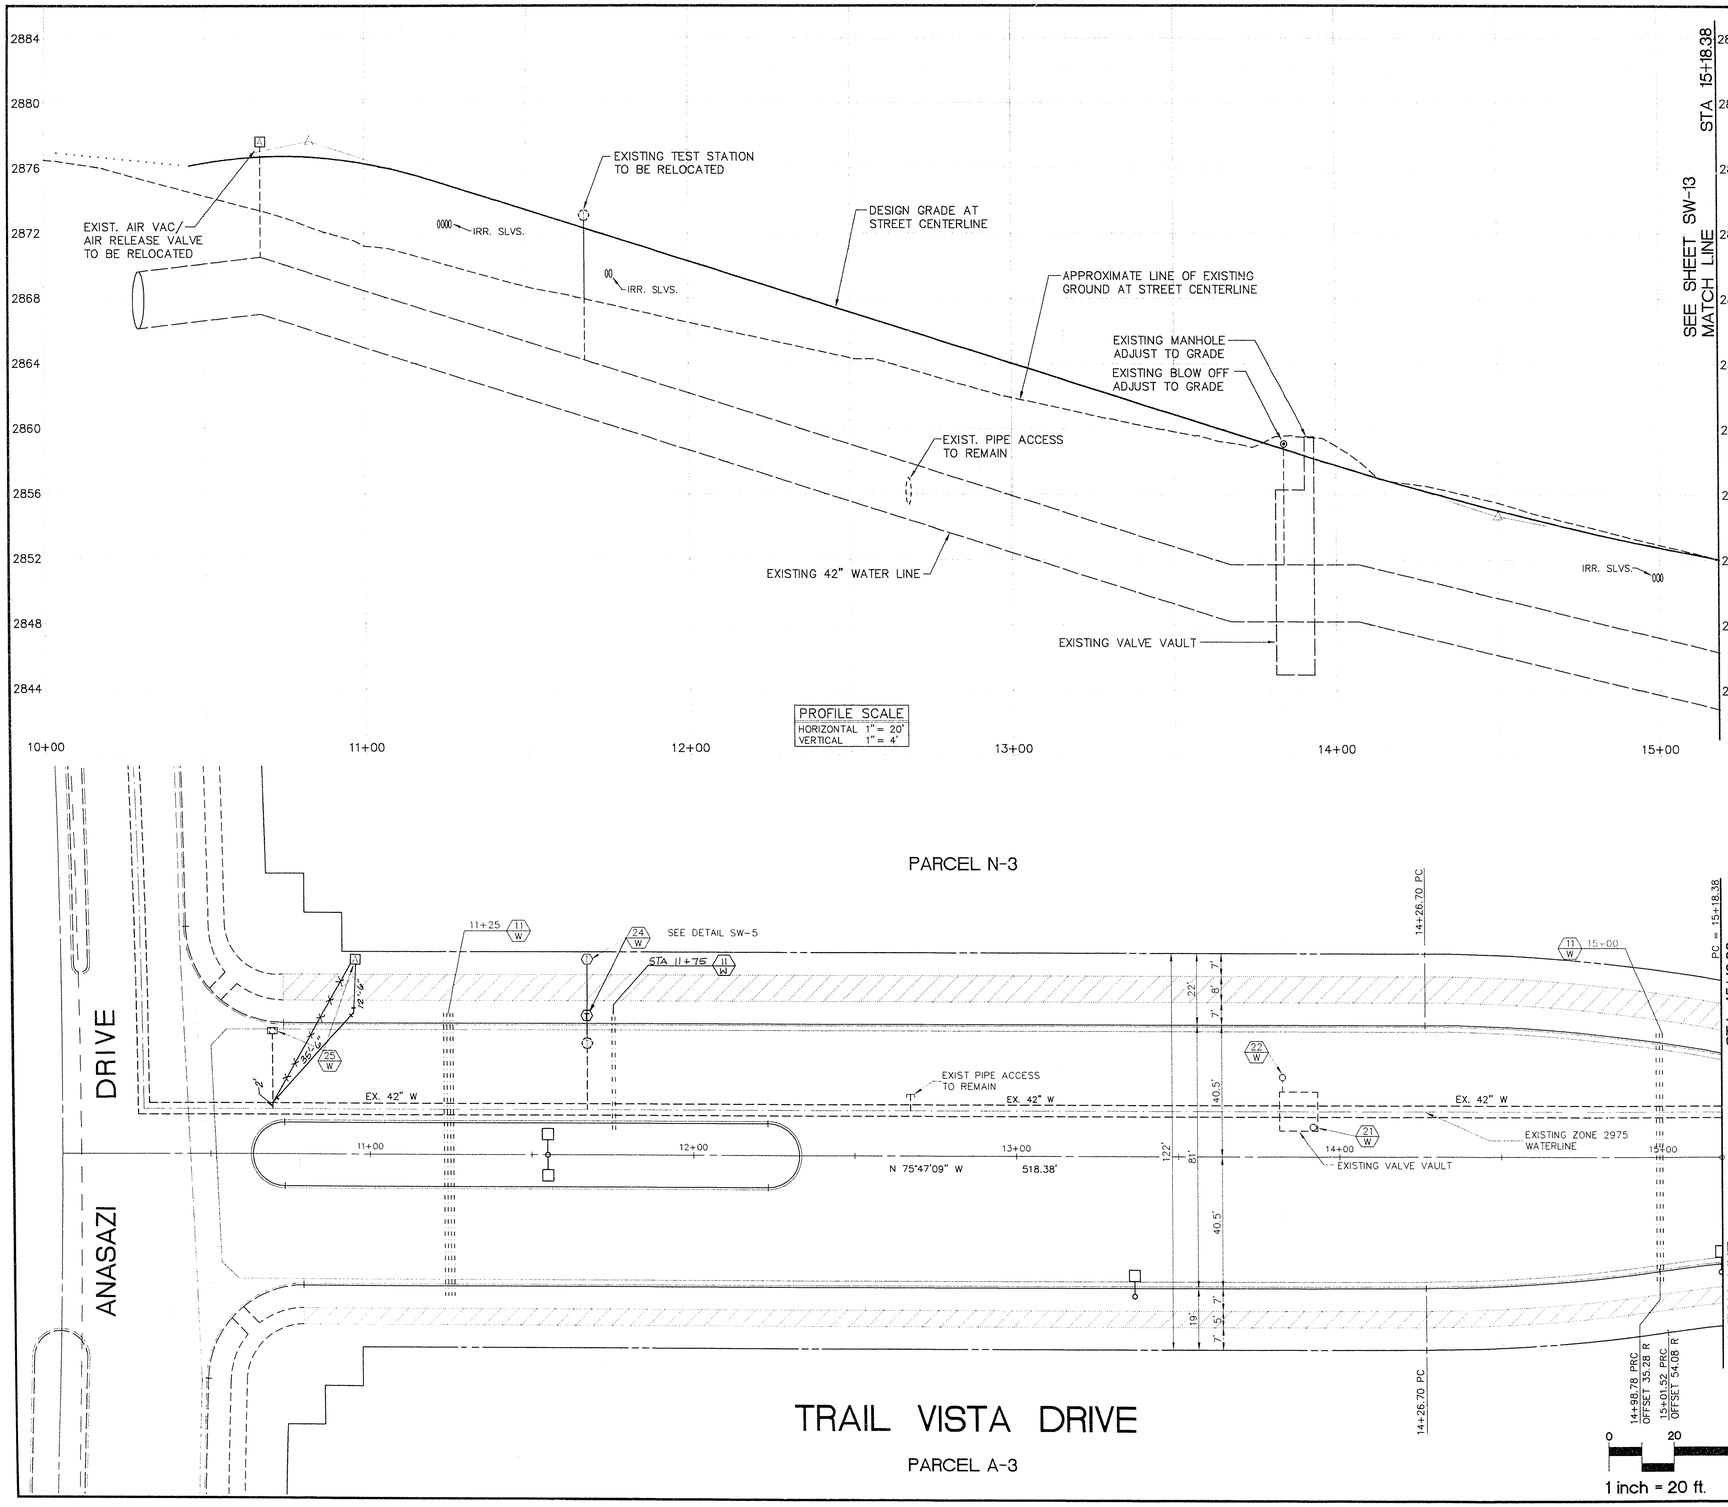

CONSTRUCTION NOTES (WATER)

1/W INSTALL ALL WATER MAINS AND APPURTENANCES PER L.V.V.W.D. STD. PLATES.

11/W INSTALL 2 EA.; 1 SET 2-6" PVC AND 2-4" PVC AND AND 1 SET 1-6" PVC AND 2-4" PVC AS SHOWN ON PLANS FOR FUTURE ELECT. OR IRRIGATION PURPOSES (SDR-35).

21/W ADJUST 1 EA. EXISTING MANHOLE LID TO GRADE

22/W ADJUST EXISTING BLOW OFF COVER TO GRADE

24/W RELOCATE 1 EA. EXISTING TEST STATION (SEE DETAIL ON SW-5)

25/W RELOCATE 1 EA. EXISTING AIR VACUM/AIR RELASE ASSEMBLY

REV.	DATE	DESCRIPTION	DATE	APPROVAL

RECORD DRAWING

RECORD INFORMATION PROVIDED BY FIELD CONTRACTOR

RECOMMENDED

GARY R. BUSBY 10584 R.P.E. DATE 2/19/97

LVVWD DATE 7/21/94

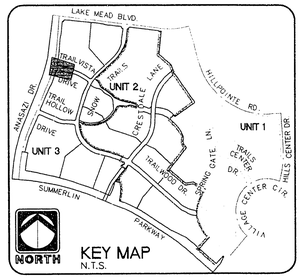

KEY MAP
N.T.S.

ENGINEER
THE KOITH COMPANIES NEVADA
4062 SO. INDUSTRIAL RD. LAS VEGAS, NV 89103

- PLANNING
- CIVIL ENGINEERING
- LAND SURVEYING
- ARCHITECTURE
- LANDSCAPE ARCHITECTURE
- CONSTRUCTION MANAGEMENT

LAS VEGAS, NV 89103 (702) 733-6850

HOWARD HUGHES PROPERTIES
SUMMERLIN VILLAGE 7 - THE TRAILS - UNIT 3
TRAIL VISTA DRIVE
SEWER AND WATER
STA 10+00 - STA 15+18.38

SHEET
SW-12
SHT 41 OF 54

Call before you Dig.
1-800-227-2600
UNDERGROUND SERVICE (USA)

11-2-90

307Y-4271-3