STREET STRIPING AND SIGNAGE NOTES

1 SS — ALL STREET SIGNS SHALL BE IN CONFORMANCE WITH THE MANUAL OF UNIFORM TRAFFIC CONTROL DEVICES (MUTCD) LATEST EDITION.

2 SS — INSTALL 2 EA. R1-1 (30" X 30") STOP SIGN.

3 SS — INSTALL 2 EA. R2-1 (24" X 30") 25 M.P.H. SPEED LIMIT SIGN.

7 SS — INSTALL 380.00 SF CROSSWALK PER S.I.S. STD. NO. S-78 WITH THERMOPLASTIC PER SPECIFICATIONS.

8 SS — INSTALL 1460.00 LF CONTINUOUS LEFT TURN LANE LINE PER S.I.S. STD. NO. S-90.

9 SS — INSTALL 1840.00 LF BROKEN LANE LINE PER S.I.S. STD. NO. S-89.

10 SS — INSTALL 72 SF STOP LINE MARKERS 24" WIDE WHITE COLD LAY THERMOPLASTIC PER S.I.S. STD. DWG. NO. S-78.

13 SS — INSTALL 1 EA. 9" STREET NAME SIGN PER CLARK COUNTY STDS. 250 & 251

14 SS — INSTALL 1 EA. 6" STREET NAME SIGN PER CLARK COUNTY STDS. 250 & 251

NOTE:
ALL STRIPING SHOWN IS FUTURE AND NOT IN THIS CONTRACT. STRIPING TO BE INSTALLED AFTER FINAL 1" OVERLAY.

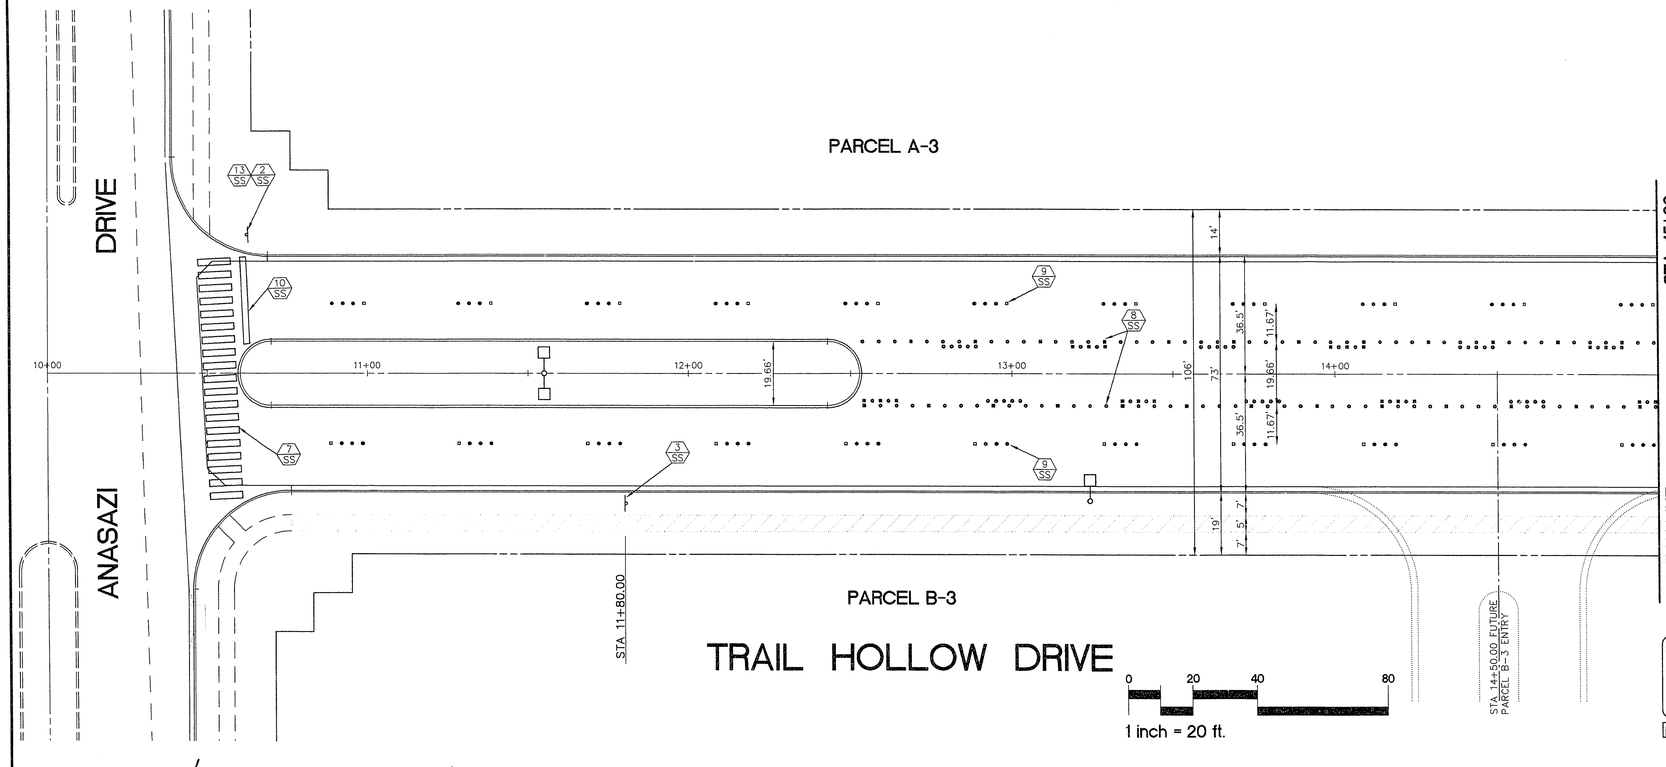

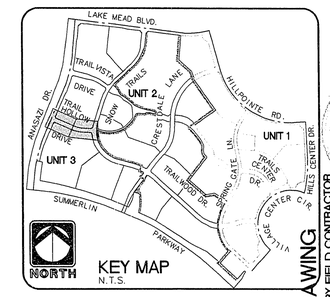

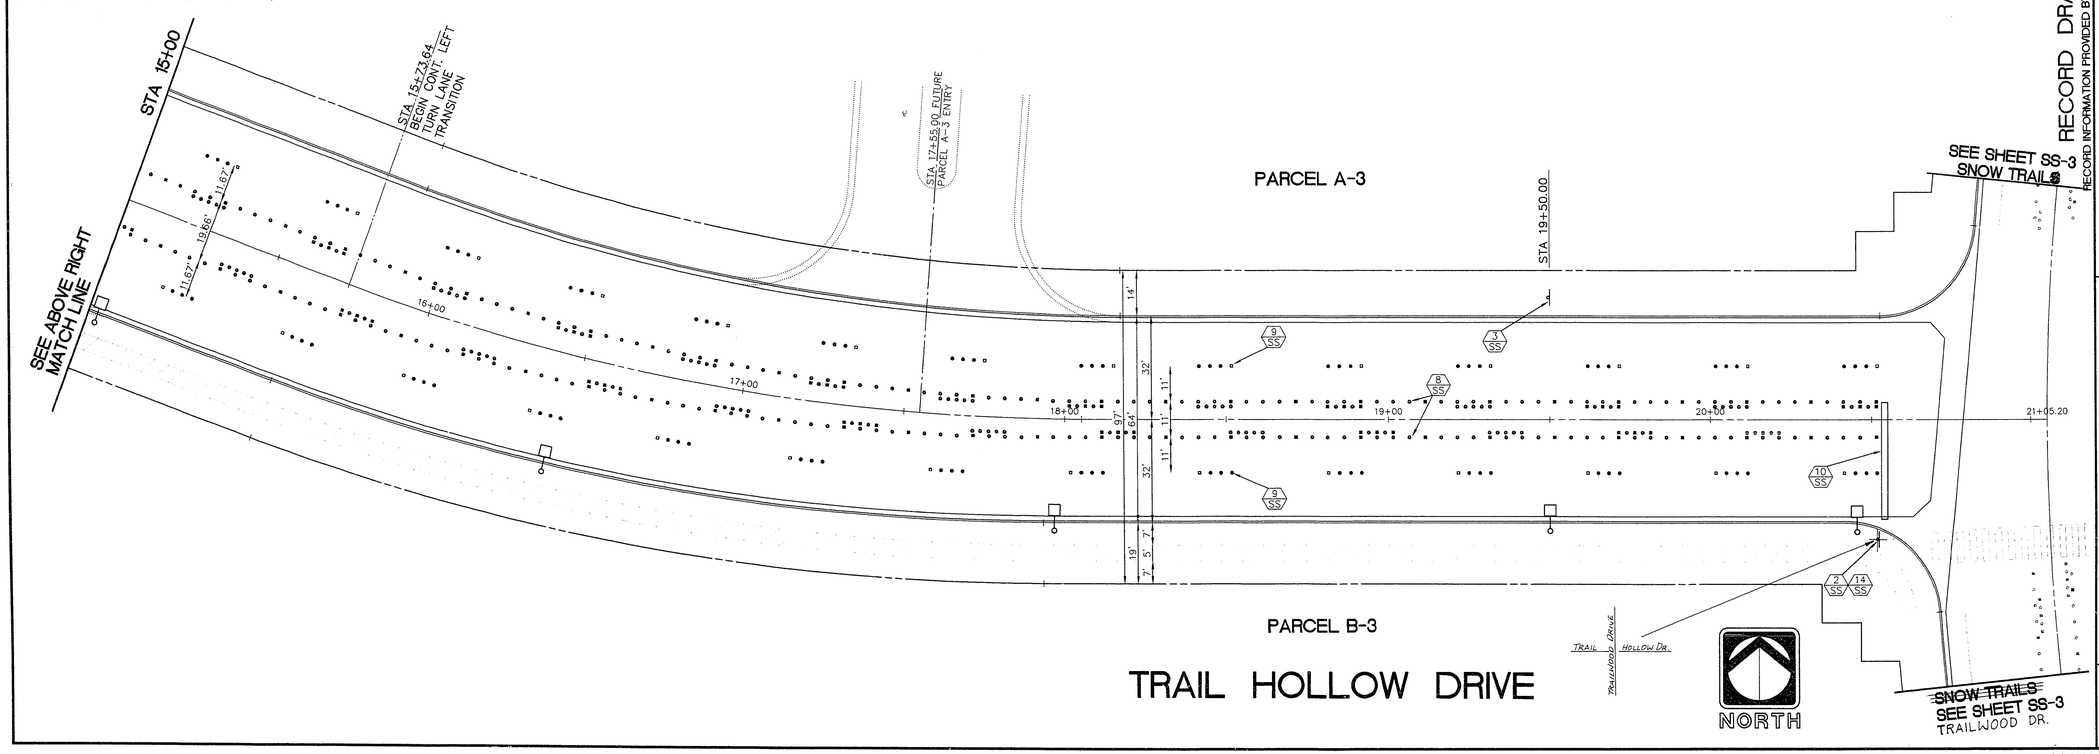

RECORD DRAWING
RECORD INFORMATION PROVIDED BY FIELD CONTRACTOR

REV.	DATE	DESCRIPTION	DATE	APPROVAL

RECOMMENDED
GARY R. BUSS R.P.E. 10584 DATE

ENGINEER
THE KEITH COMPANIES NEVADA
4032 SO. INDUSTRIAL RD. LAS VEGAS, NV. 89103 (702) 733-0050

- PLANNING
- CIVIL ENGINEERING
- LANDSCAPE ARCHITECTURE
- LAND SURVEYING
- CONSTRUCTION MANAGEMENT

HOWARD HUGHES PROPERTIES
SUMMERLIN VILLAGE 7 - THE TRAILS - UNIT 3
TRAIL HOLLOW DRIVE
SIGNING AND STRIPING
STA 10+00 - STA 21+05.20

SHEET
SS-8
SHT 54 OF 54

107Y-4271-3

D:\SUM4071P\4075S08 wed Jul 20 09:34:17 1994 SHADED 1-9,WHITEOUT 10, SOLID 11 & UP- 486-50W1
HP DesignJet 600:! HP-GL/2 ADI 4.2 plotter driver by Hewlett-Packard 1.0