
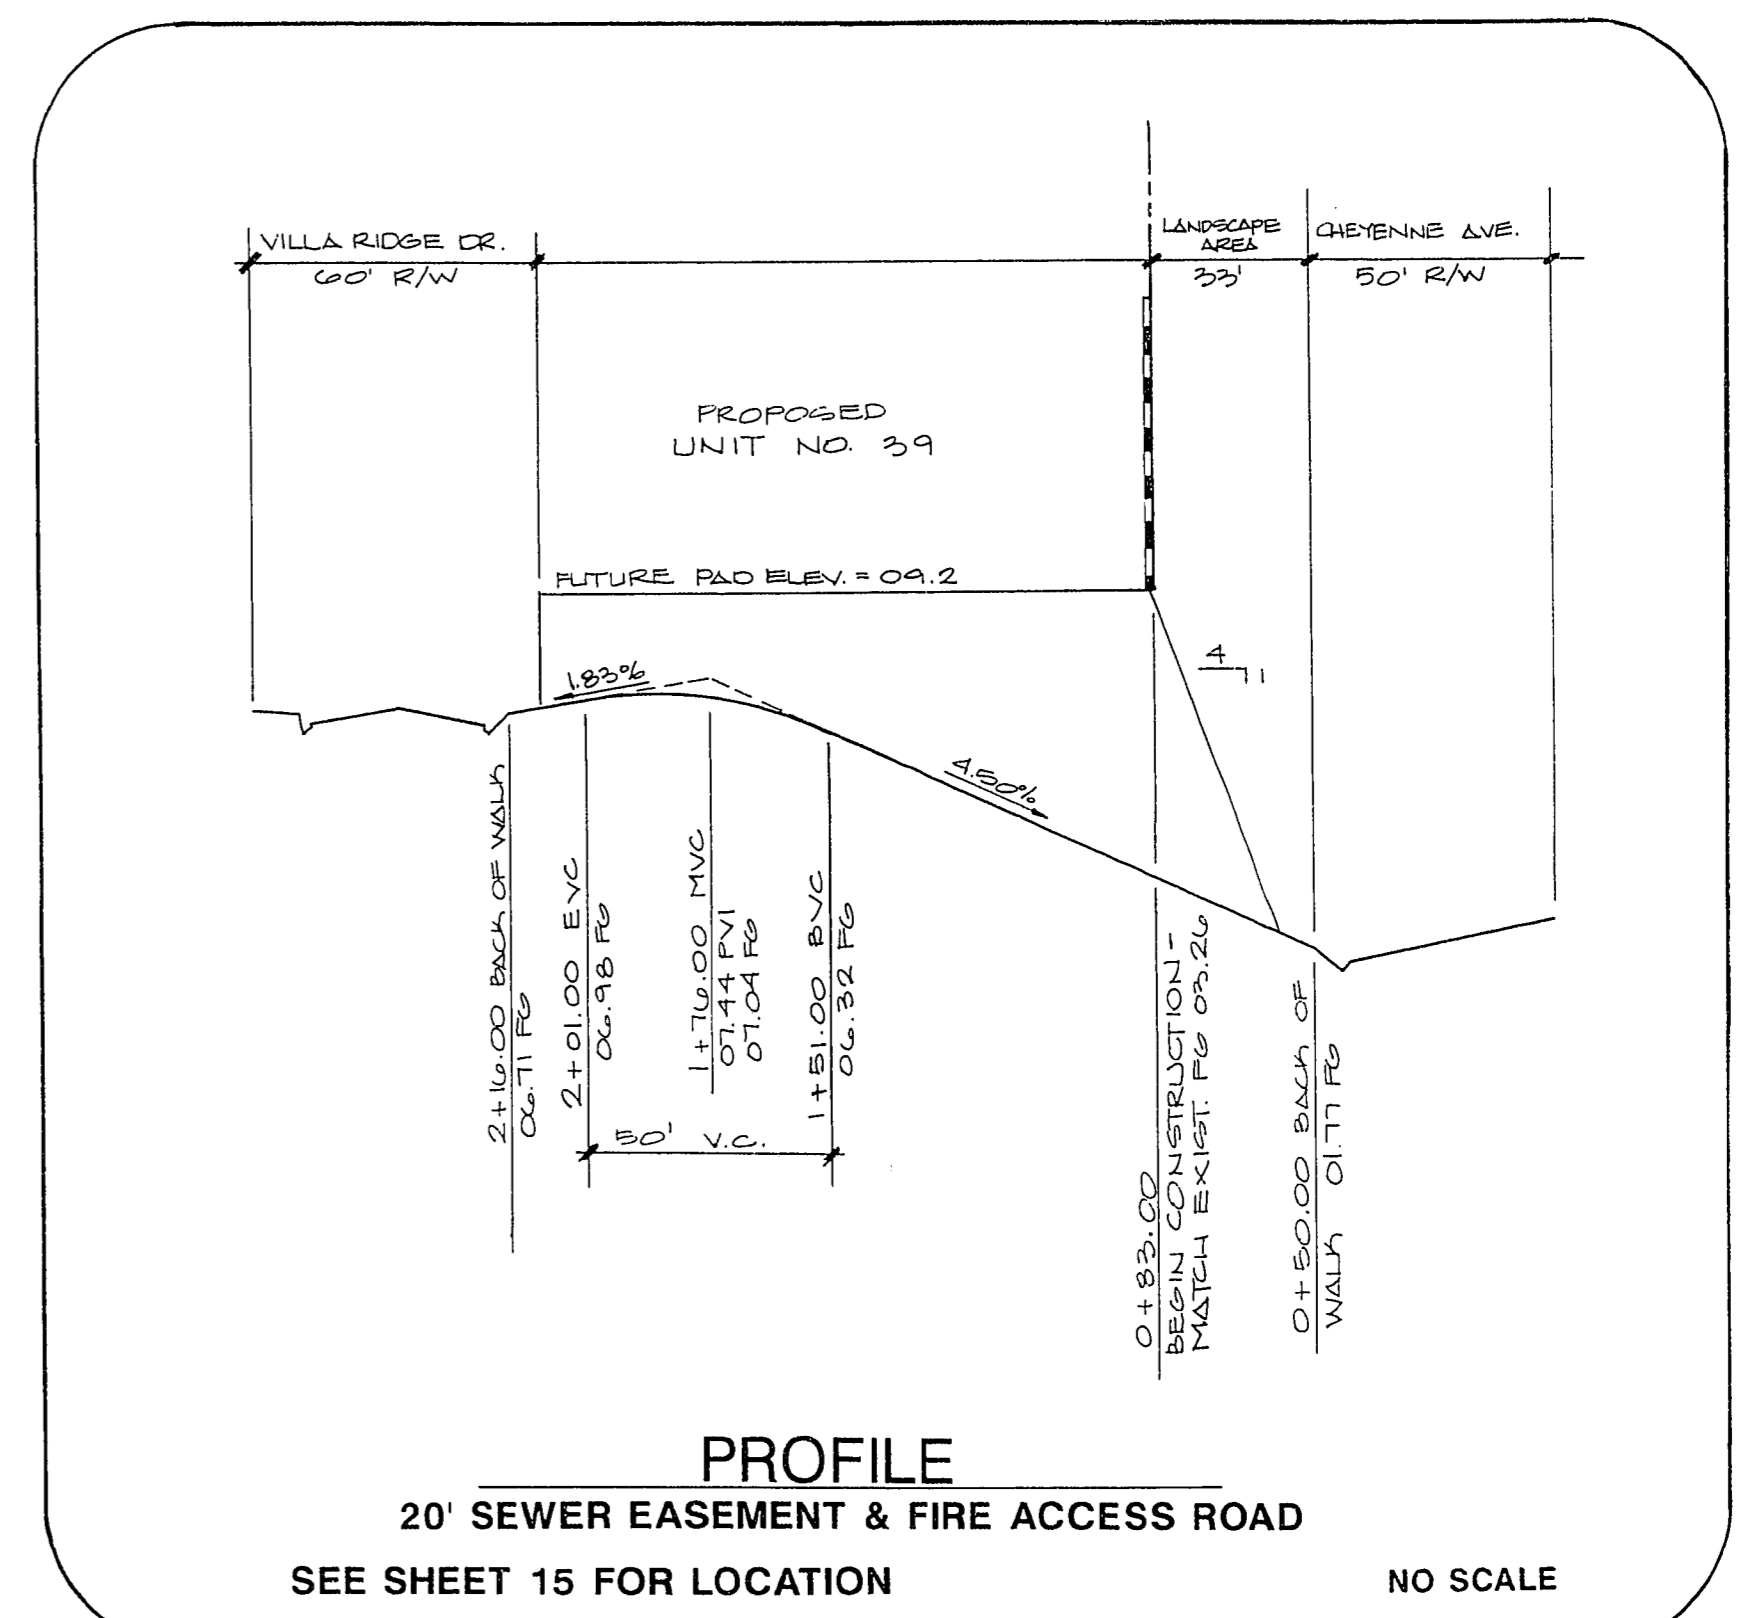
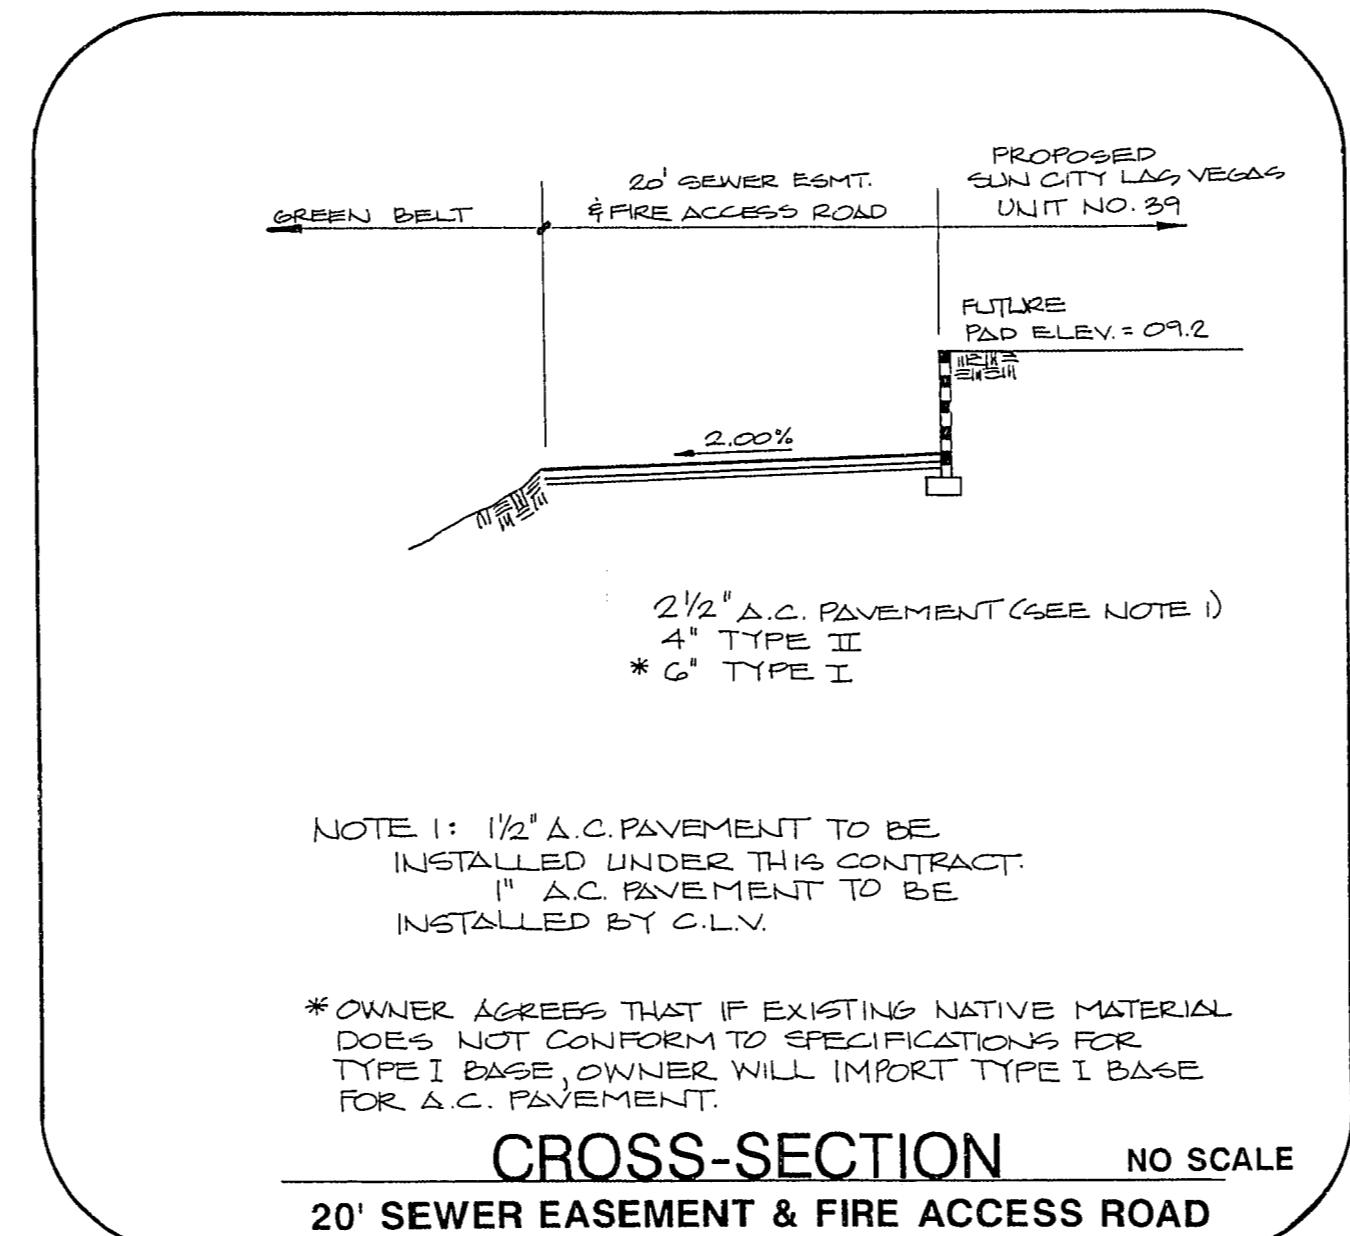


Call before you Dig.
 1-800-227-2600
 UNDERGROUND SERVICE (USA)

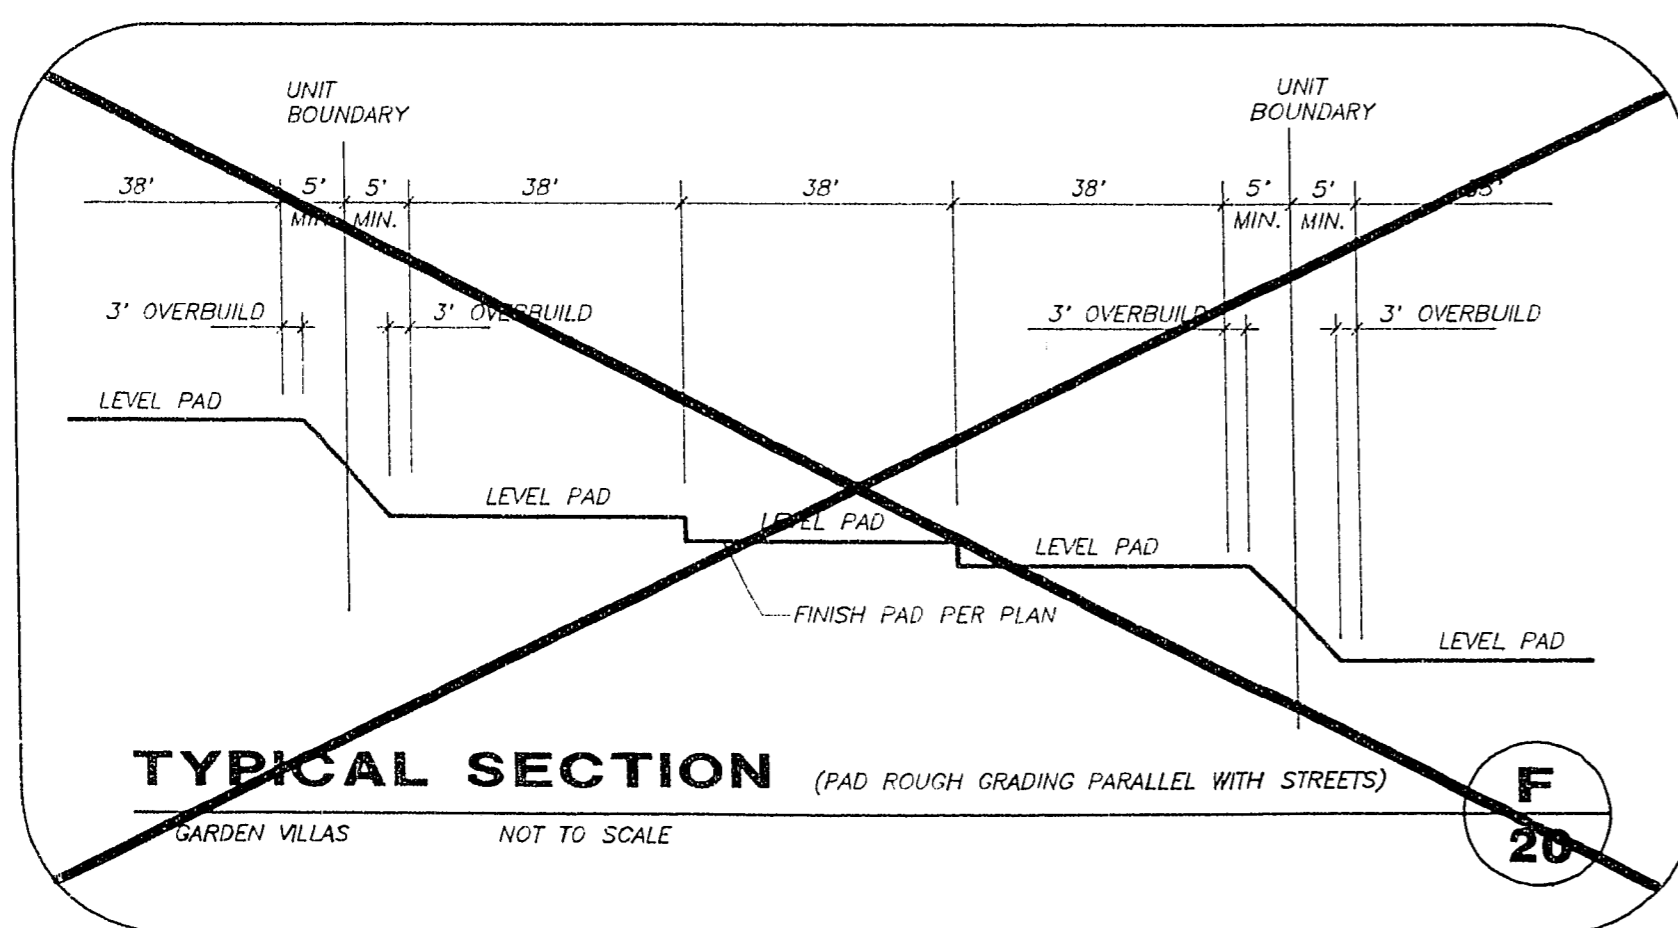

REV.	DATE	DESCRIPTION	C.L.V.	DATE

RECOMMENDED: MICHAEL D. WALLACE, ENGINEER, STATE OF NEVADA, NO. 6718

DEL WEBB COMMUNITIES, INC.
 SUN CITY LAS VEGAS UNIT NO. 37
GRADING DETAILS II

SHEET 20 OF 28 SHEETS

G.C. WALLACE, INC.
 Engineering/Architecture
 1555 SOUTH RAINBOW BLVD., LAS VEGAS, NEVADA 89102