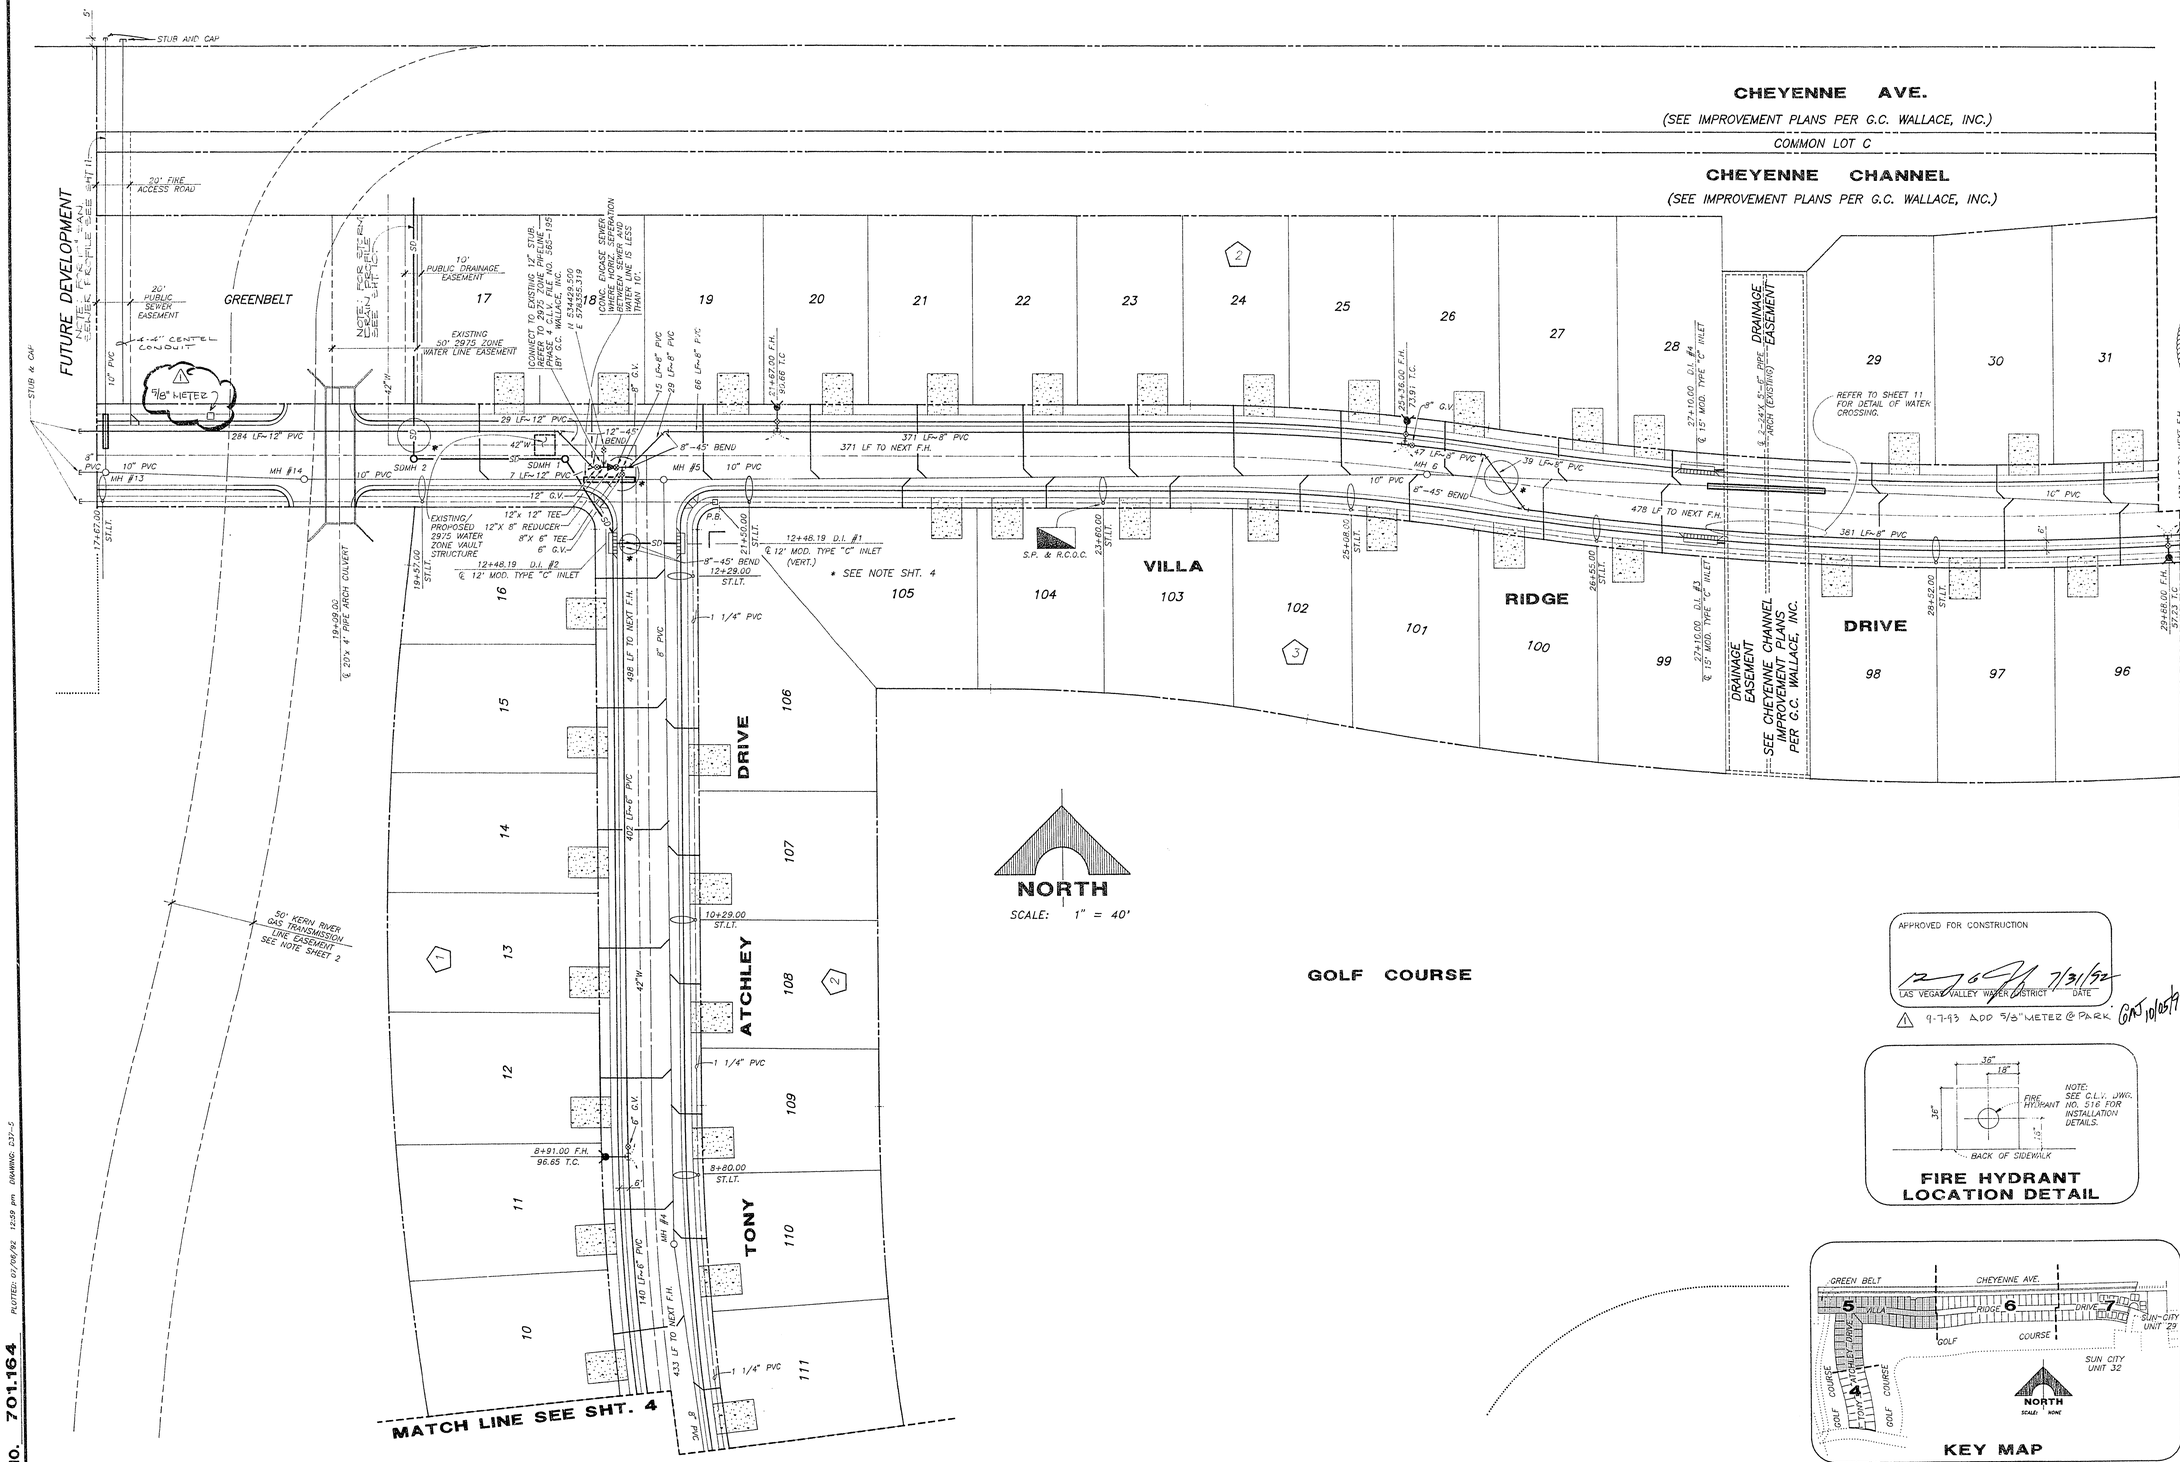

APPROVED FOR CONSTRUCTION

LAS VEGAS VALLEY WATER DISTRICT — DATE 7/31/92

⚠ 9-7-93 ADD 5/8" METER @ PARK GAS 10/05/93

FIRE HYDRANT LOCATION DETAIL

KEY MAP

REV	DATE	DESCRIPTION	C.L.V.	DATE
1	9/7/93	ADD 5/8" METER @ PARK	GAJ	10/5/93

RECOMMENDED FOR APPROVAL: MICHAEL D. MOSS, P.E. No. 6218 — DATE 7/31/92

ENGINEER-STAMP: MICHAEL D. MOSS, No. 6218, STATE OF NEVADA

G.C. WALLACE, INC.
Engineering/Architecture
1555 SOUTH RAINBOW BLVD./LAS VEGAS, NEVADA 89102

DEL WEBB COMMUNITIES, INC.
SUN CITY LAS VEGAS UNIT NO. 37

UTILITY PLAN II

SHEET 5 OF 28 SHEETS

JOB NO. 701.164

PLOTTED: 07/08/92 12:59 pm DRAWING: L37-5

10-8-99

3071-4141-37