AS-BUILT NOTE:

THE AS-BUILT ELEVATIONS AND LATERAL LOCATION DISTANCES ADDED TO THIS MAP WERE THE RESULTS OF A FIELD SURVEY MADE UNDER MY DIRECTION.

SAM LONG, PLS
NEVADA CERTIFICATE NO. 9047

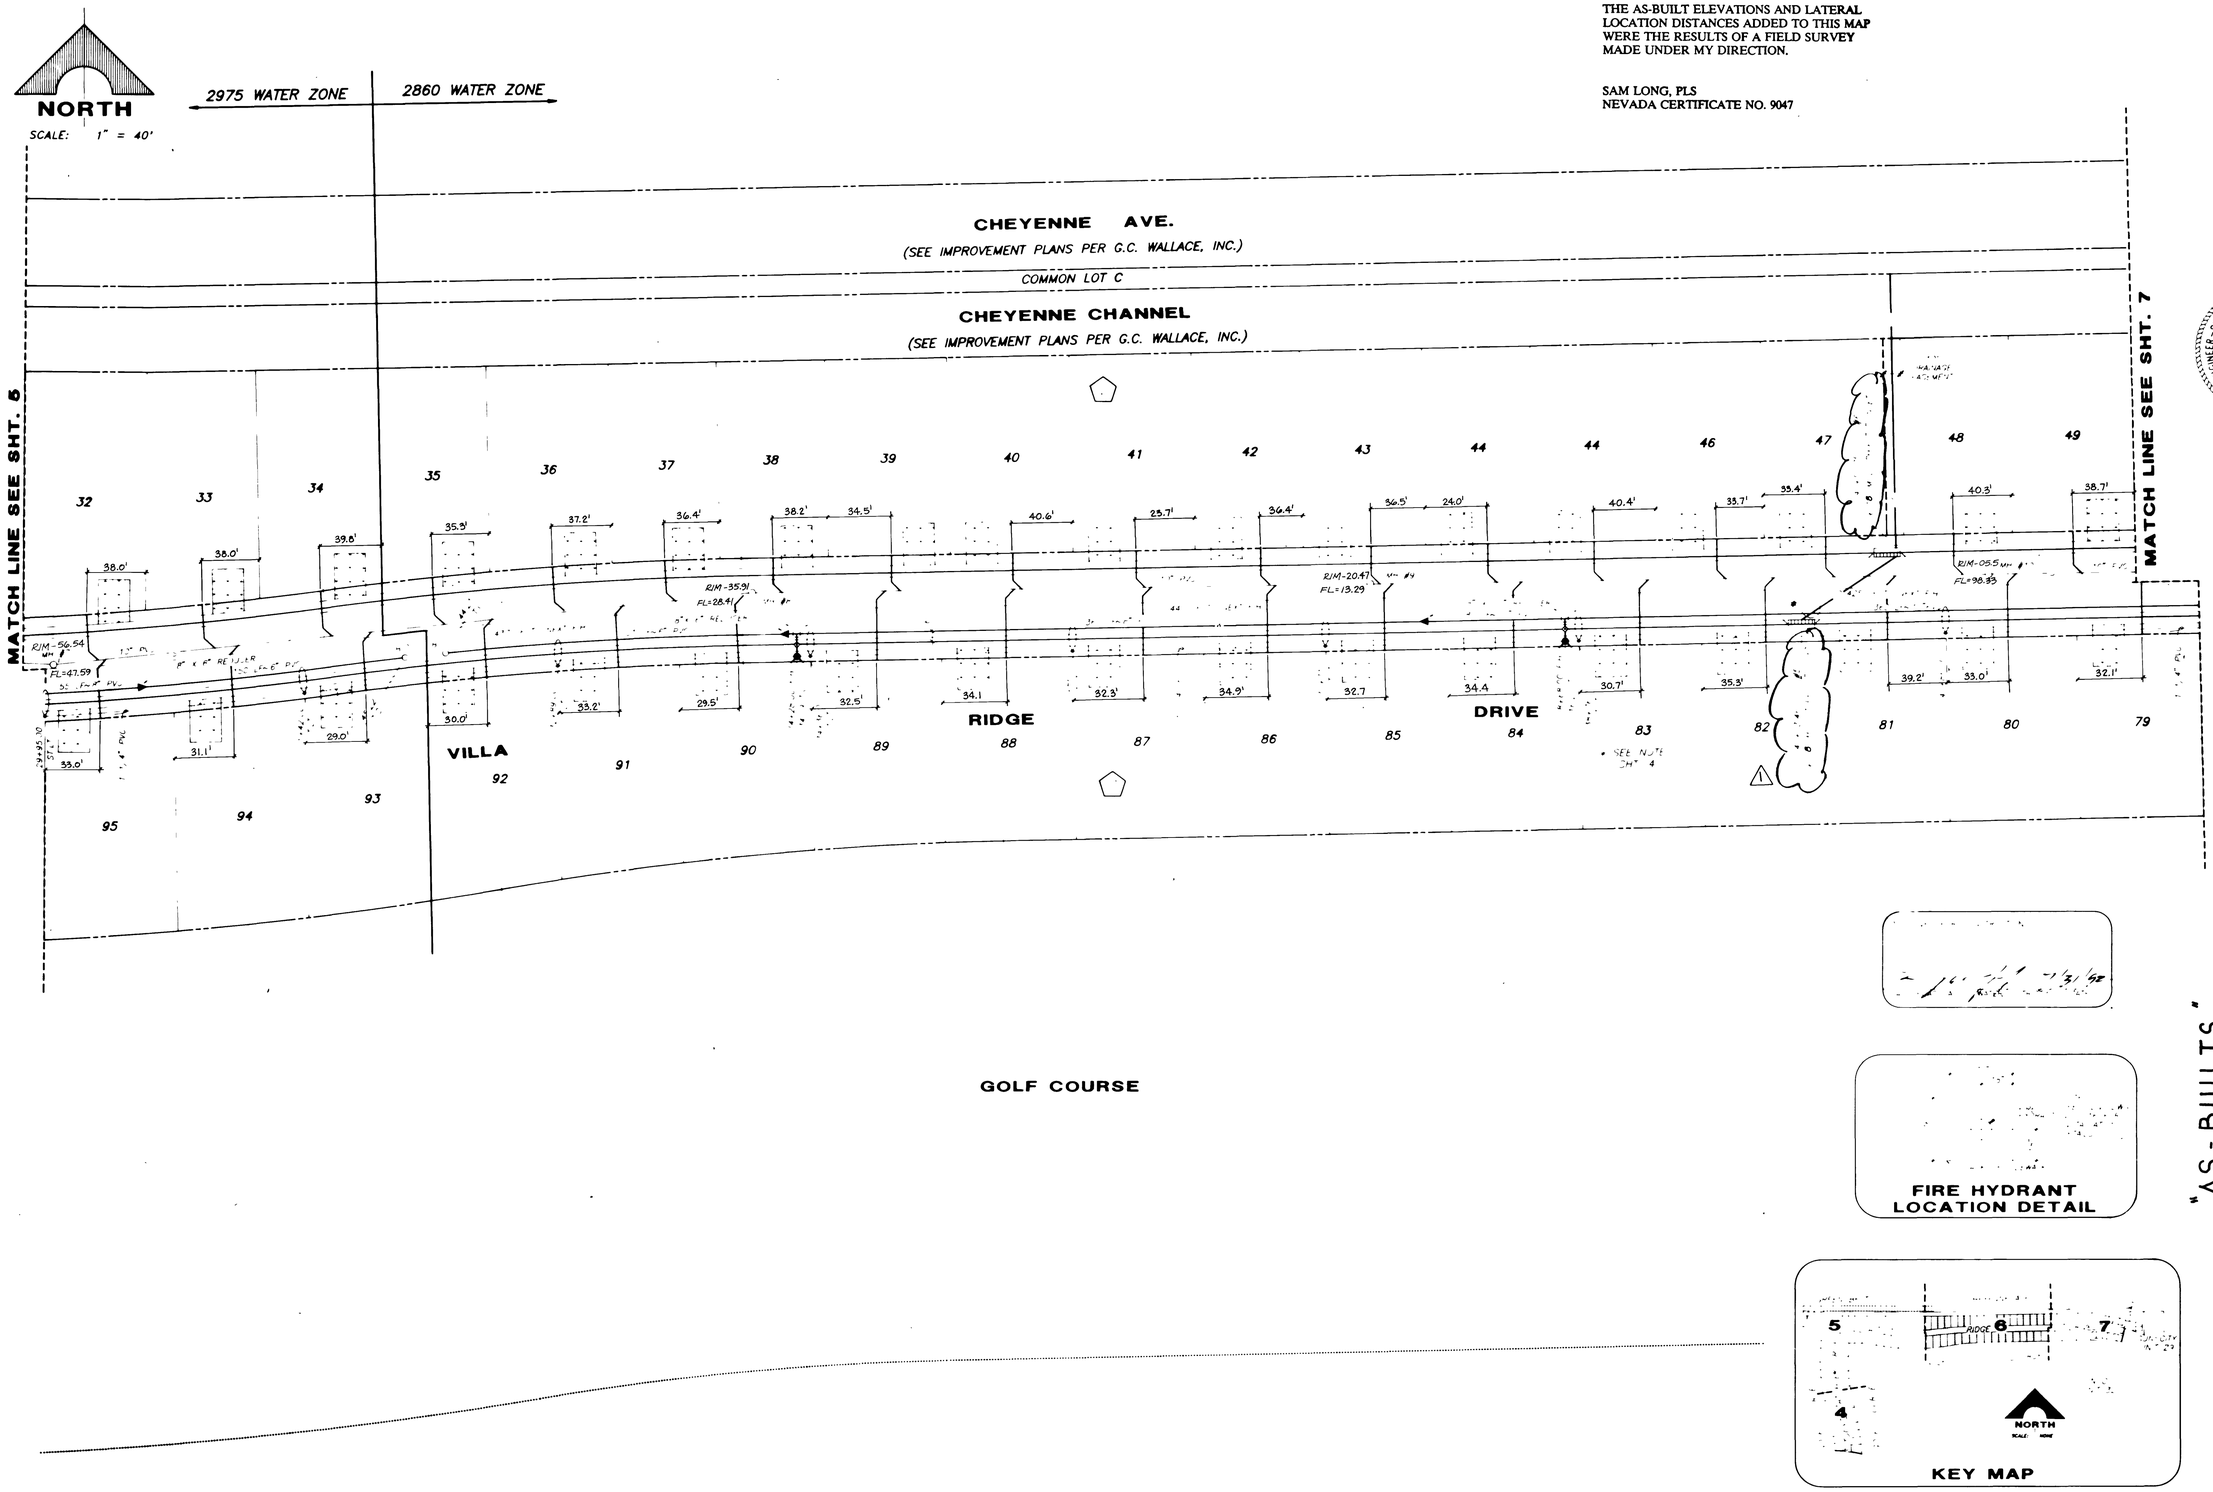

NO.	DATE	DESCRIPTION	BY	DATE
1	8/4/03	REV 01		

REGISTERED PROFESSIONAL ENGINEER - STATE OF NEVADA
MICHAEL D. MOISSOTTO
No. 6218
NO DATE

G.C. WALLACE, INC.
Engineering Architecture
1555 SOUTH HARBOR BLVD. LAS VEGAS, NEVADA 89102

DEL WEBB COMMUNITIES, INC.
SUN CITY LAS VEGAS UNIT NO. 37

UTILITY PLAN III

SHEET 6 OF 28 SHEETS

JOB NO. 701.164

PLOTTED: 08/29/03 10:16 am DRAWING: U37-6

6875 10-9-100 "As-Builts" 3074-4141-37

NORTH

CHEYENNE AVE.

CHEYENNE CHANNEL

VILLA

RIDGE

DRIVE

GOLF COURSE

FIRE HYDRANT LOCATION DETAIL

KEY MAP

'AS-BUILTS'

G.C. WALLACE, INC.

UTILITY PLAN III

SHEET 8