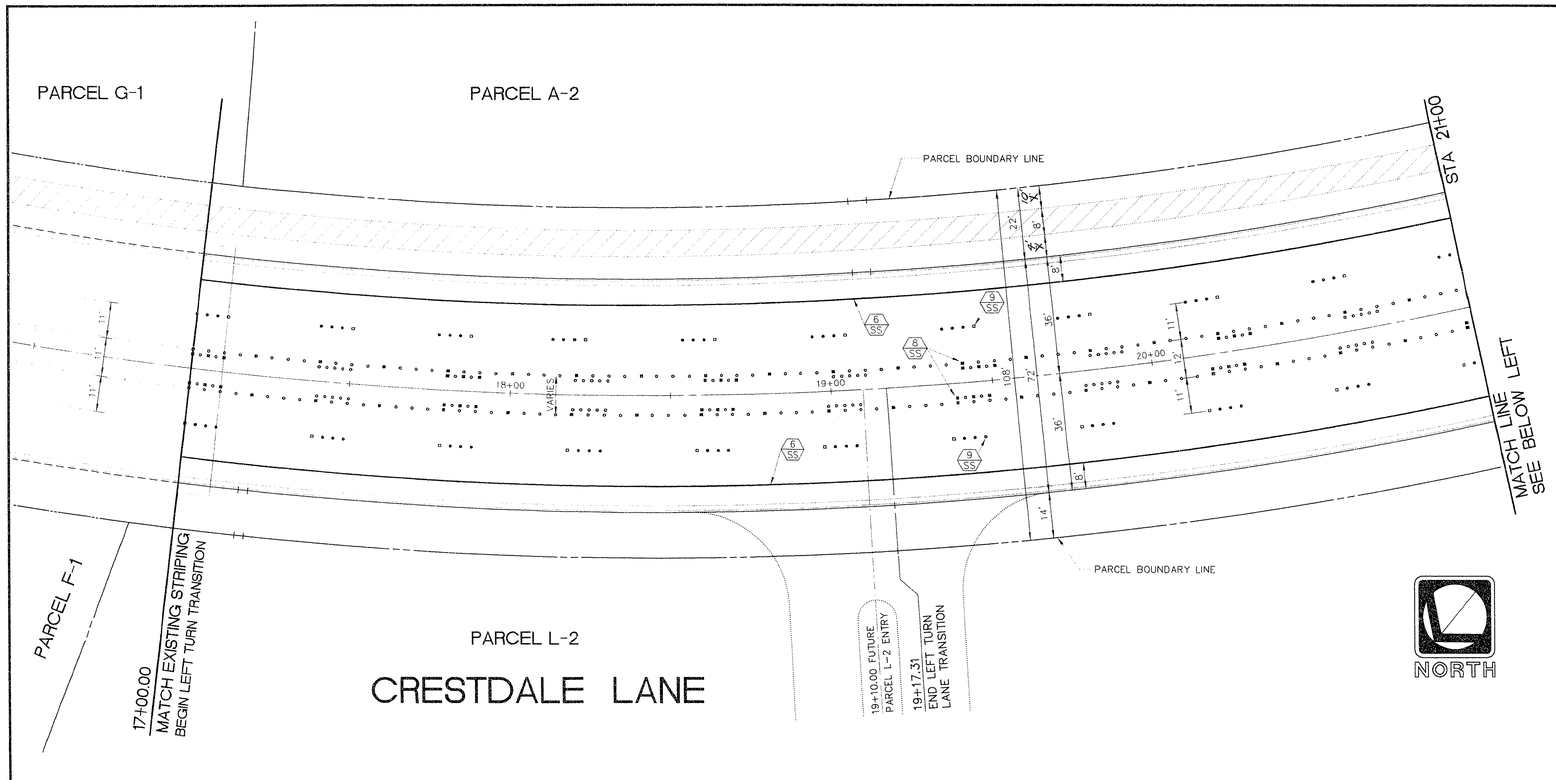

FUTURE STREET STRIPING AND SIGNAGE NOTES

1 SS ALL STREET SIGNS SHALL BE IN CONFORMANCE WITH THE MANUAL OF UNIFORM TRAFFIC CONTROL DEVICES (MUTCD) LATEST EDITION.

6 SS INSTALL 1800 L.F. 4" WHITE SOLID BIKE LANE LINE

8 SS INSTALL 1800 L.F. CONTINUOUS LEFT TURN LANE LINE

9 SS INSTALL 1800 L.F. BROKEN LANE LINE.

NOTE: STREET STRIPING AS SHOWN IS FUTURE AND NOT A PART OF THIS CONTRACT. STRIPING IS TO BE CONSTRUCTED IN THE FUTURE AFTER THE FINAL PAVING.

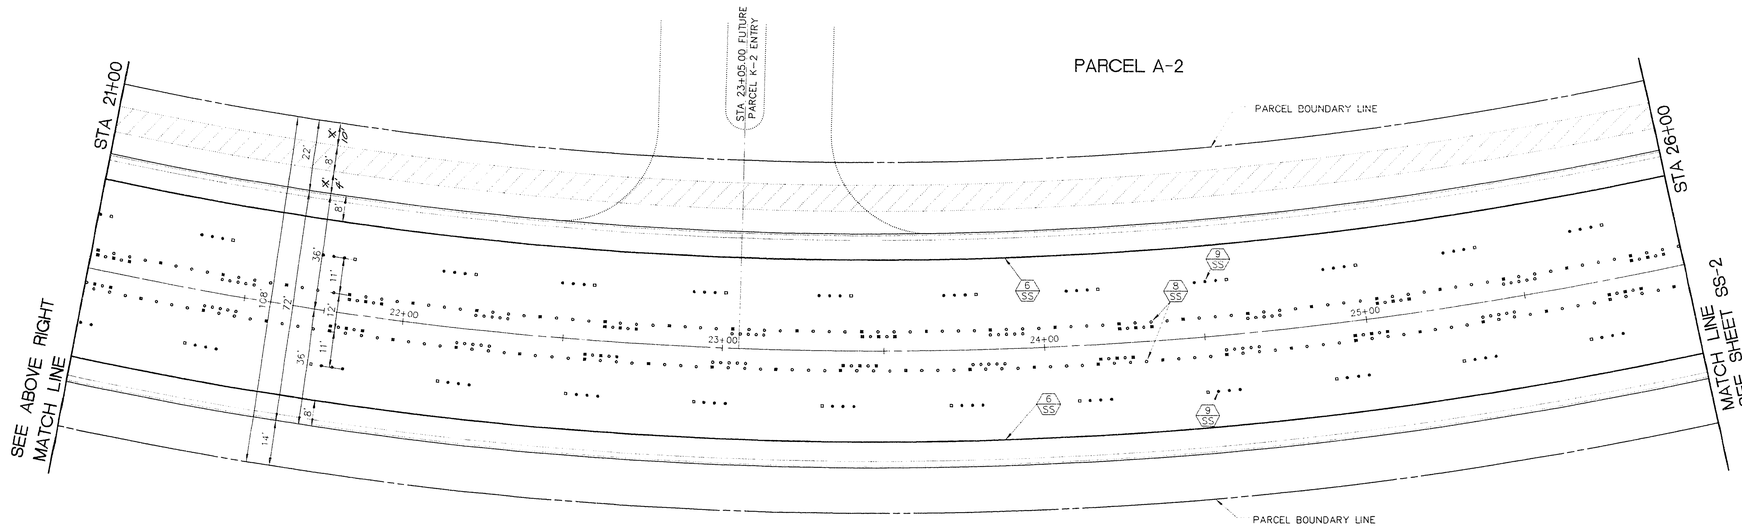

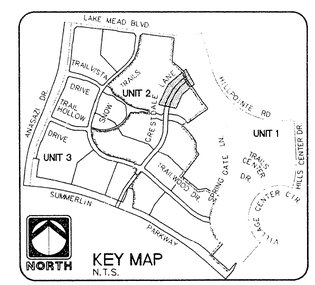

0 20 40 80

1 inch = 20 ft.

RECORD DRAWING

RECORD INFORMATION PROVIDED BY FIELD CONTRACTOR

REV.	DATE	DESCRIPTION	DATE	APPROVAL

RECOMMENDED

GARY R. BUSBY 10584 R.P.E. 6/15/99 DATE

• PLANNING
• CIVIL ENGINEERING
• LANDSCAPE ARCHITECTURE
• LAND SURVEYING
• CONSTRUCTION MANAGEMENT

6030 SO. TOLLESON RD. LAS VEGAS, NV 89103 (702) 733-0550

ENGINEER THE KEITH COMPANIES NEVADA

HOWARD HUGHES PROPERTIES

SUMMERLIN VILLAGE 7 - THE TRAILS - UNIT 2

CRESTDALE LANE

FUTURE SIGNING AND STRIPING

STA 17+00 - STA 26+00

SHEET SS-1

SHT 38 OF 42

11-2-101

1074-4271-2