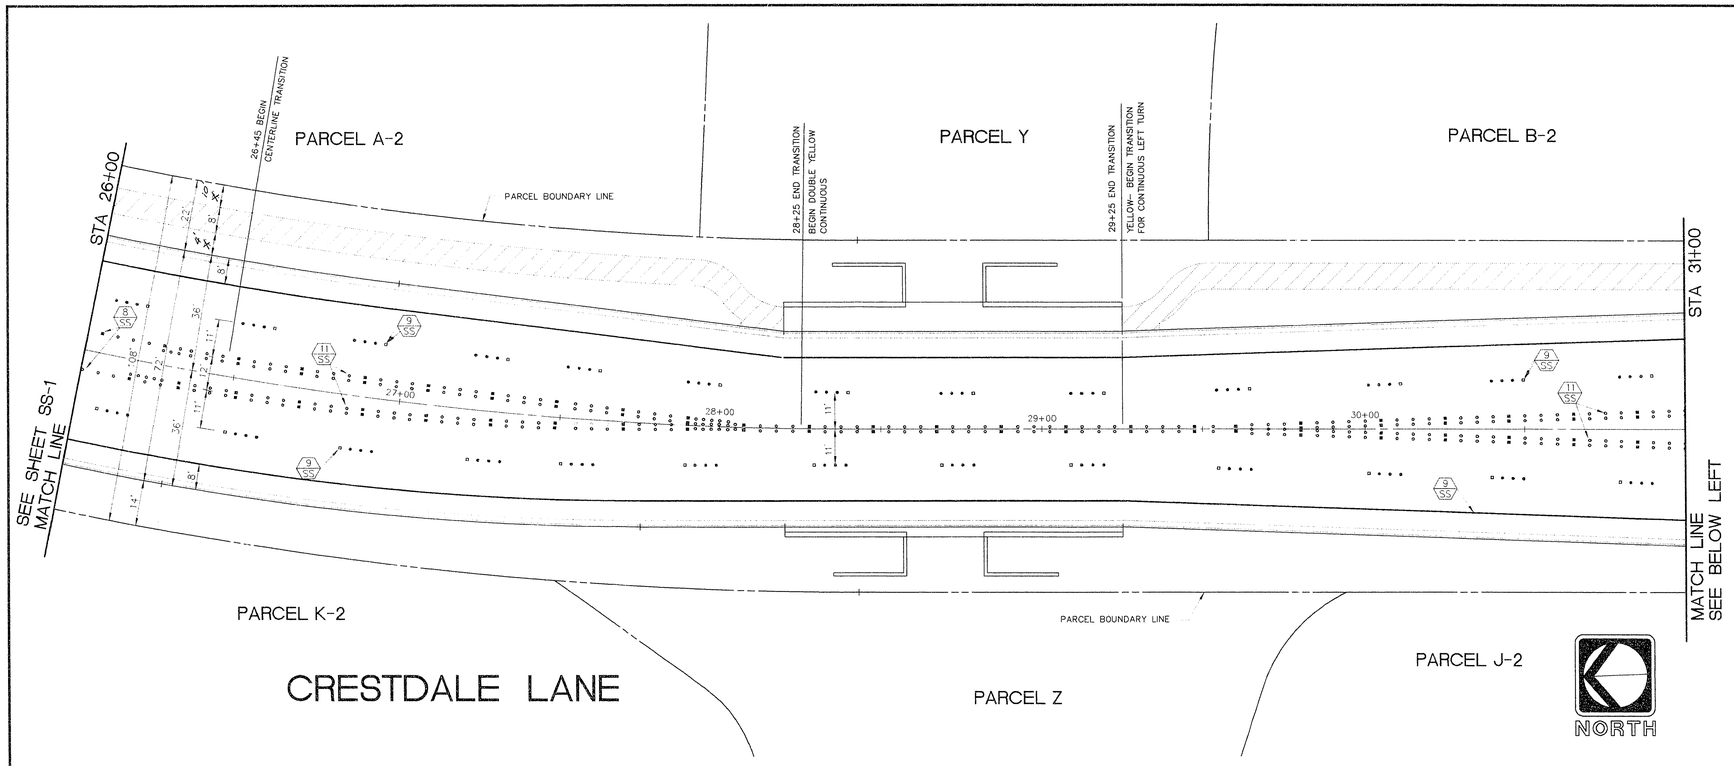

FUTURE STREET STRIPING AND SIGNAGE NOTES

1 SS ALL STREET SIGNS SHALL BE IN CONFORMANCE WITH THE MANUAL OF UNIFORM TRAFFIC CONTROL DEVICES (MUTCD) LATEST EDITION.

6 SS INSTALL 2000 LF CONTINUOUS 4" WHITE SOLID BIKE LANE LINE.

8 SS INSTALL 1080 LF CONTINUOUS LEFT TURN LANE LINE.

9 SS INSTALL 2000 LF BROKEN LANE LINE.

11 SS TYPE 1 820 LF CENTERLINE.

NOTE: STREET STRIPING AS SHOWN IS FUTURE AND NOT A PART OF THIS CONTRACT. STRIPING IS TO BE CONSTRUCTED IN THE FUTURE AFTER THE FINAL PAVING.

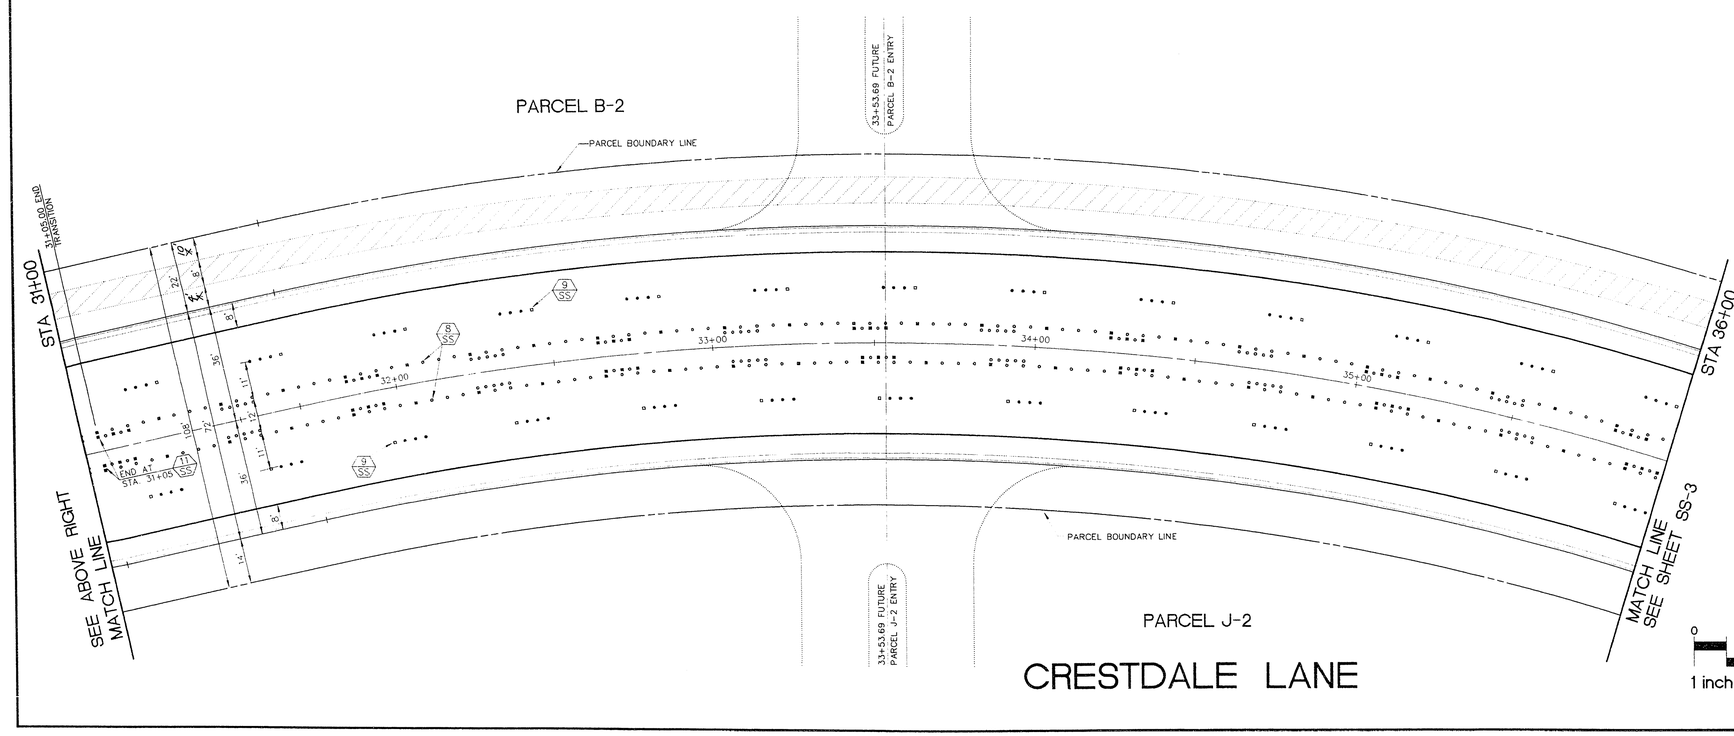

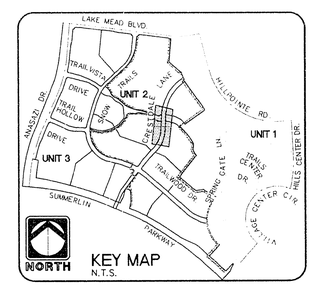

0 20 40 80

1 inch = 20 ft.

NORTH

RECORD DRAWING

RECORD INFORMATION PROVIDED BY FIELD CONTRACTOR

RECOMMENDED

GARY R. BUSBY 10584 6/15/99
R.P.E. DATE

REV.	DATE	DESCRIPTION	DATE	APPROVAL

ENGINEER

THE KEITH COMPANIES NEVADA
4002 SO. INDUSTRIAL RD. LAS VEGAS, NV. 89103

HOWARD HUGHES PROPERTIES
SUMMERLIN VILLAGE 7 - THE TRAILS - UNIT 2
CRESTDALE LANE
FUTURE SIGNING AND STRIPING
STA 26+00 - STA 36+00

SHEET
SS-2
SHT 39 OF 43

107X-4271-2

11-2403