BENCHMARK

RIVET AND PLATE IN TOP OF CURB NW SIDE OF TOWN CENTER DRIVE AND SOUTH ROUNDABOUT ISLAND.
ELEVATION = 2725.923
PER CITY OF LAS VEGAS DATUM STATION: OLVOO
1954

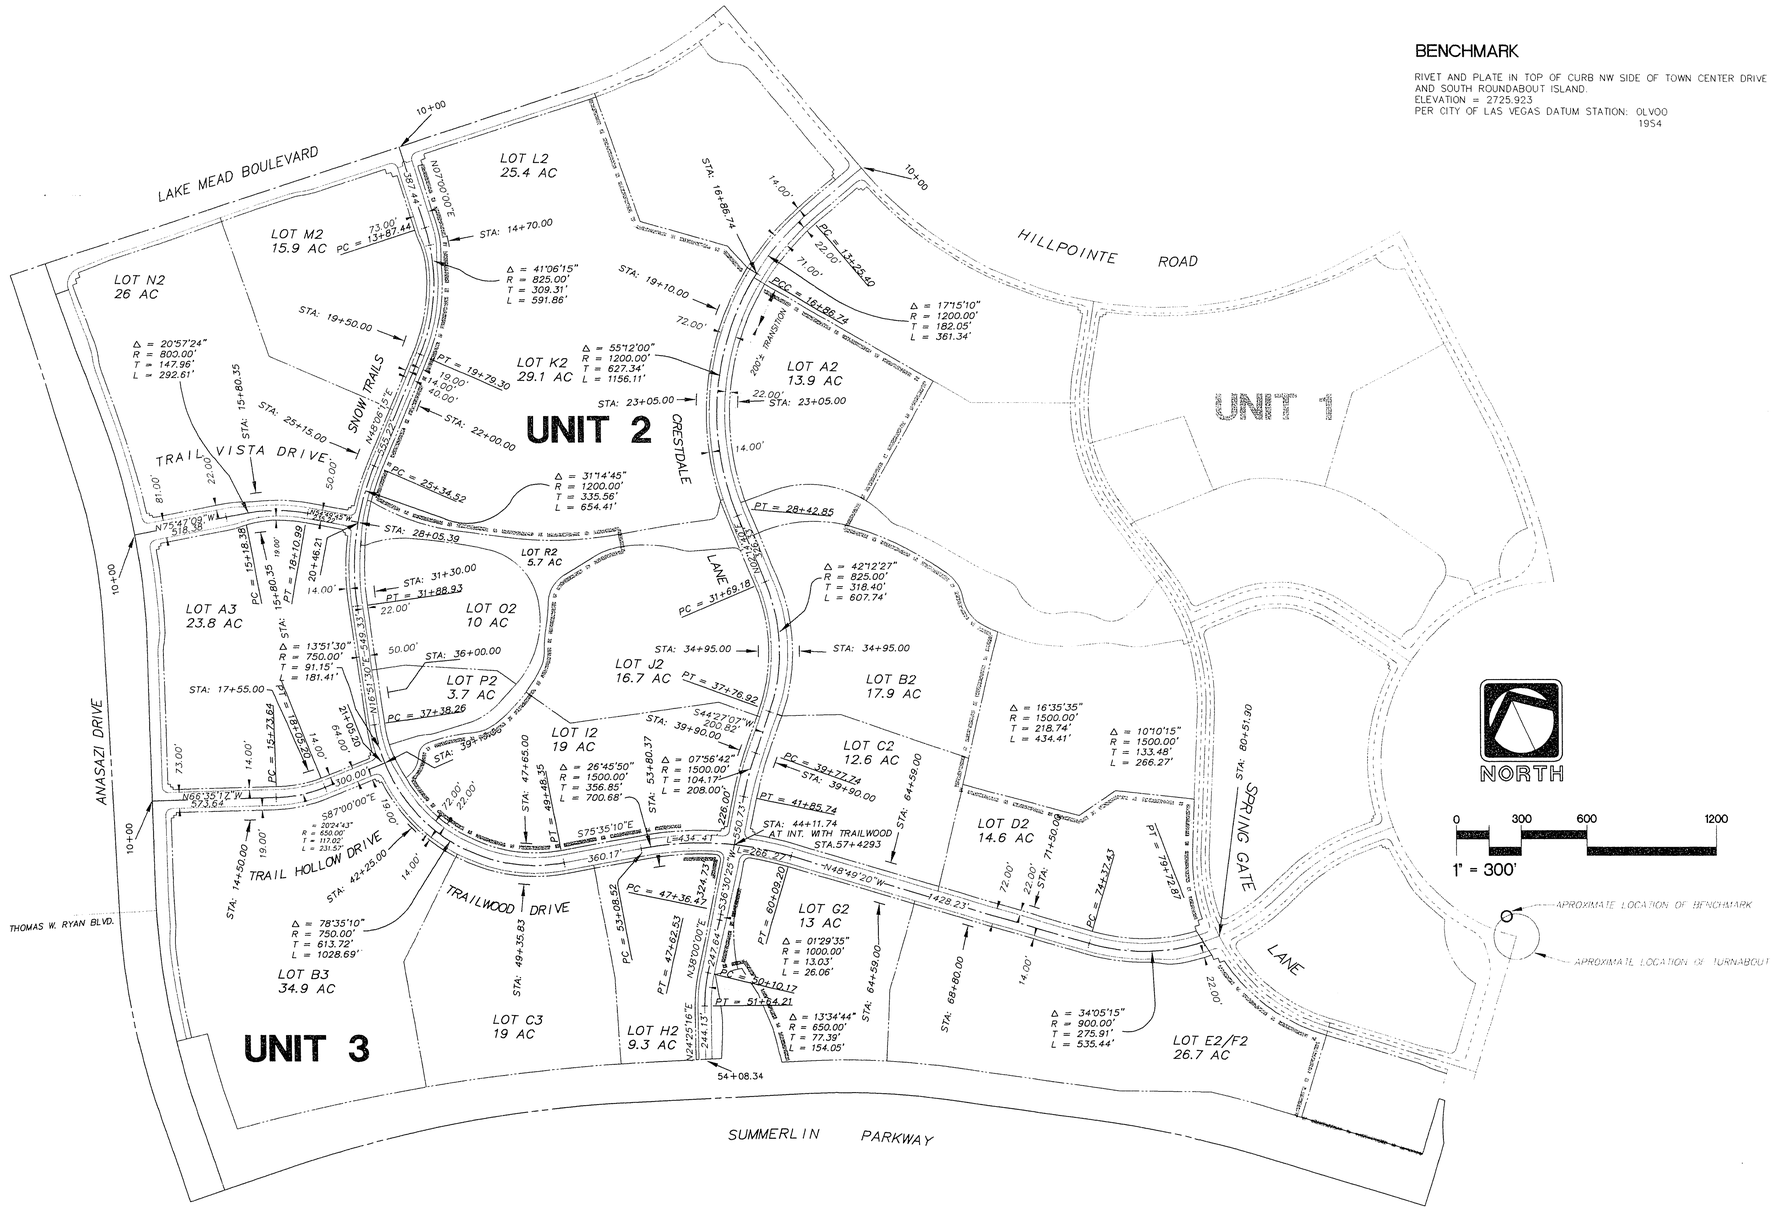

RECORD DRAWING
RECORD INFORMATION PROVIDED BY FIELD CONTRACTOR

REV.	DATE	DESCRIPTION	DATE	APPROVAL

RECOMMENDED
GARY W. BUSBY
R.P.E. 10584 DATE 6/15/94

ENGINEER
THE KEITH COMPANIES NEVADA
4030 S. INDUSTRIAL RD. LAS VEGAS, NV 89103 (702) 733-8360

- PLANNING
- CIVIL ENGINEERING
- SURVEYING
- ARCHITECTURE
- LANDSCAPE ARCHITECTURE
- CONSTRUCTION MANAGEMENT

HOWARD HUGHES PROPERTIES
SUMMERLIN VILLAGE 7 - THE TRAILS - UNIT 2
HORIZONTAL CONTROL PLAN

SHEET
CG-3
SHT 3 OF 4

1074-4271-2

11-2-63