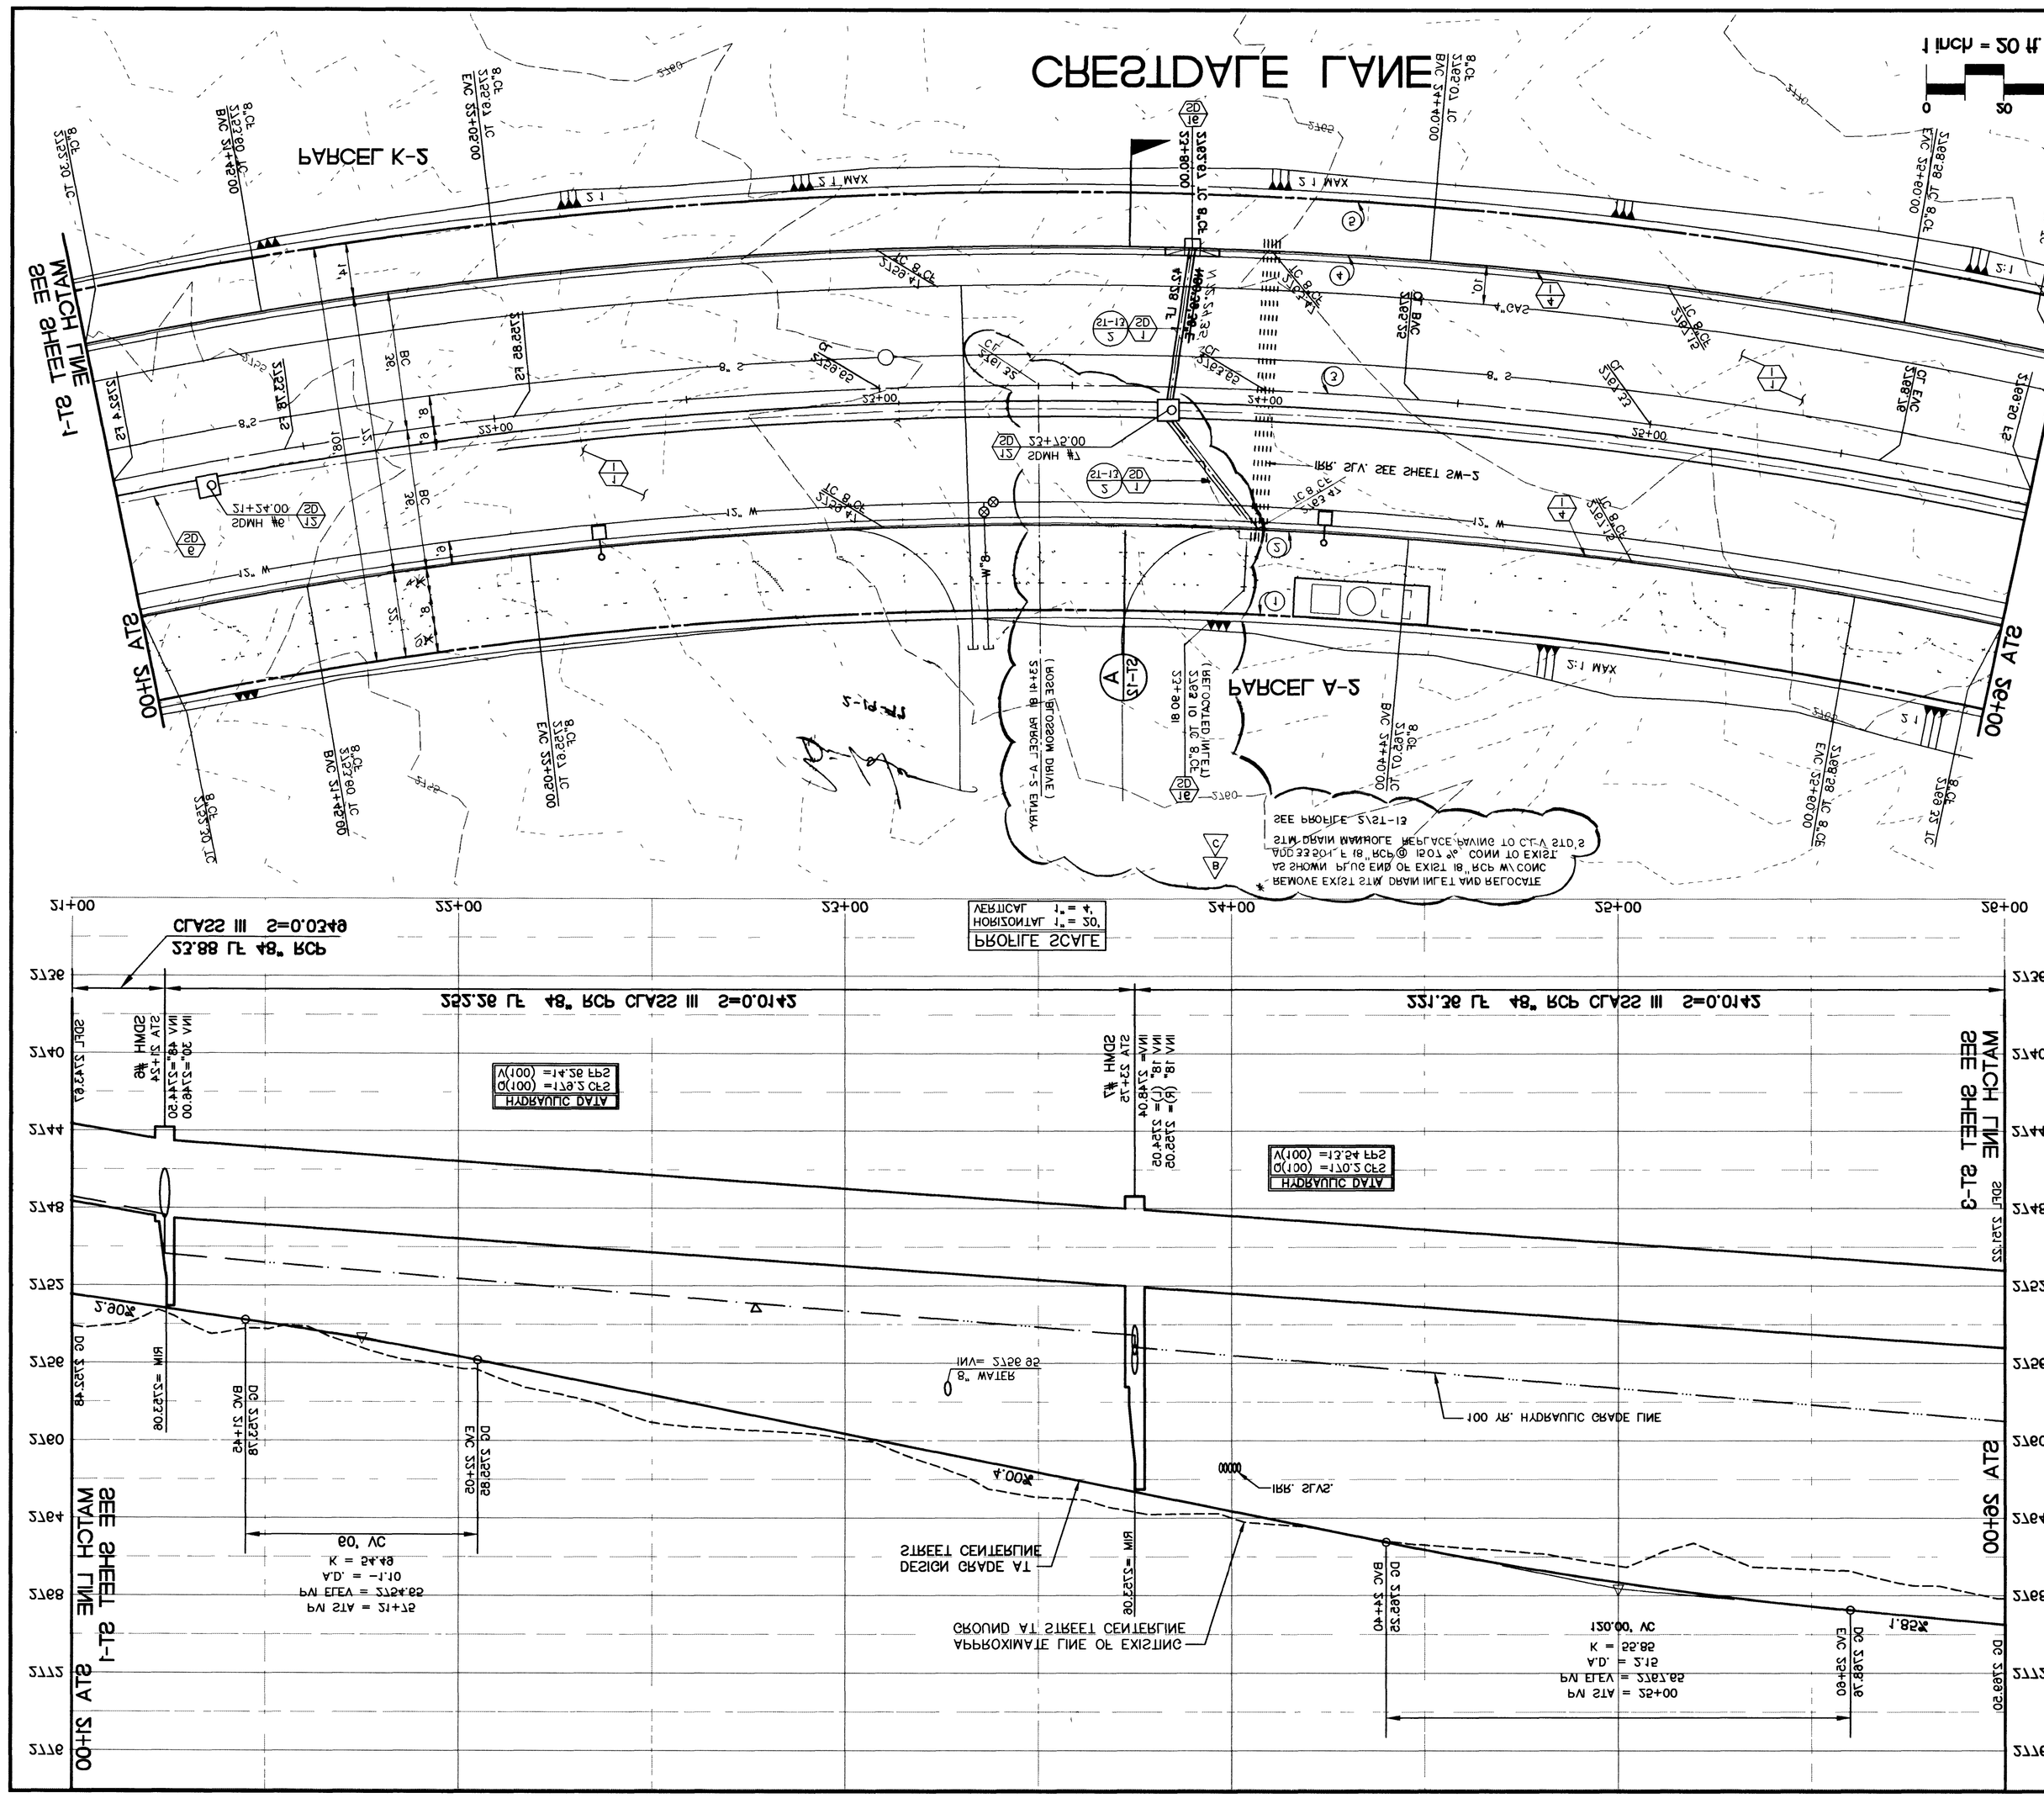
CRESTDALE LANE
MATCH LINE SEE SHEET L-1S
MATCH LINE SEE SHEET S1-3
STA 26+00
STA 30+00
PROFILE SCALE
VERTICAL 1" = 4'
STA 21+00 TO STA 26+00
STA 26+00 TO STA 30+00
STREET CENTERLINE DESIGN GRADE AT
APPROXIMATE LINE OF EXISTING GROUND AT STREET CENTERLINE
100 YR. HYDRAULIC GRADE LINE
SEE SHEET CC-2 FOR LOCATION
PER CITY OF LAS VEGAS DATUM STATION 0L900
ELEVATION = 2552.52
RIVET AND PLATE IN TOP OF CURB ON SIDE OF TOWN CENTER DRIVE AND SOUTH BONNEBOUT ISLAND.
(SEE NEVADA POWER CO. DWGS FOR ELECTRICAL DISTRIBUTION).
FOR STREET LIGHTING INSTALLATION)
(SHOWN FOR REFERENCE ONLY; SEE SHEETS SL-1 & SL-5
STREET LIGHTING AND ELECTRICAL
INSTALL 1000.00 L.F. OF 8" "L" TYPE CURB AND GUTTER
CONSTRUCT 2112.87 S.Y. OF 3" ASPHALT PAVEMENT OVER 4" TYPE II AGGREGATE BASE. A 1" FUTURE OVERLAY IS REQUIRED UNDER SEPARATE PERMIT
IMPROVEMENTS
STA 26+60
DC 2268.36
EVC 25+60
STA 25+40
DC 2262.52
BVC 24+40
STA 24+00
STA 21+45
DC 2252.18
BVC 21+45
STA 22+00
DC 2255.85
EVC 22+00
STA 21+24
SDMH #6
INV 48"= 2244.50
INV 30"= 2246.00
RIM = 2253.06
STA 22+37.05
SDMH #7
INV 18" (S)= 2254.05
INV 18" (W)= 2254.05
RIM = 2257.06

MATCH LINE
SEE SHEET SL-4
MATCH LINE
SEE SHEET SL-4
BENCHMARK
CLEAR DATUM