


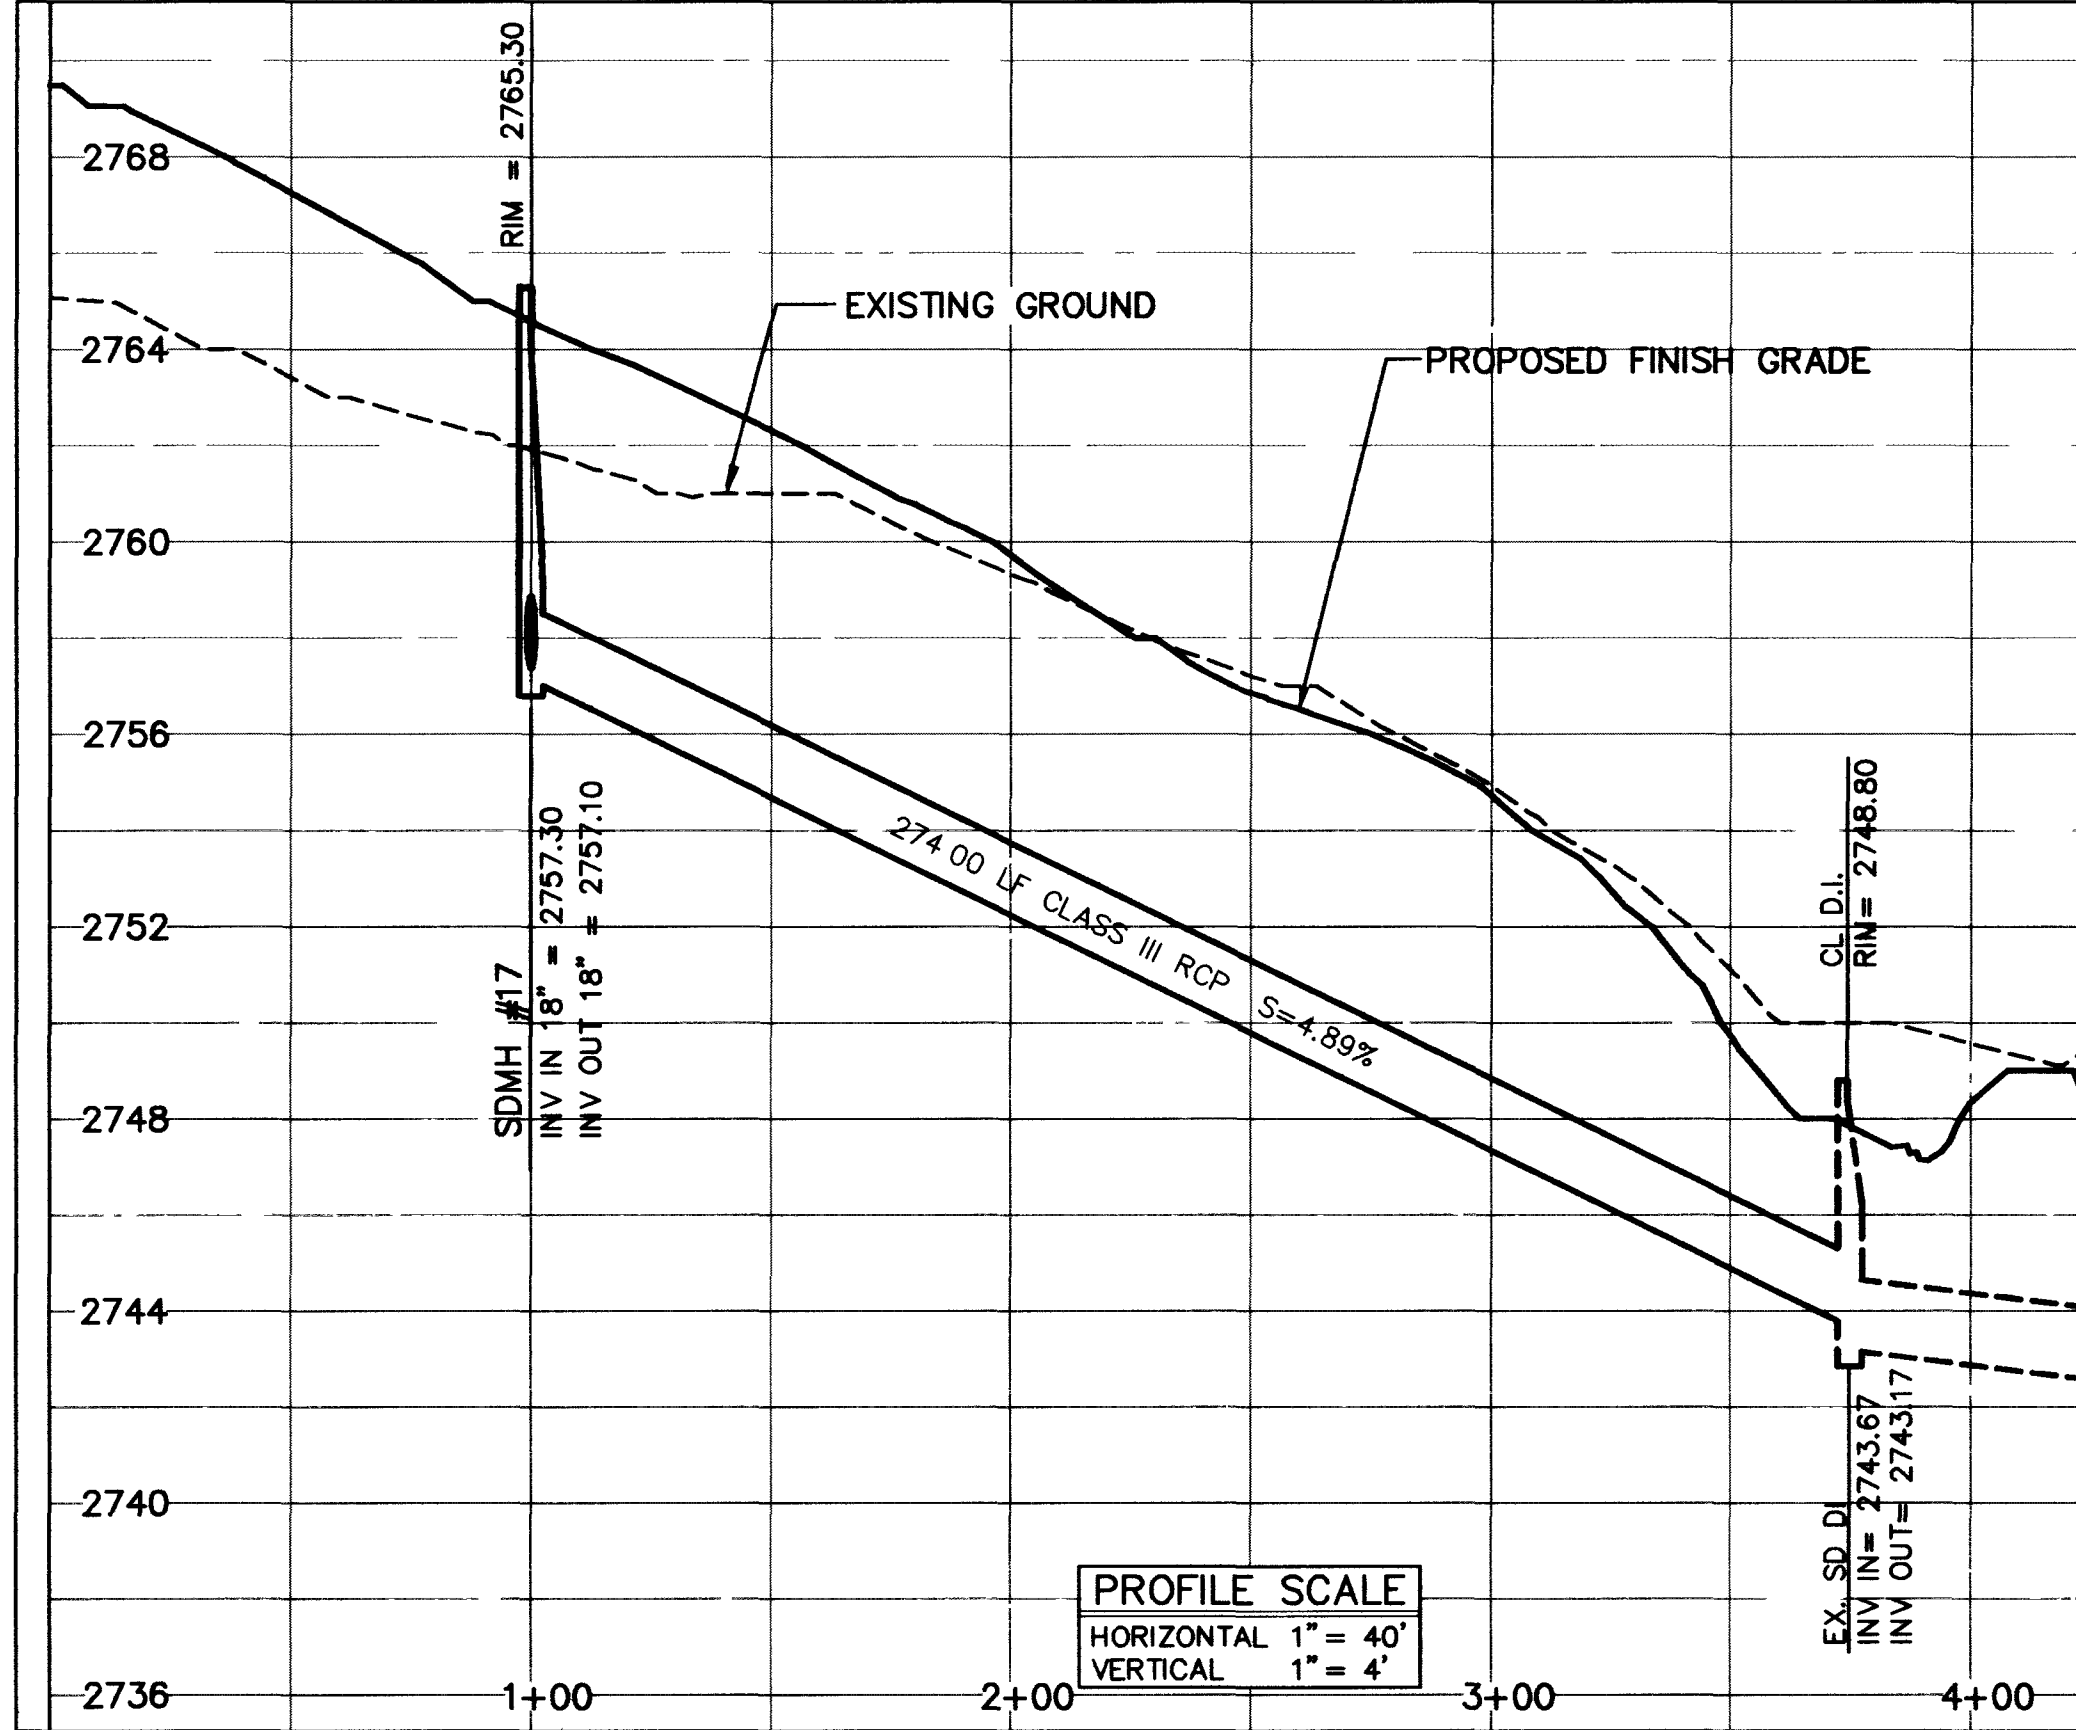
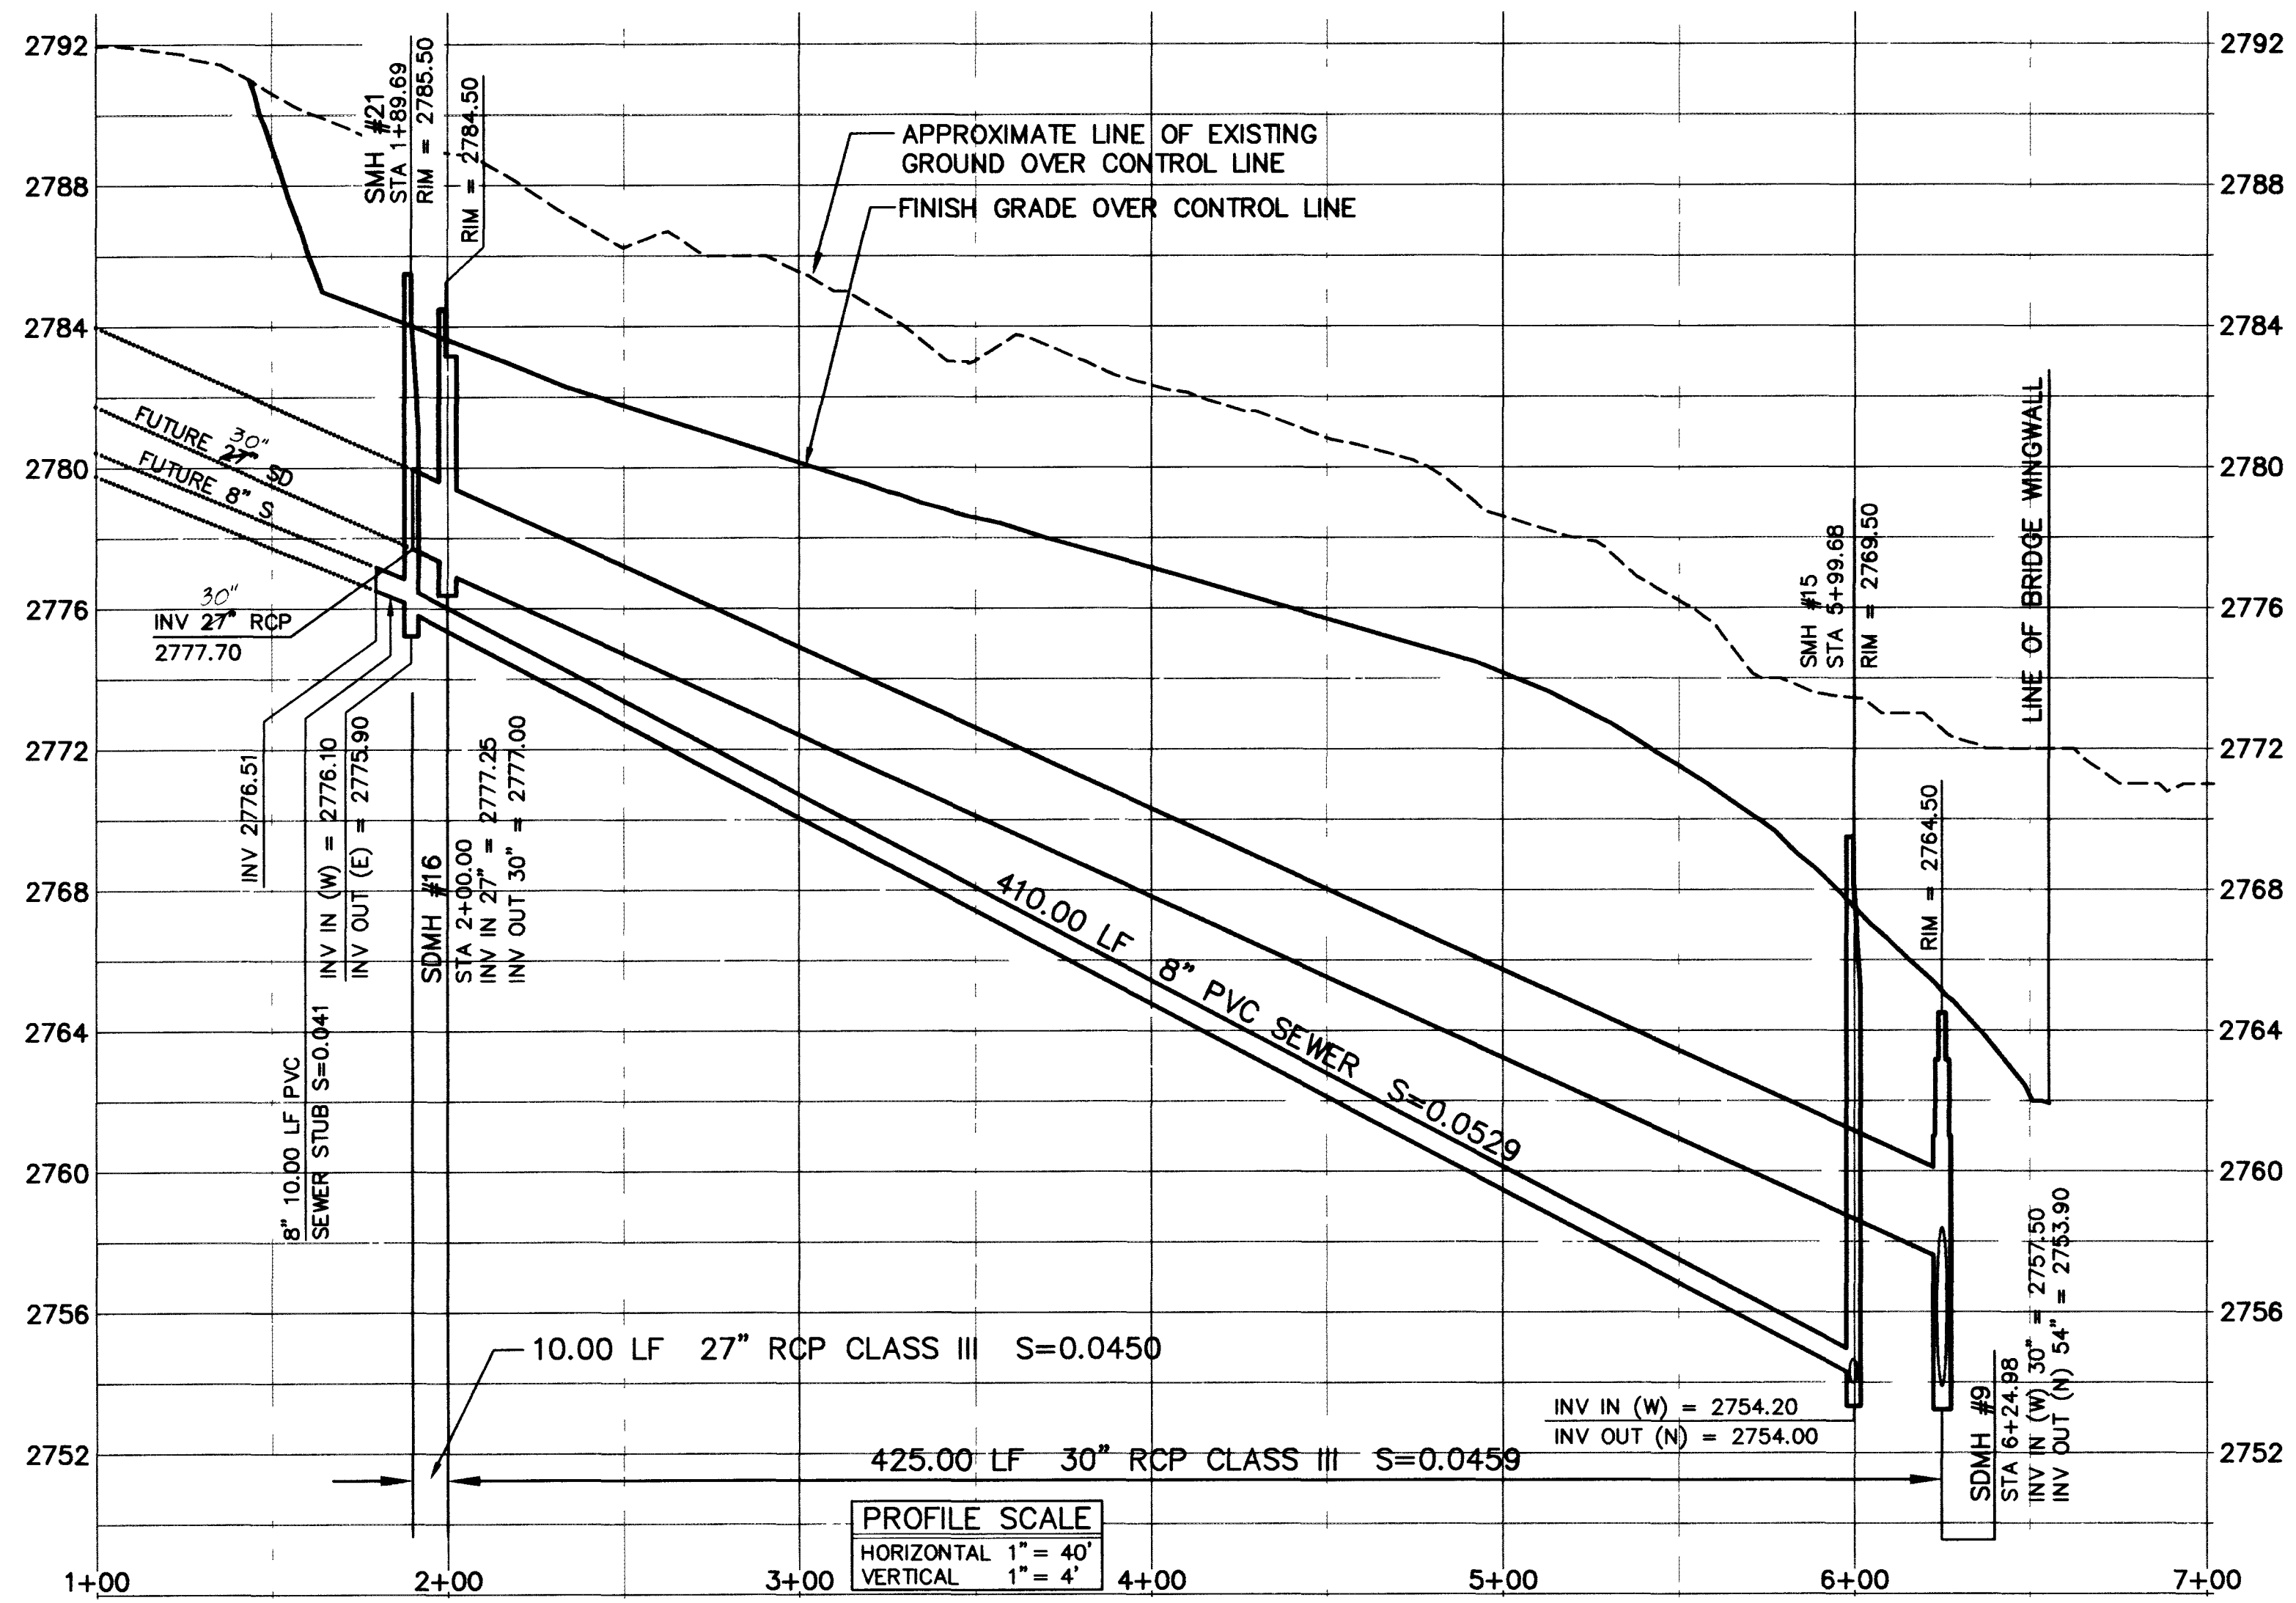
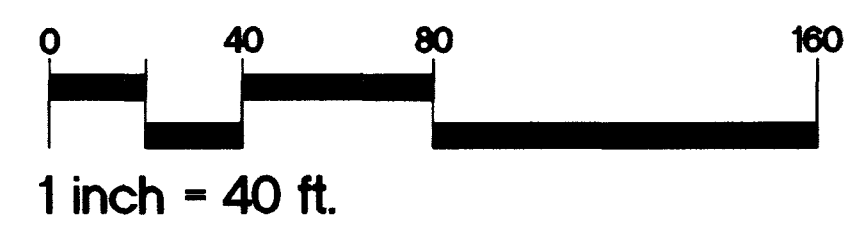


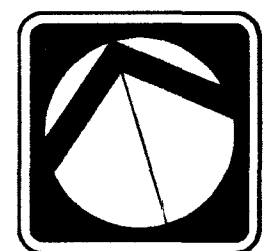

- CONSTRUCTION NOTES (SEWER)**
- 1 S INSTALL 1 EA. STANDARD 4' SEWER MANHOLE PER CLARK COUNTY SANITATION DISTRICT STANDARD DRAWINGS.
 - 2 S INSTALL 420 L.F. 8" PVC (SDR-35) SEWER LINE.
 - 3 S INSTALL 1 EA. 8" PVC PLUG AND CAP
- STORM DRAIN**
- 1 SD INSTALL 351.78 L.F. OF 18" RCP STORM DRAIN
 - 3 SD INSTALL 435 L.F. OF 30" RCP STORM DRAIN.
 - 8 SD INSTALL 10 L.F. OF 27" RCP STORM DRAIN
 - 11 SD INSTALL 2 EA. TYPE 1 STORM DRAIN MANHOLE
 - 15 SD INSTALL 1 EA. OF TYPE 2 DROP INLET
 - 19 SD INSTALL 2 EA. PLUG

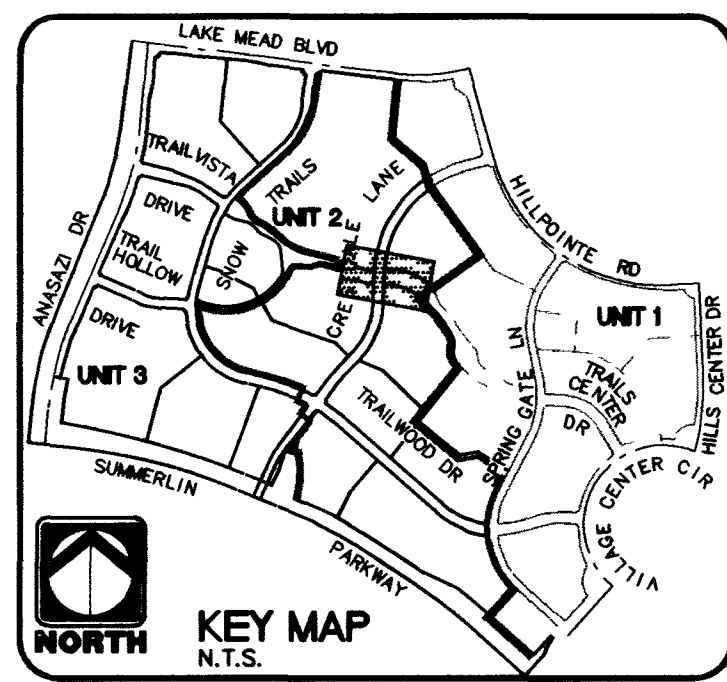

Call before you Dig.
1-800-227-2800
NEVADA SERVICE ONLY

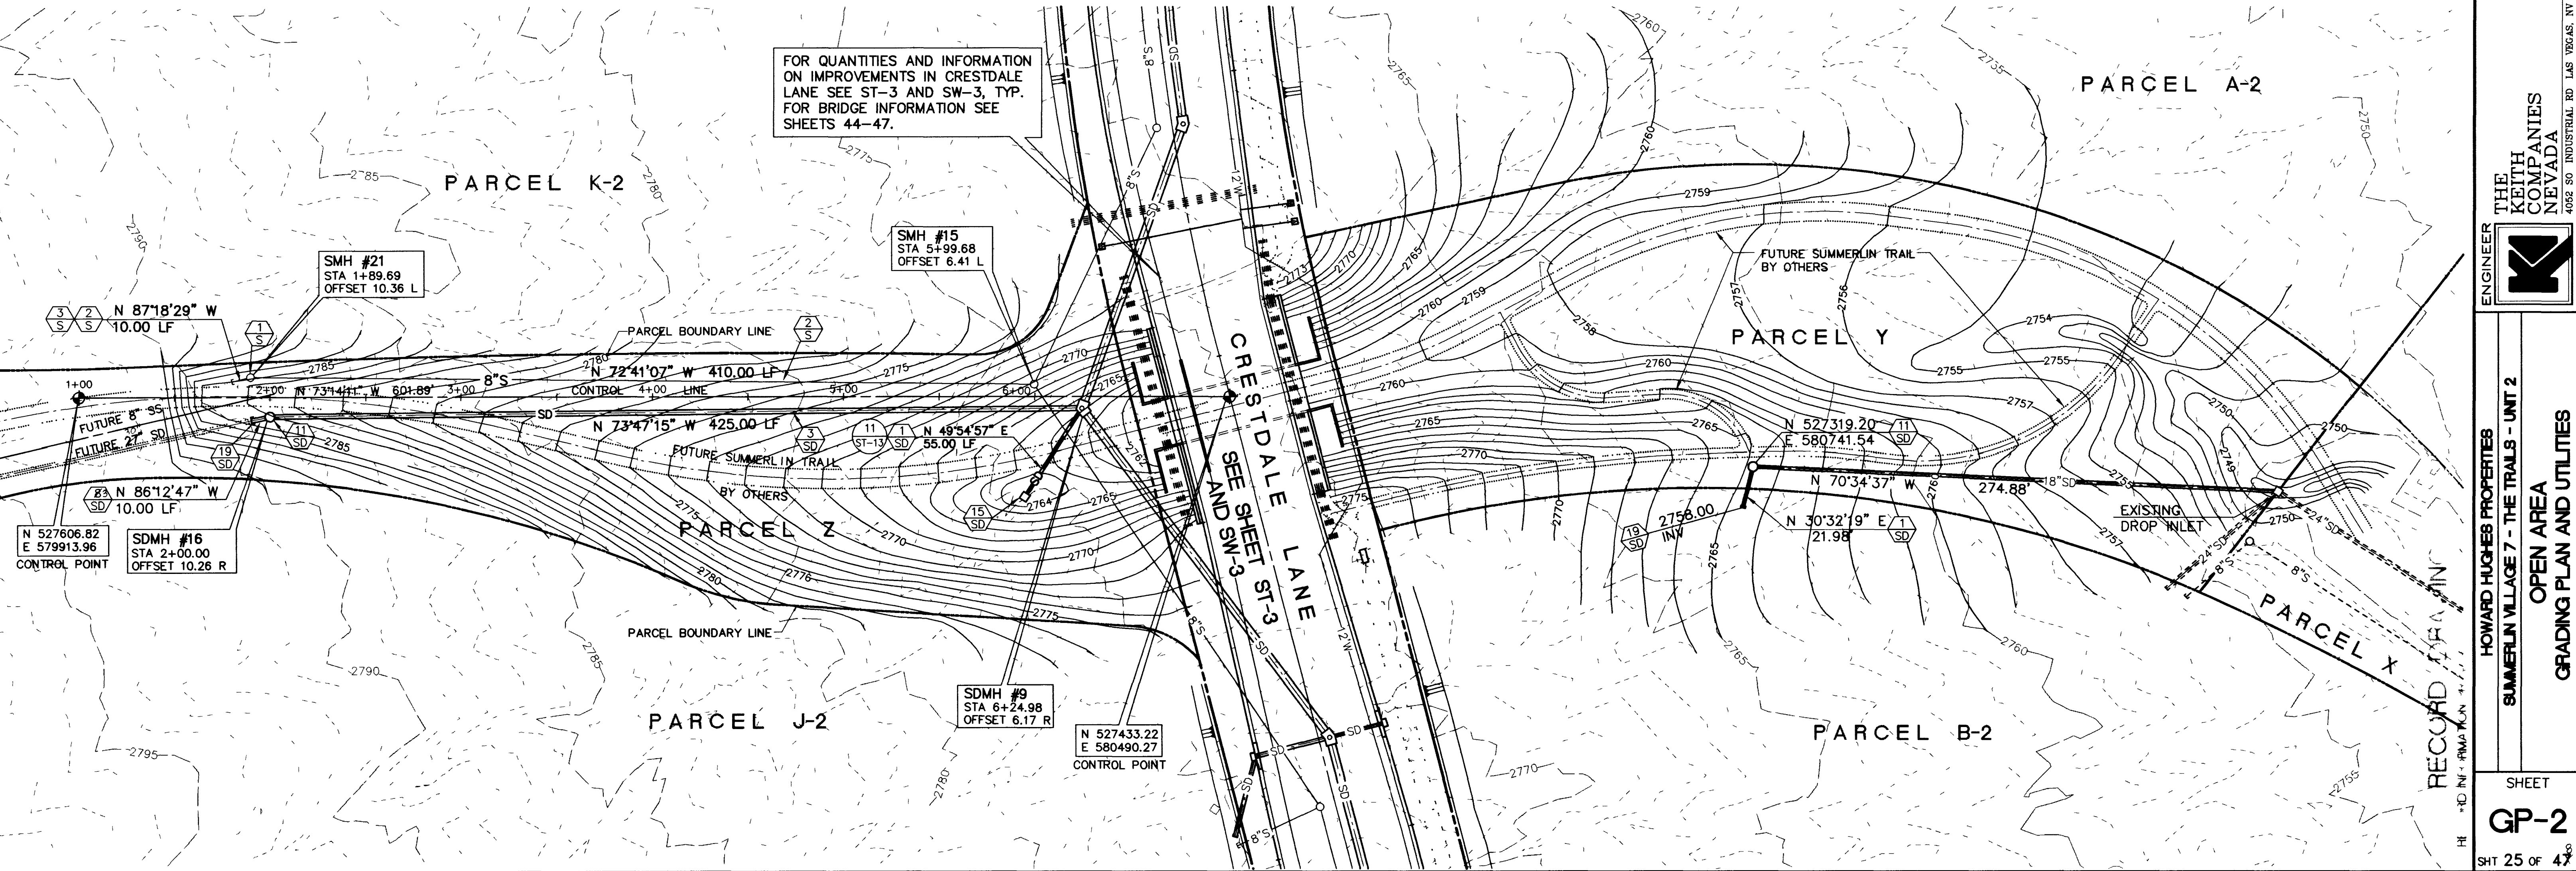

RECOMMENDED	DATE	APPROVAL
PLANNING		
CIVIL ENGINEERING		
LANDSCAPE		
ARCHITECTURE		
LAND SURVEYING		
MANAGEMENT		

ENGINEER: THE KEITH COMPANIES, INC. (Nevada)

PROJECT: SUMMERLIN VILLAGE 7 - THE TRAILS - UNIT 2

AREA: OPEN AREA

TYPE: GRADING PLAN AND UTILITIES

SHEET: GP-2




