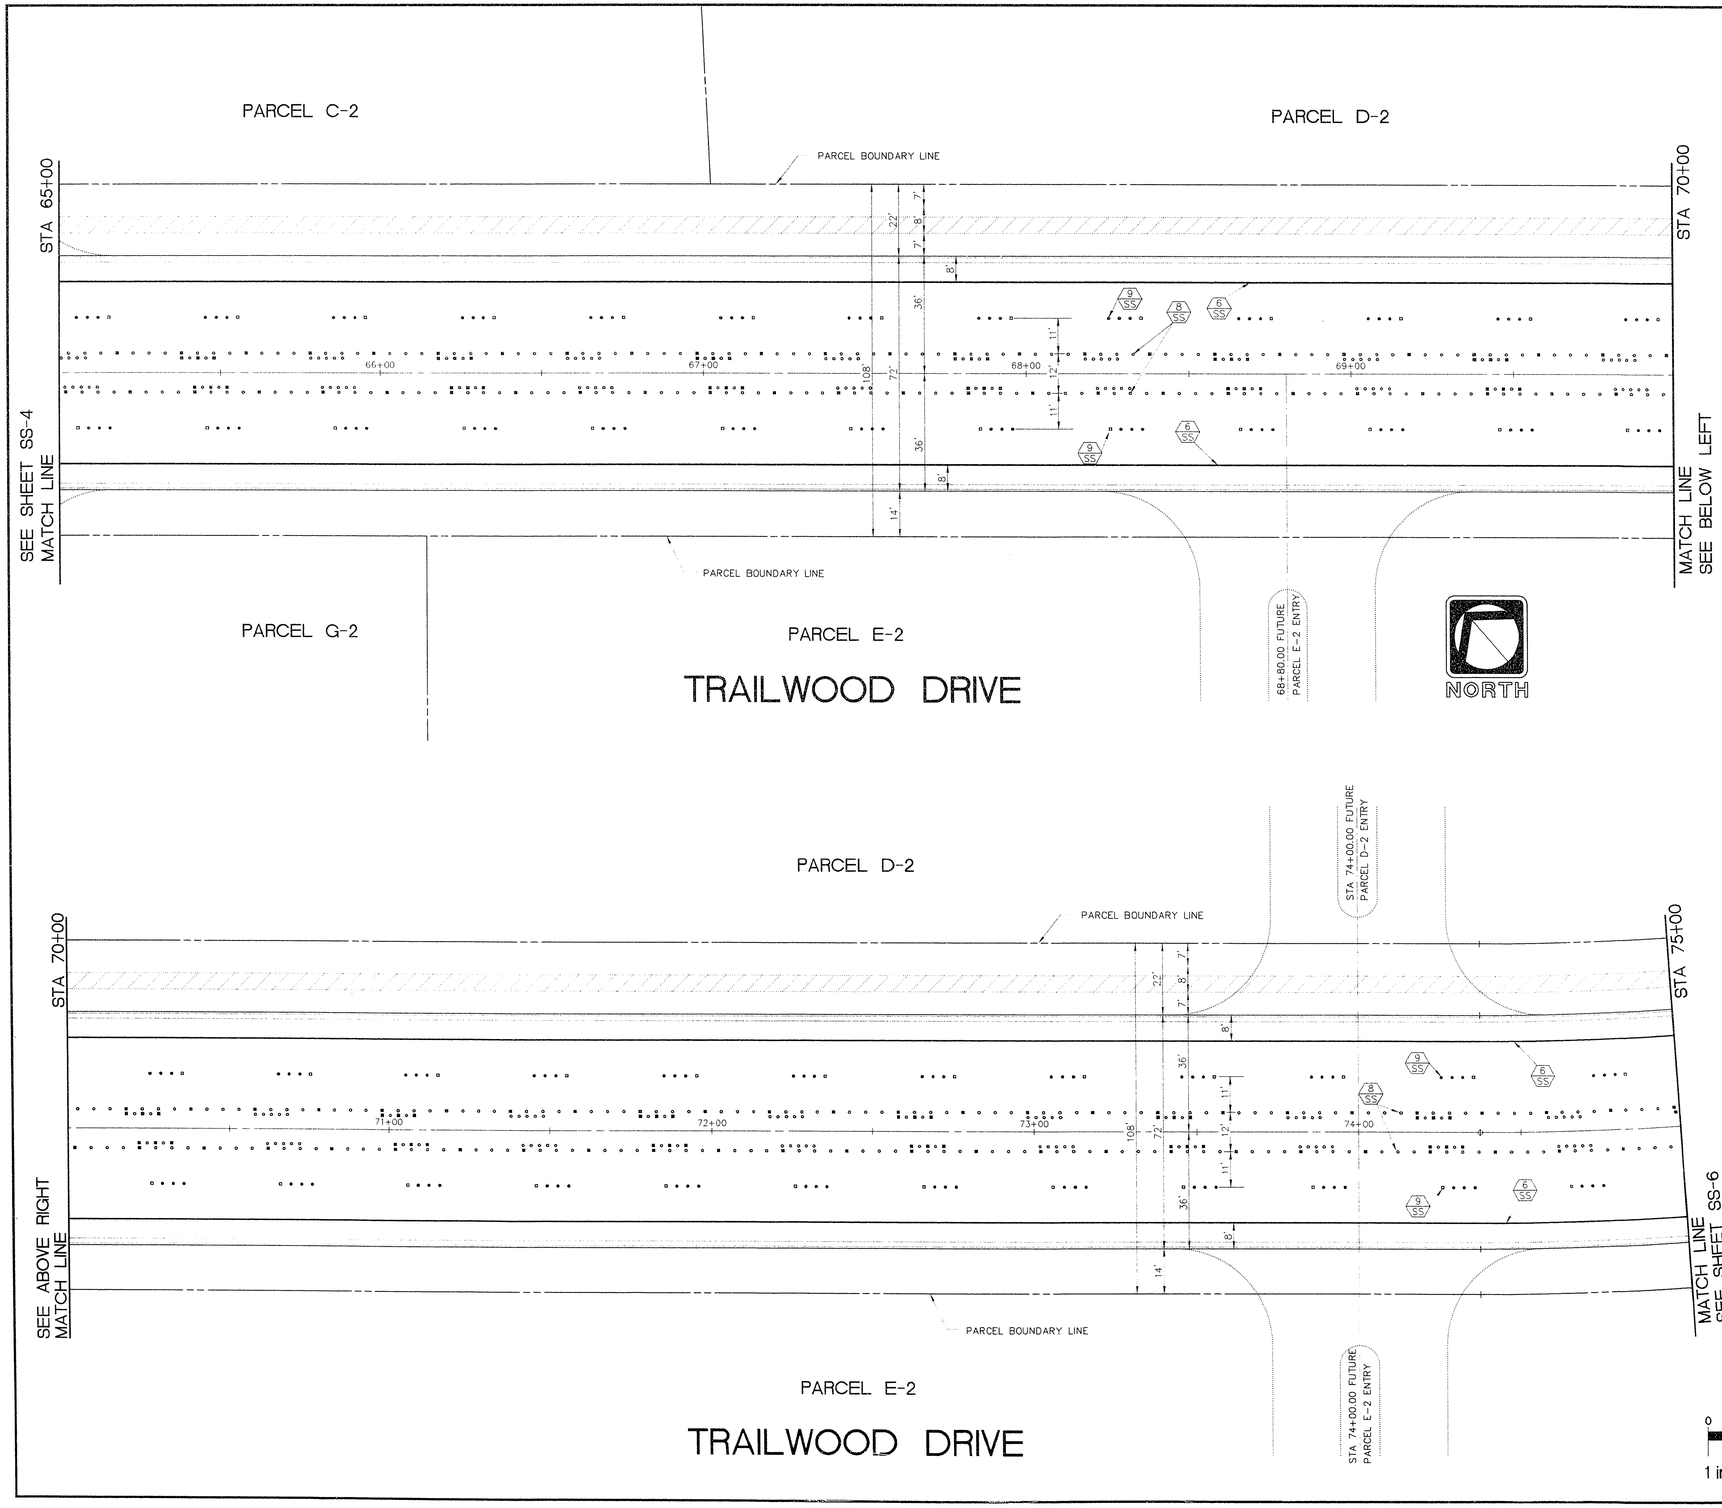

FUTURE STREET STRIPING AND SIGNAGE NOTES

1 SS ALL STREET SIGNS SHALL BE IN CONFORMANCE WITH THE MANUAL OF UNIFORM TRAFFIC CONTROL DEVICES (MUTCD) LATEST EDITION.

6 SS INSTALL 2000 LF 4" WHITE SOLID BIKE LANE LINE.

8 SS INSTALL 2000 LF. CONTINUOUS LEFT TURN LANE LINE.

9 SS INSTALL 2000 LF. BROKEN LANE LINE.

NOTE: STREET STRIPING AS SHOWN IS FUTURE AND NOT A PART OF THIS CONTRACT. STRIPING IS TO BE CONSTRUCTED IN THE FUTURE AFTER THE FINAL PAVING.

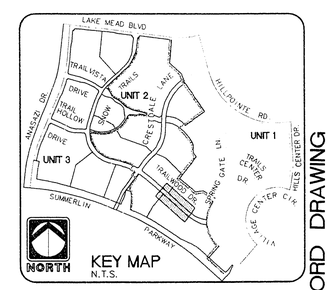

KEY MAP
N.T.S.

RECORD DRAWING
RECORD INFORMATION PROVIDED BY FIELD CONTRACTOR

REV.	DATE	DESCRIPTION	DATE	APPROVAL

RECOMMENDED
GARY R. BUSBY 10584 R.P.E. 6/15/94 DATE

ENGINEER
THE KEITH COMPANIES NEVADA
4052 SO. INDUSTRIAL RD LAS VEGAS, NV 89103
• PLANNING
• CIVIL ENGINEERING
• LANDSCAPE ARCHITECTURE
• LAND SURVEYING
• PROJECT MANAGEMENT
LAS VEGAS, NV 89103 (702) 733-0350

HOWARD HUGHES PROPERTIES
SUMMERLIN VILLAGE 7 - THE TRAILS - UNIT 2
TRAILWOOD DRIVE
FUTURE SIGNING AND STRIPING
STA.65+00 - STA.75+00

SHEET
SS-5
SHT 42 OF 48

11-2-105

107Y-4271-2