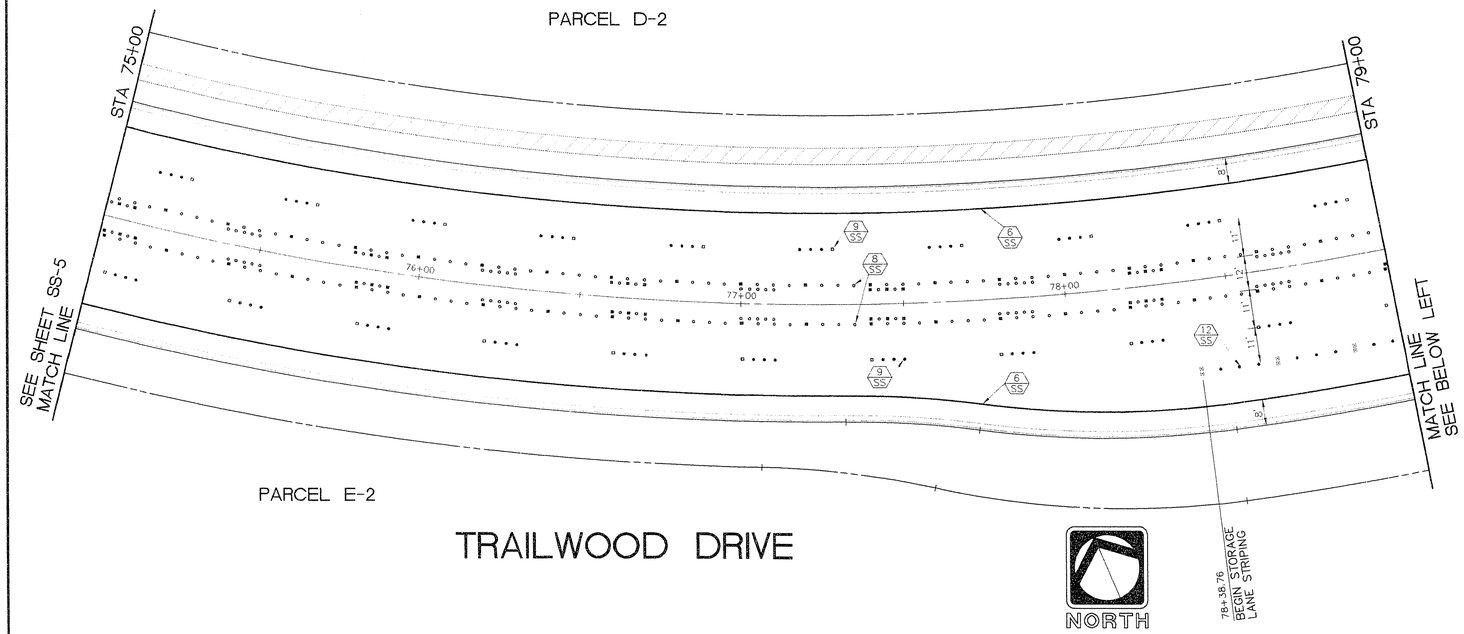

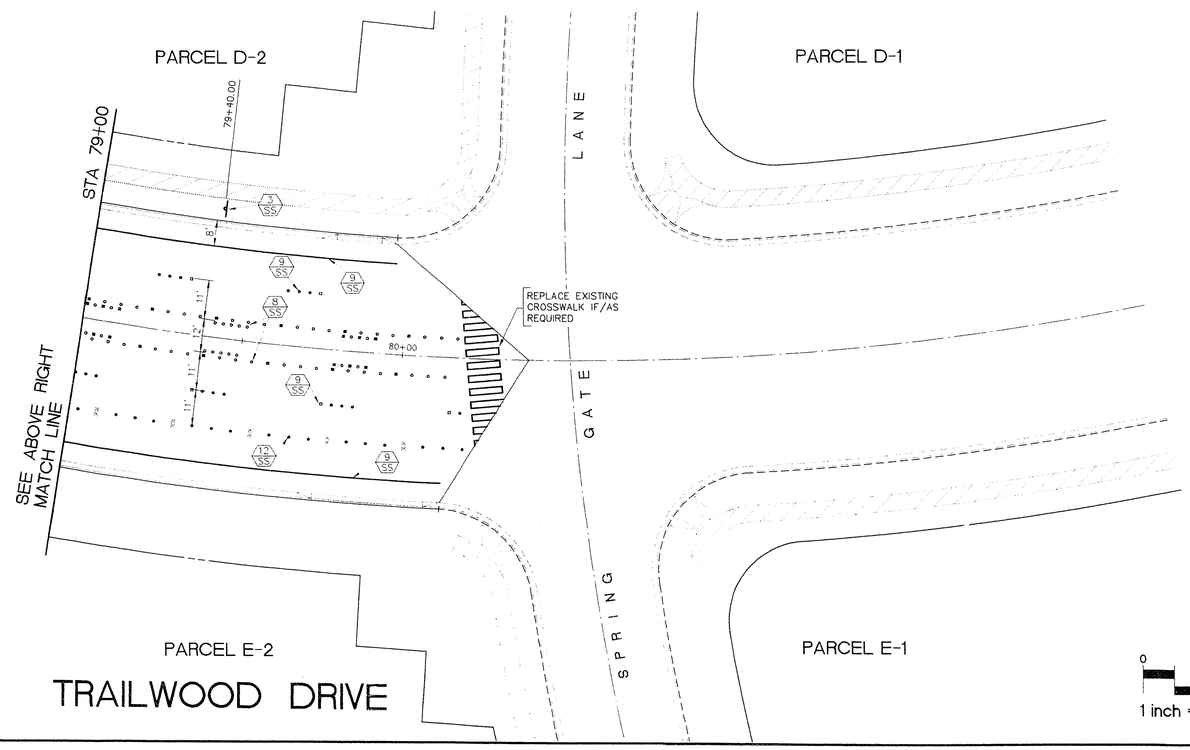

FUTURE STREET STRIPING AND SIGNAGE NOTES

1 SS — ALL STREET SIGNS SHALL BE IN CONFORMANCE WITH THE MANUAL OF UNIFORM TRAFFIC CONTROL DEVICES (MUTCD) LATEST EDITION.

3 SS — INSTALL 1 EA. R2-1 (24" X 30") 25 M.P.H. SPEED LIMIT SIGN.

6 SS — INSTALL 1041 LF 4" WHITE SOLID BIKE LANE LINE.

7 SS — INSTALL 166 S.F. CROSSWALK

8 SS — INSTALL 1036 L.F. CONTINUOUS LEFT TURN LANE LINE.

9 SS — INSTALL 1036 L.F. BROKEN LANE LINE.

12 SS — INSTALL 188 L.F. STORAGE LANE LINE.

NOTE: STREET STRIPING AS SHOWN IS FUTURE AND NOT A PART OF THIS CONTRACT. STRIPING IS TO BE CONSTRUCTED IN THE FUTURE AFTER THE FINAL PAVING.

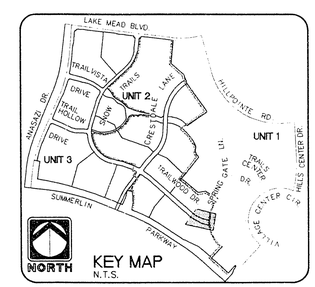

RECORD DRAWING
RECORD INFORMATION PROVIDED BY FIELD CONTRACTOR

REV.	DATE	DESCRIPTION	DATE	APPROVAL

RECOMMENDED
GARY R. DASBY R.P.E. 10584 DATE 6/25/24

• PLANNING
• CIVIL ENGINEERING
• LANDSCAPE ARCHITECTURE
• LAND SURVEYING
• TRANSPORTATION MANAGEMENT
LAS VEGAS, NV 89103 (702) 753-0350

ENGINEER
THE KEITH COMPANIES NEVADA
4052 SO. INDUSTRIAL RD LAS VEGAS NV 89103

HOWARD HUGHES PROPERTIES
SUMMERLIN VILLAGE 7 - THE TRAILS - UNIT 2
TRAIL WOOD DRIVE
FUTURE SIGNING AND STRIPING
STA 70+00 - STA 80+00

SHEET
SS-6
SHT 43 OF 47

11-2-106

1074-4271-2