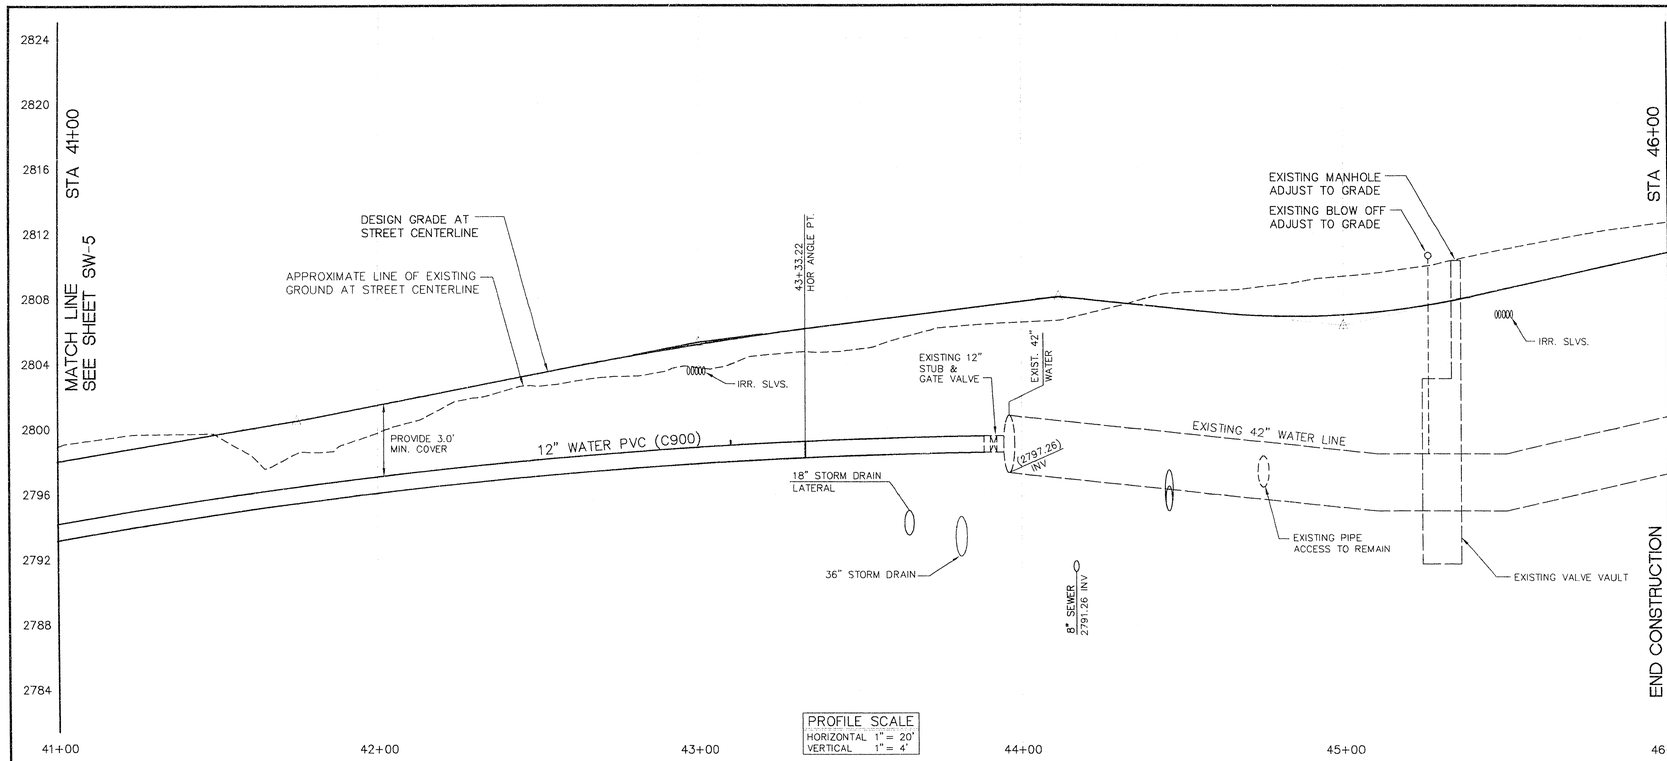

PROFILE SCALE
HORIZONTAL 1" = 20'
VERTICAL 1" = 4'

CONSTRUCTION NOTES (WATER)

- (W) INSTALL ALL WATER MAINS AND APIPURTENANCES PER L.V.V.W.D. STD. PLATES.
- (4 W) INSTALL 290.77 L.F. 12" PVC (C-900) WATER PIPE.
- (10 W) INSTALL 1 EA. 2" METER AND SERVICE LATERAL WITH BACKFLOW PREVENTION DEVICE FOR FUTURE LANDSCAPE IRRIGATION.
- (11 W) INSTALL 2 EA. SET 2-6" PVC AND 3-4" PVC (SDR-35) SLEEVES FOR FUTURE ELECTRICAL OR IRRIGATION PURPOSES.
- (13 W) REMOVE 1 EA END CAP AND CONNECT TO EXIST 12" WATER PIPE.
- (20 W) ADJUST 2 EA EXISTING VALVE COVER TO GRADE
- (21 W) ADJUST 1 EA EXISTING MANHOLE LID TO GRADE
- (22 W) ADJUST 1 EA EXISTING BLOW OFF COVER TO GRADE

GENERAL NOTES

1. PIPE LENGTHS SHOWN ARE FROM CENTERLINE OF MANHOLE TO CENTERLINE OF MANHOLE OR MATCHLINE AND ARE BASED ON LENGTHS AT CENTERLINE OF UTILITY (TYPICAL ALL SHEETS).
2. UTILITY LOCATIONS ARE BASED ON STREET CENTERLINE STATIONING.

LVVWD 6/17/94 DATE

REDUCED PRESSURE PRINCIPLE ASSEMBLY

Approved Reduced Pressure Principle Assembly(s) shall be installed per the District's Standard Plate No. 11. No water shall be taken from a service requiring backflow prevention until the reduced pressure principle assembly has been successfully tested by the LVVWD.

Any block wall or other fence material shall be designed and constructed around the outside of the easement(s), so as to allow the District direct access from the adjacent right-of-way.

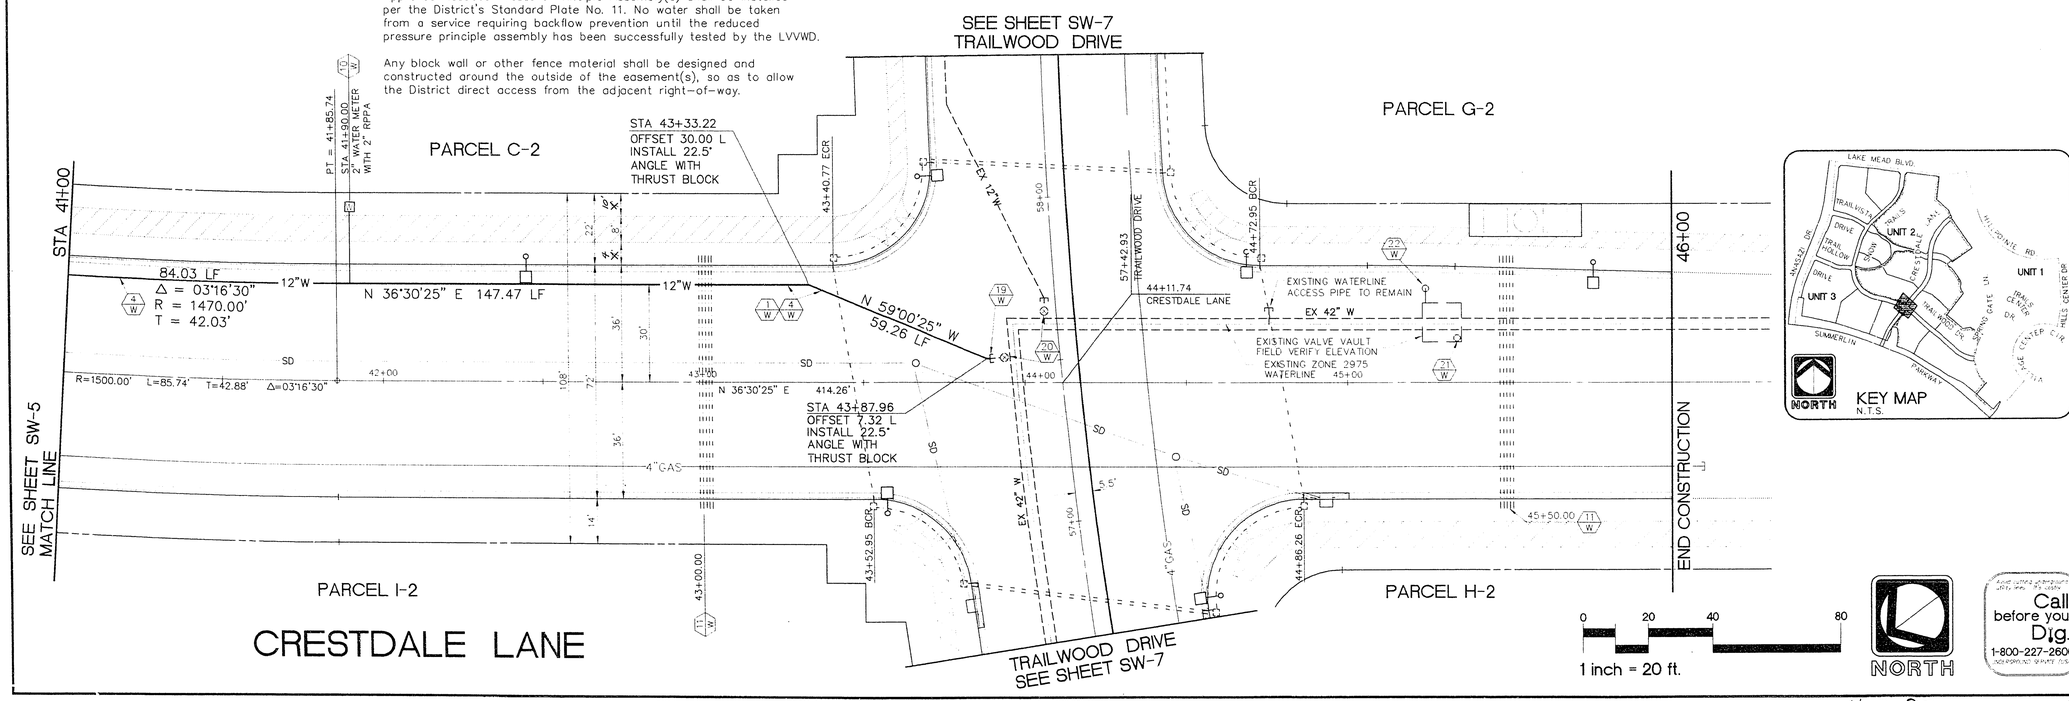

Call before you Dig. 1-800-227-2600

RECORD DRAWING
RECORD INFORMATION PROVIDED BY FIELD CONTRACTOR

RECOMMENDED
GARY R. BUSBY 10584 R.P.E. 6/15/94 DATE

REV.	DATE	DESCRIPTION	APPROVAL
A	6/27/94		

ENGINEER
THE KEITH COMPANIES NEVADA
4850 S. INDUSTRIAL RD. LAS VEGAS, NV 89103 (702) 733-0359

HOWARD HUGHES PROPERTIES
SUMMERLIN VILLAGE 7 - THE TRAILS - UNIT 2
CRESTDALE LANE
SEWER AND WATER
STA 41+00 - STA 46+00

SHEET
SW-6
SHT 31 OF 43

11-2-93

307X-4271-2