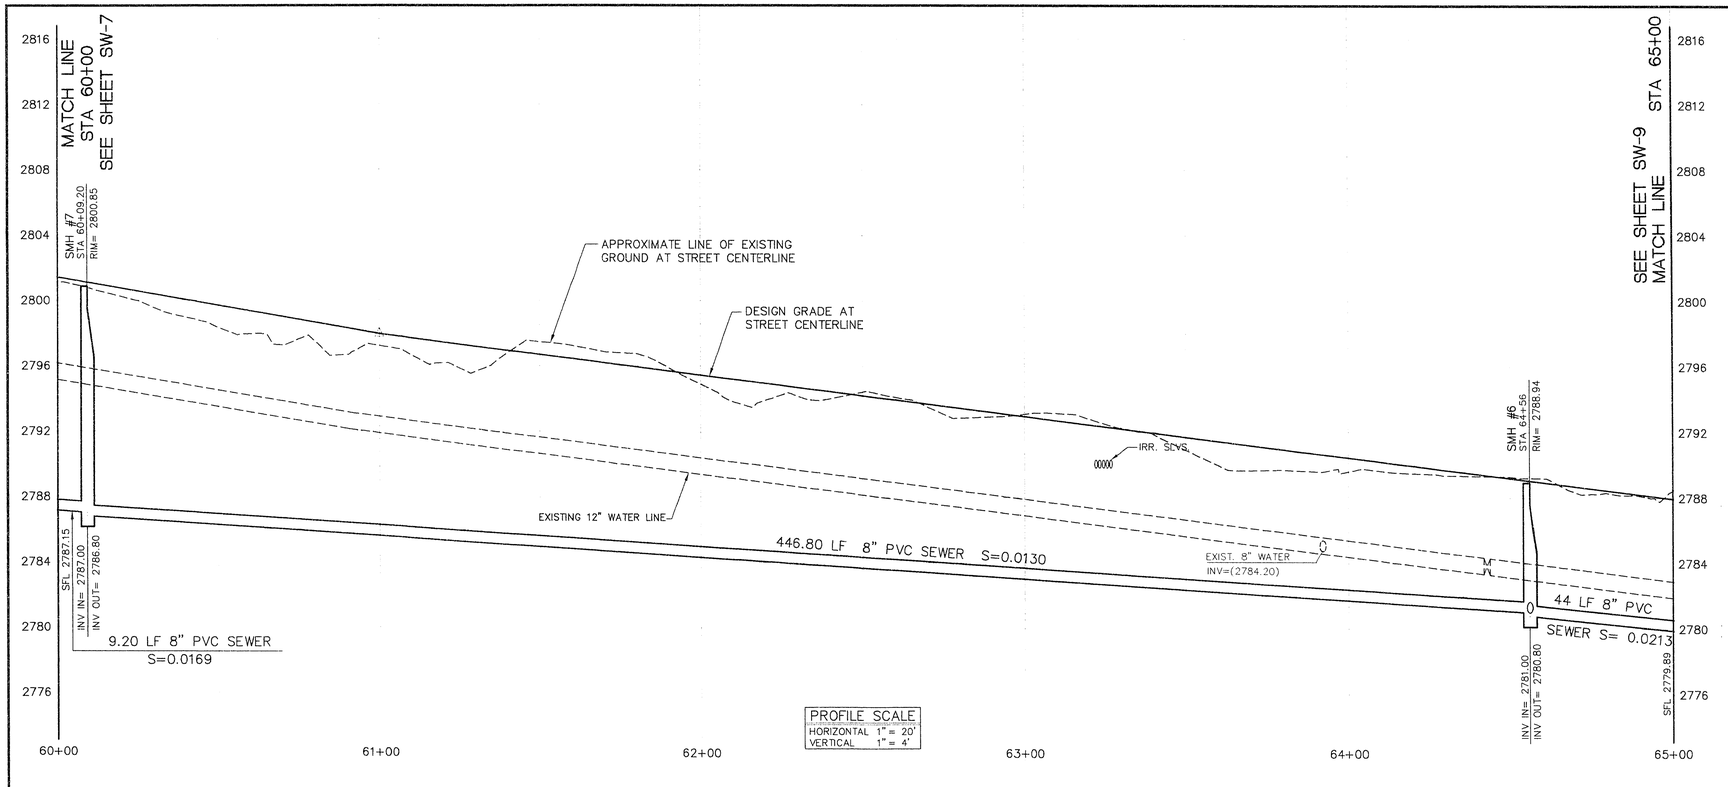

PROFILE SCALE
HORIZONTAL 1" = 20'
VERTICAL 1" = 4'

CONSTRUCTION NOTES (SEWER)

1 S — INSTALL 2 EA. STANDARD 4' SEWER MANHOLE PER CLARK COUNTY SANITATION DISTRICT STANDARD DRAWINGS.
2 S — INSTALL 554.47 L.F. 8" PVC (SDR-35) SEWER LINE.
3 S — INSTALL 1 EA. 8" PVC PLUG STUB-OUT PLUG AND CAP.

CONSTRUCTION NOTES (WATER)

11 W — INSTALL 1 SET 2-6" PVC AND 3-4" PVC (SDR-35) SLEEVES FOR FUTURE ELECTRICAL OR IRRIGATION PURPOSES.
20 W — ADJUST 3 EA. EXISTING VALVE COVER TO GRADE

GENERAL NOTES

1. PIPE LENGTHS SHOWN ARE FROM CENTERLINE OF MANHOLE TO CENTERLINE OF MANHOLE OR MATCHLINE AND ARE BASED ON LENGTHS AT CENTERLINE OF UTILITY (TYPICAL ALL SHEETS).
2. UTILITY LOCATIONS ARE BASED ON STREET CENTERLINE STATIONING.

LVVWD — 6/17/94 DATE

RECORD DRAWING
RECORD INFORMATION PROVIDED BY FIELD CONTRACTOR

RECOMMENDED
GARY R. BUSBY — 10584 R.P.E. — 6/15/94 DATE

REV.	DATE	DESCRIPTION	DATE	APPROVAL

ENGINEER
THE KEITH COMPANIES NEVADA
4005 SO. INDUSTRIAL RD. LAS VEGAS, NV. 89103 (702) 733-0585

- PLANNING
- CIVIL ENGINEERING
- LANDSCAPE ARCHITECTURE
- LAND SURVEYING
- CONSTRUCTION MANAGEMENT

HOWARD HUGHES PROPERTIES
SUMMERLIN VILLAGE 7 - THE TRAILS - UNIT 2
TRAILWOOD DRIVE
PLAN AND PROFILE
STA 60+00 - STA 65+00

SHEET
SW-8
SHT 33 OF 42

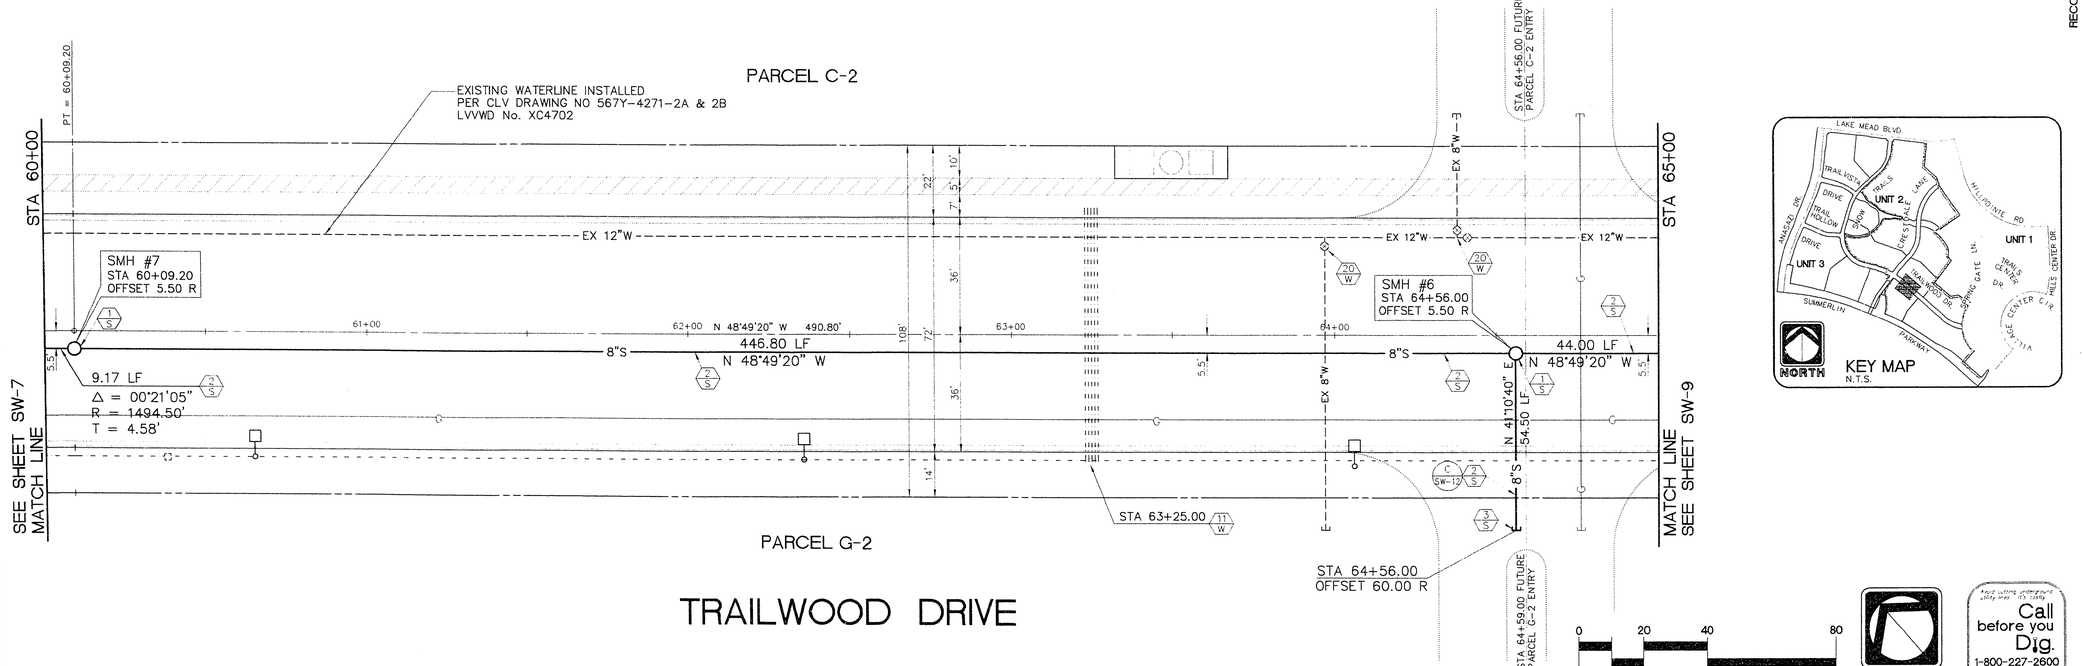

0 20 40 80
1 inch = 20 ft.

NORTH

Call before you Dig. 1-800-227-2600

11-295

3074-4271-2