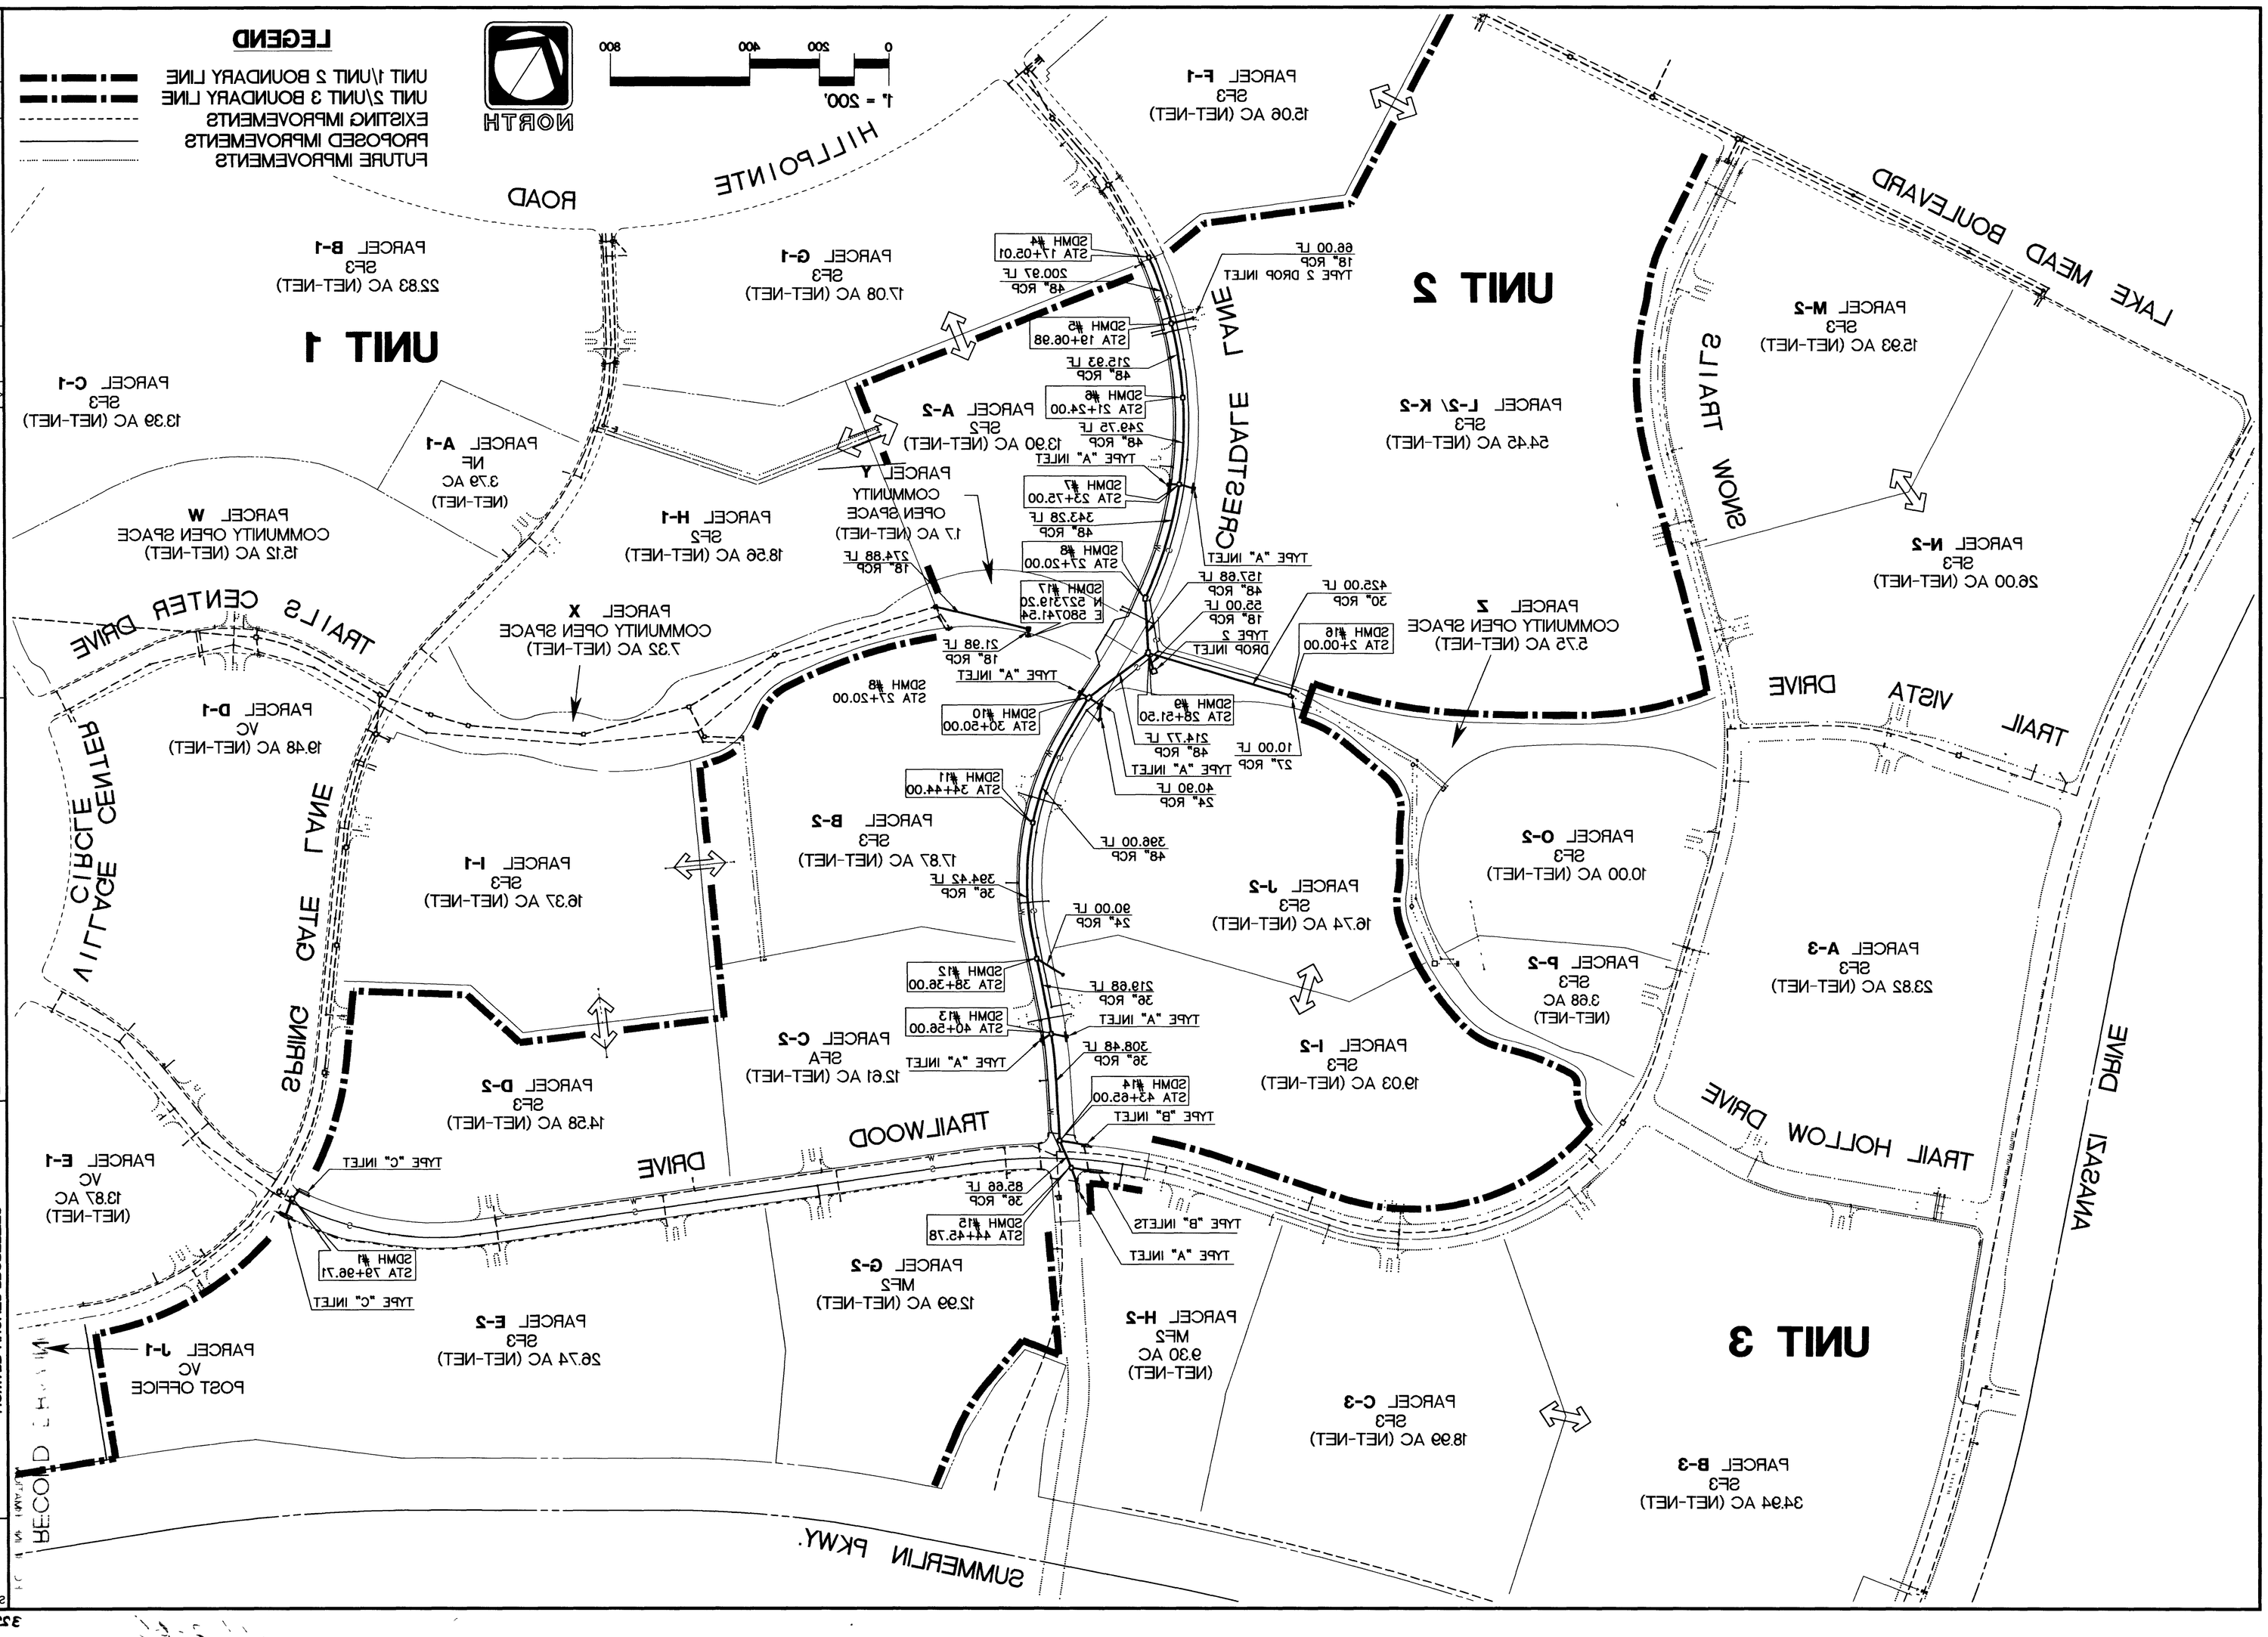

HOWARD HUGHES PROPERTIES
SUMMERLIN VILLAGE 7 - THE TRAILS - UNIT 2
STORM DRAINAGE MASTER UTILITY

SHEET
MU-1
SHT 6 OF 47

ENGINEERS
VEGAS COMPANIES
KEITH HILL

DESCRIPTION | DATE | DATE

DATE | REV. | DATE

RECOMMENDED

DATE | R.E.

CITY OF LAS VEGAS

0920-ESL (2001) (2018) IN 2020 DIGITAL DR JAN 2020

UNIT 1
UNIT 3
UNIT 3
VILLAGE
CENTER
DRIVE
RECORD
DRIVE
TEGEND