


COURSE TABLE

LINE	BEARING	DISTANCE
L1	S 0°04'34" W	293.90
L2	S 7°42'31" E	56.45
L3	S 7°42'31" E	112.90
L4	S 31°16'18" E	82.23
L5	S 74°21'41" E	80.56
L6	S 72°14'46" E	47.44
L7	S 72°14'59" E	23.73
L8	S 64°26'31" E	49.87
L9	S 79°56'23" E	111.78
L10	S 82°16'05" E	130.55
L11	S 83°06'12" E	92.07
L12	S 53°56'06" E	24.43
L13	S 81°13'46" E	97.62
L14	S 82°37'24" E	122.45
L15	S 82°37'25" E	61.23
L16	S 0°04'01" W	7.36
L17	S 82°59'49" E	59.83
L18	S 82°35'57" E	61.48
L19	S 82°35'57" E	30.74
L20	S 52°42'06" W	67.01
L21	N 89°15'10" E	36.31
L22	N 89°15'42" E	50
L23	N 89°15'42" E	25
L24	S 67°46'41" E	75.86

LEGEND

- L1 COURSE NUMBER
- △ SET REBAR & AL CAP PLS 6201
- BOUNDARY LINE
- FOUND BLM BRASS CAP
- ▲ FOUND POINT AS INDICATED
- ( ) CALCULATED ALIQUOT LINES BASED UPON THE SINGLE PROPORTION LOCATION OF THE TOWNSHIP LINE BETWEEN BLM COR. AND THE TOWNSHIP COR. AT LONE MOUNTAIN AND DECATUR BOULEVARD

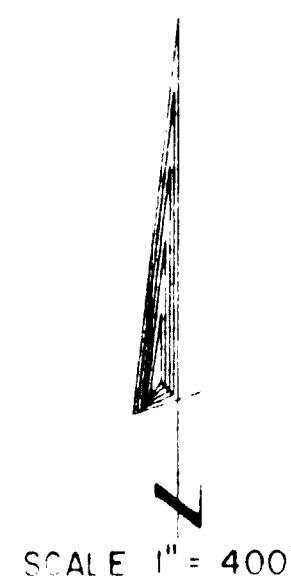

<b>VTN</b>		CONSULTING ENGINEERS - PLANNERS 2727 S. RAINBOW BOULEVARD LAS VEGAS, NEV 89102 (702) 873-7550	
<b>RECORD OF SURVEY FOR</b>			
<b>VTN NEVADA</b>			
SEC. 36, T. 19 S., R. 60 E., M.D.M., 8			
SEC. 31, T. 19 S., R. 61 E., M.D.M.,			
CLARK COUNTY, NEVADA			
SCALE 1" = 400'	WO NO 3742	DATE 9-90	SHEET OF
DISK 3742 PJ	DRN DH		<b>2 5</b>

3573

FILE 57 PAGE 05  
055-620