


**COURSE TABLE**

LINE	BEARING	DISTANCE
L1	S 80° 21' 57" E	49.97
L2	S 80° 12' 22" E	99.93
L3	S 80° 02' 20" E	149.86
L4	S 56° 57' 18" E	199.40
L5	N 13° 14' 20" W	180.85
L6	S 86° 09' 21" E	58.74
L7	S 86° 04' 21" E	117.87
L8	S 85° 52' 52" E	176.43
L9	S 63° 14' 01" E	216.57
L10	S 70° 54' 38" E	67.98
L11	S 70° 21' 29" E	136.72
L12	S 87° 39' 47" E	185.71
L13	S 86° 01' 23" E	234.34
L14	S 73° 51' 01" E	77.88
L15	S 73° 44' 36" E	156.19
L16	S 74° 50' 48" E	206.36
L17	S 74° 51' 22" E	243.30
L18	S 83° 36' 38" E	96.22
L19	S 76° 30' 21" E	88.02
L20	S 76° 22' 50" E	176.09
L21	S 80° 38' 31" E	229.64
L22	S 82° 15' 07" E	257.17
L23	S 82° 38' 38" E	282.74
L24	S 82° 38' 06" E	135.25
L25	N 29° 55' 26" E	.28
L26	N 5° 44' 11" E	.38

**LEGEND**

- L1 COURSE NUMBER
- △ SET REBAR & AL CAP PLS 6201
- BOUNDARY LINE
- CALCULATED LINE PER BLM SURVEY
- FOUND BLM BRASS CAP
- FOUND POINT AS INDICATED
- NOTE A THE POINT SET OR FOUND AS INDICATED IN RECORD OF SURVEY
- FND PT. HAS BEEN REPLACED BY BLM BRASS CAP
- MINOR DIFFERENCES IN POSITION ARE NOTED HEREON

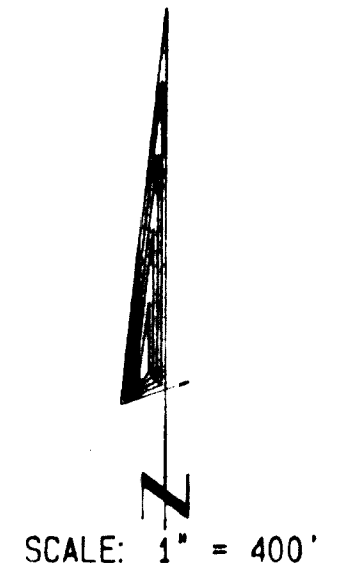

**VTN** CONSULTING ENGINEERS - PLANNERS  
 2727 S. RAINBOW BOULEVARD  
 LAS VEGAS, NEV. 89102 (702) 873-7550

**RECORD OF SURVEY FOR VTN NEVADA**  
 SEC. 24, T. 19 S., R. 60 E., M.D.M., 8  
 SEC. 19, T. 19 S., R. 61 E., M.D.M.,  
 CLARK COUNTY, NEVADA

SCALE 1" = 400'	WO NO 3742	DATE 9-90	SHEET	OF
DISK 3742 PJ	DRN DH		4	5

3525