


COURSE TABLE

LINE	BEARING	DISTANCE
L1	N 45° 58' 23" E	.10
L2	N 54° 23' 28" E	.13
L3	S 90° 01' 53" E	37.43
L4	S 50° 57' 20" E	48.85
L5	N 58° 39' 16" E	.11
L6	S 80° 21' 21" E	.13
L7	S 58° 57' 20" E	98.70
L8	N 42° 08' 14" E	.19
L9	S 80° 10' 56" E	74.88
L10	S 78° 21' 31" E	234.03
L11	S 50° 56' 43" E	148.53
L12	S 80° 21' 57" E	49.97
L13	S 80° 12' 22" E	99.93
L14	S 76° 26' 18" E	282.73
L15	S 80° 57' 18" E	198.40
L16	S 13° 14' 20" E	186.85
L17	N 29° 58' 28" E	.18
L18	N 29° 55' 26" E	.28
L19	N 29° 56' 46" E	.21
L20	N 29° 54' 31" E	.14
L21	N 29° 43' 36" E	.07
L22	N 29° 57' 30" E	.16

LEGEND

- L1 COURSE NUMBER
- △ SET REBAR & AL CAP PLS 6201
- BOUNDARY LINE
- FOUND BLM BRASS CAP
- ▲ FOUND POINT AS INDICATED
- () CALCULATED BEARING & DISTANCE PER BLM SURVEY
- NOTE A THE POINT SET OR FOUND AS INDICATED IN RECORD OF SURVEY FND PT. HAS BEEN REPLACED BY BLM BRASS CAP MINOR DIFFERENCES IN POSITION ARE NOTED HEREON

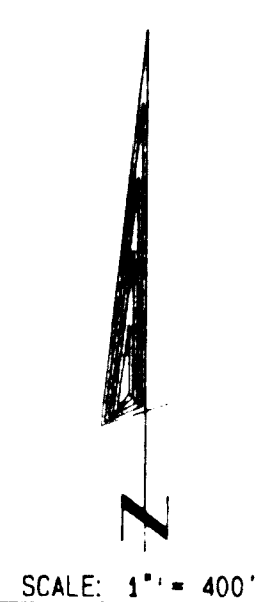

VTN CONSULTING ENGINEERS - PLANNERS
 2727 S. RAINBOW BOULEVARD
 LAS VEGAS, NEV. 89102 (702) 873-7550

RECORD OF SURVEY
 FOR
VTN NEVADA
 SEC. 13, T. 19 S., R. 60 E., M.D.M., 8
 SEC. 18, T. 19 S.; R. 61 E., M.D.M.,
 CLARK COUNTY, NEVADA

SCALE 1" = 400'	WO NO 3742	DATE 9-90	SHEET	OF
DISK 3742 PJ	DRN DH		5	5

357b