
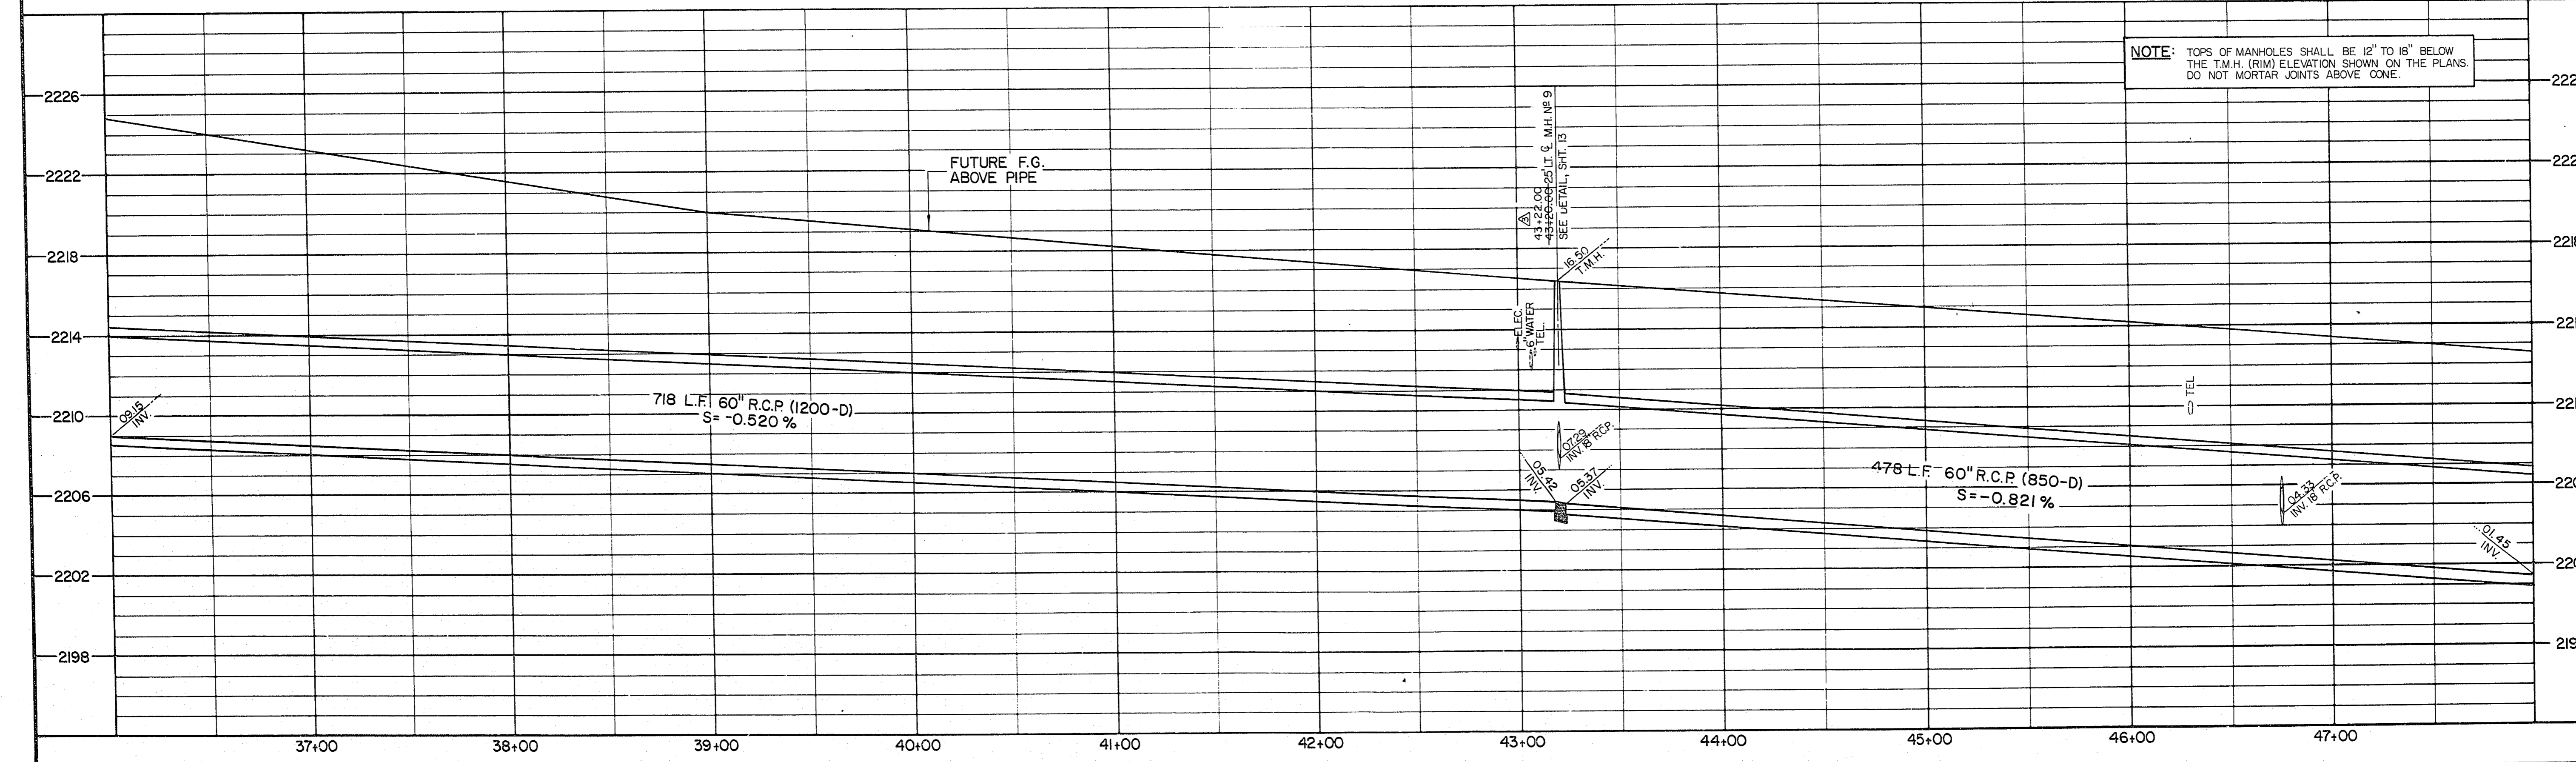


MAILBOX NOTE: Δ
MAILBOXES LOCATED BETWEEN STA. 33+80.00 TO STA. 57+90.00,
LESS THAN 45' FROM ϕ TO BE RELOCATED BY CONTRACTOR.

NOTES:
(B) TO BE REMOVED AND OR RELOCATED
(C) ITEM TO REMAIN

CLEARING AND GRUBBING LIMITS:
SMOKE RANCH ROAD TO BE CLEARED & GRUBBED
FROM STA. 33+80 TO STA. 57+90, 10 FT. TO 50 FT. OF ϕ

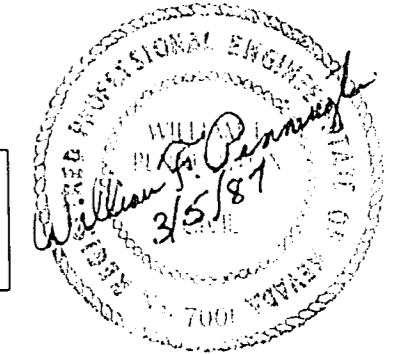

NOTE: TOPS OF MANHOLES SHALL BE 12\"/>

REV. NO.	DATE	DESCRIPTION	APPROVED
1	4/17/87	REVISIONS PER ADDENDUM #1	
2	10/6/88	CHANGED DURING CONSTRUCTION	

DESIGNED BY: W. Pennington, K. Lambert
 DRAWN BY: Kevin R.P. Ch...
 CHECKED BY: William R. Pennington

CLARK COUNTY NEVADA
DEPARTMENT OF PUBLIC WORKS

SMOKE RANCH ROAD
 STORM DRAIN PLAN AND PROFILE
 STA. 36+00 TO STA. 48+00

SCALE	HORZ. : 1"=40'	VERT. : 1"=4'	DRAWING NO.
PROJECT NO.	830524R		L-750A
FIELD	#281, #2341		
BOOK	#595, #596		SHT. 6 OF 13