



SCALE: 1"=40' HORIZ
1"=4' VERT

CURVE DATA			
NO	Δ	R	T
①	180°00'00"	2.00'	∞
②	92°08'18"	30.00'	31.14'
③	87°51'48"	30.00'	28.90'
④	87°51'48"	30.00'	28.90'
⑤	92°08'12"	30.00'	31.14'

REVISIONS			
NO	DESCRIPTION	DATE	BY
1	REMOVE V.C. MEDIAN	2/16/85	KA

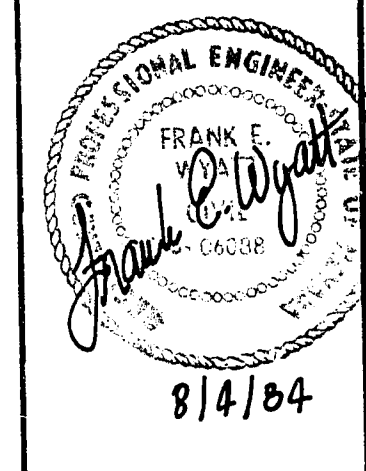

SPARKS, NEVADA
LAS VEGAS, NEVADA
SEATTLE, WASHINGTON
INCORPORATED
S&P
ENGINEERS/PLANNERS

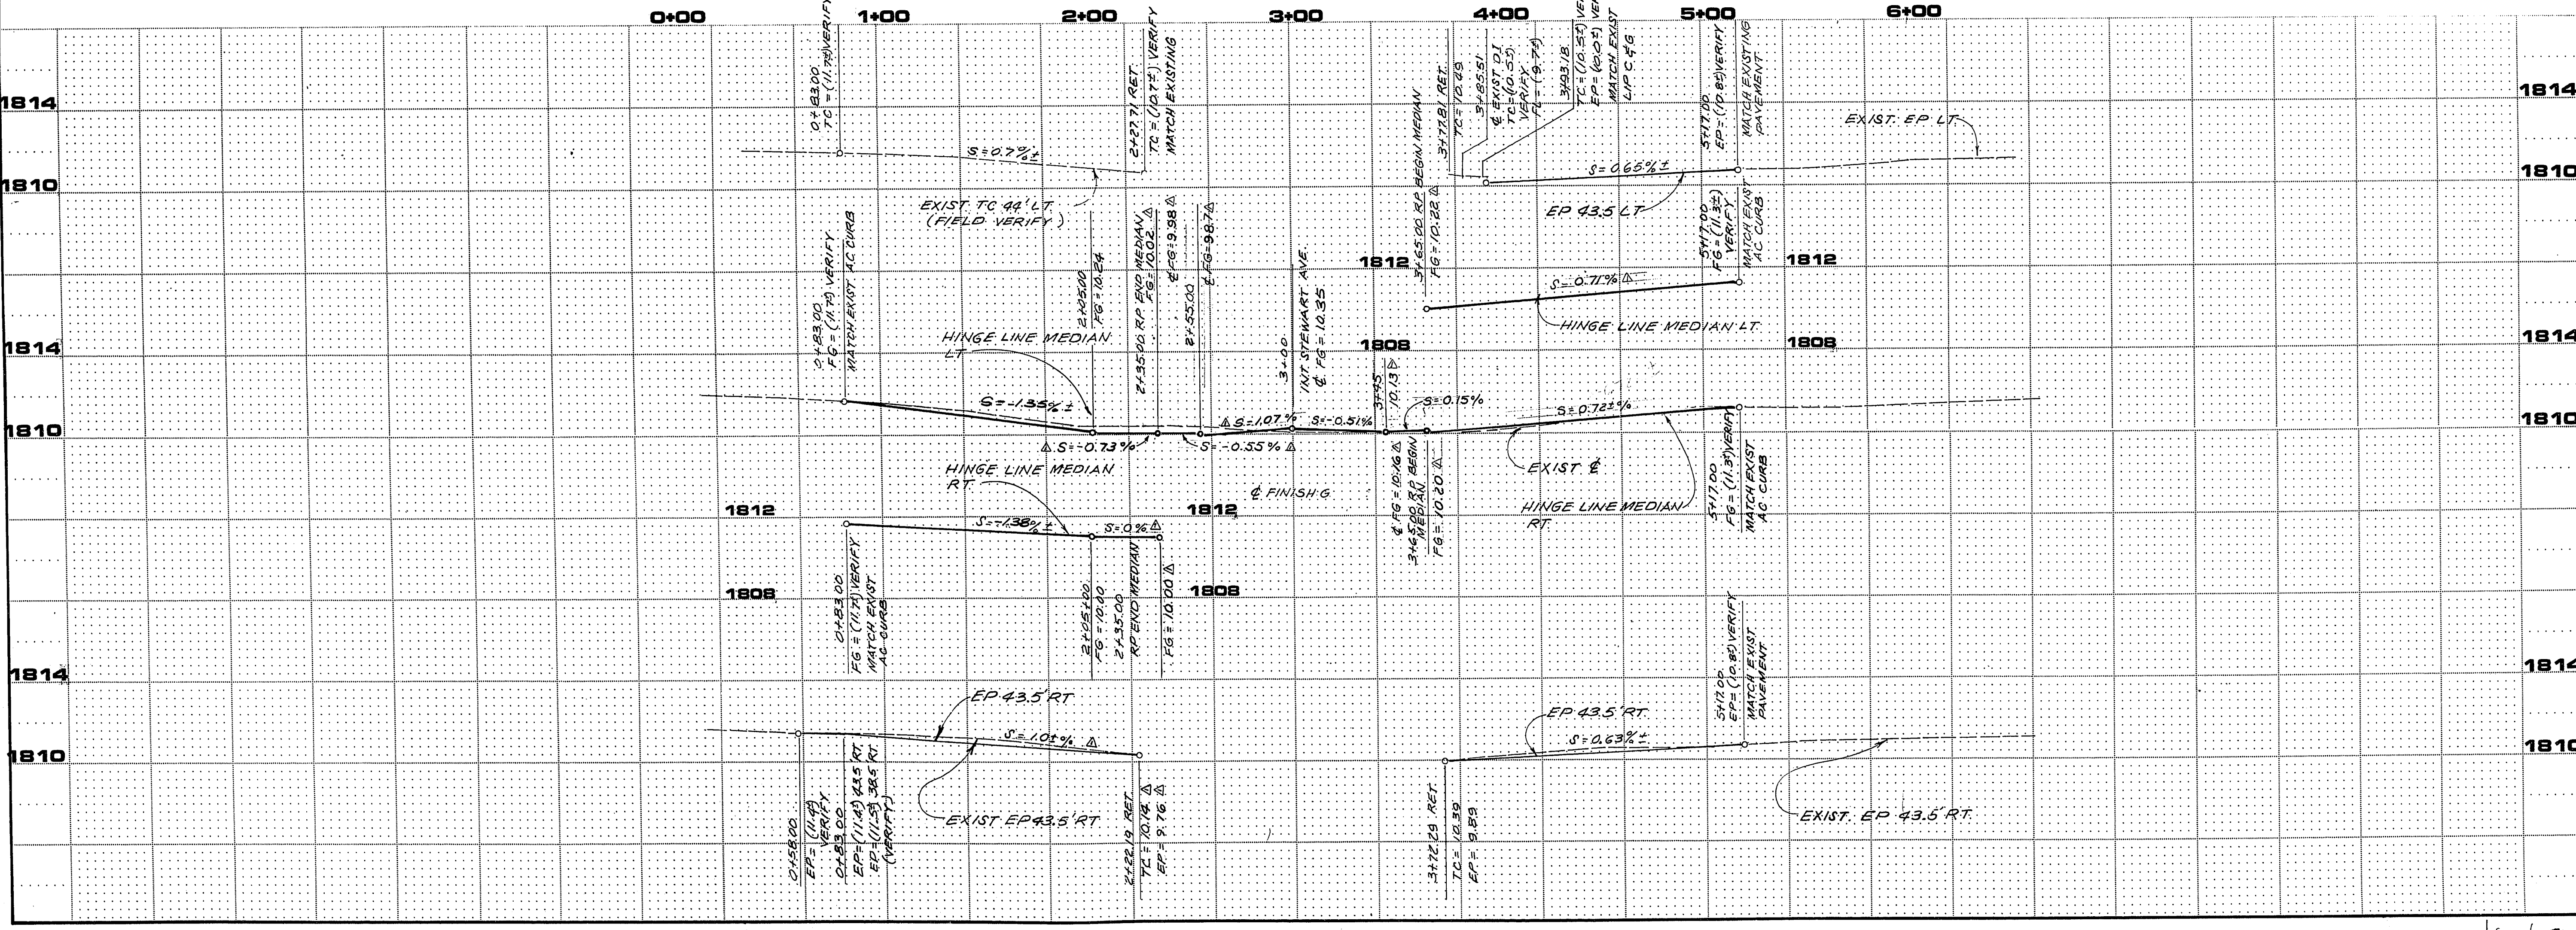

CITY OF LAS VEGAS
STEWART AVENUE
28TH STREET TO NELLIS BOULEVARD
RECONSTRUCTION PLAN & PROFILE
MOJAVE ROAD

JOB NO. 2-241-005-821
DESIGNED KA
DRAWN AC
COMP. [Name]
CHECKED [Name]
DATE FEBRUARY, 1984
SHEET NO.

23

16-4-37 107-V8190