


NOTE: All record distances and bearings are from Curtis Park Manor Units 2 & 4.

SURVEYOR'S CERTIFICATE:

[Jerry E. Barnson, a duly registered Land Surveyor in the State of Nevada acting as agent for myself do hereby certify that the survey of the land shown hereon was made under my direct supervision at the instance of George and Anna Essayian the survey was completed on 1/19/84, and that the points found and set are correctly shown hereon, this plat does not constitute a subdivision as defined by Nevada Revised Statutes.

Jerry E. Barnson
 Jerry E. Barnson, R.L.S.
 Nevada Certificate No. 4066
 Date 1/19/84

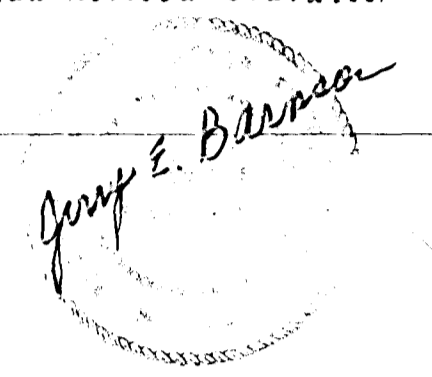

BASIS OF BEARING:

50°10'48"W, being the centerline of Decatur Blvd. as shown on Curtis Park Manor Unit No. 2, Book 5, Page 24 Clark County, Nevada Records.

LEGAL DESCRIPTION:

Lot 22, Block 5, Curtis Park Manor Unit No. 2 Book 5, Page 24 and the West 60.00 feet of Decatur Blvd. fronting said Lot 22.

LEGEND

- End as shown
- set 3/8" Rebar & Plastic Cap R.L.S. 4066, unless otherwise shown

RECORD OF SURVEY: For George and Anna Essayian Of Lot 22, Block 5, Curtis Park Manor Unit No. 2 Annexed to the City of Las Vegas, Clark County, Nevada under Ordinance No. 3101	No. 1869851 Filed At The Request Of: George Essayian Date: 1/19/84 At 2:15 A.M. File 41 Page 50 of Surveys Official Records Book No. 220a Clark County, Nevada Records Joan L. Swift, Recorder Fee \$ 10.00 Deputy D.C.S.
--	--