


IVI-20-0

VAC-4-85

HARRIS AVE

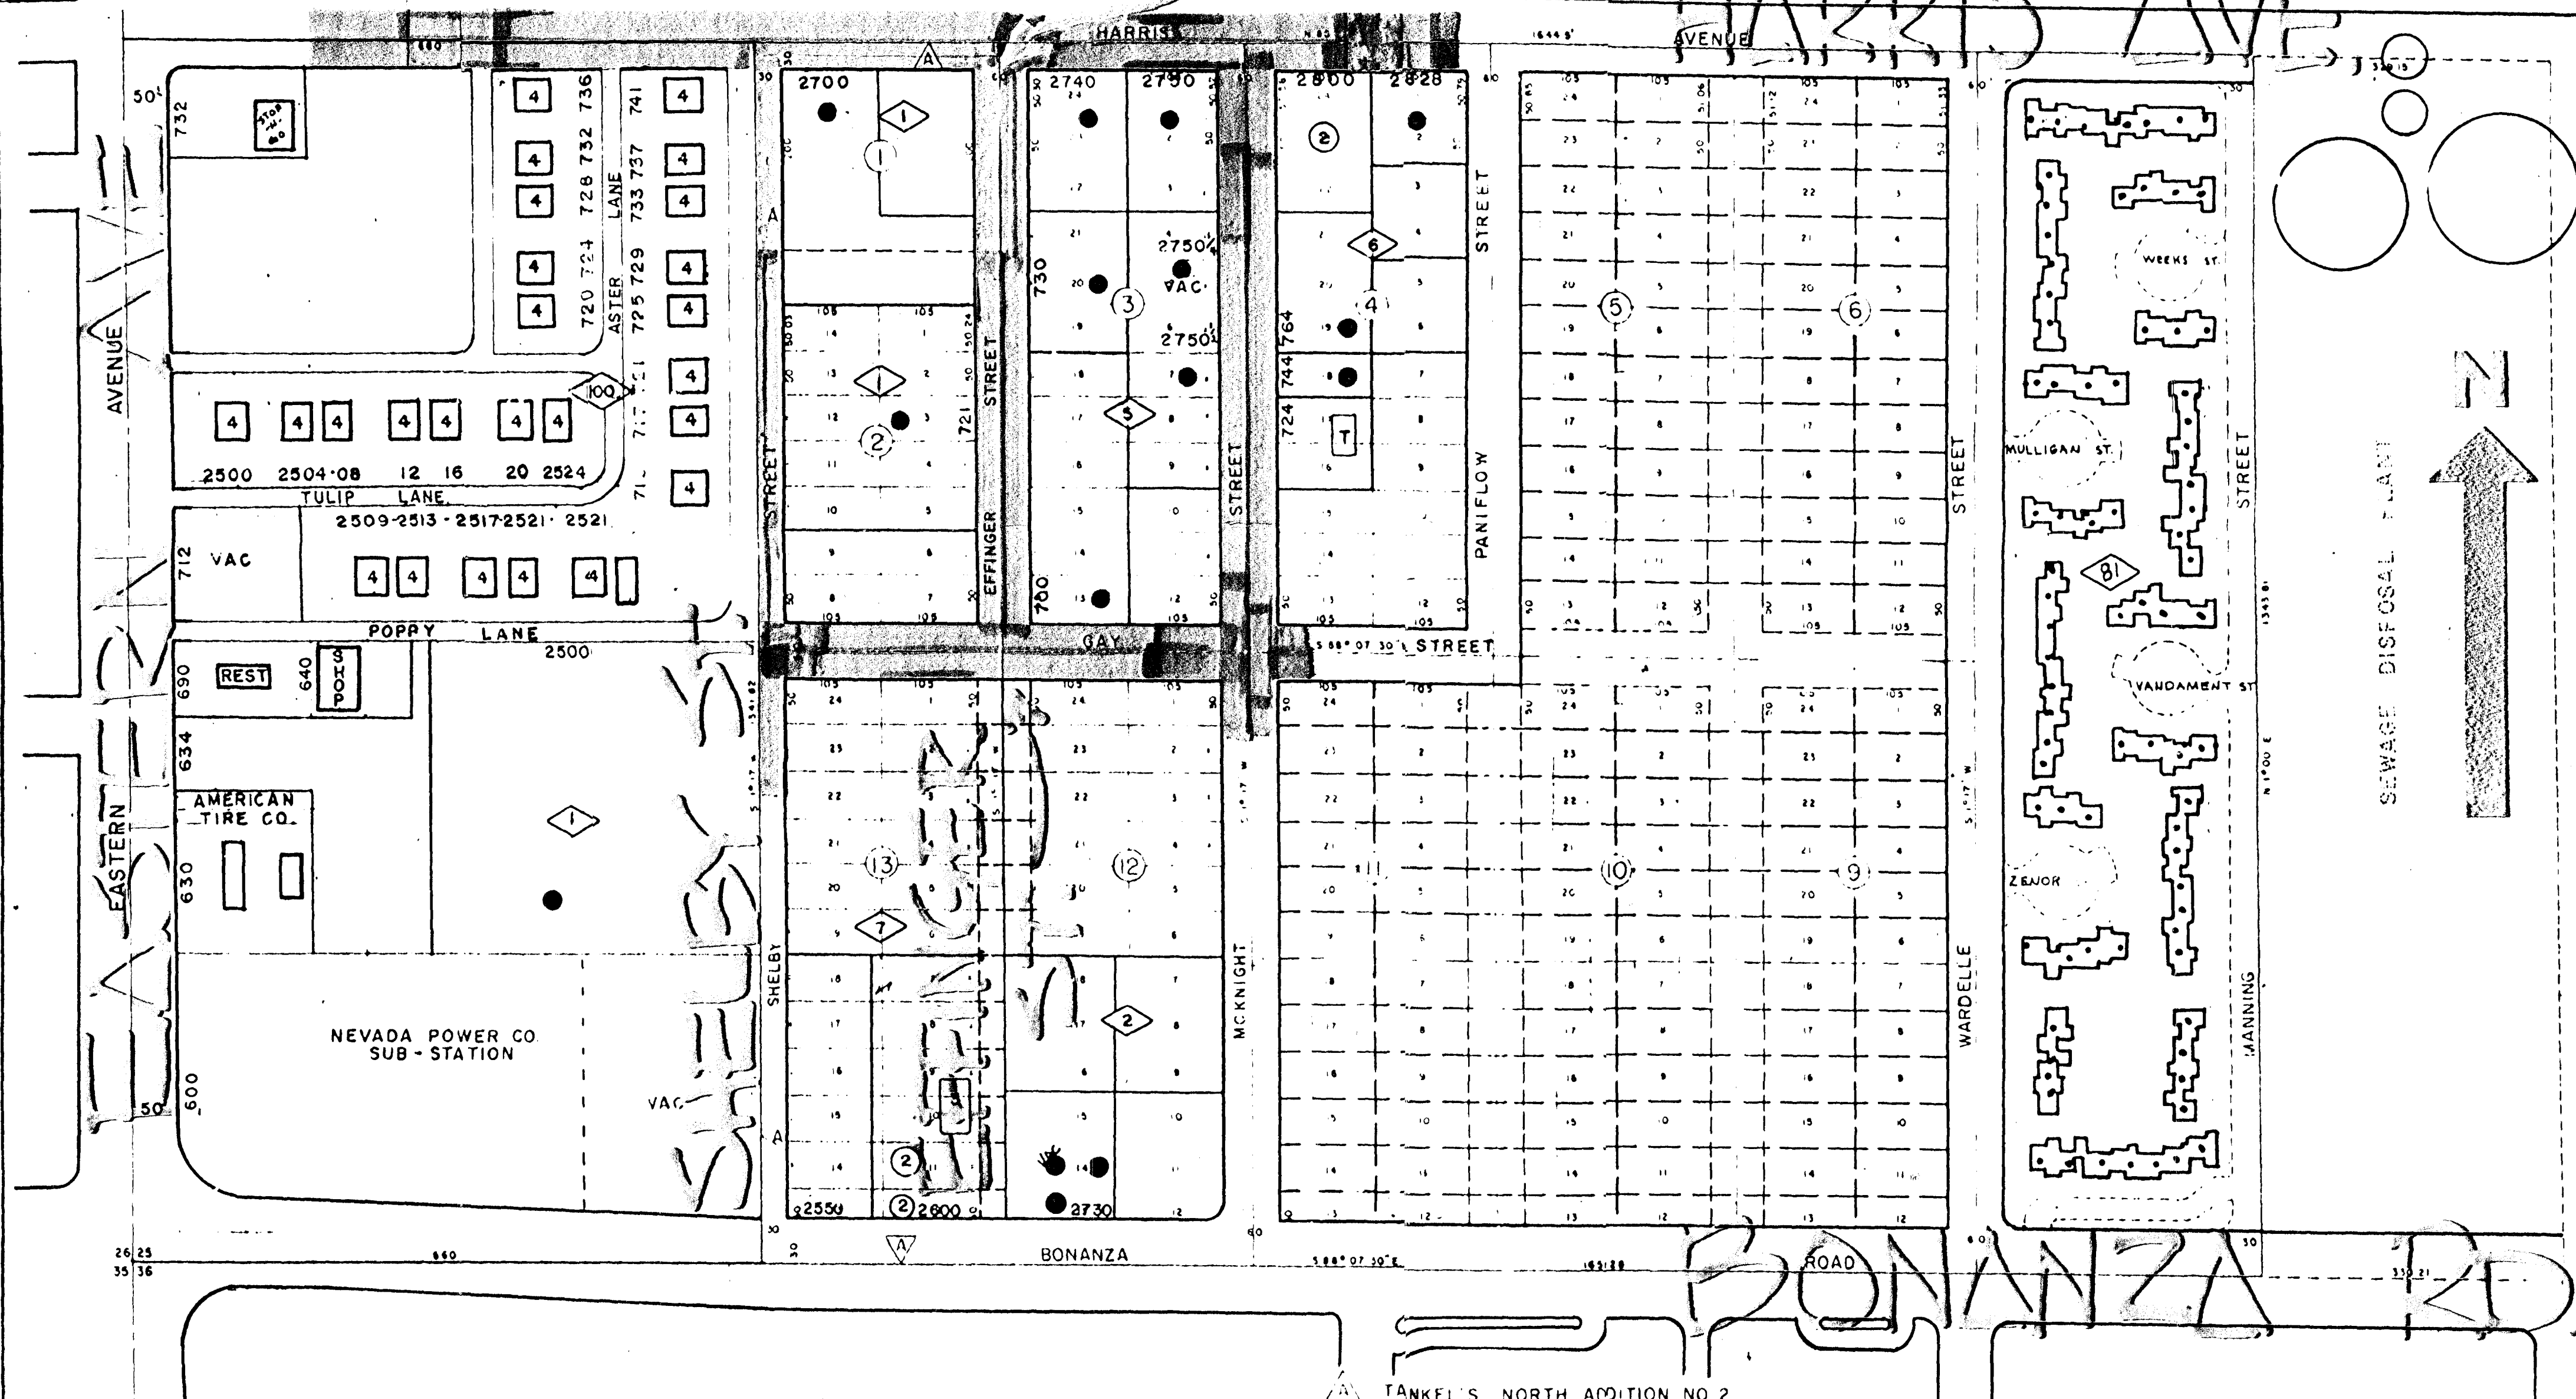

- 13 SINGLE FAMILY
- 190 MULTI-FAMILY
- 1 MOBILE HOME

S. 1/2 SW 1/4, SEC. 25, T. 20 S., R. 6 E.
CITY OF LAS VEGAS NEVADA
PLANNING DEPT.
DISTRICT MAP NO. 20, 61, 25-7

M-25-8