


Center Sec. 22

NE $\frac{1}{4}$ of the SW $\frac{1}{4}$ Sec 22-20-61

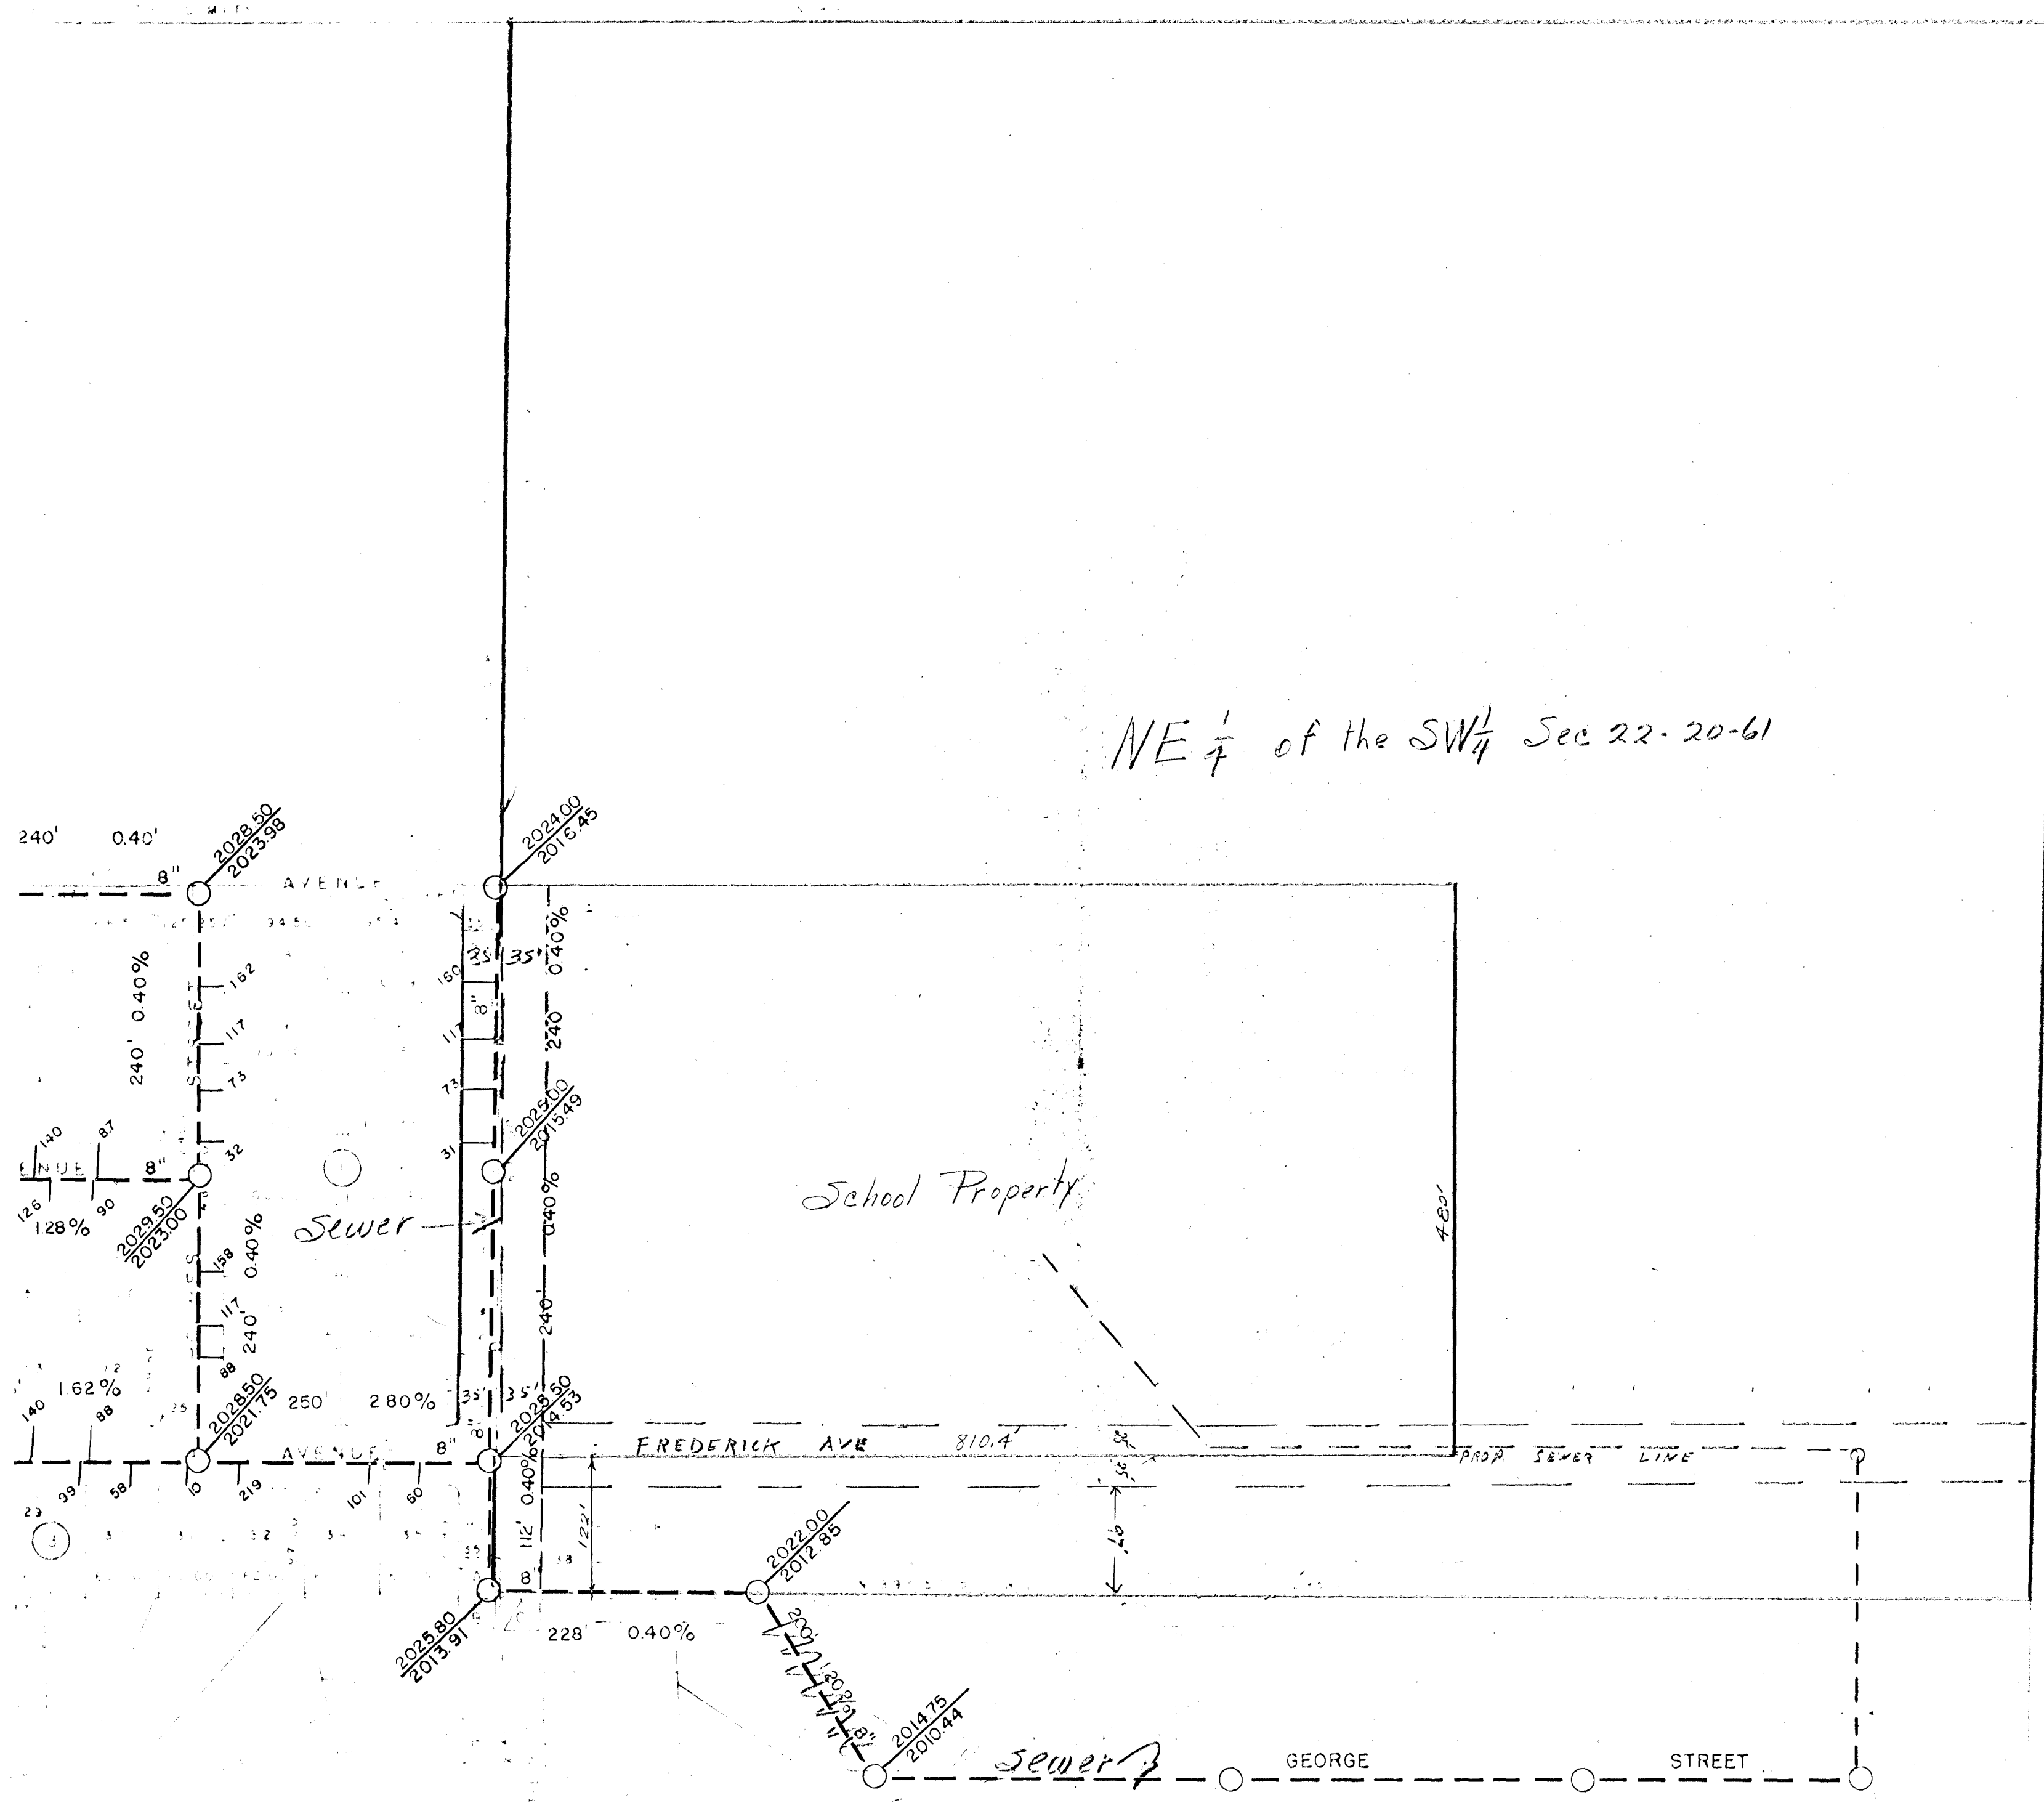

VER LINE
JS — — — — —

SEE SHEET 164
FOR HOUSE CONNECTIONS
ON GEORGE ST.

CITY OF LAS VEGAS NEW	
ENGINEERING DEPT	
SECTION MA- NO 17	
DESIGNED BY	DATE
DRAWN BY	DATE
CHECKED BY	DATE
APPROVED BY	