


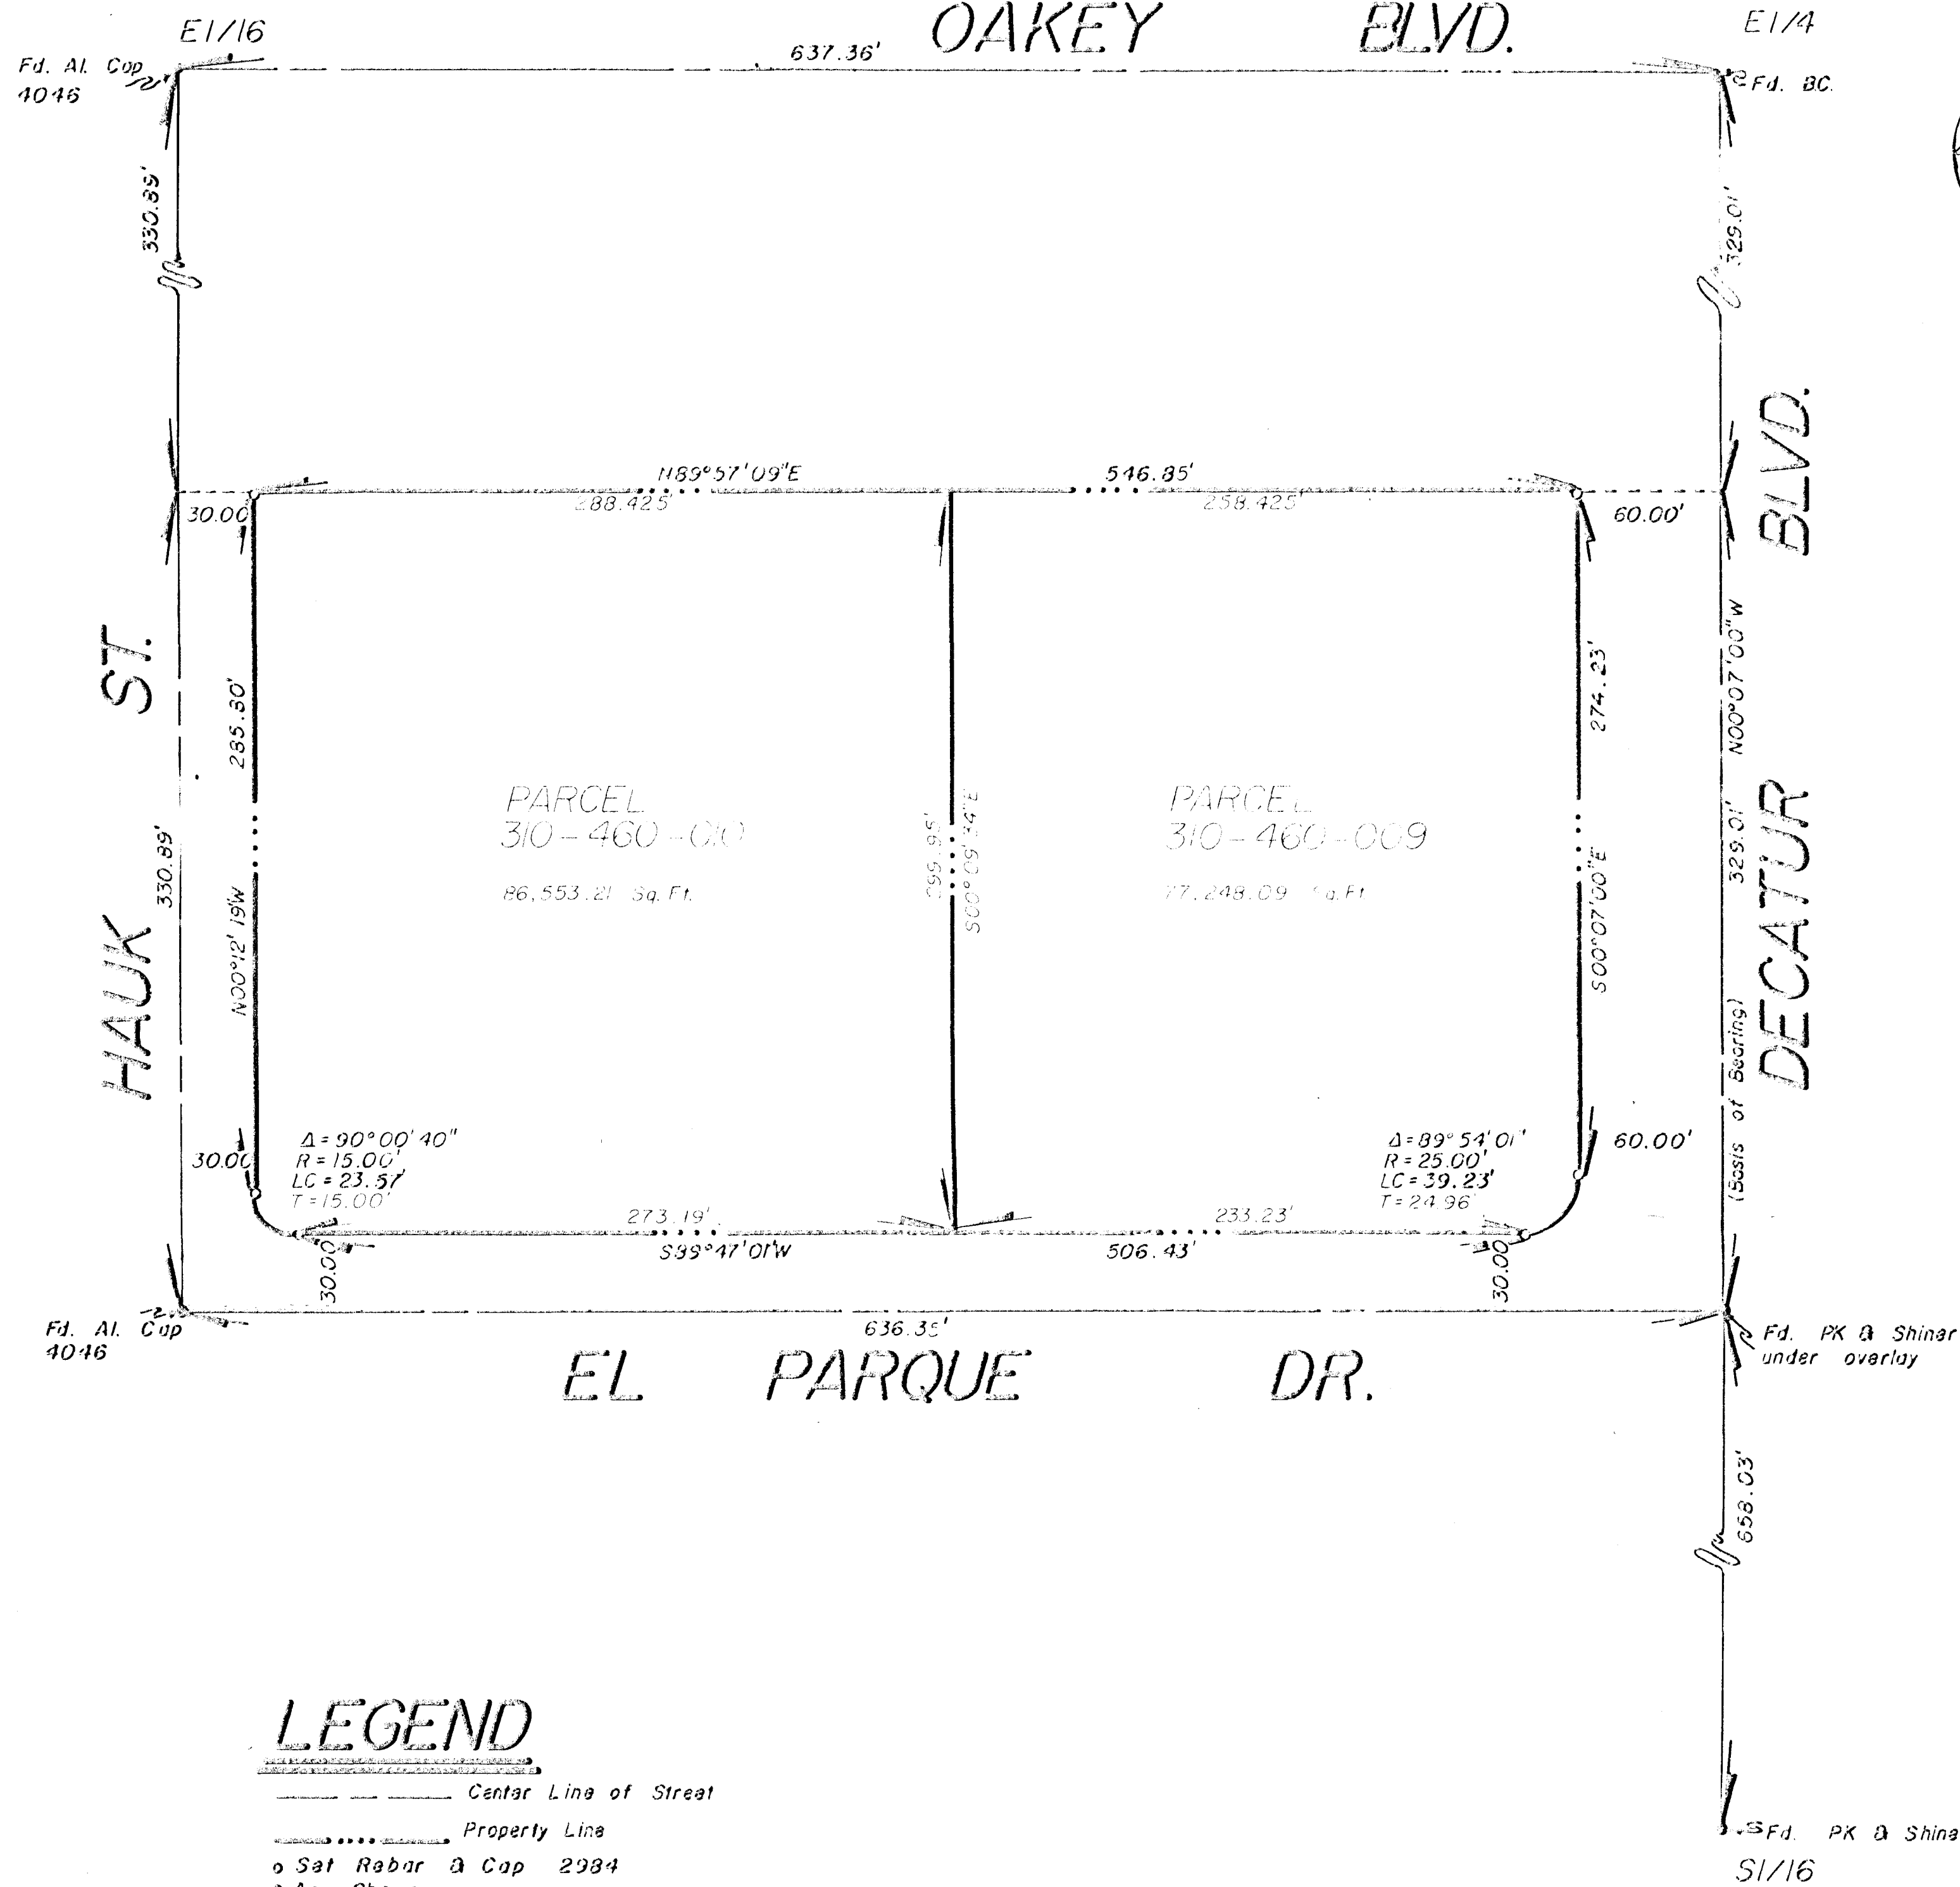

LEGEND


- Center Line of Street
- Property Line
- Set Backer & Cap 2984
- As Shown

BASIS OF BEARING

N00°07'00"W Being the east line of the NE1/4, SE1/4, Sec. 1, T.21S., R.60E. M.D.B. & M. Clark County, Nev.

LEGAL DESCRIPTION

The South Half (S1/2) of the Northeast Quarter (NE1/4) of the Northeast Quarter (NE1/4) of the Southeast Quarter (SE1/4) of Section 1, Township 21 South, Range 60 East, M.D.B. & M. Clark County, Nevada.

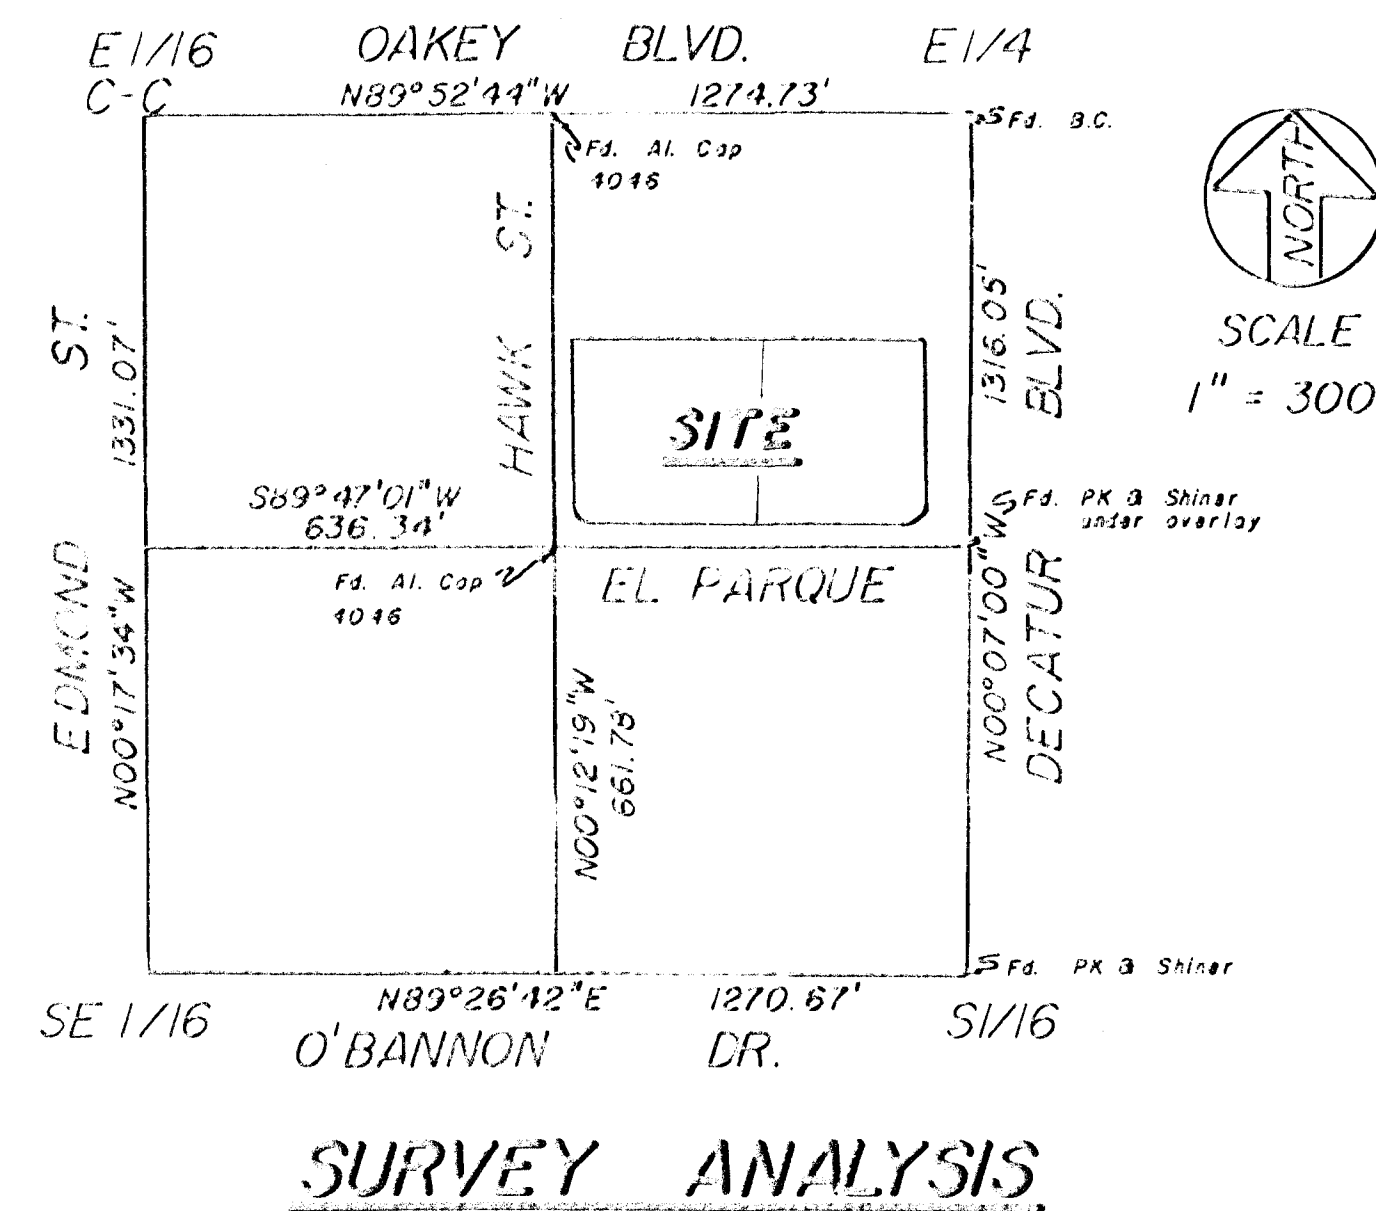

SURVEYOR'S CERTIFICATE

I, Armand A. Ducharme, a duly Registered Land Surveyor in the State of Nevada, do hereby certify that this map is a true and accurate representation of the land surveyed by me at the instance of E. F. MUELLER. This survey was completed on 11/14/83. This map is not a subdivision.

Armand A. Ducharme RLS 2984

RECORD OF SURVEY

ANNEXED UNDER ORDINANCE 3026

NO. 1751813
 FILED AT THE REQUEST OF
 E. F. MUELLER
 Date 8-24-83 at 10:30 A.M.
 FILE NO. PAGE 23
 of Record of Survey
 OFFICIAL RECORDS BOOK NO. 1772
 CLARK COUNTY, NEVADA, RECORDS
 JOAN L. SWIFT, RECORDER
 Fee \$12.00 Deputy \$2.00

