


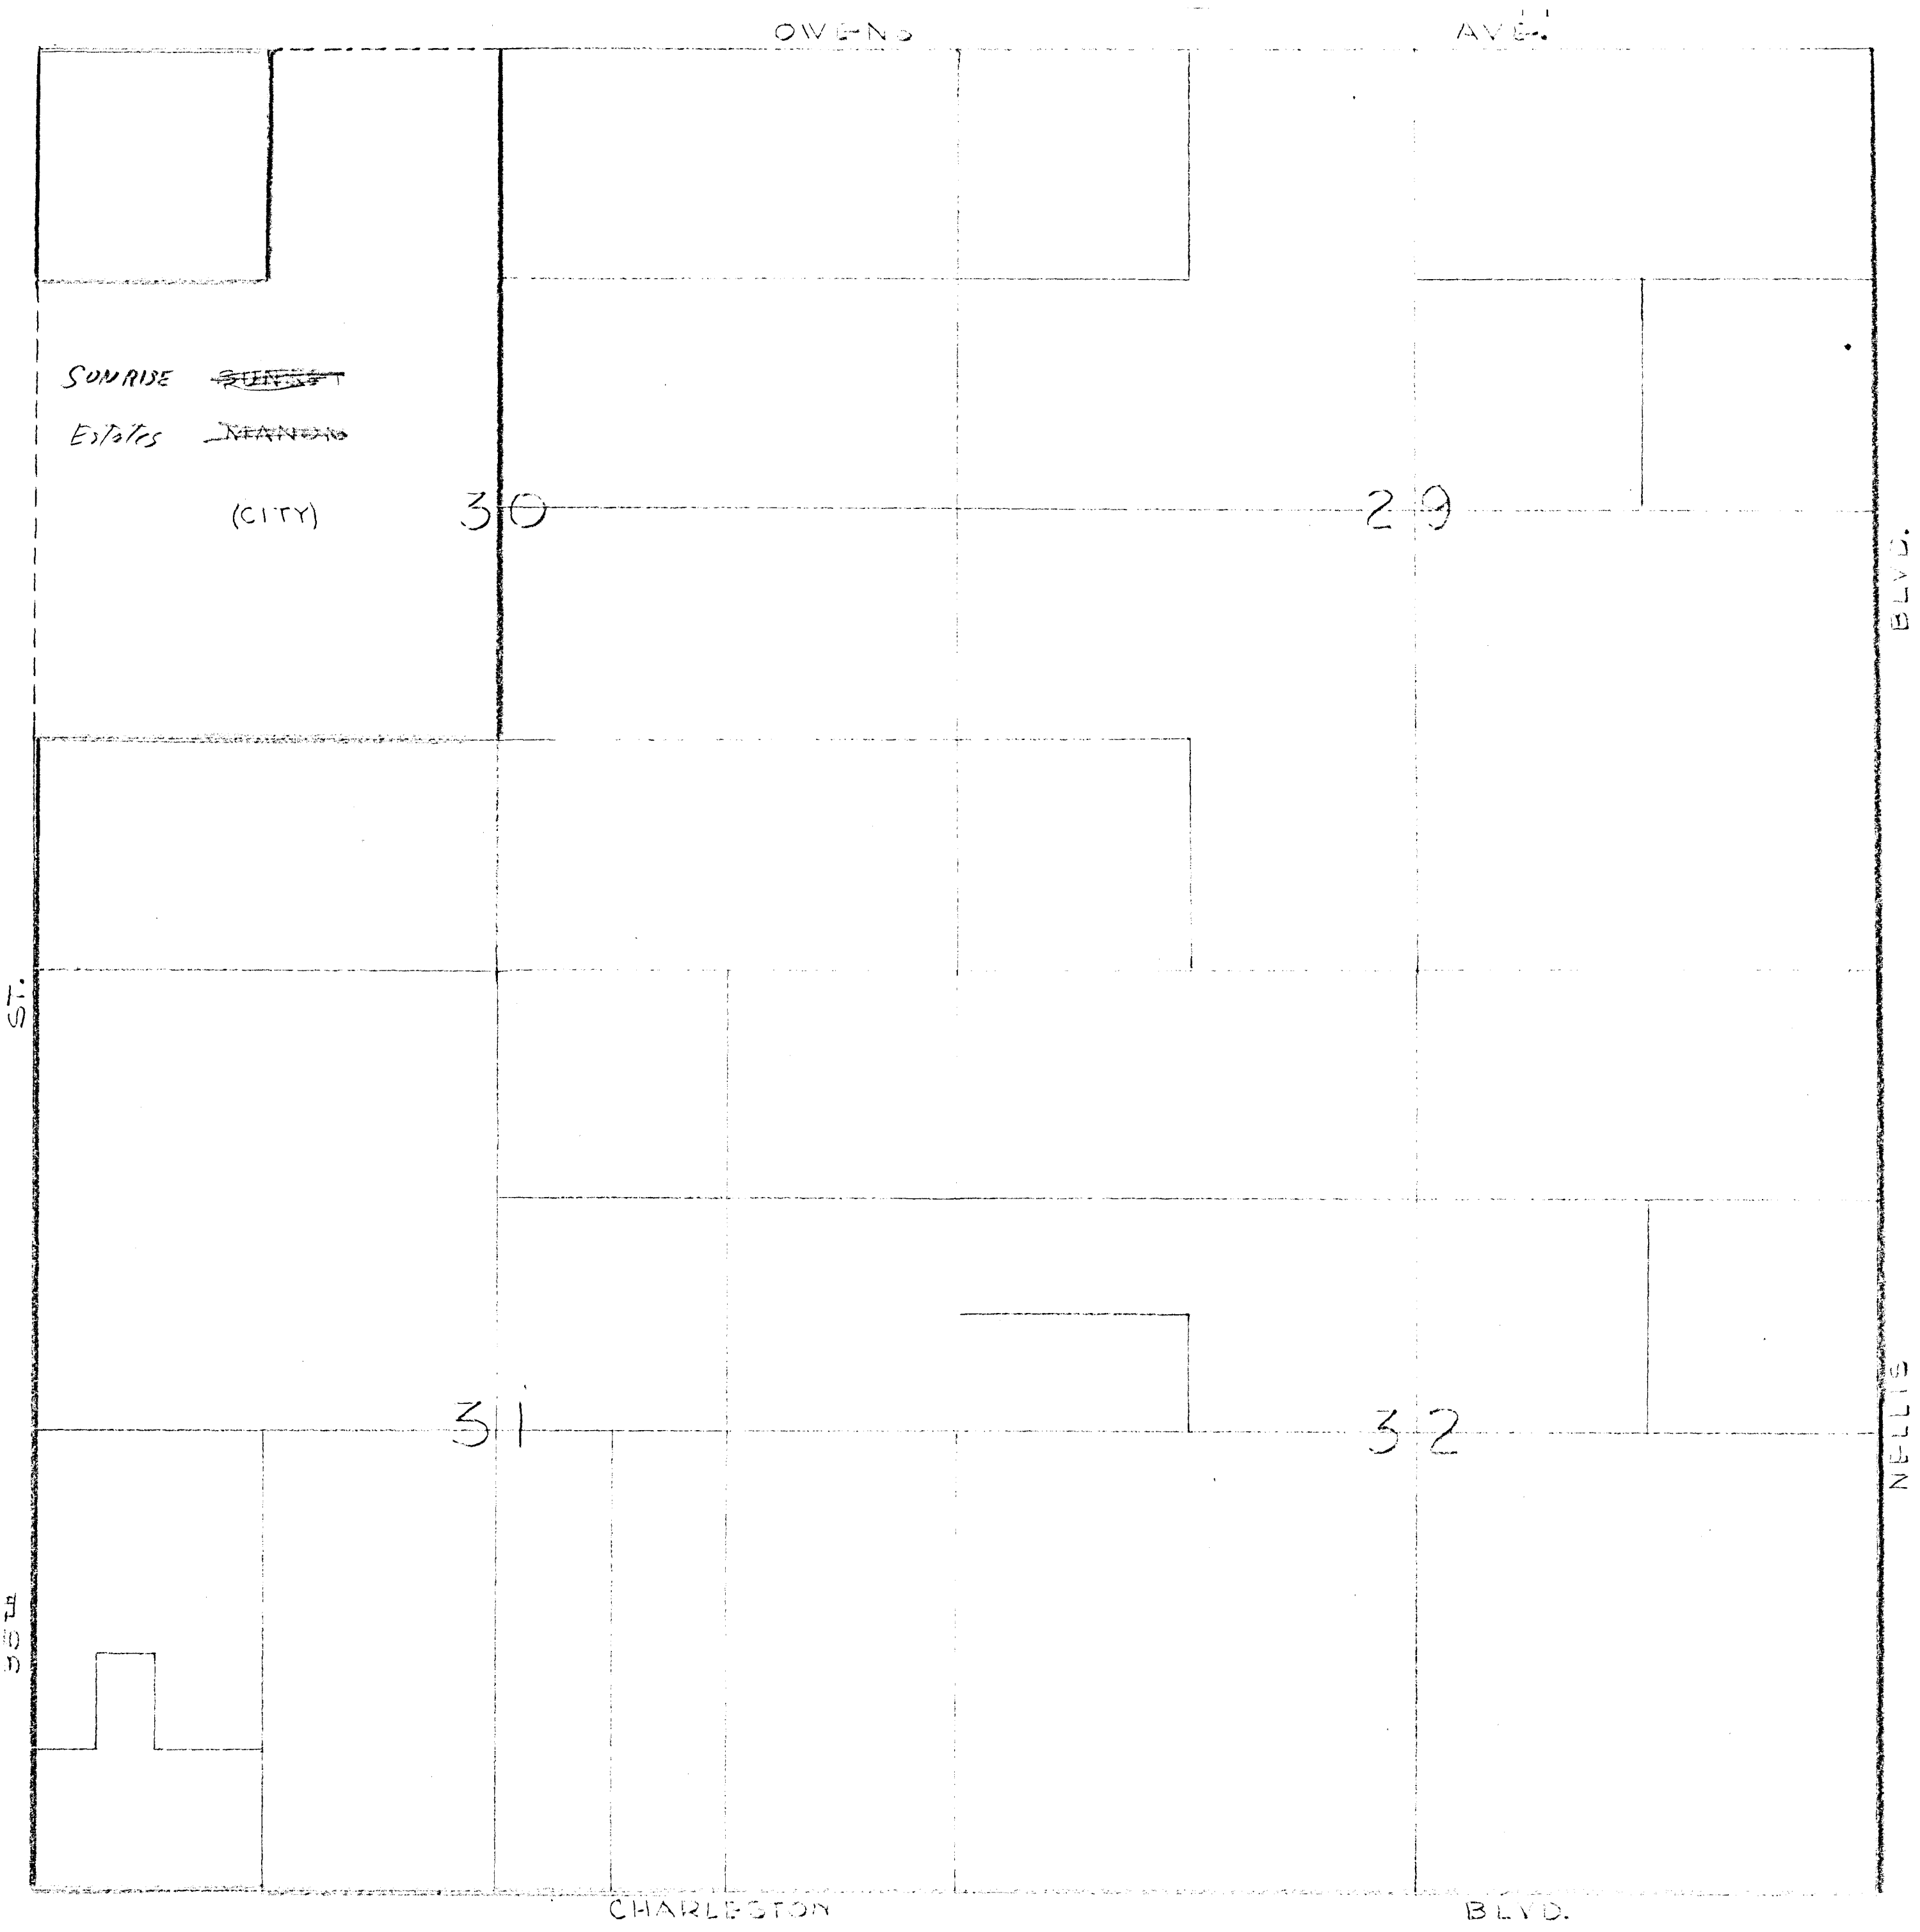
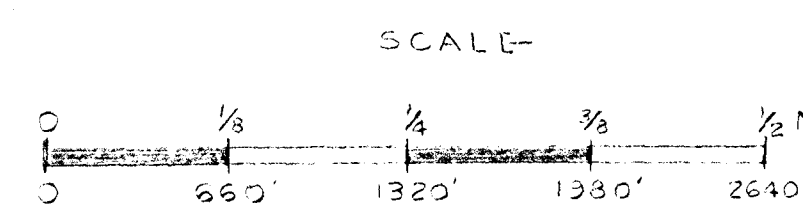


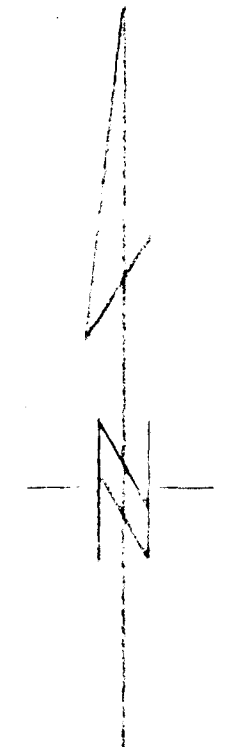

SUNRISE ~~BLVD.~~
Estates ~~NEARBY~~
(CITY)

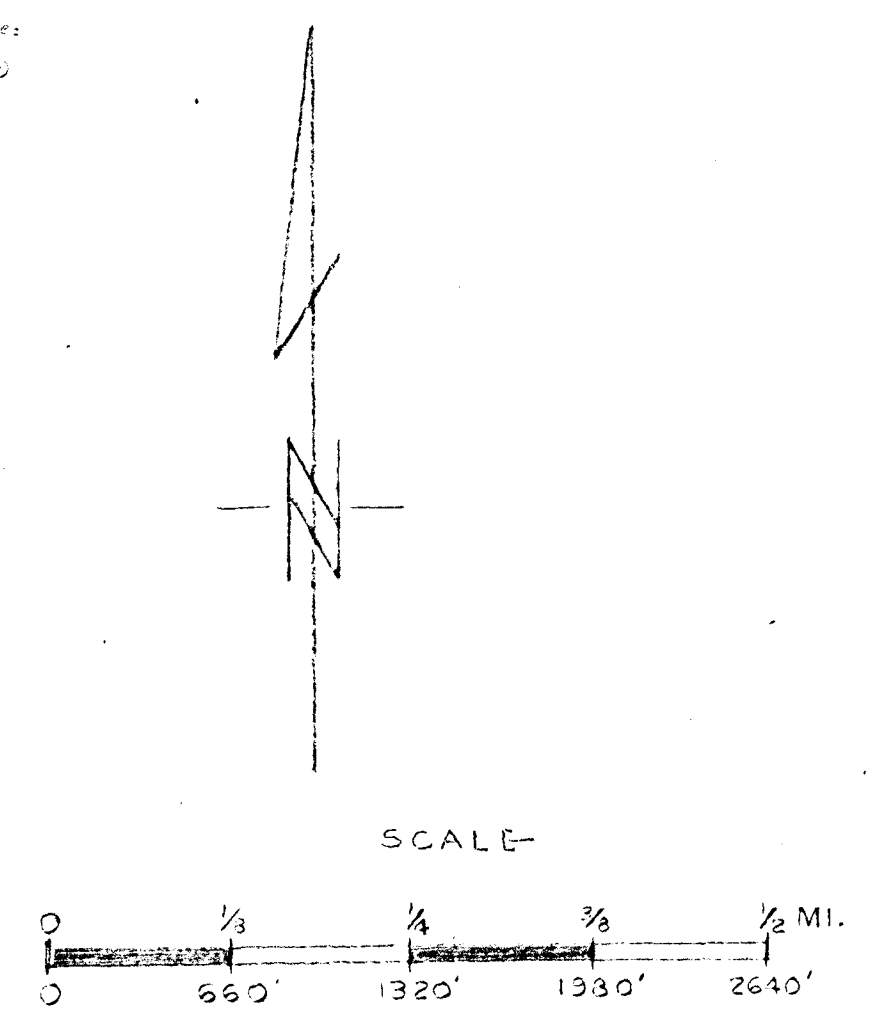

CITY OF LAS VEGAS, NEVADA		
CITY PLANNING COMMISSION		
FRANKLIN J. BILLS, DIRECTOR OF PLANNING		
PROPOSED ANNEXATION		
LOCATED IN SECTIONS		
29-30-31-32, T.20S, R.62E		
DRAWN 12-18-56	BY NUS SMITH	FILE NO.
CHECKED	BY	610.0

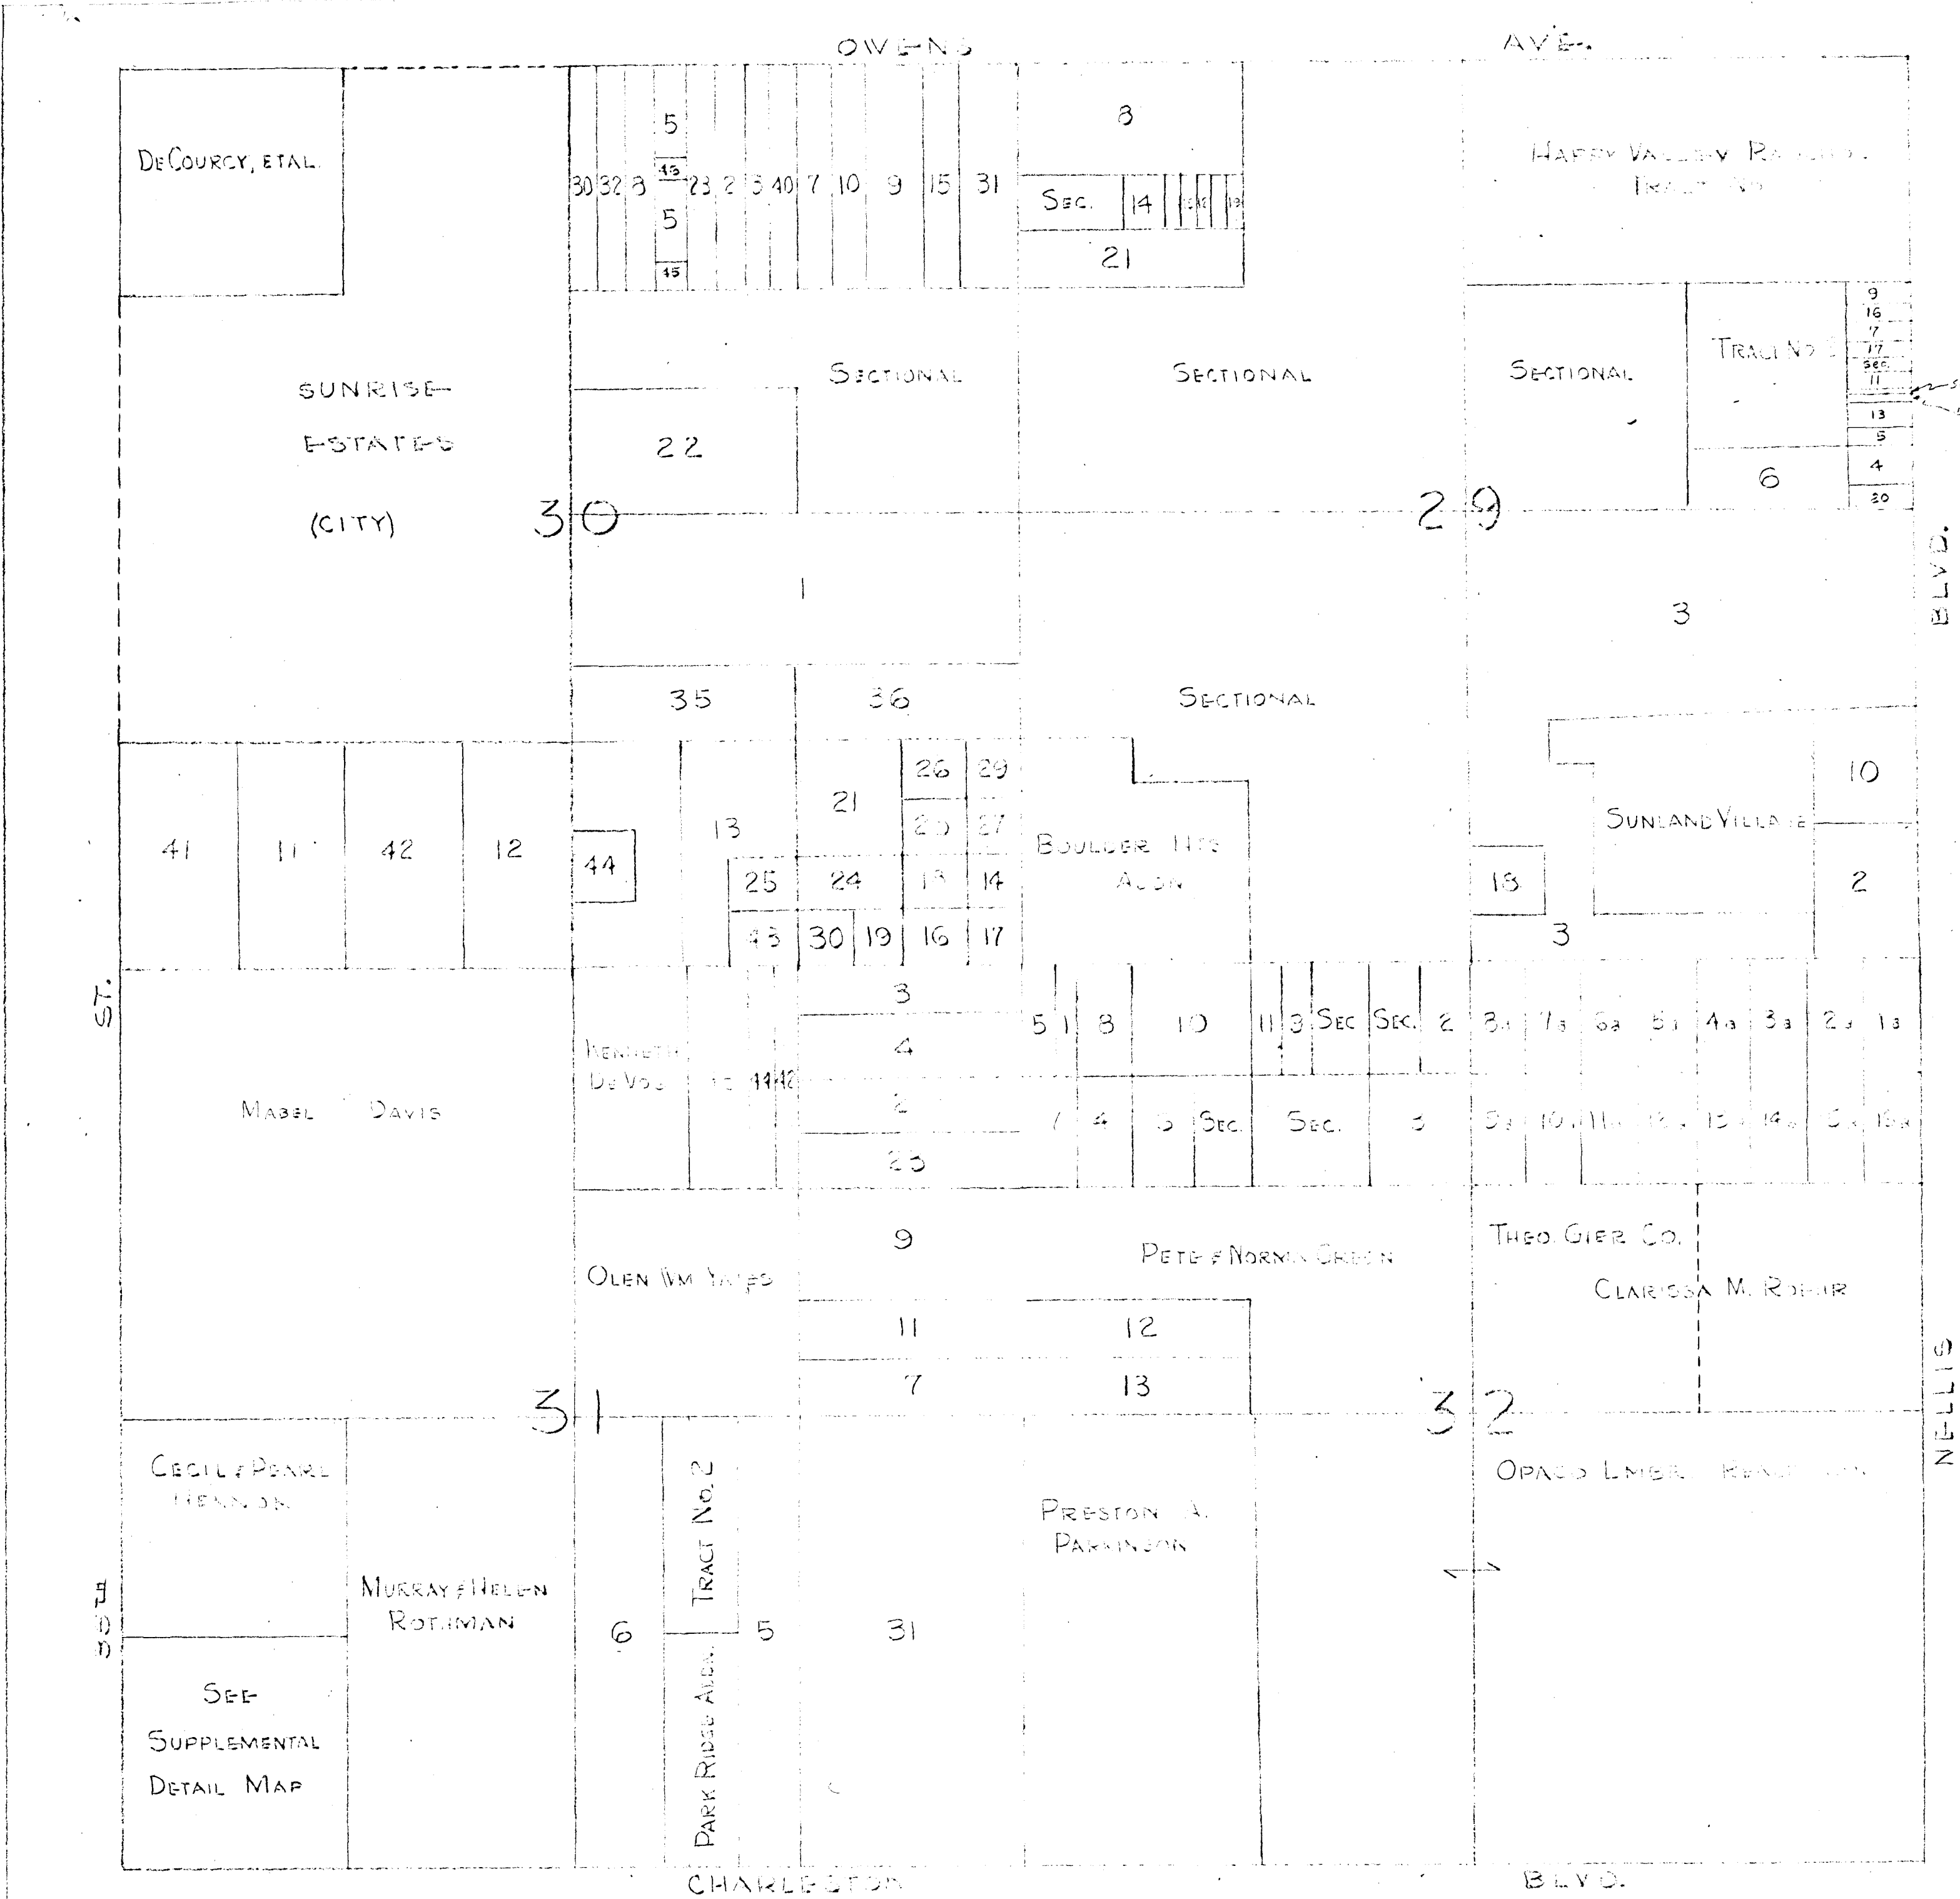

CITY OF LAS VEGAS, NEVADA		
CITY PLANNING COMMISSION		
FRANKLIN J. BILES, DIRECTOR OF PLANNING		
PROPOSED ANNEXATION		
LOCATED IN SECTIONS		
20-30-31-32, T.20S, R.62E.		
DRAWN 12-18-36	BY N. J. SMITH	FILE NO.
CHECKED	BY	
REVISED 12-18-36	BY M. E. SMITH	610.02