



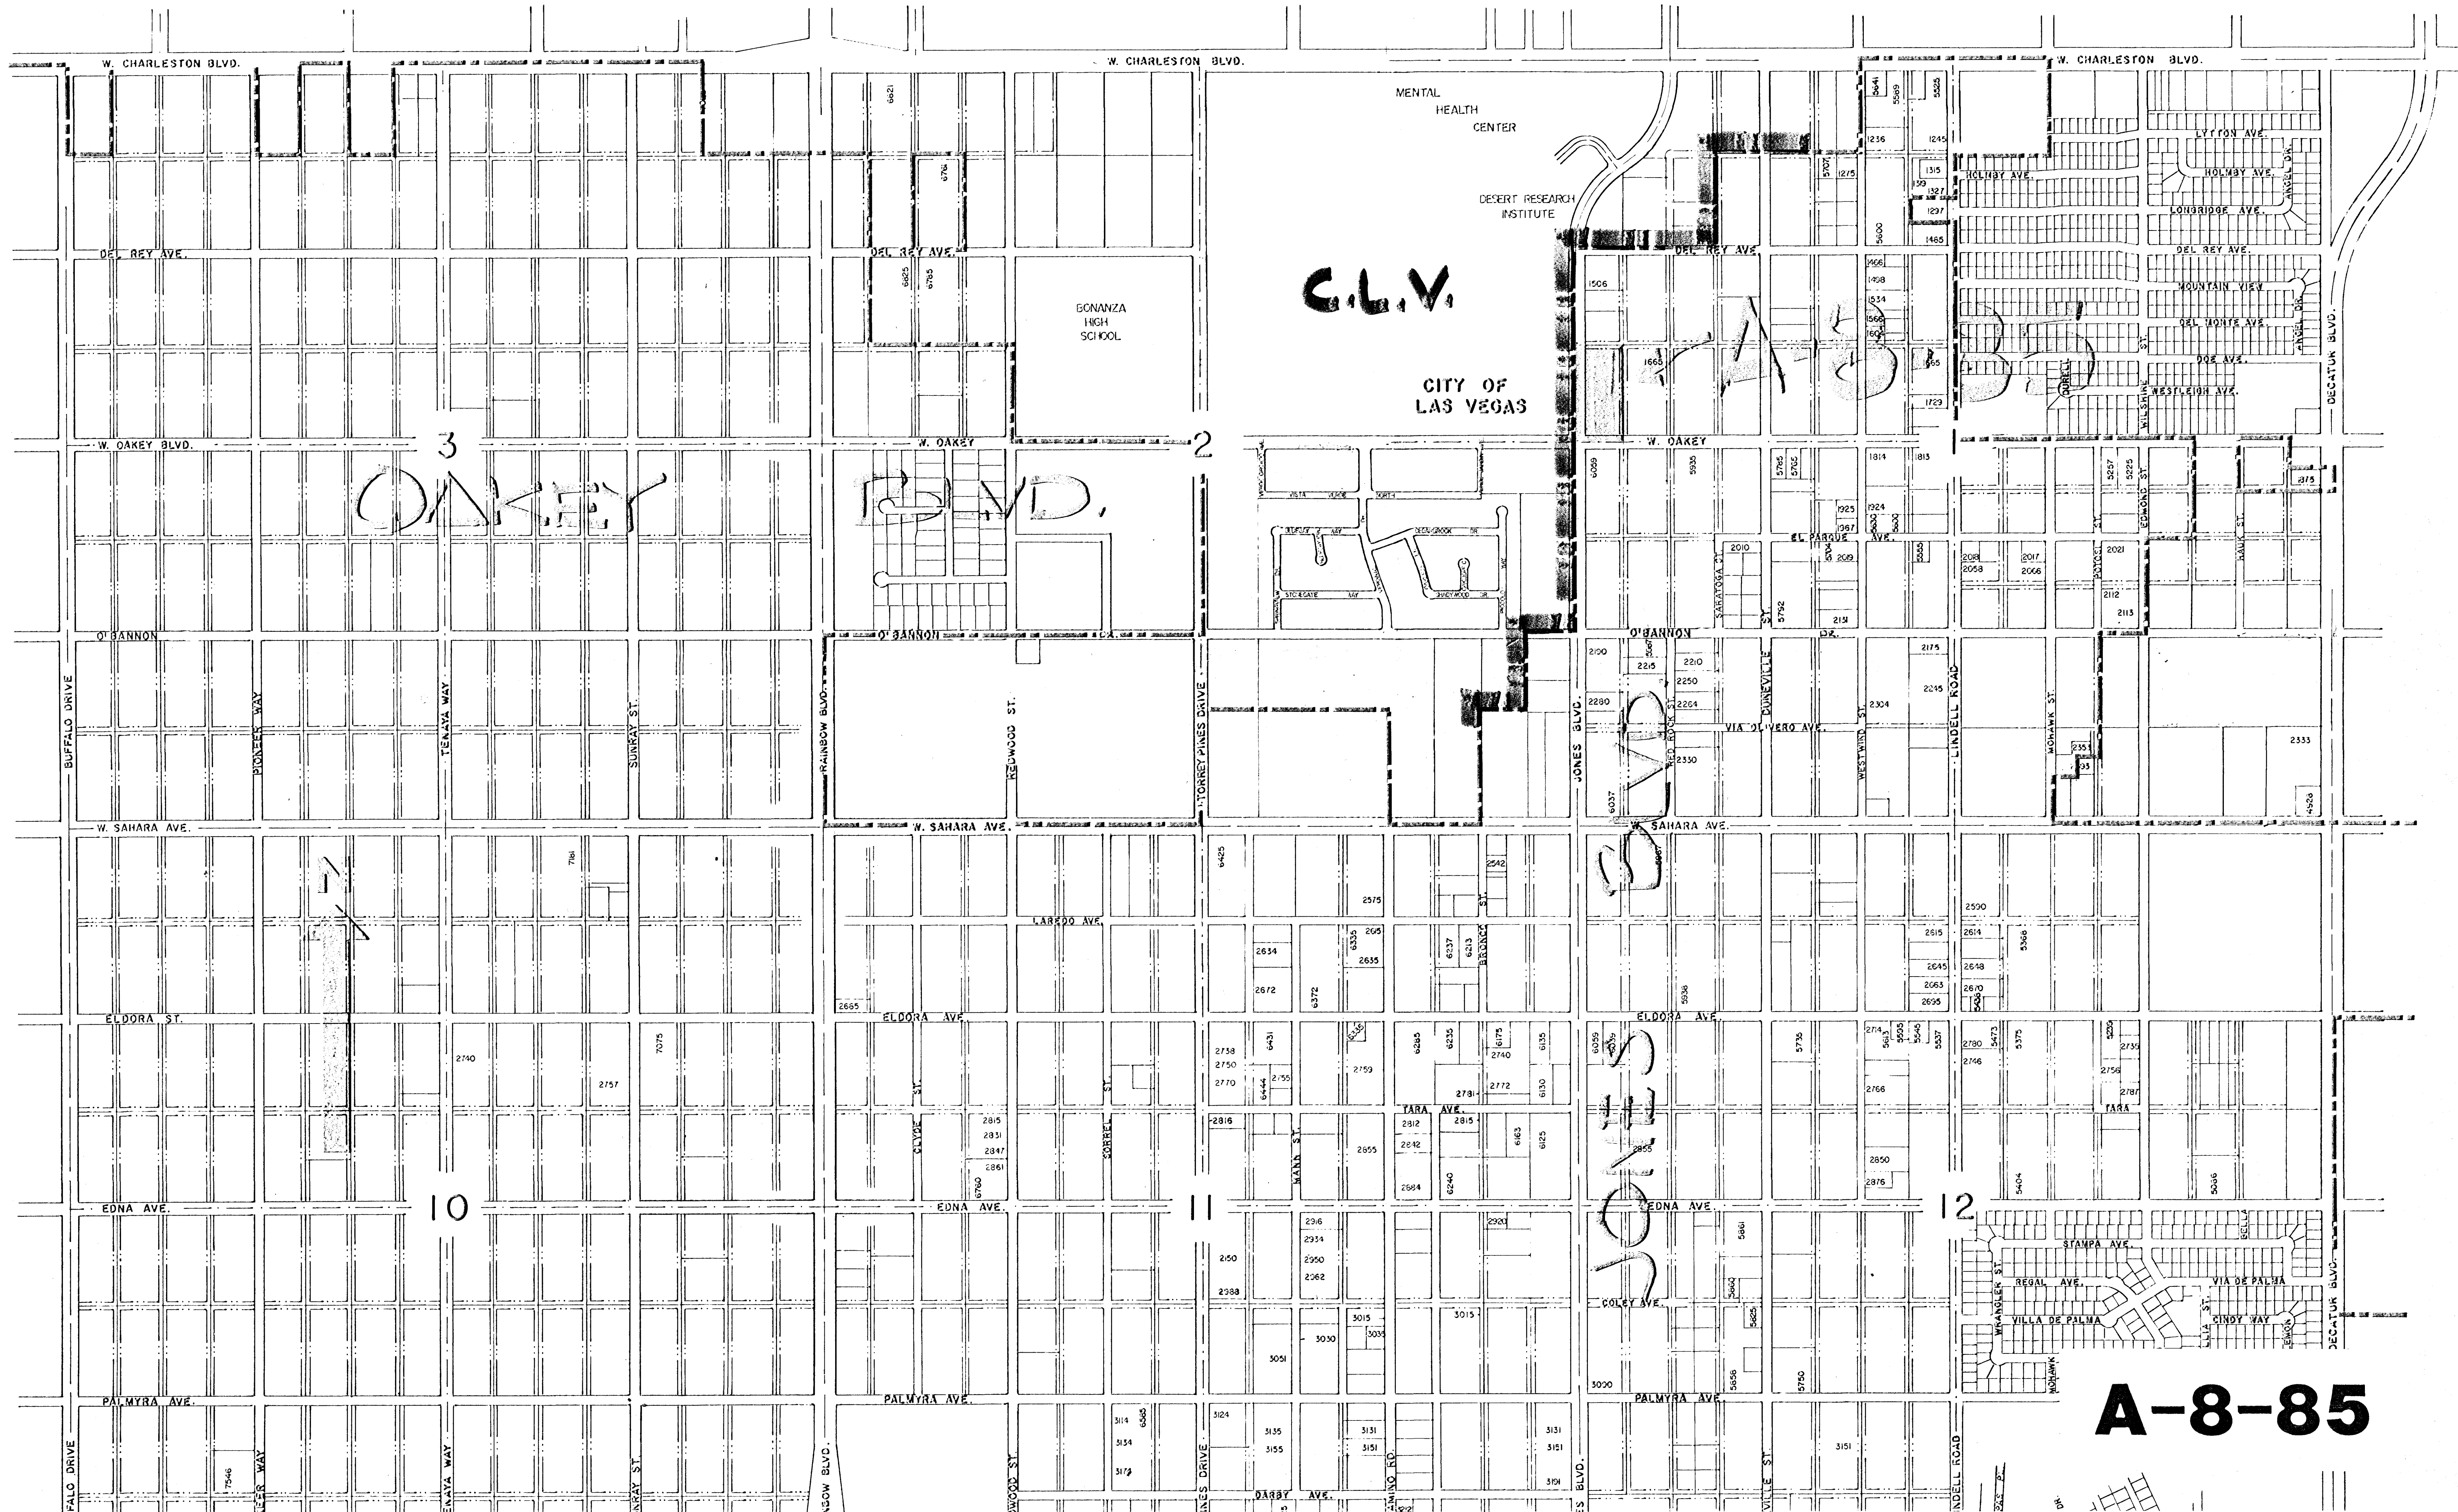


A-8-85


2190431

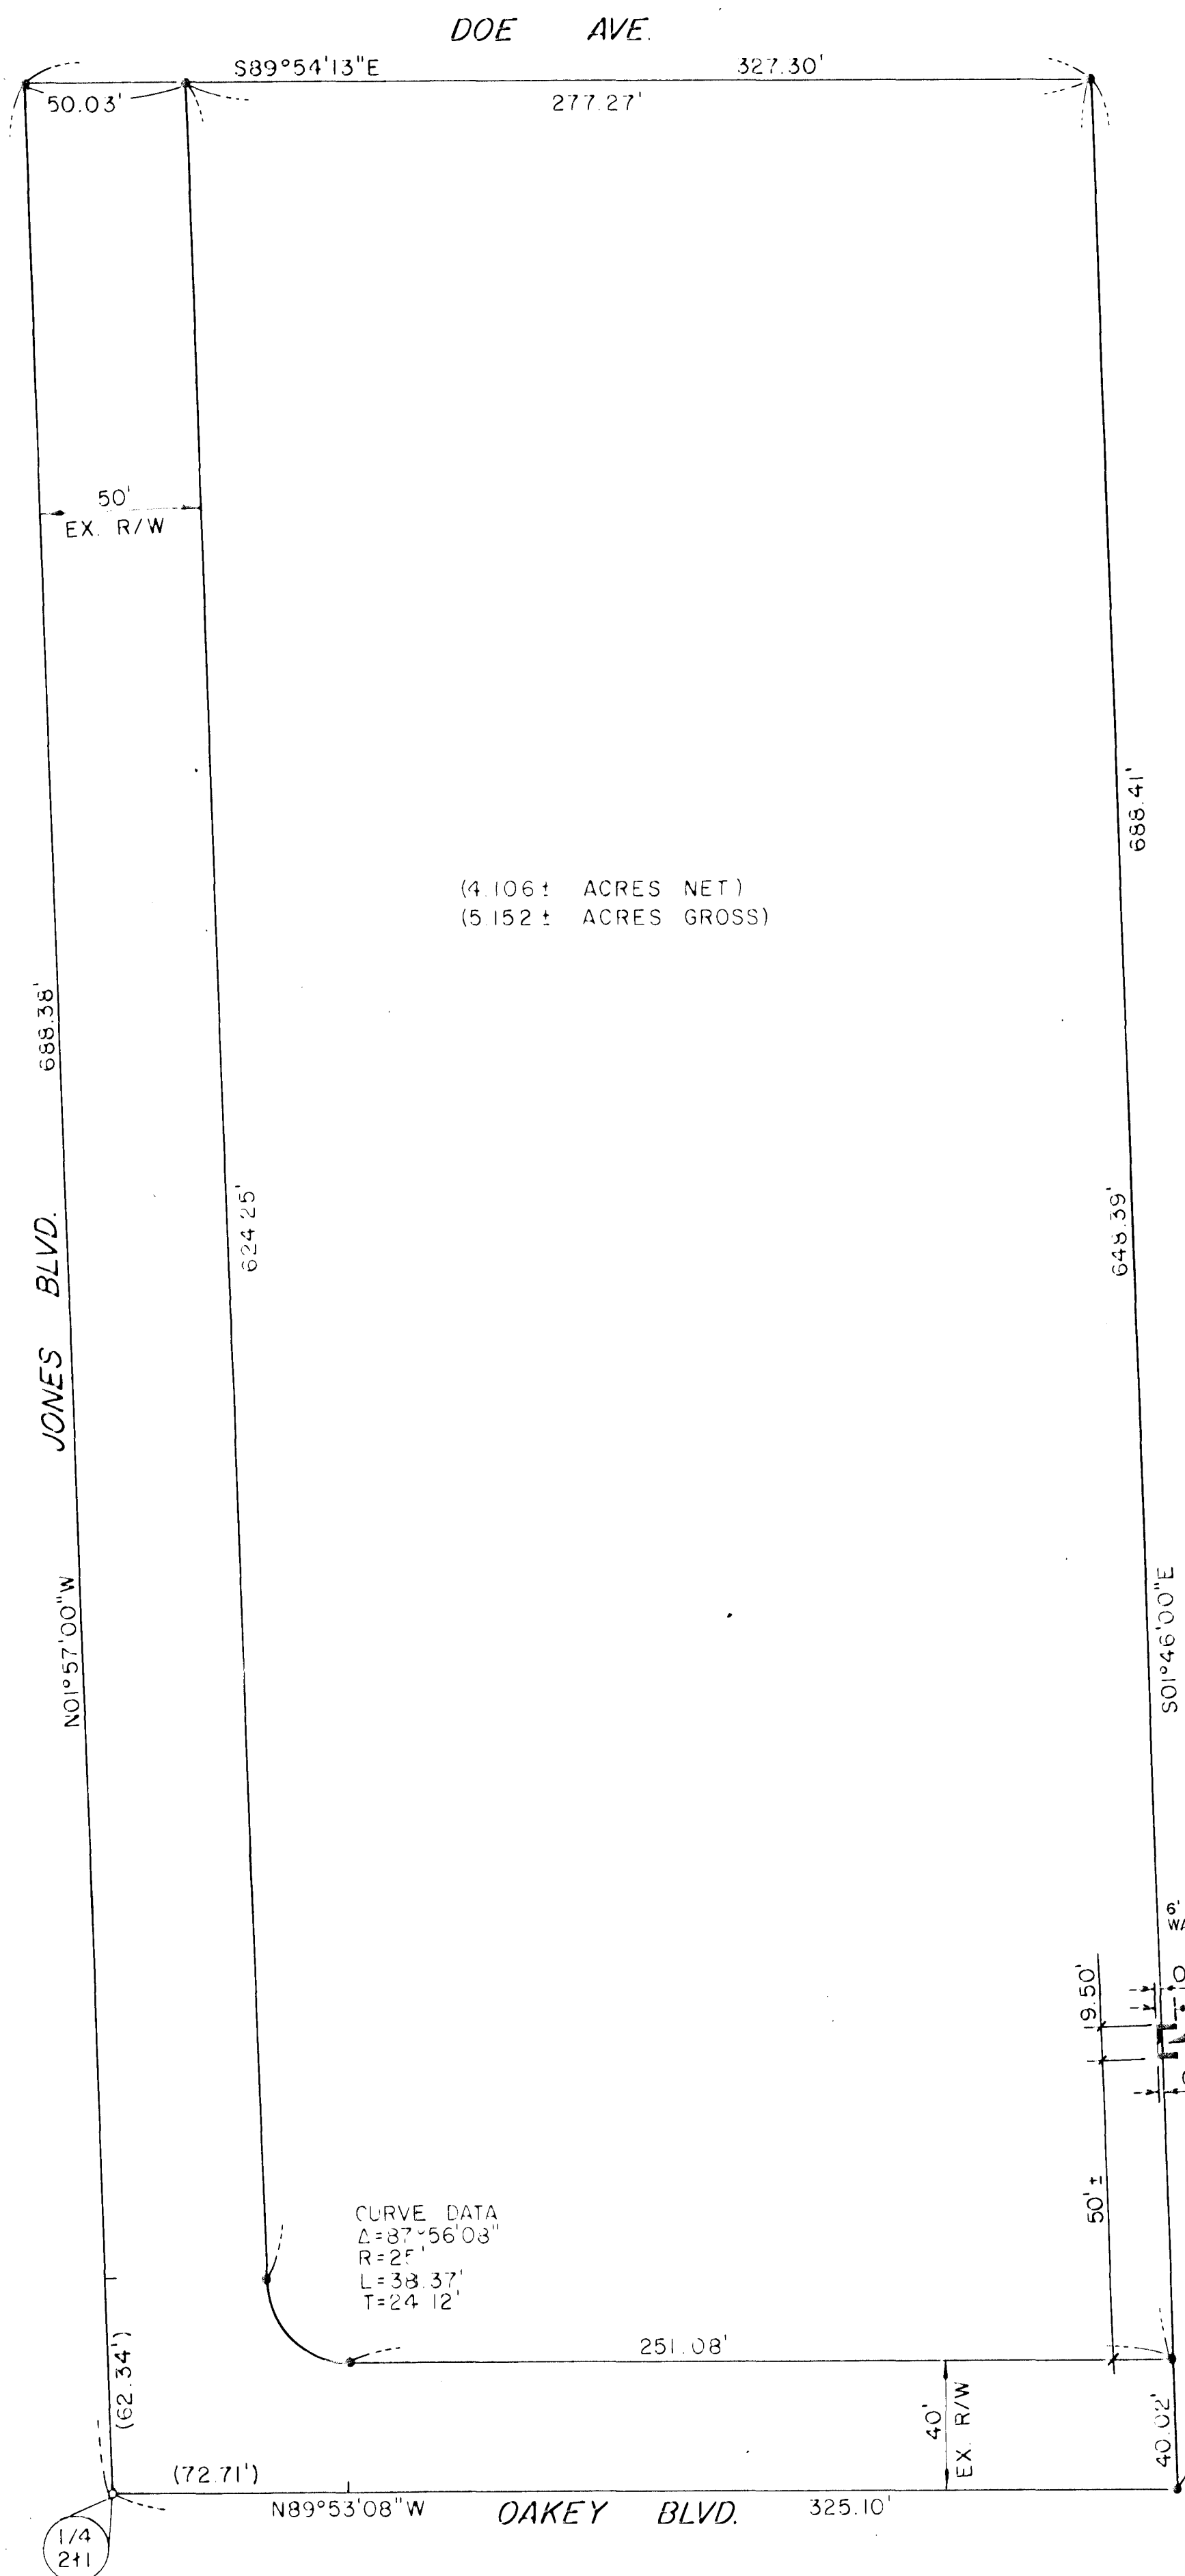

(4.106: ACRES NET)
(5.152: ACRES GROSS)

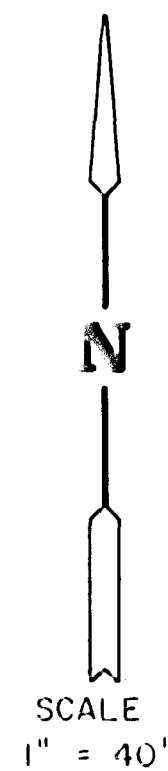

SURVEY ANALYSIS

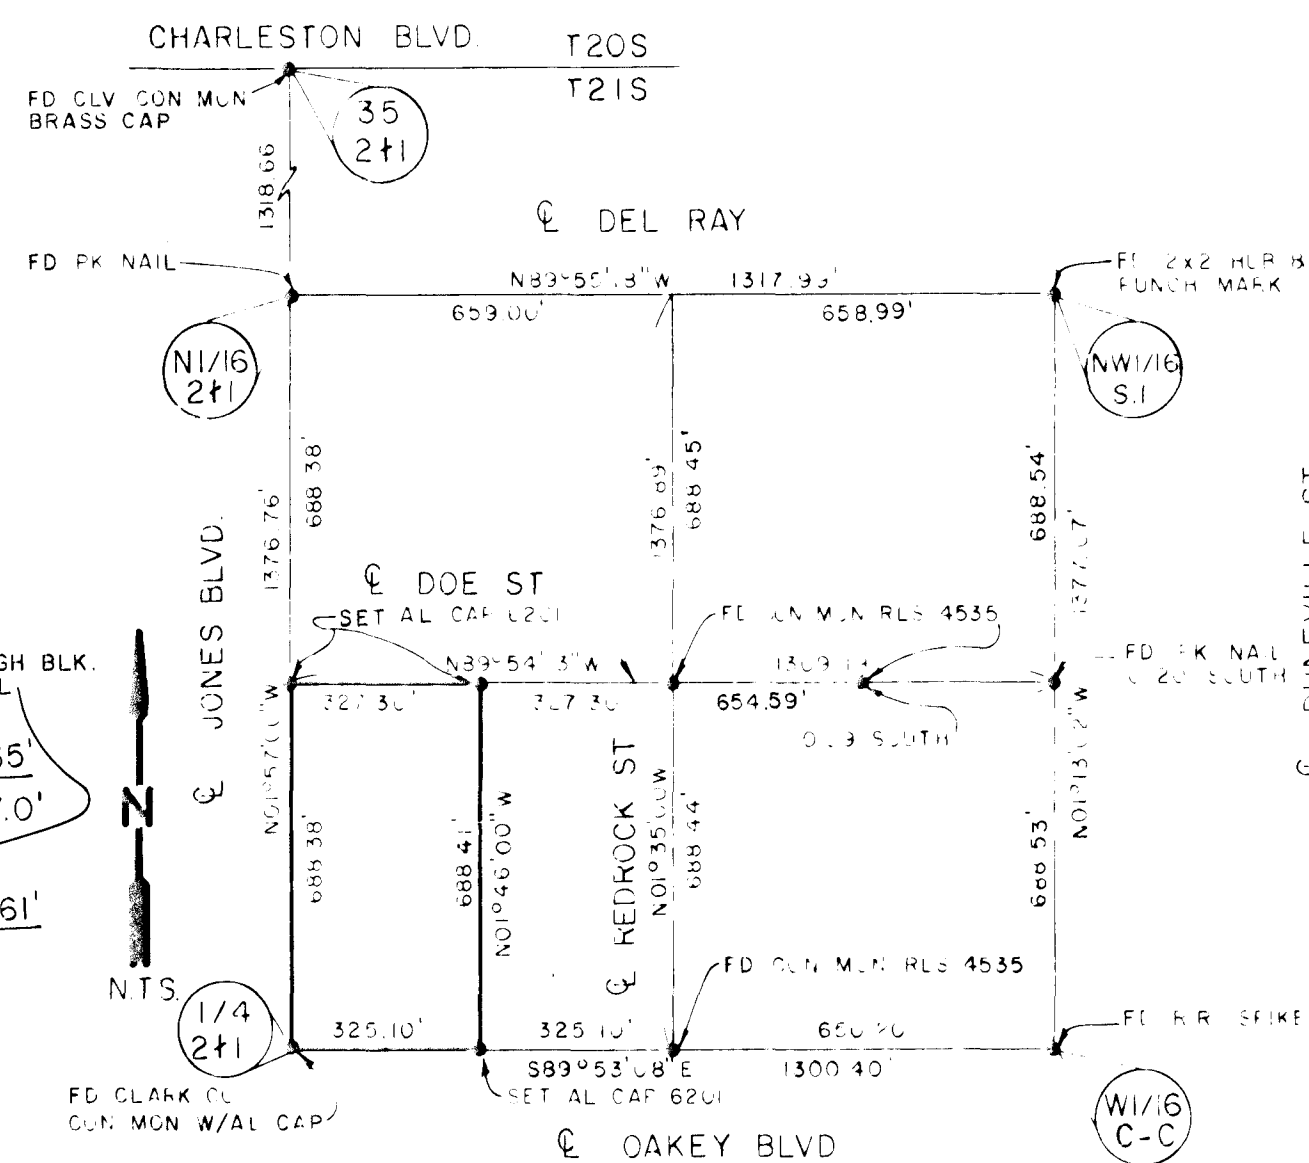

SURVEYOR'S CERTIFICATE

I, the undersigned, being a duly qualified and licensed Surveyor of the State of Nevada, do hereby certify that the survey of the land shown hereon was made under my direct supervision at the instance of DESERT LAWN, INC. and that the survey was completed on 7/29/85 and that the points found and set are correct as shown hereon. This map does not constitute a subdivision as defined by Nevada State Law.

Gene D. Hammett 8/1/85
REGISTERED LAND SURVEYOR
NEV. CERT. NO. 1031

Gene D. Hammett

LEGAL DESCRIPTION

Being the West Half (W1/2) of the Southwest Quarter (SW1/4) of the Southwest Quarter (SW1/4) of the Northwest Quarter (NW1/4) of Section 1, T. 21 S., R. 60 E., M.D.M., Clark County, Nevada, and being further described as follows:

BEGINNING at the Southwest Corner (SW Cor.) of said West Half (W1/2) of the Southwest Quarter (SW1/4) of the Southwest Quarter (SW1/4) of the Northwest Quarter (NW1/4) of Section 1, T. 21 S., R. 60 E., M.D.M., Clark County, Nevada, along the West line thereof, 688.38 feet; thence S. 89°54'13\"E., along the North line thereof, 327.30 feet; thence S. 01°46'00\"E., along the East line thereof, 688.41 feet; thence N. 89°53'08\"W., along the South line thereof, 325.10 feet to the POINT OF BEGINNING.

Containing 5.152 acres, more or less.

Also being Government Lot No. 29 in the West Half (W1/2) of the Southwest Quarter (SW1/4) of the Southwest Quarter (SW1/4) of the Northwest Quarter (NW1/4) of Section 1, T. 21 S., R. 60 E., M.D.M., Clark County, Nevada.

LEGEND

- FOUND CLARK COUNTY CONC. M.N. W/AL CAP
- SET 5/8\" REPAIR W/AL CAP RLS NO. 6201

BASIS OF BEARING

N. 01°57'00\"W., being the West line of Section 1, T. 21 S., R. 60 E., M.D.M., Clark County, Nevada, as shown by a map on file in the County Recorder's Office in File 6 of Records of Survey, Page 63.

ANNEXED TO THE CITY OF LAS VEGAS BY ORDINANCE NO. 3205

VTN CONSULTING ENGINEERS & PLANNERS		2190431	
RECORD OF SURVEY		VTN Nevada	
A portion of the Southwest Quarter (SW1/4) of the Northwest Quarter (NW1/4) of Section 1, T. 21 S., R. 60 E., M.D.M., Clark County, Nevada.		DATE 12-11-85 BY 2190431	
SCALE 1\" = 40'		PAGE 64	
DATE 1031		DATE R-5-85	
DRN RLG		1 1	
CLARK COUNTY, NEVADA RECORDS		CLARK COUNTY, NEVADA RECORDS	
CLARK COUNTY, NEVADA RECORDS		CLARK COUNTY, NEVADA RECORDS	

FILE 43 PAGE 64