


RAINBOW MEADOWS

A PORTION OF THE NE1/4 OF SECTION 27, T.20 S., R.60 E., M.D.M.,
CITY OF LAS VEGAS, CLARK COUNTY, NEVADA

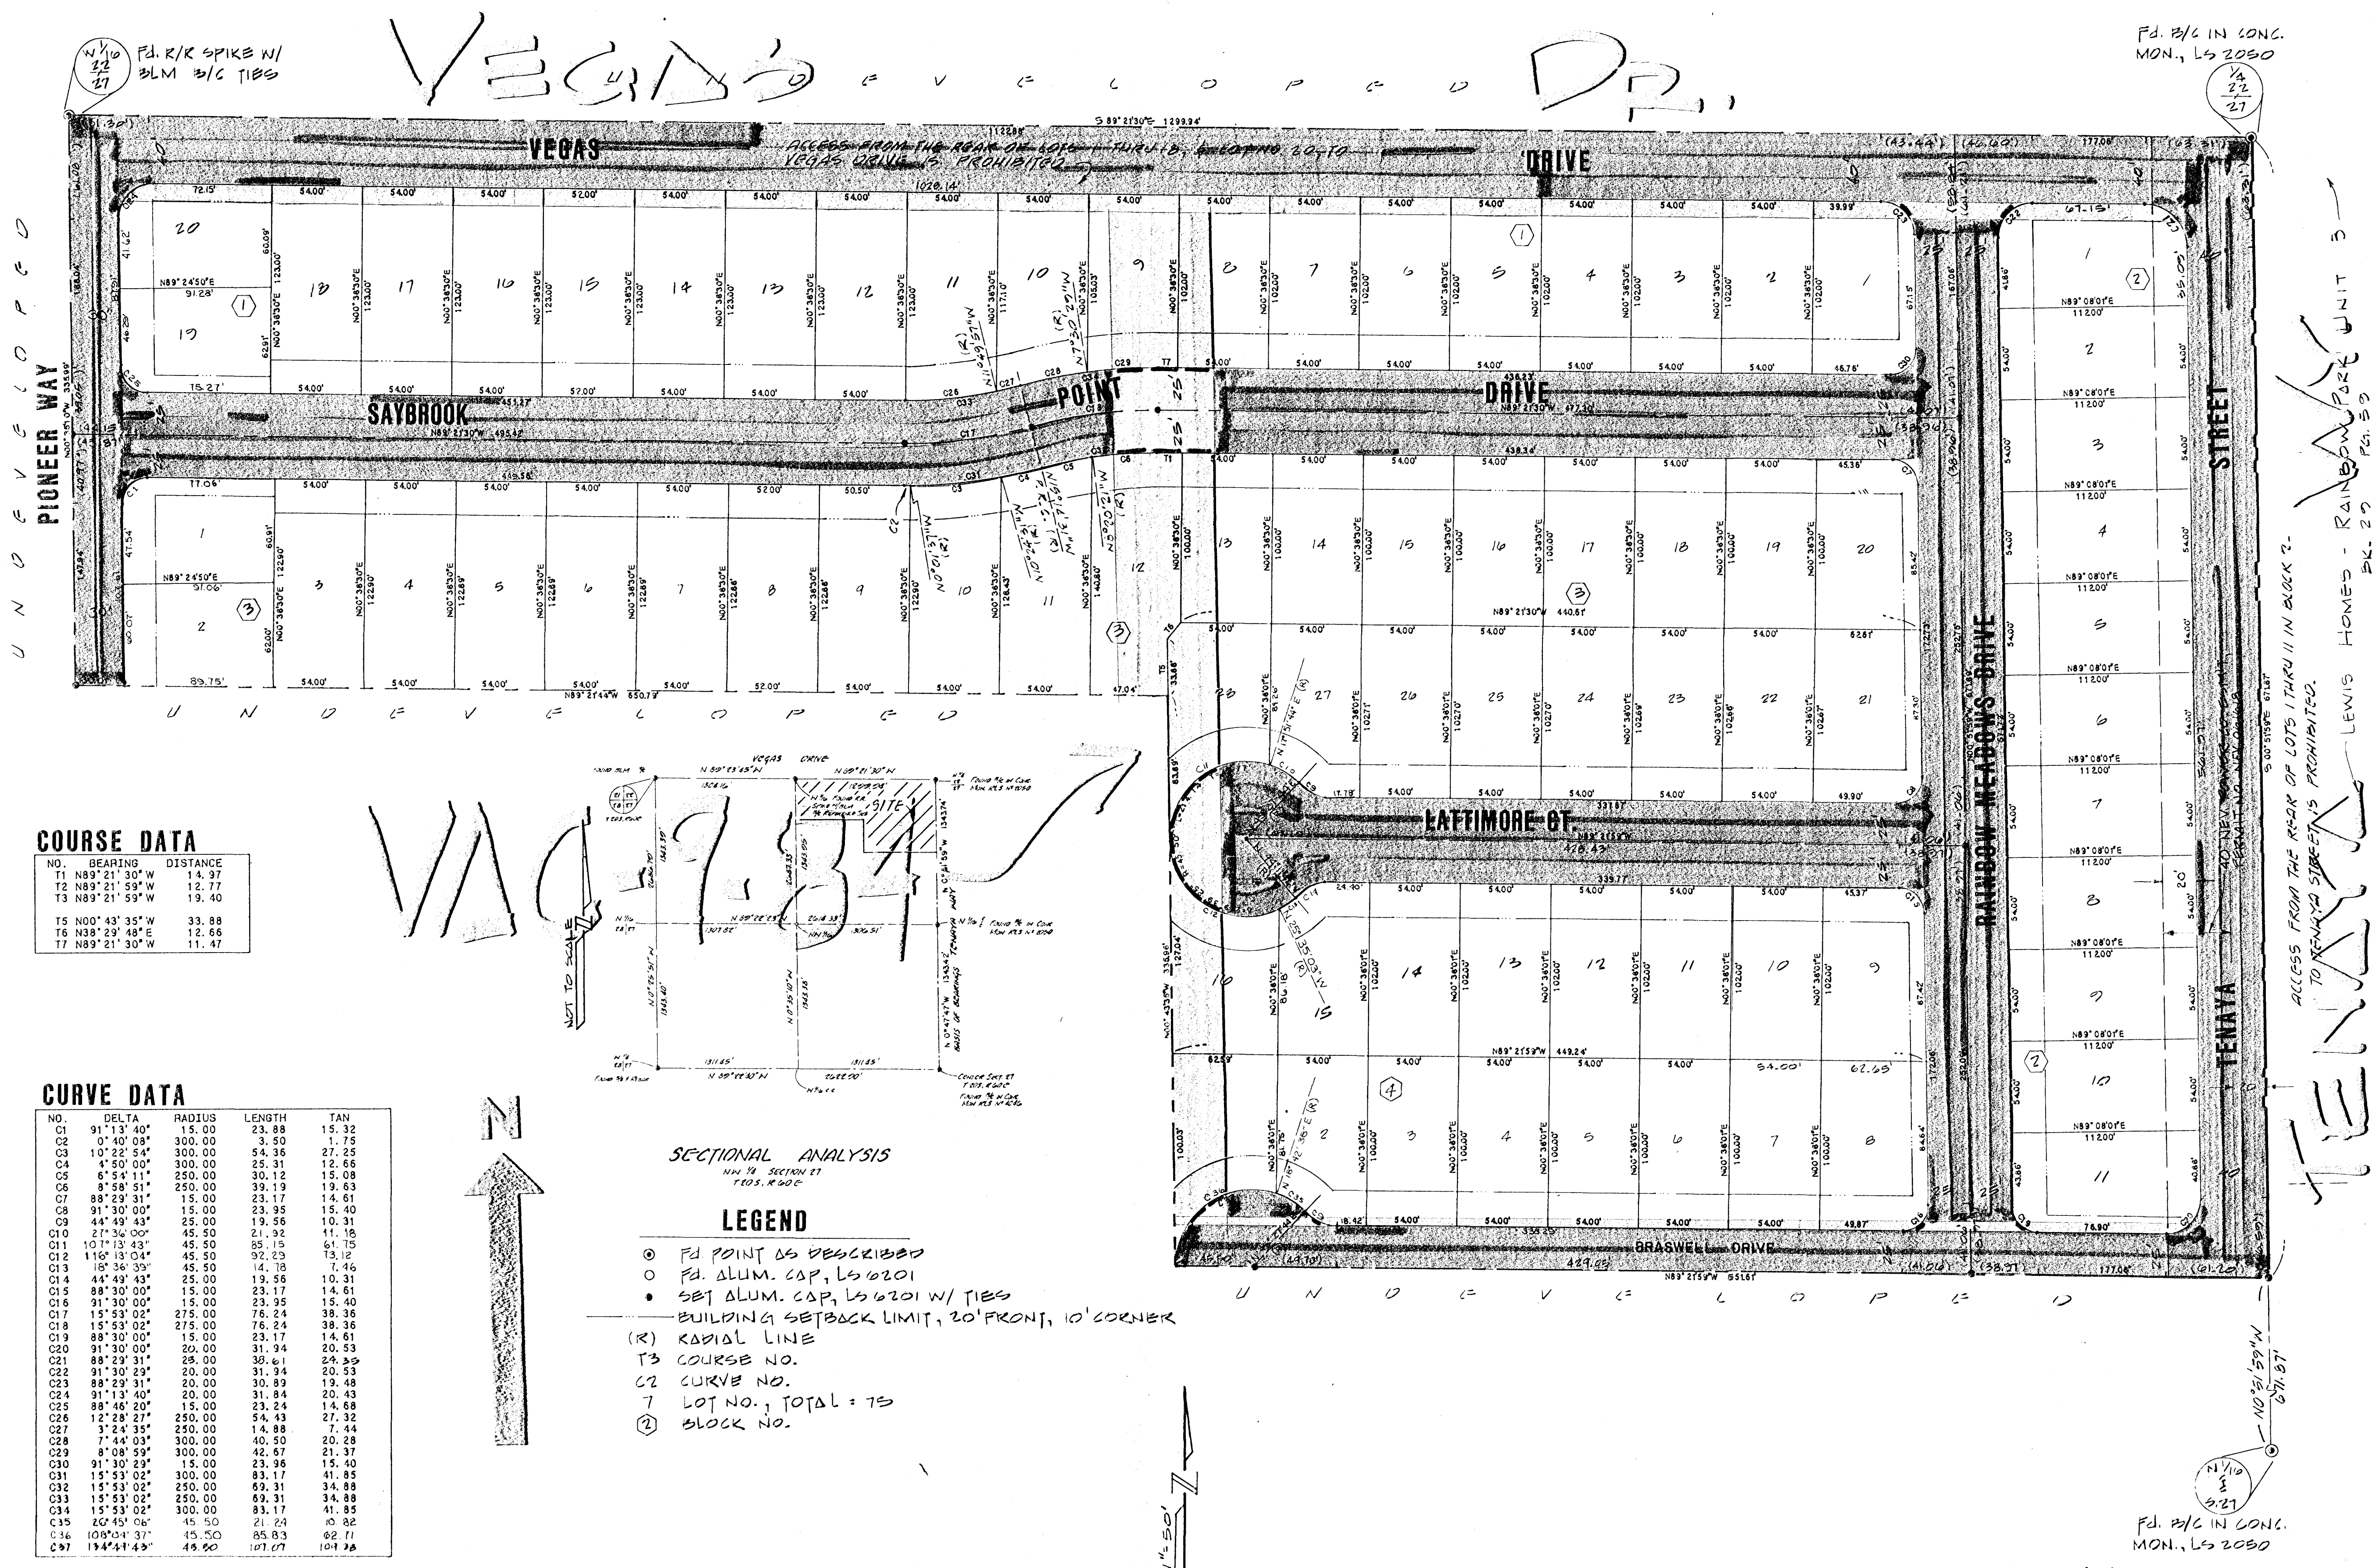

COURSE DATA

NO.	BEARING	DISTANCE
T1	N89°21'30"W	14.97
T2	N89°21'59"W	12.77
T3	N89°21'59"W	19.40
T5	N00°43'35"W	33.88
T6	N38°29'48"E	12.66
T7	N89°21'30"W	11.47

CURVE DATA

NO.	DELTA	RADIUS	LENGTH	TAN
C1	91°13'40"	15.00	23.88	15.32
C2	0°40'08"	300.00	1.15	1.15
C3	10°22'54"	300.00	54.36	27.25
C4	4°50'00"	300.00	25.31	12.66
C5	6°54'11"	250.00	30.12	15.08
C6	8°58'51"	250.00	30.19	19.53
C7	88°29'31"	15.00	23.17	14.61
C8	91°30'00"	15.00	23.95	15.40
C9	44°49'43"	25.00	19.56	10.31
C10	21°36'00"	45.50	21.92	11.16
C11	101°13'43"	45.50	95.15	61.75
C12	110°13'04"	45.50	92.23	73.12
C13	18°36'39"	45.50	14.78	7.46
C14	44°49'43"	25.00	19.56	10.31
C15	88°30'00"	15.00	23.17	14.61
C16	91°30'00"	15.00	23.95	15.40
C17	15°53'02"	275.00	76.24	38.36
C18	15°53'02"	275.00	76.24	38.36
C19	88°30'00"	15.00	23.17	14.61
C20	91°30'00"	20.00	31.94	20.53
C21	88°29'31"	25.00	30.61	24.59
C22	91°30'29"	20.00	31.94	20.53
C23	88°29'31"	20.00	30.89	19.48
C24	91°13'40"	20.00	31.84	20.43
C25	88°46'20"	15.00	23.24	14.68
C26	12°28'27"	250.00	54.43	27.32
C27	3°24'35"	250.00	14.88	7.44
C28	7°44'03"	300.00	40.50	20.28
C29	8°08'59"	300.00	42.67	21.37
C30	91°30'29"	15.00	23.96	15.40
C31	15°53'02"	300.00	83.17	41.85
C32	15°53'02"	250.00	69.31	34.88
C33	15°53'02"	250.00	69.31	34.88
C34	15°53'02"	300.00	83.17	41.85
C35	20°45'06"	15.50	21.24	10.92
C36	100°04'37"	15.50	95.83	62.71
C37	194°41'43"	49.90	107.07	101.96

SECTIONAL ANALYSIS

LEGEND

- FD POINT AS DESCRIBED
- FD. ALUM. CAP, L5 0201
- SET ALUM. CAP, L5 0201 W/ TIES
- BUILDING SETBACK LIMIT, 20' FRONT, 10' CORNER
- (R) RADIAL LINE
- T3 COURSE NO.
- C2 CURVE NO.
- 7 LOT NO., TOTAL = 75
- ② BLOCK NO.