


BOOK 1491

1450535

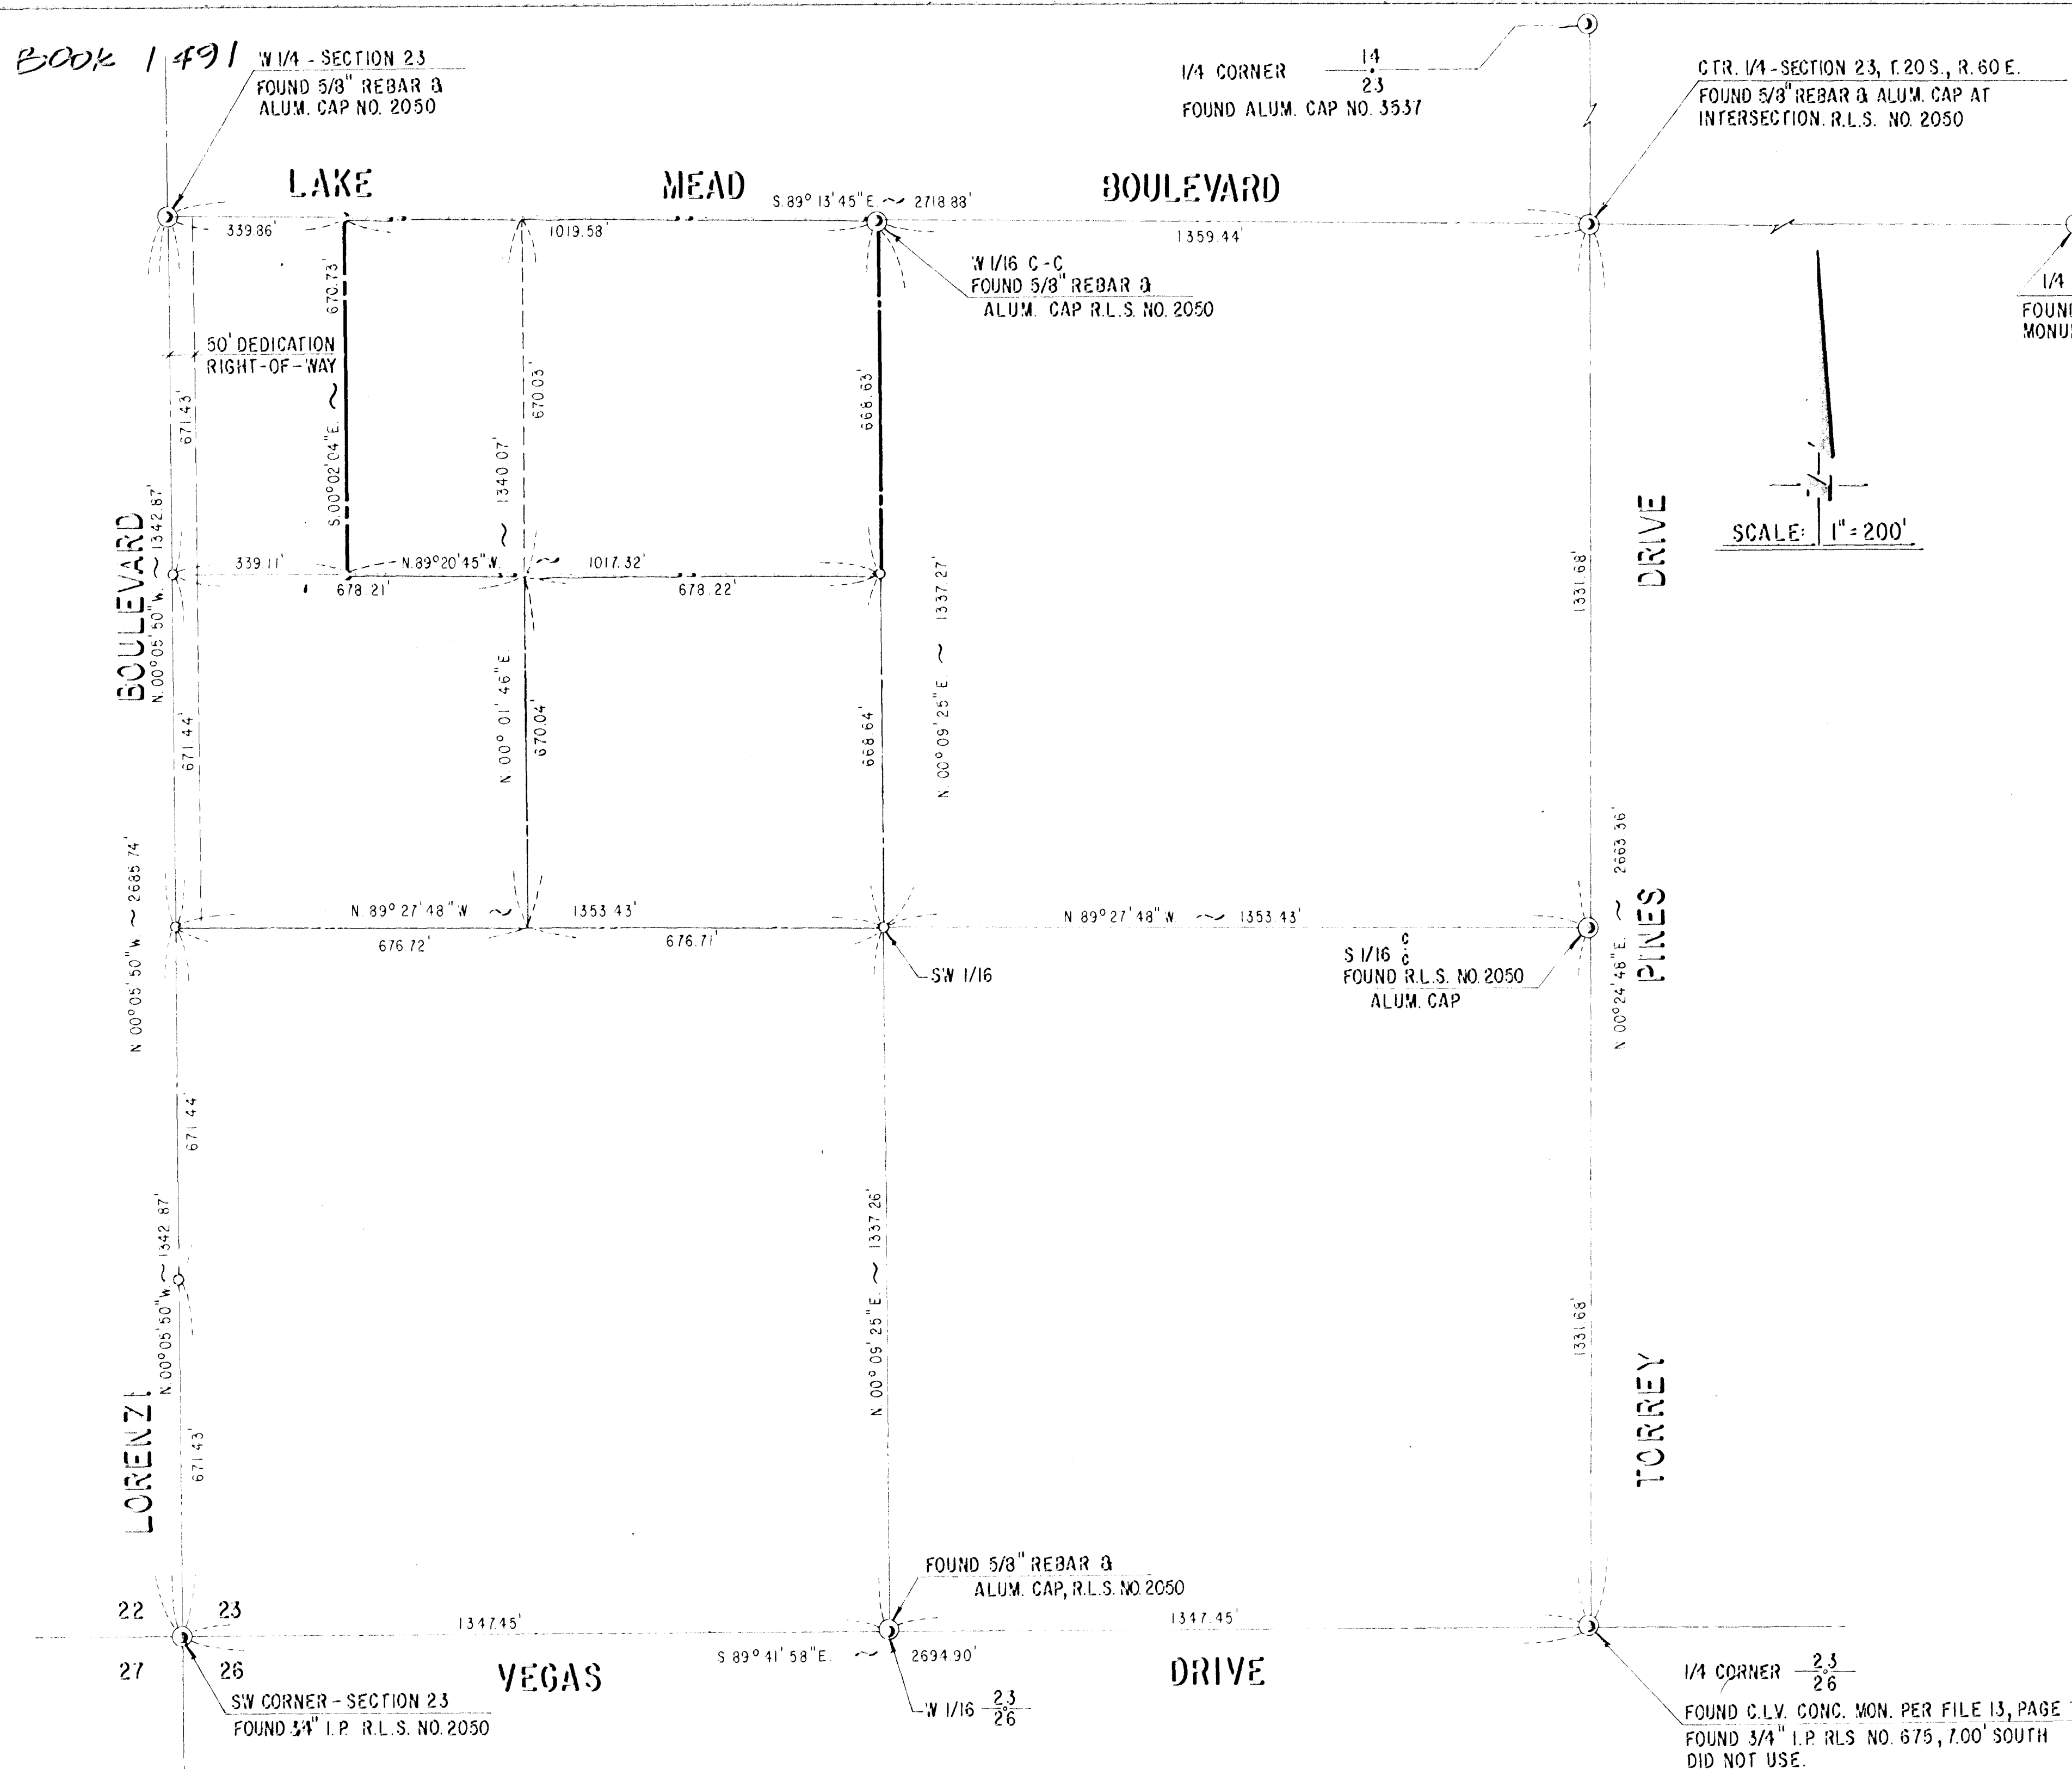

SURVEYOR'S CERTIFICATE

I, KAY L. ADAMS, A DULY REGISTERED LAND SURVEYOR, DO HEREBY CERTIFY THAT THIS MAP TRULY AND CORRECTLY REPRESENTS THE RESULTS OF A SURVEY MADE UNDER MY SUPERVISION AND COMPLETED ON THE 24th DAY OF Oct. 1981, FOR METROPOLITAN DEVELOPMENT CORPORATION. THIS SURVEY IS NOT A SUBDIVISION AS DEFINED BY NEVADA STATE LAWS.

Kay L. Adams
KAY L. ADAMS, REGISTERED LAND SURVEYOR, NO. 2050

BASIS OF BEARING

SOUTH 89°41'58" EAST, BEING THE BEARING OF THE SOUTH LINE OF THE SOUTHWEST QUARTER OF SECTION 23, TOWNSHIP 20 SOUTH, RANGE 60 EAST, M.D.M., AS SHOWN BY A MAP ON FILE IN THE CLARK COUNTY, NEVADA, RECORDER'S OFFICE AS BOOK 23, PAGE 99 OF PLATS.

LEGEND

- ① MONUMENT FOUND AS SHOWN
- SET STANDARD CONCRETE MONUMENT W/BRASS CAP
- FOUND CONCRETE MONUMENT W/BRASS CAP - R.L.S. #2050


LEGAL DESCRIPTION

THE NORTHEAST QUARTER (NE 1/4) OF THE NORTHWEST QUARTER (NW 1/4) OF THE SOUTHWEST QUARTER (SW 1/4) AND THE EAST HALF (E 1/2) OF THE NORTHWEST QUARTER (NW 1/4) OF THE NORTHWEST QUARTER (NW 1/4) OF THE SOUTHWEST QUARTER (SW 1/4) OF SECTION 23, TOWNSHIP 20 SOUTH, RANGE 60 EAST, M.D.M., CLARK COUNTY, NEVADA.

SAID PARCEL CONTAINS 15.6563 ACRES.

NO.	1450535
FILED AT THE REQUEST OF	
METROPOLITAN DEVELOPMENT CORPORATION.	
DATE	11-24-81 AT 1:52 P.M.
FILE	38 PAGE 24
OF SURVEYS	
OFFICIAL RECORDS BOOK NO.	1491
CLARK COUNTY NEVADA, RECORDS	
JOAN L. SWIFT	
RECORDER	
FEE \$	10.00
DEPUTY	J.W.

BOUNDARY SURVEY OF A PORTION OF THE
NORTHWEST QUARTER OF THE SOUTHWEST
QUARTER OF SECTION 23,
TOWNSHIP 20 SOUTH, RANGE 60 EAST, M.D.M.
CLARK COUNTY, NEVADA
ANNEXED TO THE CITY OF LAS VEGAS, NEVADA
UNDER ORDINANCE NO. 2221

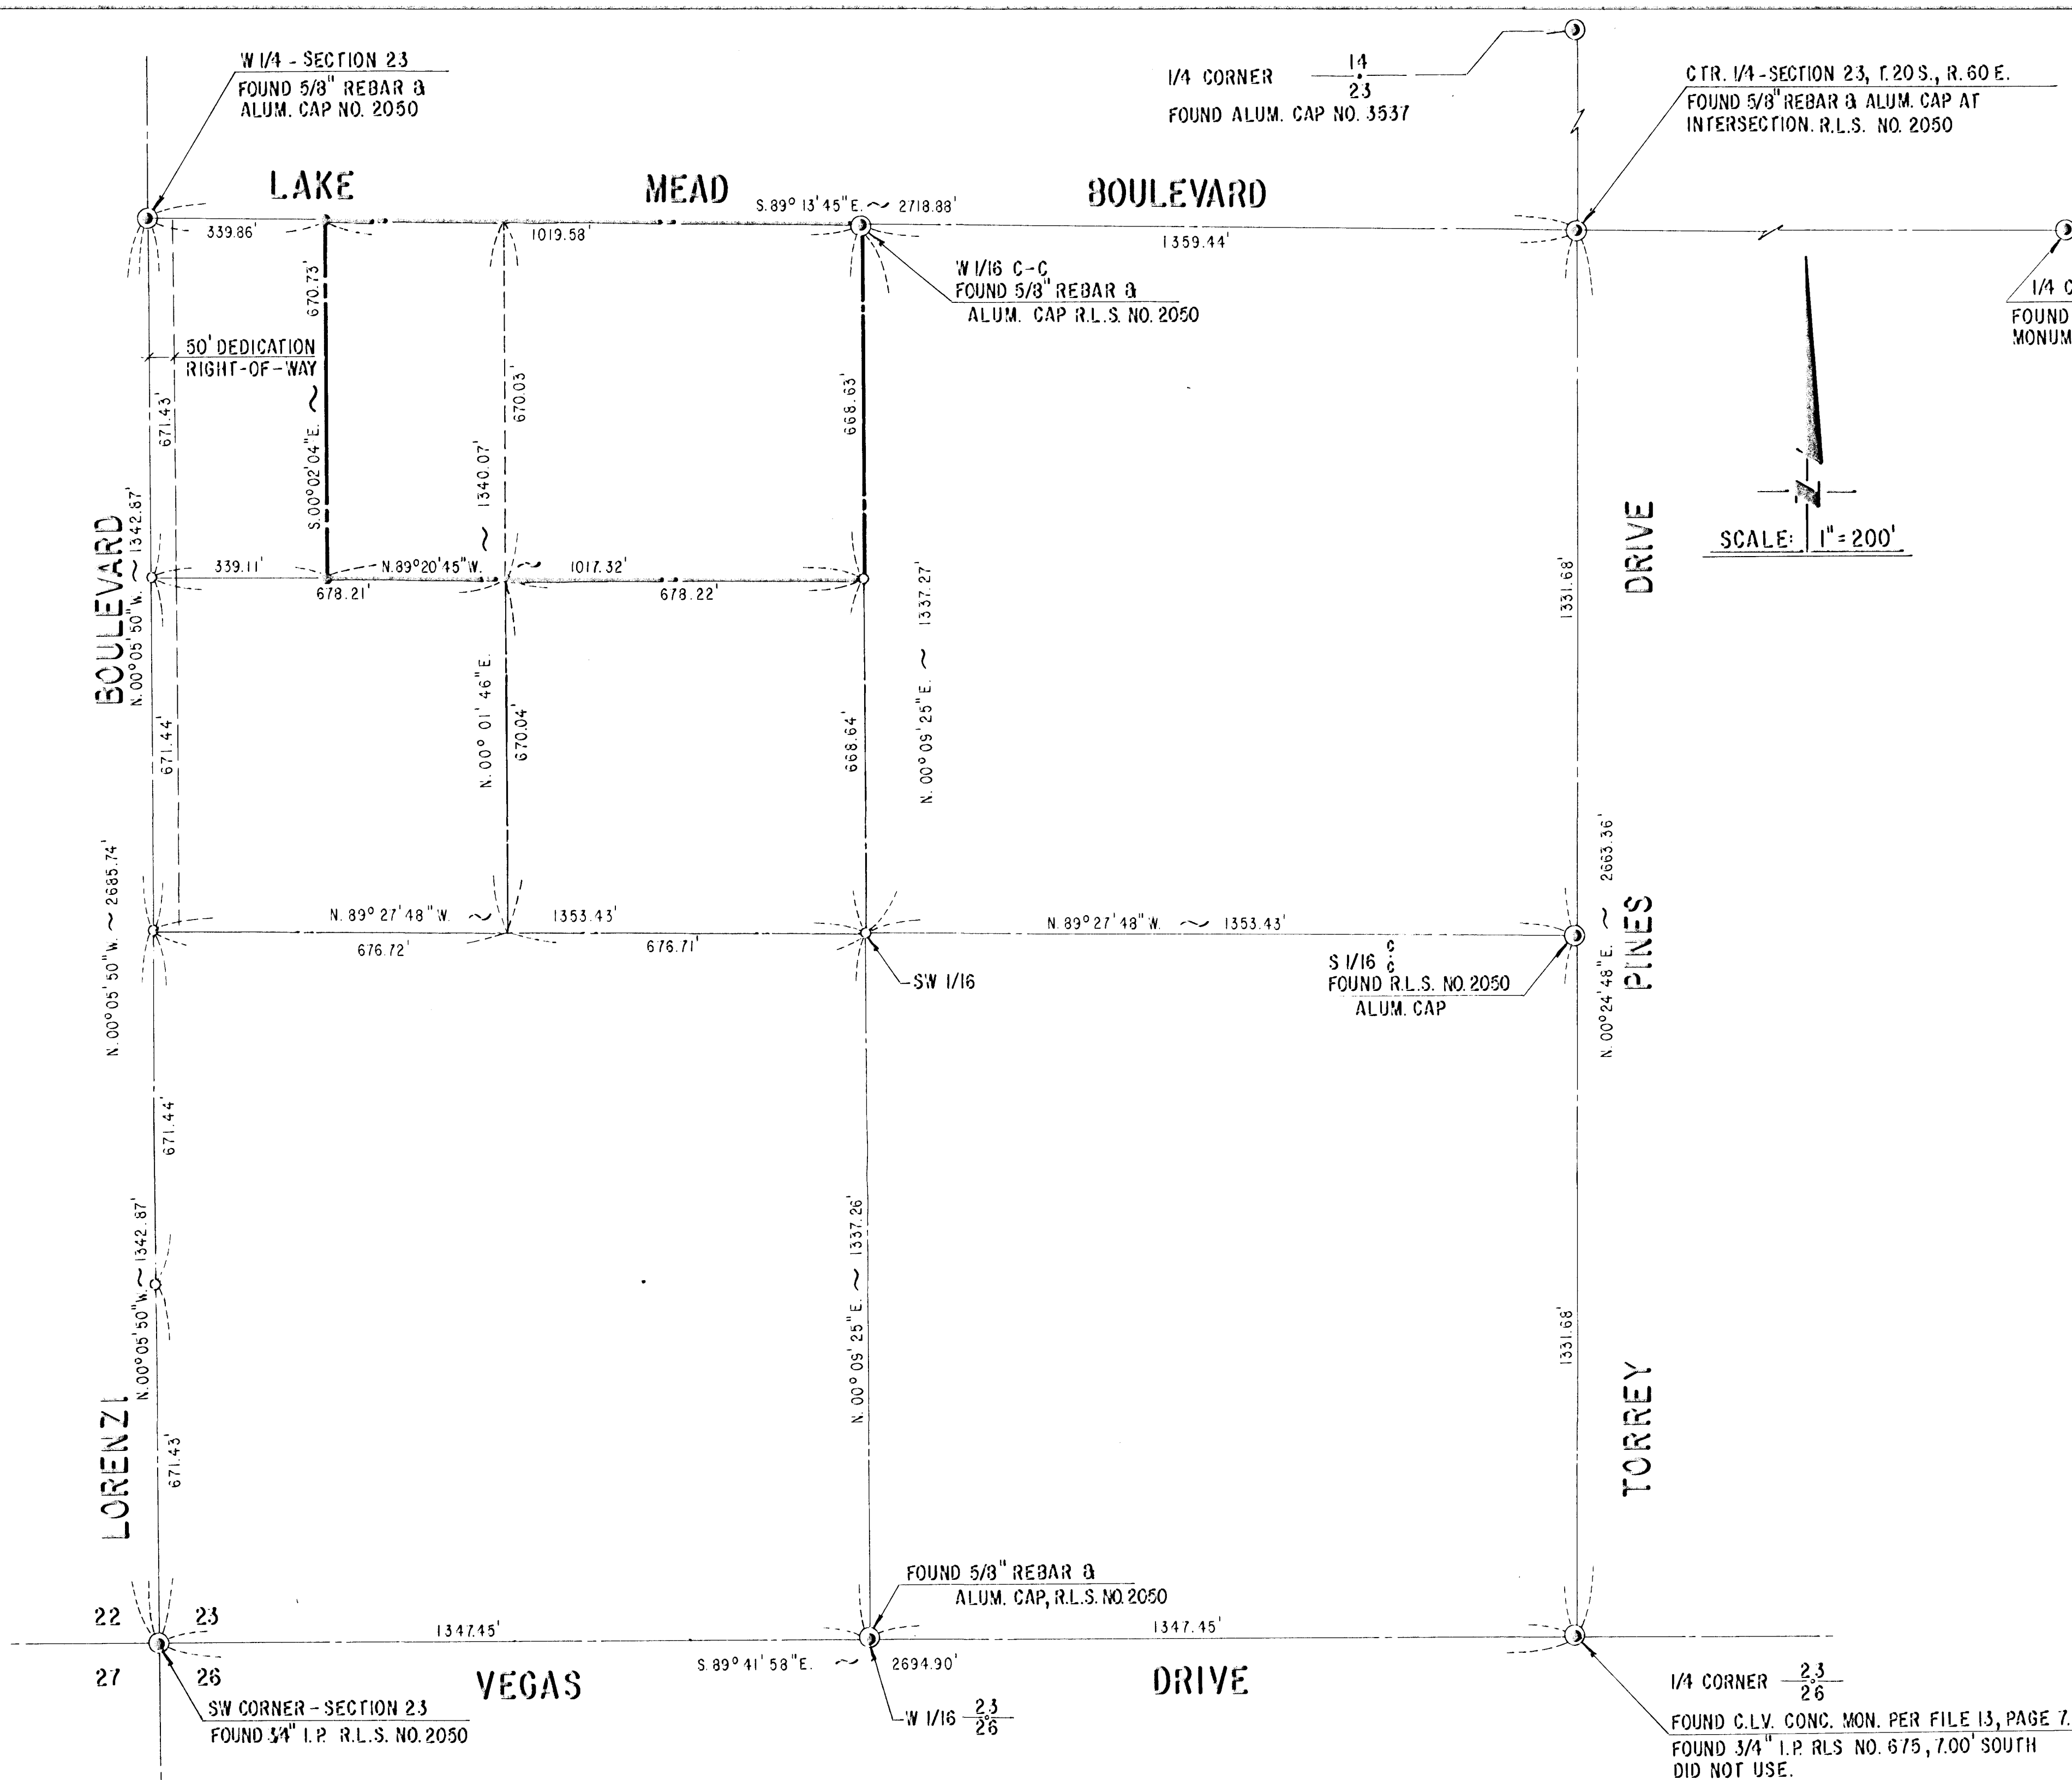

SURVEYOR'S CERTIFICATE

I, KAY L. ADAMS, A DULY REGISTERED LAND SURVEYOR, DO HEREBY CERTIFY THAT THIS MAP TRULY AND CORRECTLY REPRESENTS THE RESULTS OF A SURVEY MADE UNDER MY SUPERVISION AND COMPLETED ON THE 26th DAY OF Oct., 1981, FOR METROPOLITAN DEVELOPMENT CORPORATION. THIS SURVEY IS NOT A SUBDIVISION AS DEFINED BY NEVADA STATE LAWS.

Kay L. Adams
KAY L. ADAMS, REGISTERED LAND SURVEYOR, NO. 2050

BASIS OF BEARING

SOUTH 89°41'58" EAST, BEING THE BEARING OF THE SOUTH LINE OF THE SOUTHWEST QUARTER OF SECTION 23, TOWNSHIP 20 SOUTH, RANGE 60 EAST, M.D.M., AS SHOWN BY A MAP ON FILE IN THE CLARK COUNTY, NEVADA, RECORDER'S OFFICE AS BOOK 23, PAGE 99 OF PLATS.

LEGEND

- ③ MONUMENT FOUND AS SHOWN
- ▶ SET STANDARD CONCRETE MONUMENT W/BRASS CAP
- FOUND CONCRETE MONUMENT W/BRASS CAP - R.L.S. #2050


LEGAL DESCRIPTION

THE NORTHEAST QUARTER (NE 1/4) OF THE NORTHWEST QUARTER (NW 1/4) OF THE SOUTHWEST QUARTER (SW 1/4) AND THE EAST HALF (E 1/2) OF THE NORTHWEST QUARTER (NW 1/4) OF THE NORTHWEST QUARTER (NW 1/4) OF THE SOUTHWEST QUARTER (SW 1/4) OF SECTION 23, TOWNSHIP 20 SOUTH, RANGE 60 EAST, M.D.M., CLARK COUNTY, NEVADA.

SAID PARCEL CONTAINS 15.6563 ACRES.

NO.	FILED AT THE REQUEST OF
	METROPOLITAN DEVELOPMENT CORPORATION
DATE	AT
FILE	PAGE
	OF SURVEYS
OFFICIAL RECORDS BOOK NO.	
CLARK COUNTY NEVADA, RECORDS	
JOAN L. SWIFT	
RECORDER	
FEE \$	
DEPUTY	

BOUNDARY SURVEY OF A PORTION OF THE NORTHWEST QUARTER OF THE SOUTHWEST QUARTER OF SECTION 23, TOWNSHIP 20 SOUTH, RANGE 60 EAST, M.D.M. CLARK COUNTY, NEVADA ANNEXED TO THE CITY OF LAS VEGAS, NEVADA UNDER ORDINANCE NO.

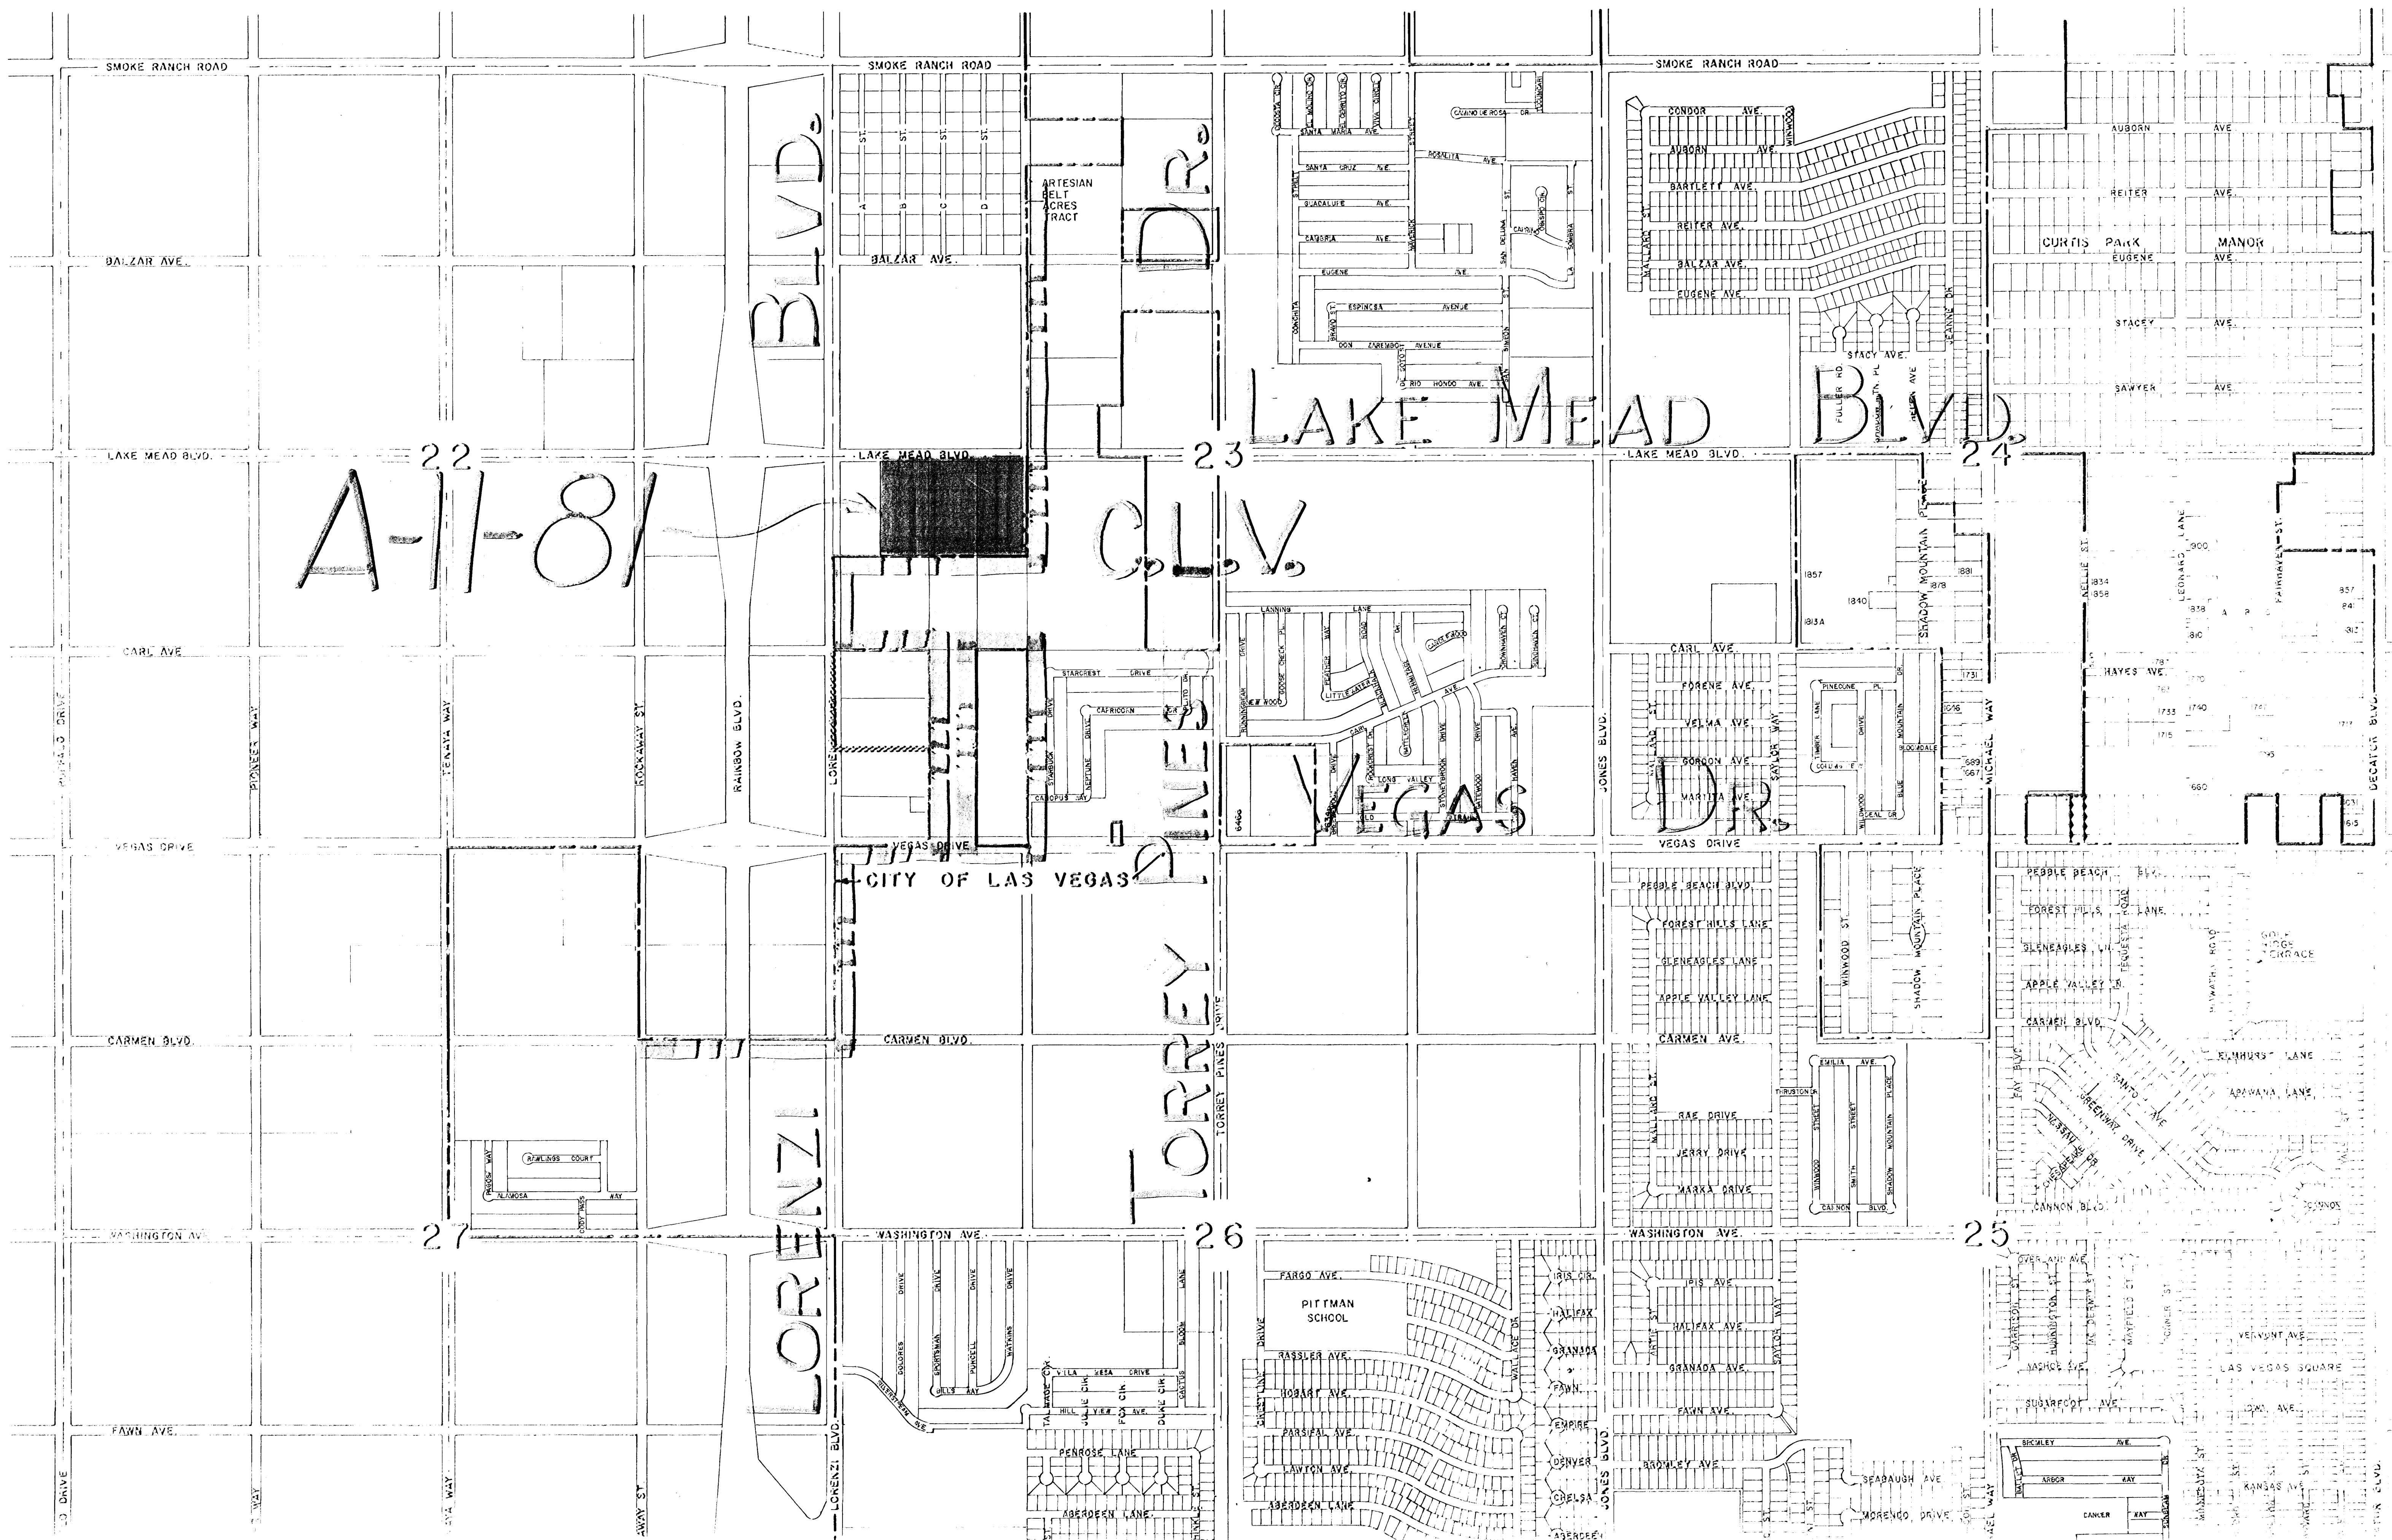

A-11-81

CLV

TORREY

LORENZI

LAKE MEAD

BLVD

VEGAS

CITY OF LAS VEGAS

DR