


BOOK 1310

1269978

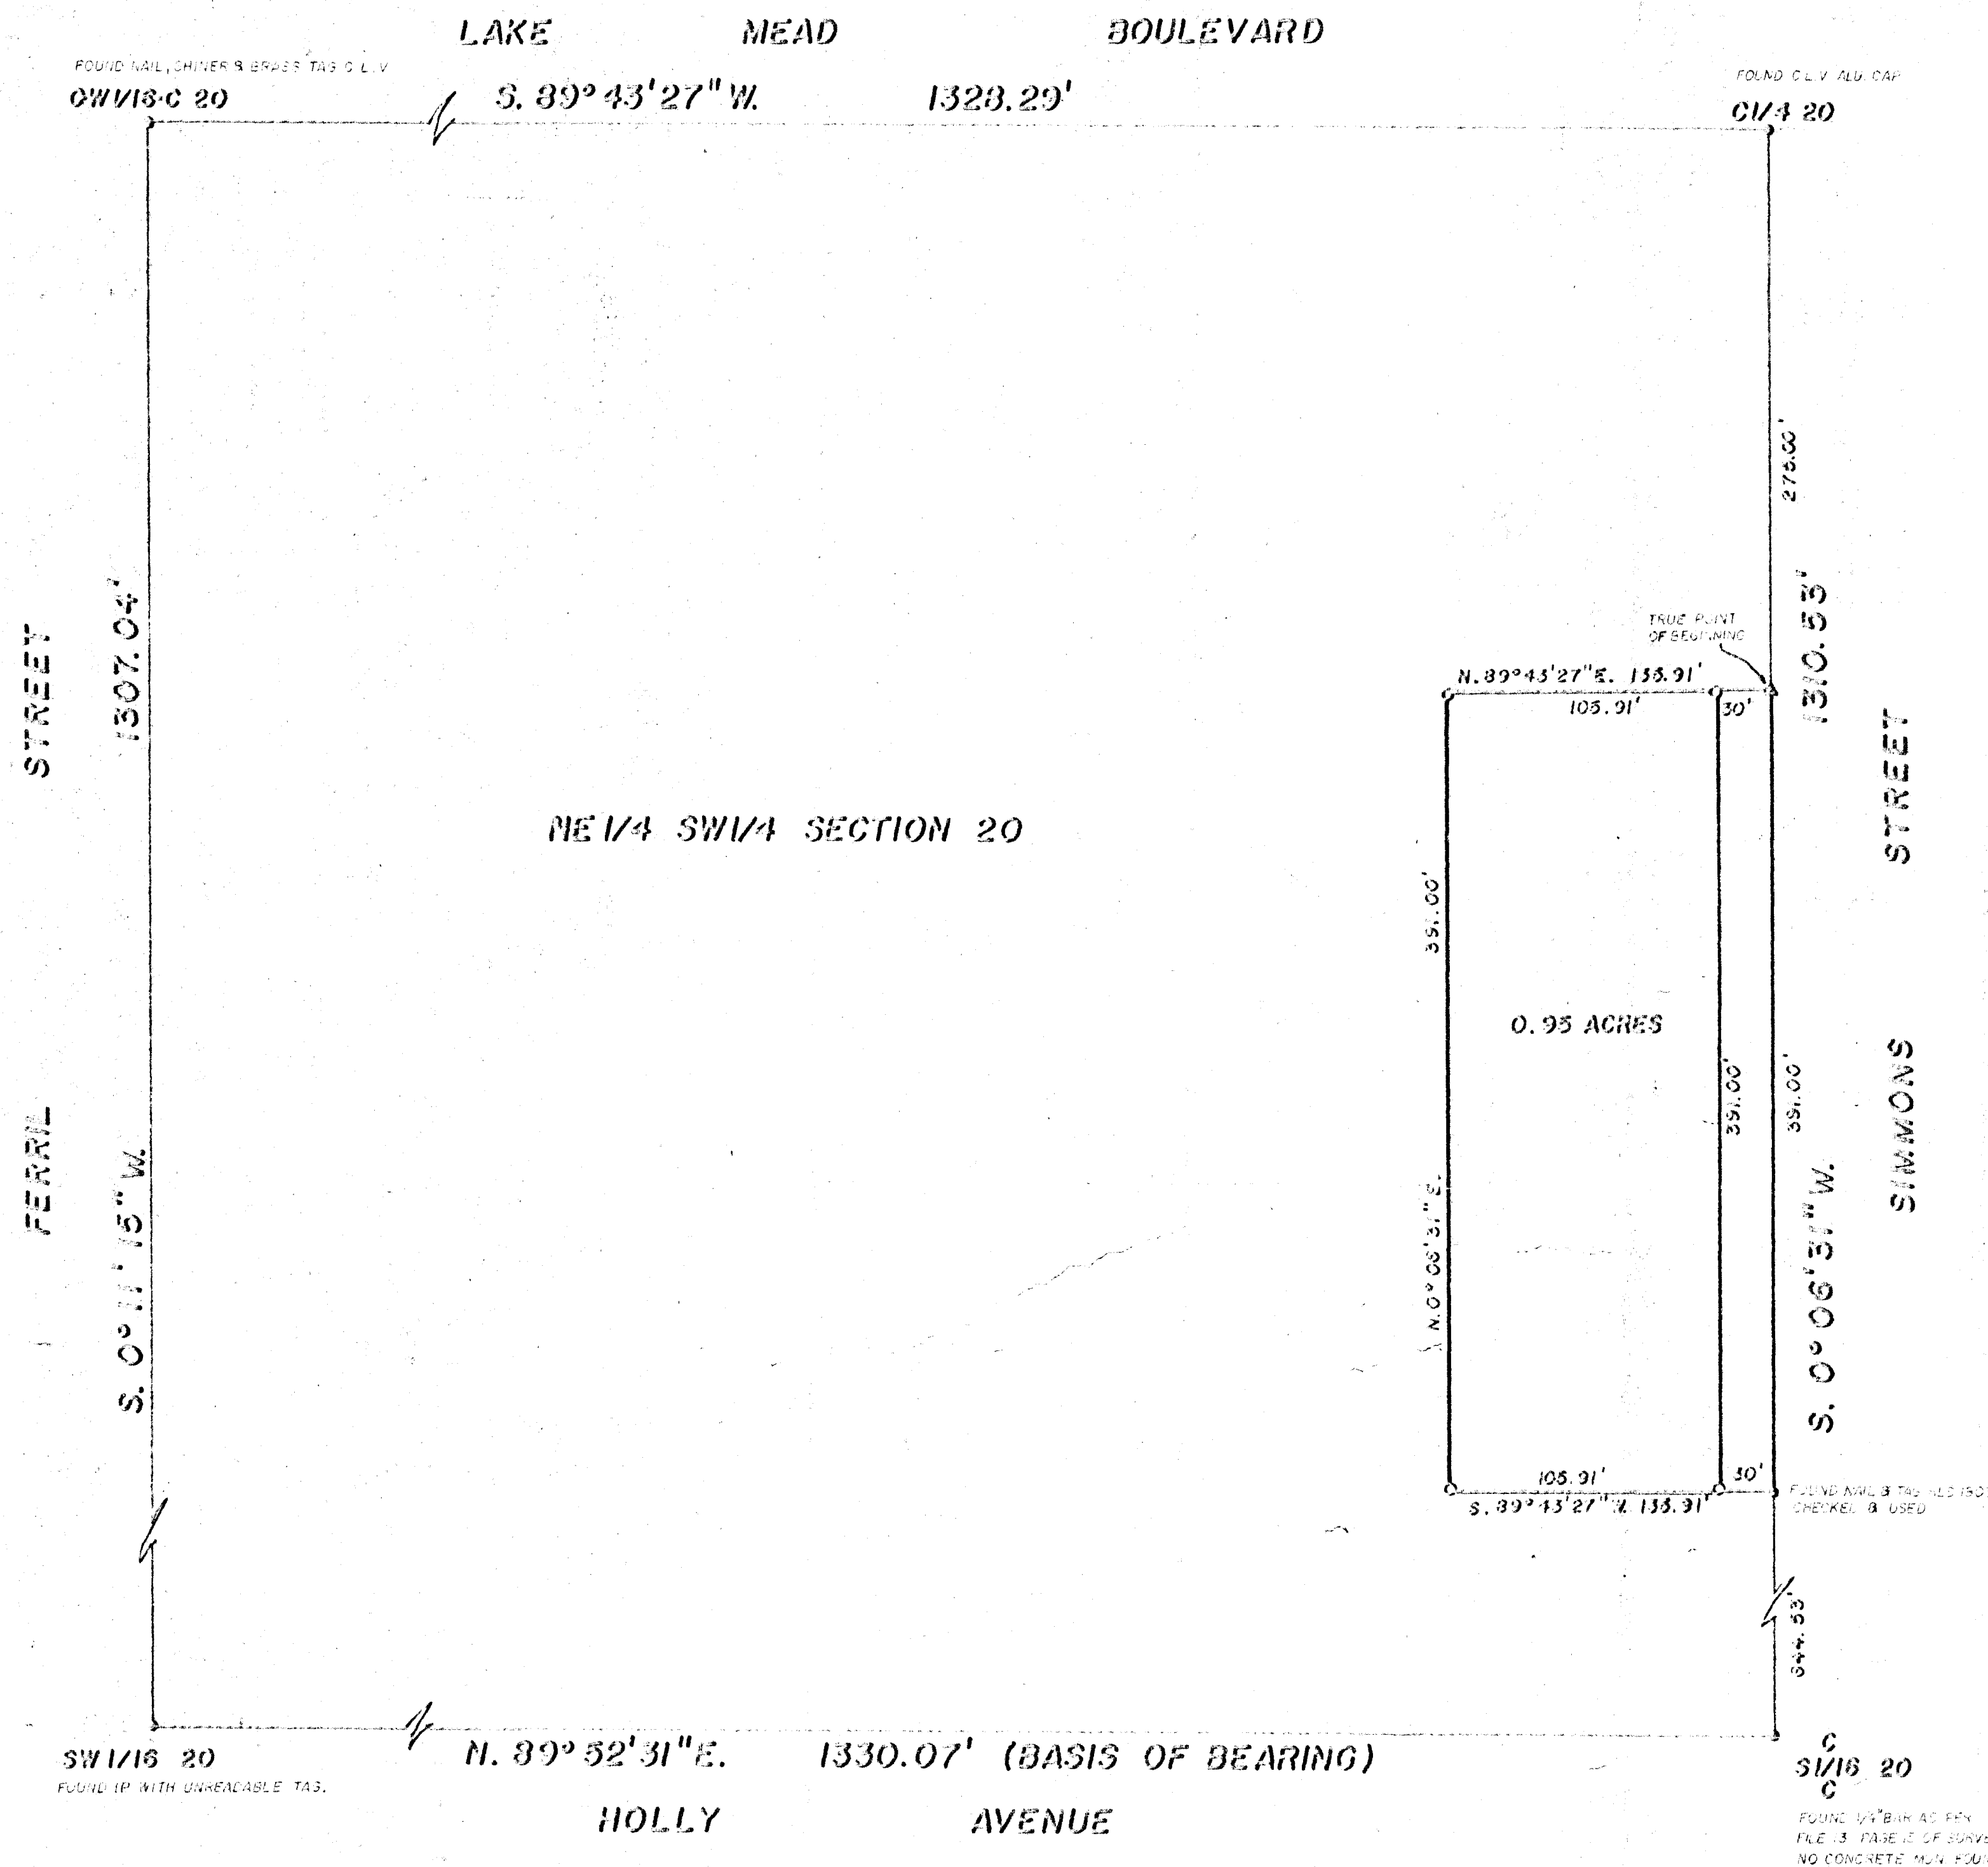

SURVEYORS CERTIFICATE

I, BRENT ROSS WOOLSEY, A DULY REGISTERED LAND SURVEYOR, DO HEREBY CERTIFY THAT THIS MAP TRULY AND CORRECTLY REPRESENTS A SURVEY MADE BY ME AND COMPLETED AUGUST 21, 1930 FOR ALTON M. CARTER AND ALICE E. CARTER. THIS SURVEY IS NOT A SUBDIVISION AS DEFINED BY NEVADA STATE LAW.

Brent Ross Woolsey
BRENT ROSS WOOLSEY, R.L.S. DATE *8/21/30*
NEVADA CERTIFICATE NO. 4301

LEGEND

- Δ MONUMENTS FOUND AS INDICATED.
- MONUMENTS SET BAR W/CAP RLS 4301.
- Δ SET NAIL & TAG RLS 4301.


BASIS OF BEARING

SOUTH LINE NE 1/4 SW 1/4 SEC. 20, T. 20 S., R. 61 E., M.D.B. 3 M. BEING N. 89° 52' 31" E. AS SHOWN ON FILE 13 PAGE 15 OF SURVEYS CLARK COUNTY RECORDS.

DESCRIPTION

BEGINNING AT THE C 1/4 SEC. 20, T. 20 S., R. 61 E., M.D.B. 3 M. BEING THENCE S. 0° 06' 31" W. ALONG THE EAST LINE NE 1/4 SW 1/4 SEC. 20, 275.00' TO THE TRUE POINT OF BEGINNING, THENCE S. 0° 06' 31" W. ALONG THE EAST LINE OF THE NE 1/4 SW 1/4 SEC. 20, 351.00' TO THE SOUTH LINE OF THAT PARCEL OF LAND DESCRIBED BY DOCUMENT NO. 403807, RECORDED JULY 9, 1933, THENCE S. 89° 43' 27" W. ALONG SAID SOUTH LINE 135.91'; THENCE N. 0° 06' 31" E. AND PARALLEL TO SAID EAST LINE 351.00'; THENCE N. 89° 43' 27" E. AND PARALLEL TO THE NORTH LINE OF SAID NE 1/4 SW 1/4 SEC. 20, 135.91' TO THE TRUE POINT OF BEGINNING.

BRW SURVEYING, INC. BOX 465, INDIAN SPRINGS, NEVADA 89018 P. 702) 875-3319	NO. 1269978
BOUNDARY SURVEY OF A PORTION OF THE NE 1/4 SW 1/4 OF SECTION 20, T. 20 S., R. 61 E., M.D.B. 3 M. CLARK CO. NEV.	FILED AT THE REQUEST OF ALTON M. CARTER
ANNEXED TO THE CITY OF LAS VEGAS NEV. UNDER ORDINANCE NO. 2124	DATE 11-13-30 AT 2:25 P.M.
	FILE 36 PAGE 72
	OF SURVEYS
	OFFICIAL RECORDS BOOK NO. 1310
	CLARK COUNTY NEVADA RECORDS
	JOAN L. SHIFF, RECORDER
	FEE \$5.00 DEPUTY R.H. P.

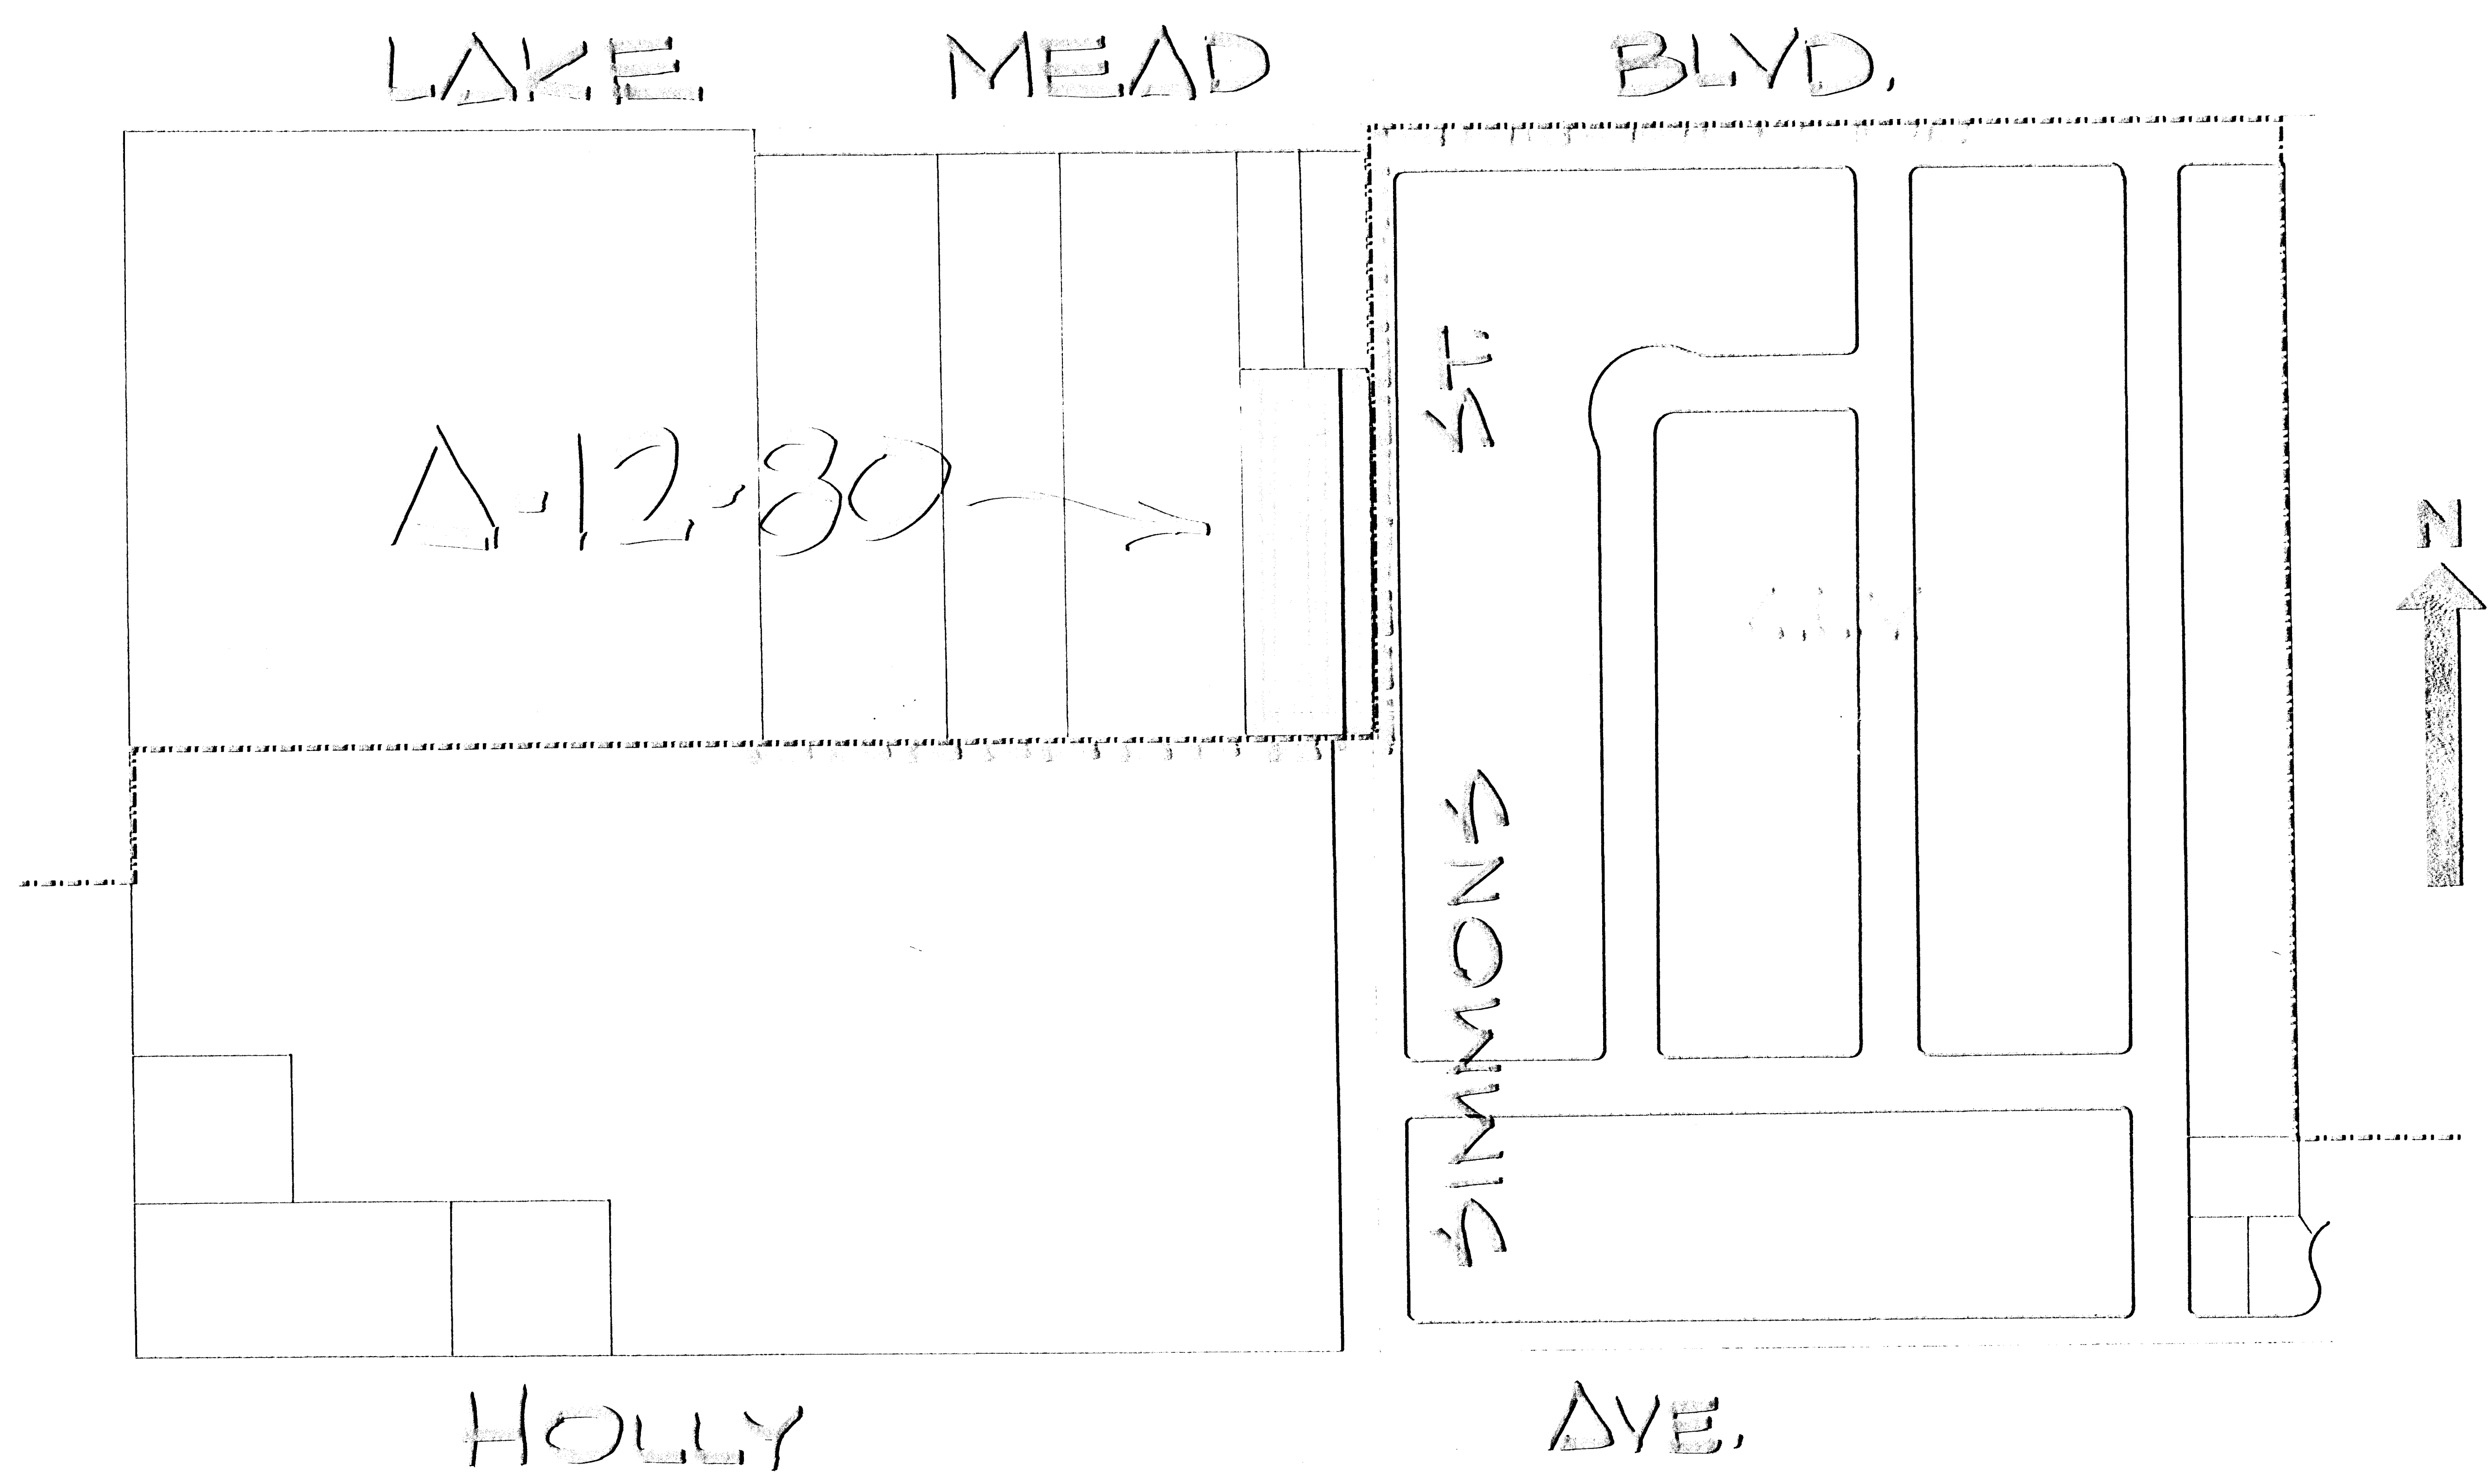

Sheet
Drawing no.
of
11 2. no.

Design: BV:	Date:	Reviewed: BV:	Date:
Drawn: BV:	Date:	Reviewed: BV:	Date:
Division:	Scale:		

City of Las Vegas, Nevada
Department of
Community Planning and Development
Don J. Saylor, A.I.P., Director

