


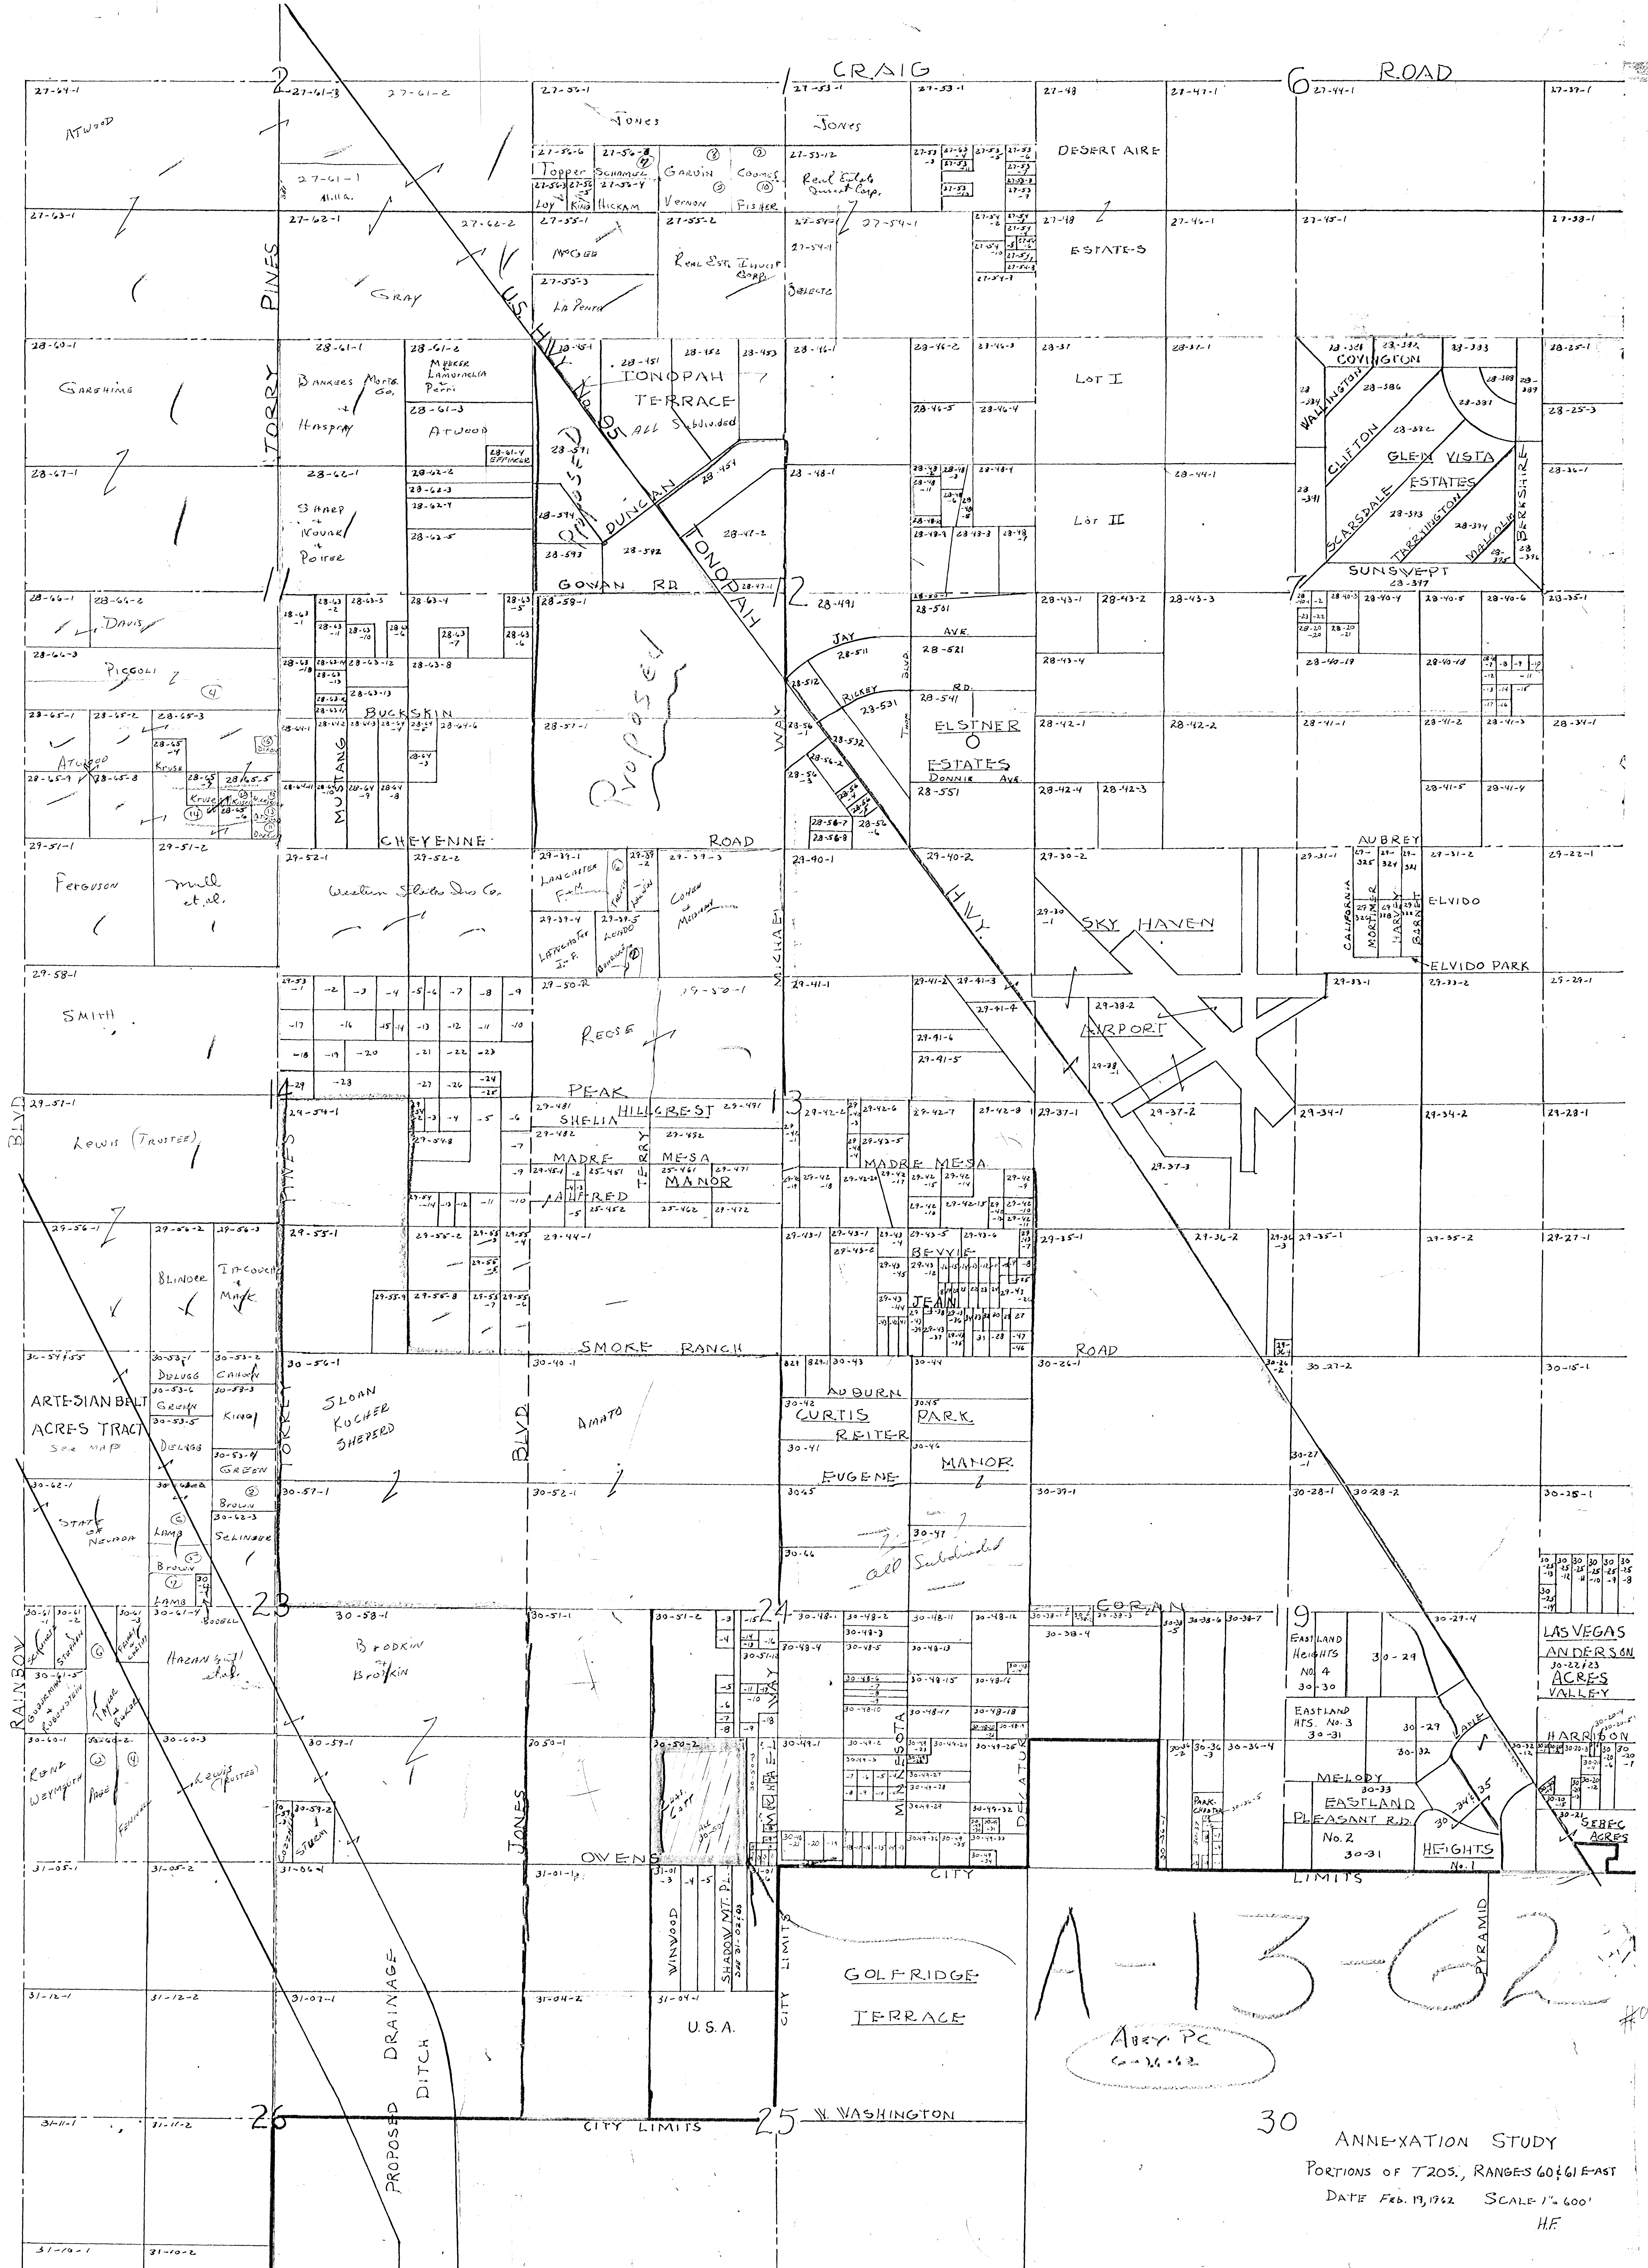

30
ANNEXATION STUDY
PORTIONS OF T20S, RANGES 60 & 61 E-AST
DATE Feb. 19, 1962 SCALE 1" = 600'
HF