


- LEGEND**
- FND. MON. AS INDICATED
 - ◆ SET 5/8" REBAR W/PLASTIC CAP, RLS 4040

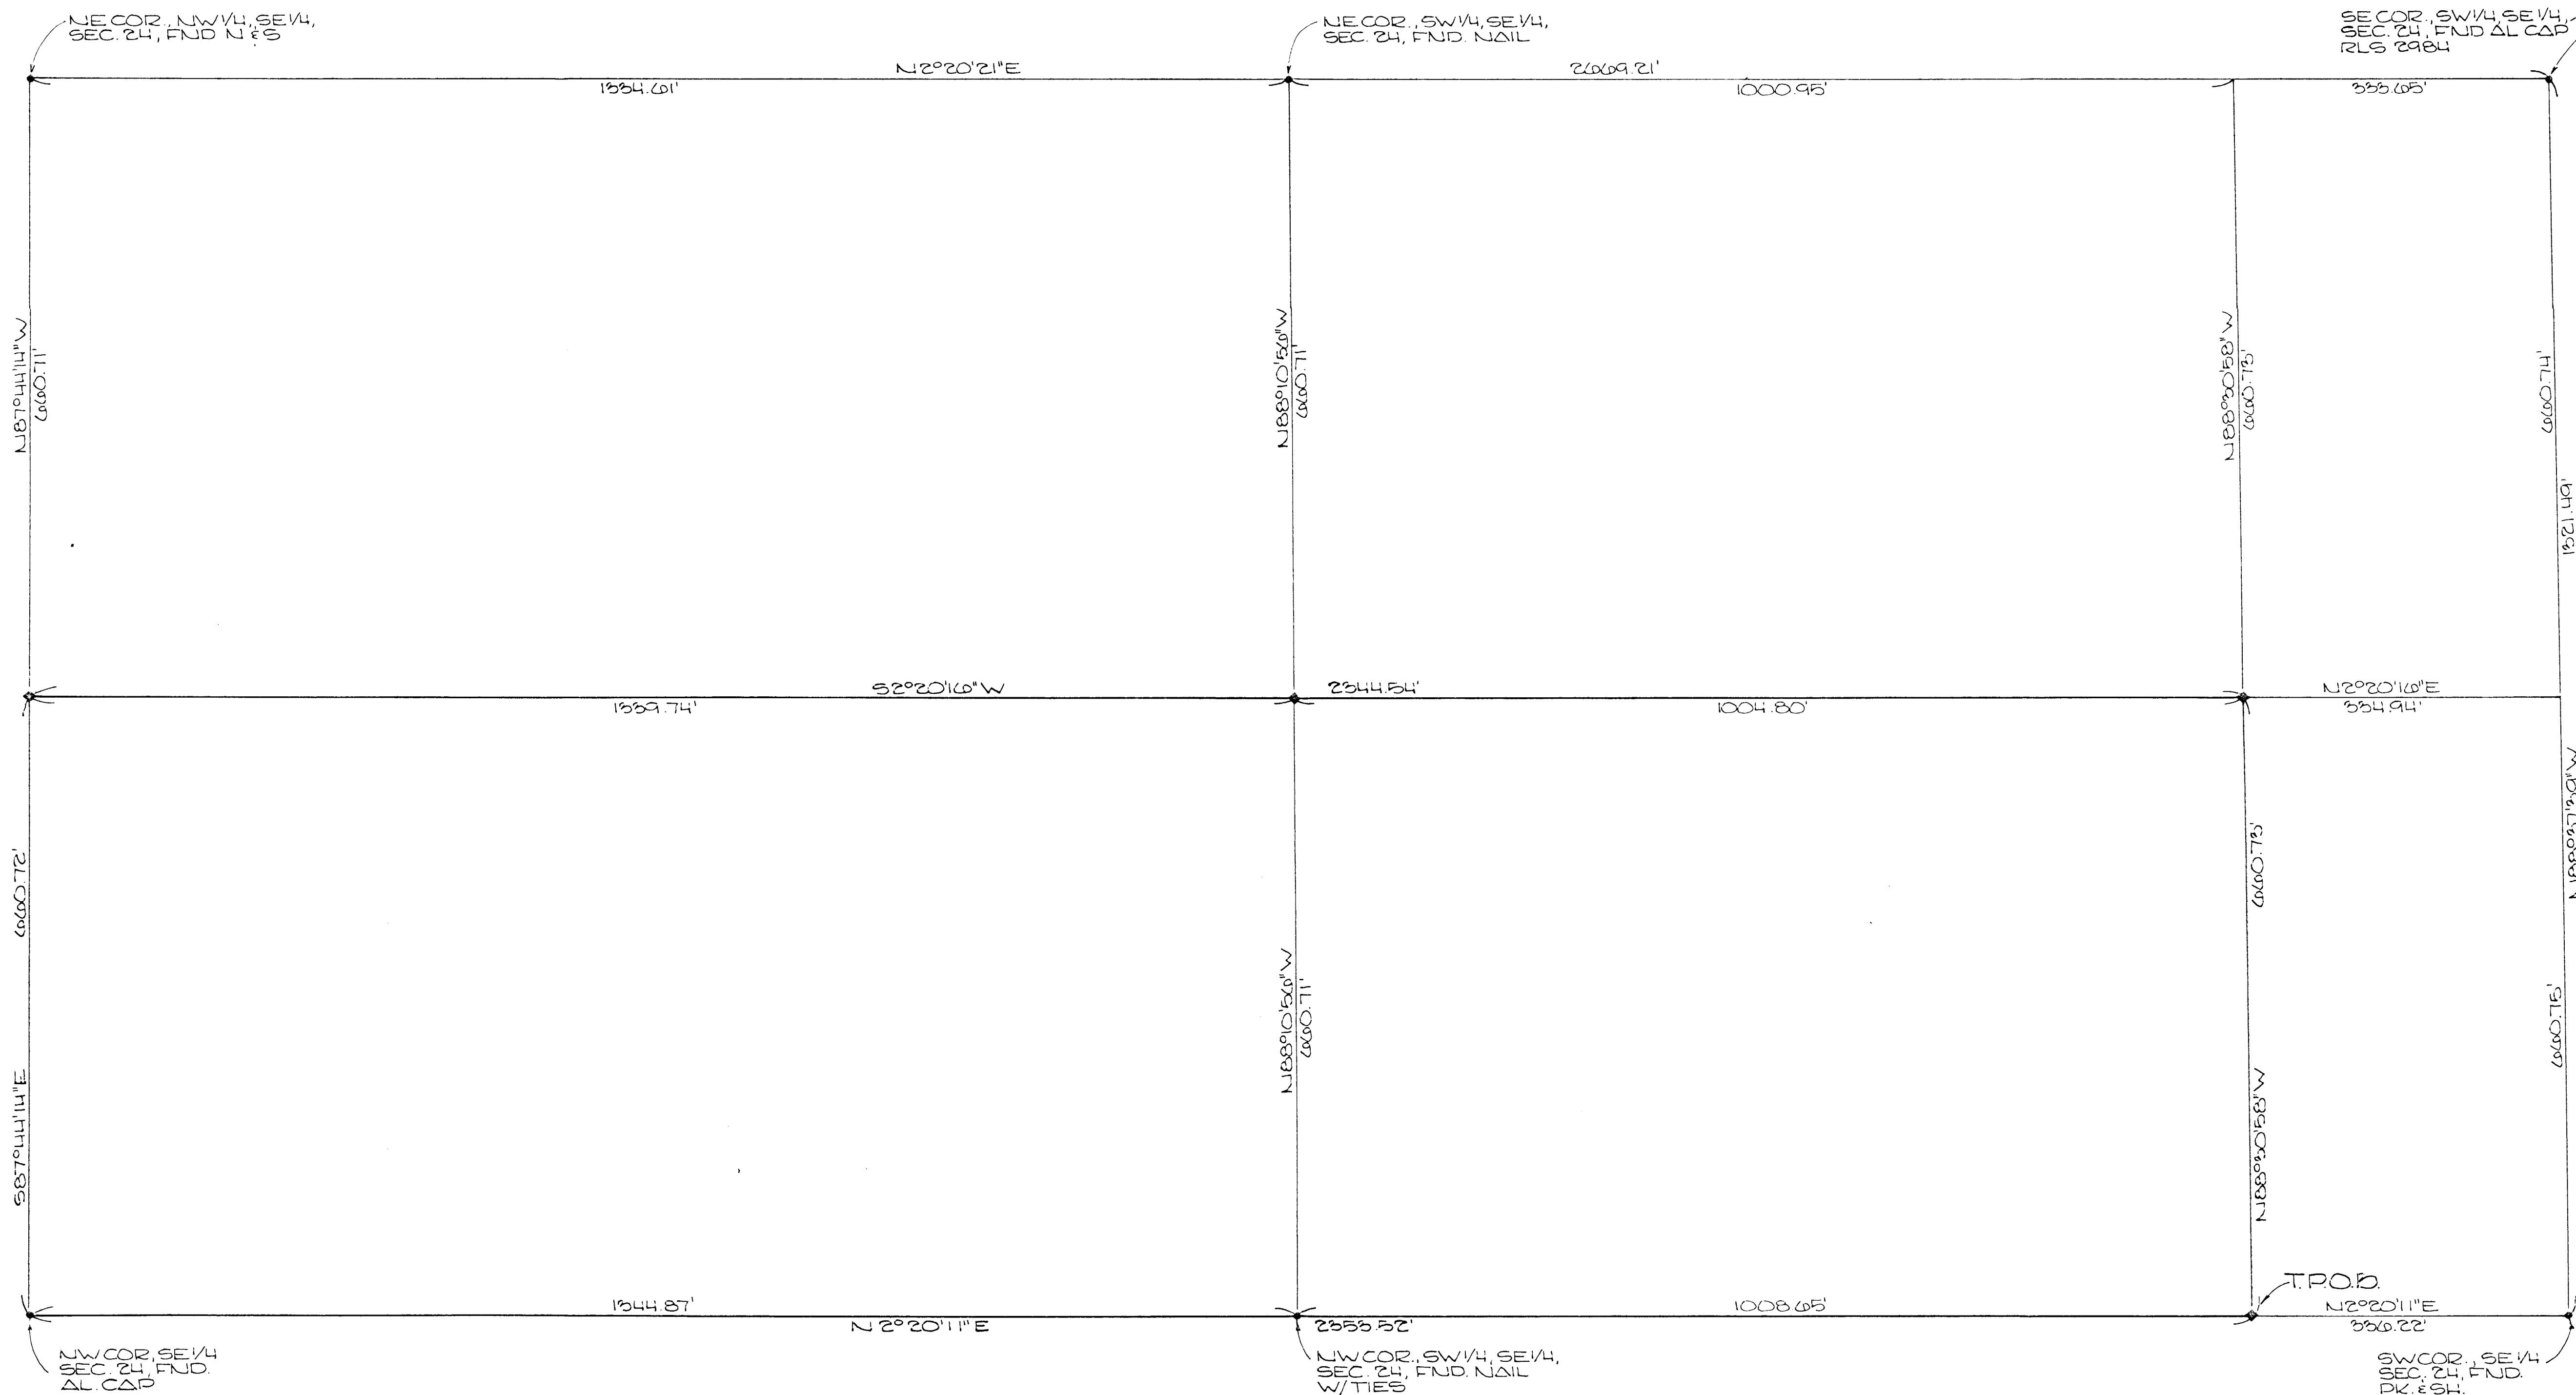

SURVEYOR'S CERTIFICATE

I, JERRY E. BARNSON, A DULY REGISTERED SURVEYOR IN THE STATE OF NEVADA AS AN AGENT FOR VTN NEVADA, DO HEREBY CERTIFY THAT THE SURVEY OF THE LAND SHOWN HEREON WAS MADE UNDER MY DIRECT SUPERVISION AT THE INSTANCE OF PHILIP J. COHEN AND THE CITY OF LAS VEGAS, THAT THE SURVEY WAS COMPLETED ON JAN. 14, 1978, AND THAT THE POINTS FOUND AND SET ARE CORRECTLY SHOWN HEREON. THIS MAP DOES NOT CONSTITUTE A SUBDIVISION AS DEFINED BY NEVADA STATE LAW.

8/8/79
DATE

Jerry E. Barnson
JERRY E. BARNSON, R.L.S.
NEV. CERT. NO. 4040



LEGAL DESCRIPTION

That portion of the West Half (W $\frac{1}{2}$) of the West Half (W $\frac{1}{2}$) of the Southeast Quarter (SE $\frac{1}{4}$) of Section 24, T. 20 S., R. 60 E., M.D.M., Clark County, Nevada, described as follows:

COMMENCING at the Southwest Corner of said West Half (W $\frac{1}{2}$) of the West Half (W $\frac{1}{2}$) of the Southeast Quarter (SE $\frac{1}{4}$); thence N. 02° 20' 11\"/>

Containing 35.629 acres, more or less.

ANNEXED TO THE CITY OF LAS VEGAS UNDER
ORDINANCE NO. _____

BASIS OF BEARING

N 2° 20' 11\"/>

RECORD OF SURVEY

BEING A PORTION OF THE W $\frac{1}{2}$ OF THE SE $\frac{1}{4}$ OF SEC. 24, T20S, R60E, M.D.M., CLARK COUNTY, NEVADA

VTN CONSULTING ENGINEERS • PLANNERS					
2209 PARADISE ROAD, LAS VEGAS, NEVADA 89105					
(702) 735-0227					
SCALE: 1"=100'	WO. NO. 2721	DATE 8/8/79	SHEET	OF	
HORIZ:	DES.	REV.	1	1	
VERT:	CHK.	REV.			

NO. 1095346
FILED AT THE REQUEST OF
CITY OF LAS VEGAS
DATED 10-19-79 AT 2:33 P.M.
FILE 35 PAGE 2
OF SURVEYS
OFFICIAL RECORDS BOOK NO. 1136
CLARK COUNTY, NEVADA RECORDS
JOAN L. SWIFT, RECORDER
FEE: \$ DH DEPUTY DC 6