


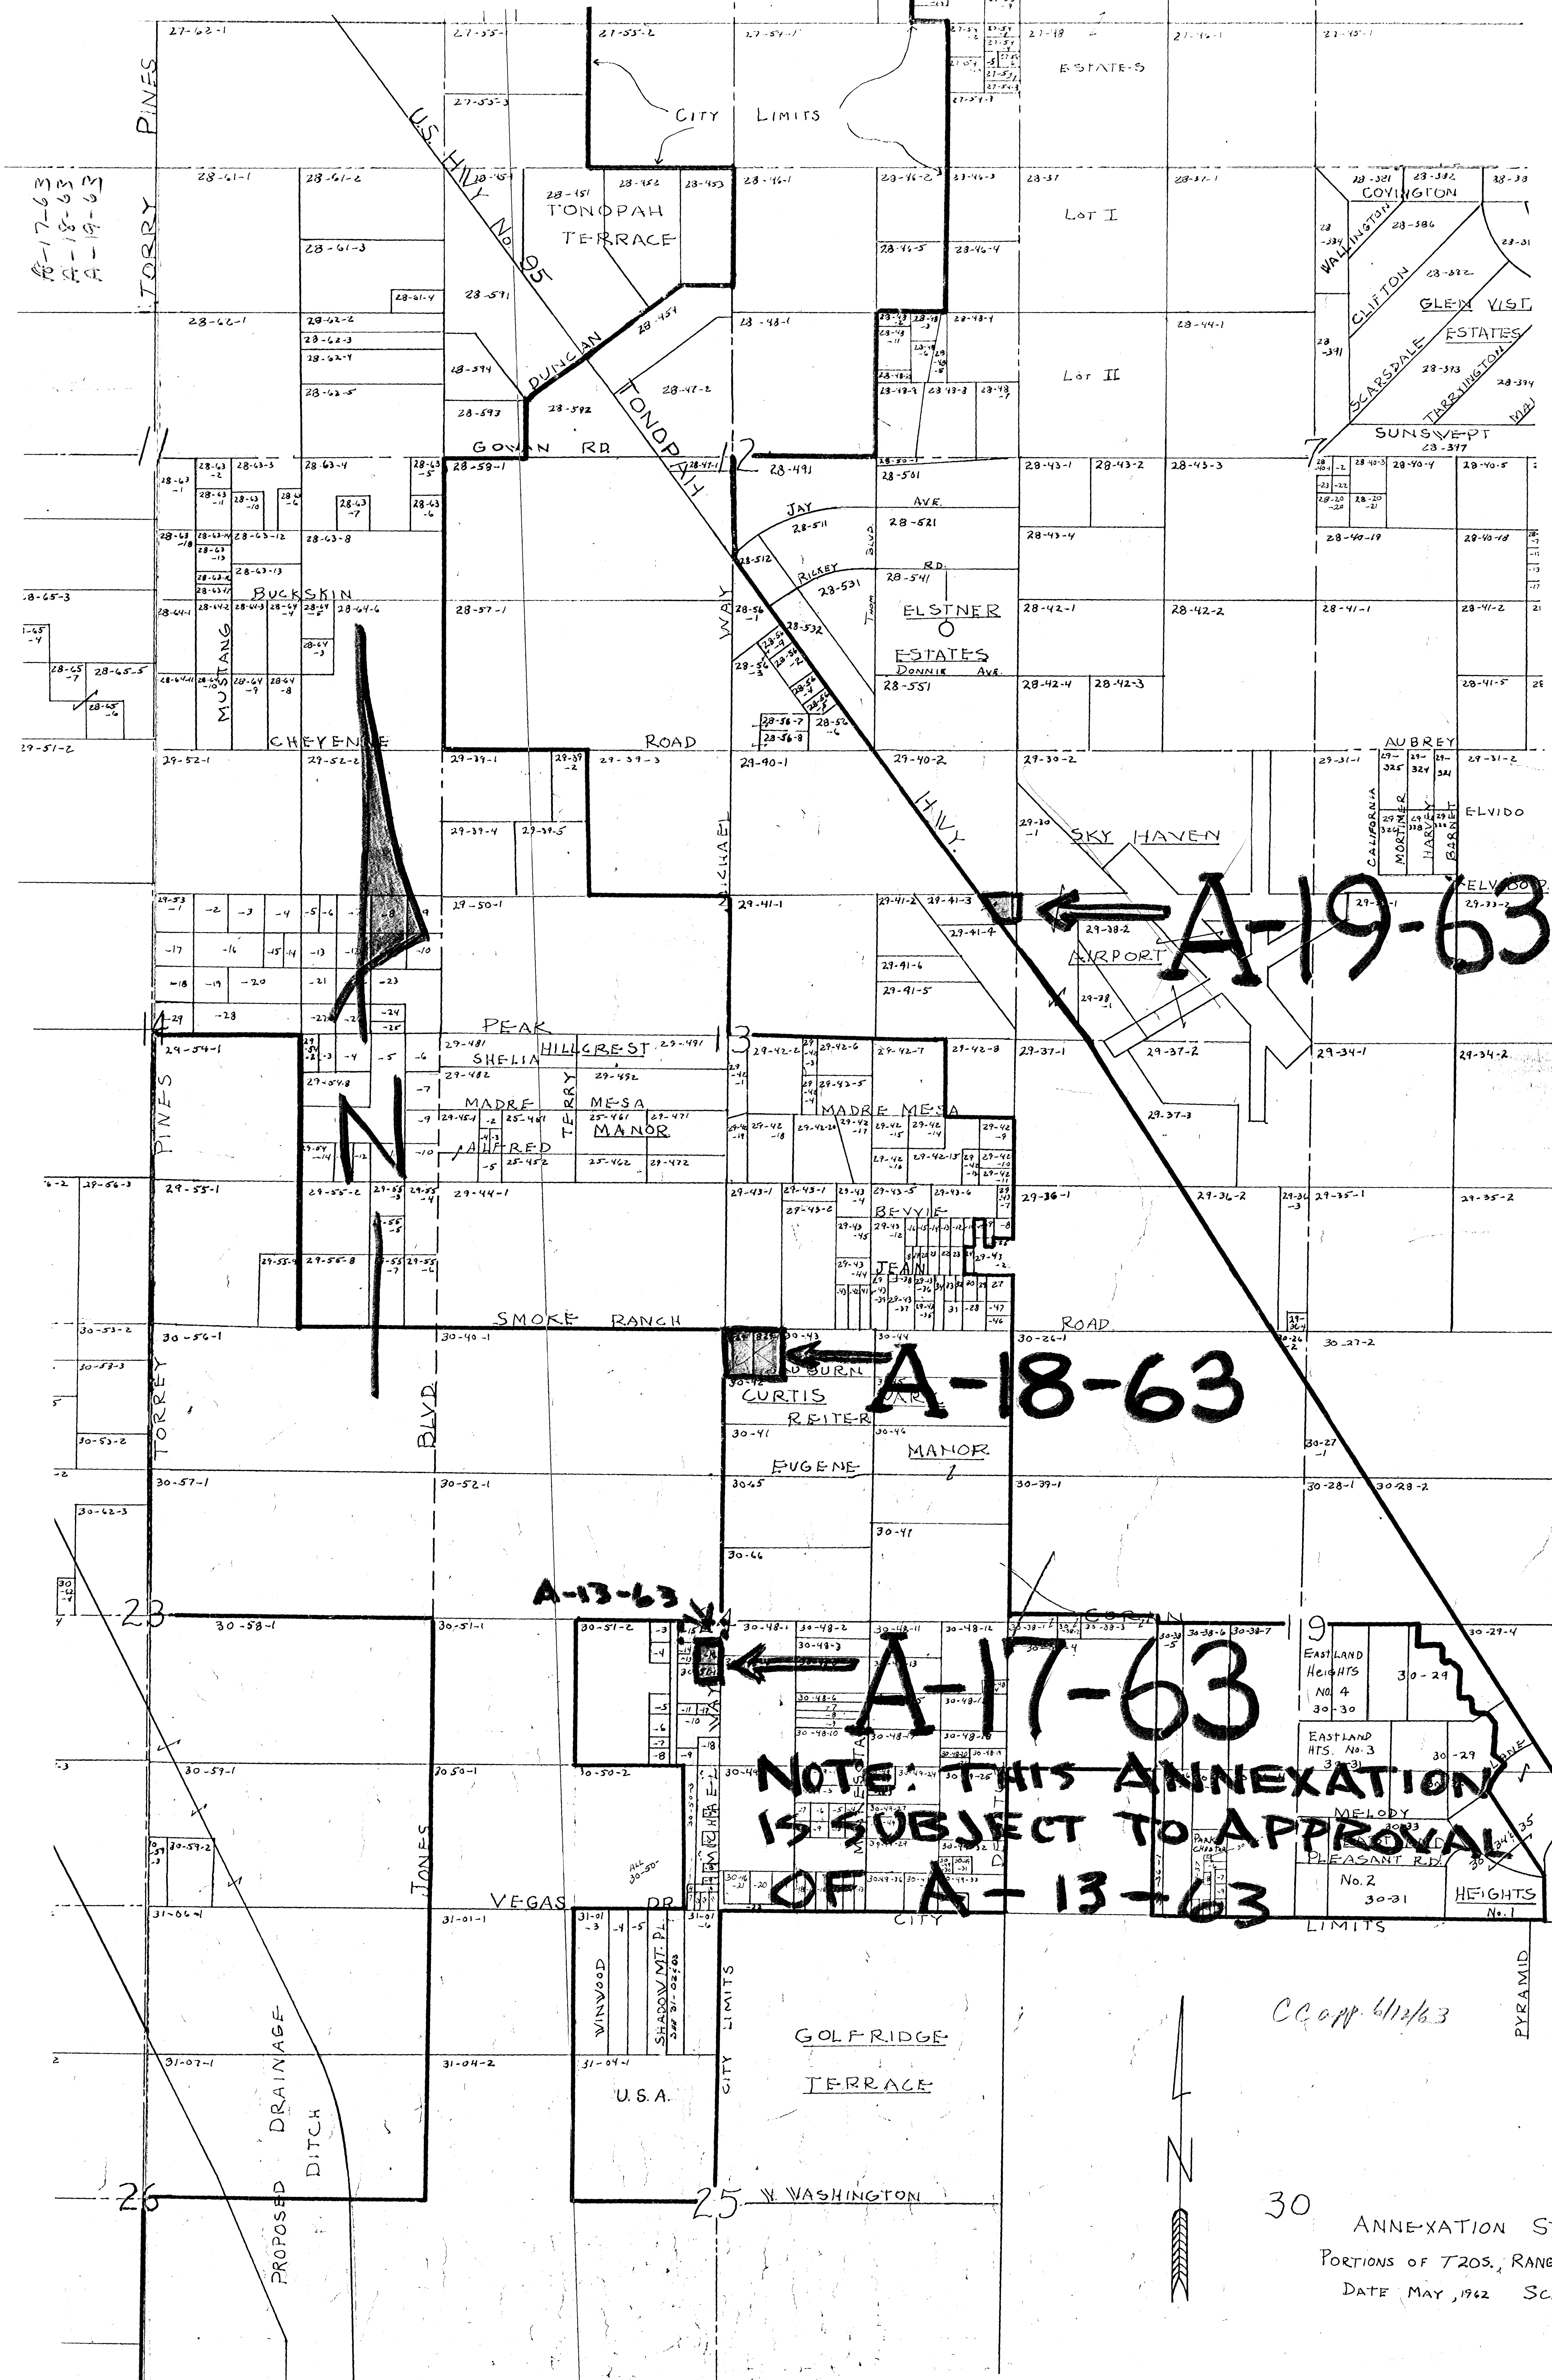

A-17-63
A-18-63
A-19-63

A-19-63

A-18-63

A-13-63

A-17-63

NOTE: THIS ANNEXATION
IS SUBJECT TO APPROVAL
OF A-13-63

CC app 6/12/63

30
ANNEXATION ST
PORTIONS OF T20S, RANGE
DATE MAY, 1962 SCA