


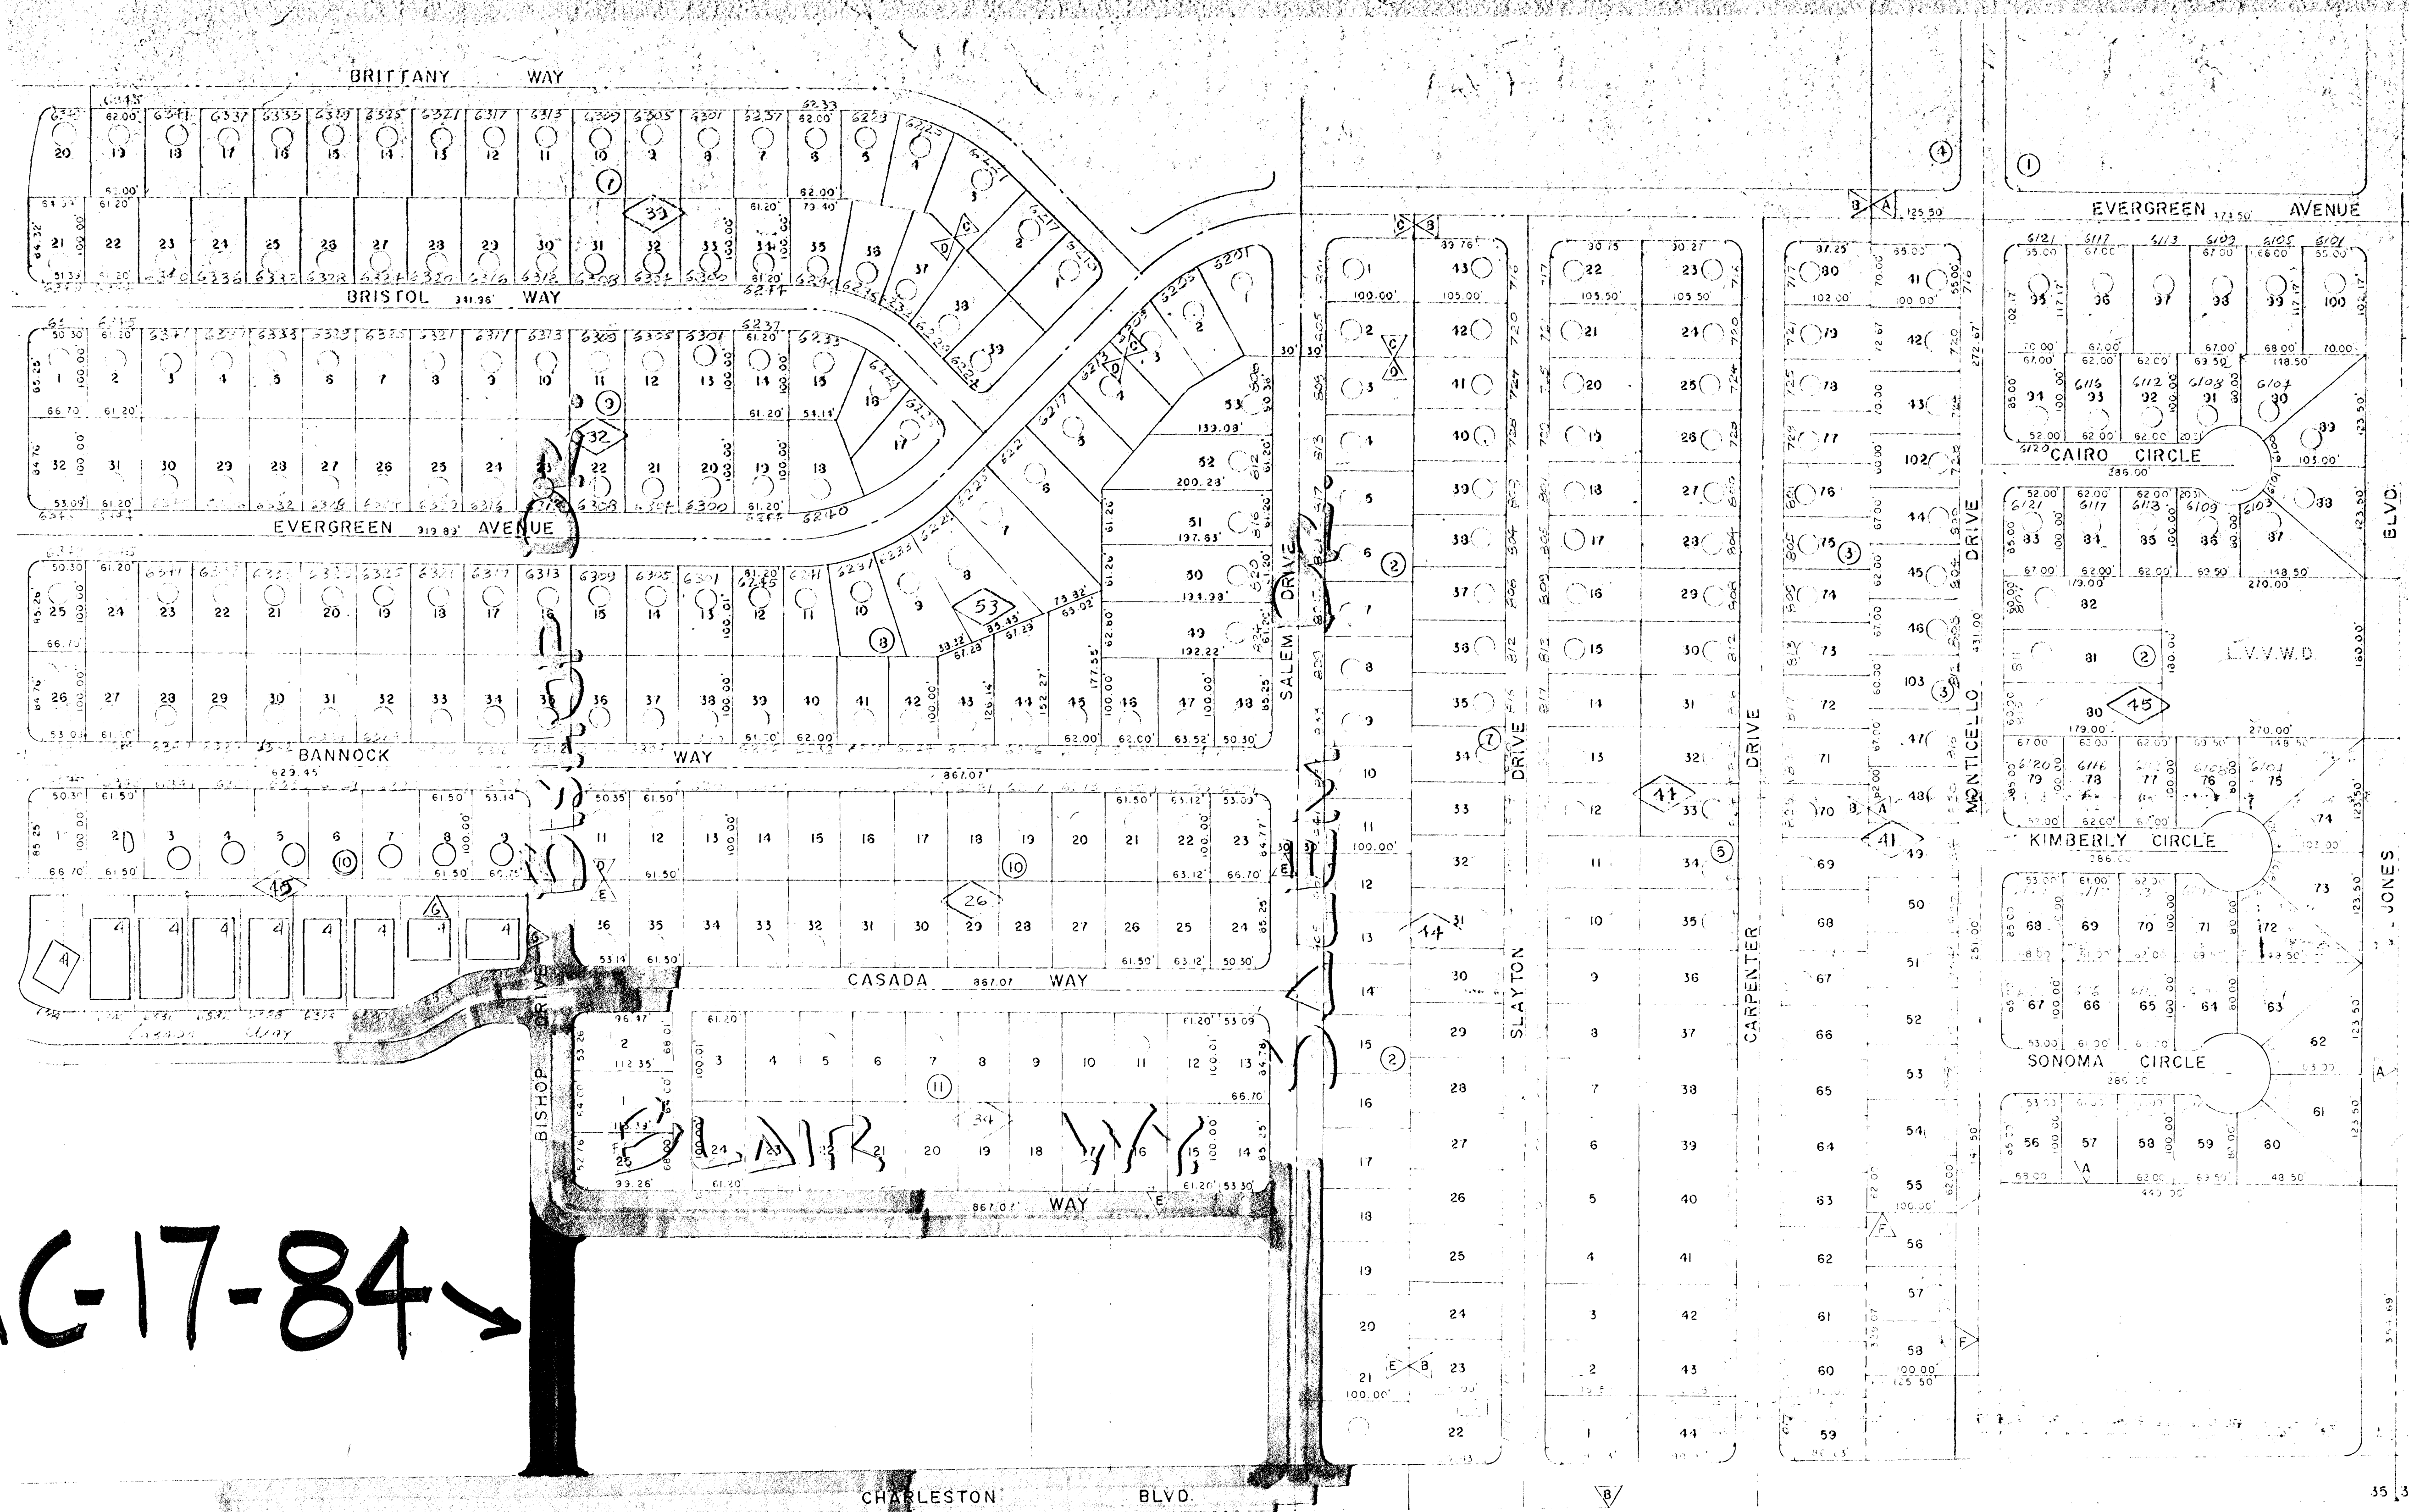

- CHARLESTON HEIGHTS NO. 12-A
- " " NO. 20-A
 - " " NO. 21
 - " " NO. 23
 - " " NO. 24
 - " " NO. 12-C
 - " " NO. 13

LAND USE STUDY
NOV 1981
M. E. TAYLOR
Feb 1972 db
APRIL 1973 JEH

CHARLESTON BLVD.

335 HOUSING UNITS
18 MULTI FAMILY UNITS

S. 1/2, S.E. 1/4, SEC 35, T 20S, R 60E.			
CITY OF LAS VEGAS NEVADA			
DEPARTMENT OF PUBLIC WORKS			
SERVICES DIVISION			
DISTRICT MAP - SHEET NO. 176			
N.O. NO.	F.B.K. NO.	DATE	DRAWING NO.
SC (H)	SC (V)		
DES.			
CR			
APPROVED BY DIRECTOR OF PUBLIC WORKS			FILE NO.
			35-8
			SHEET OF