



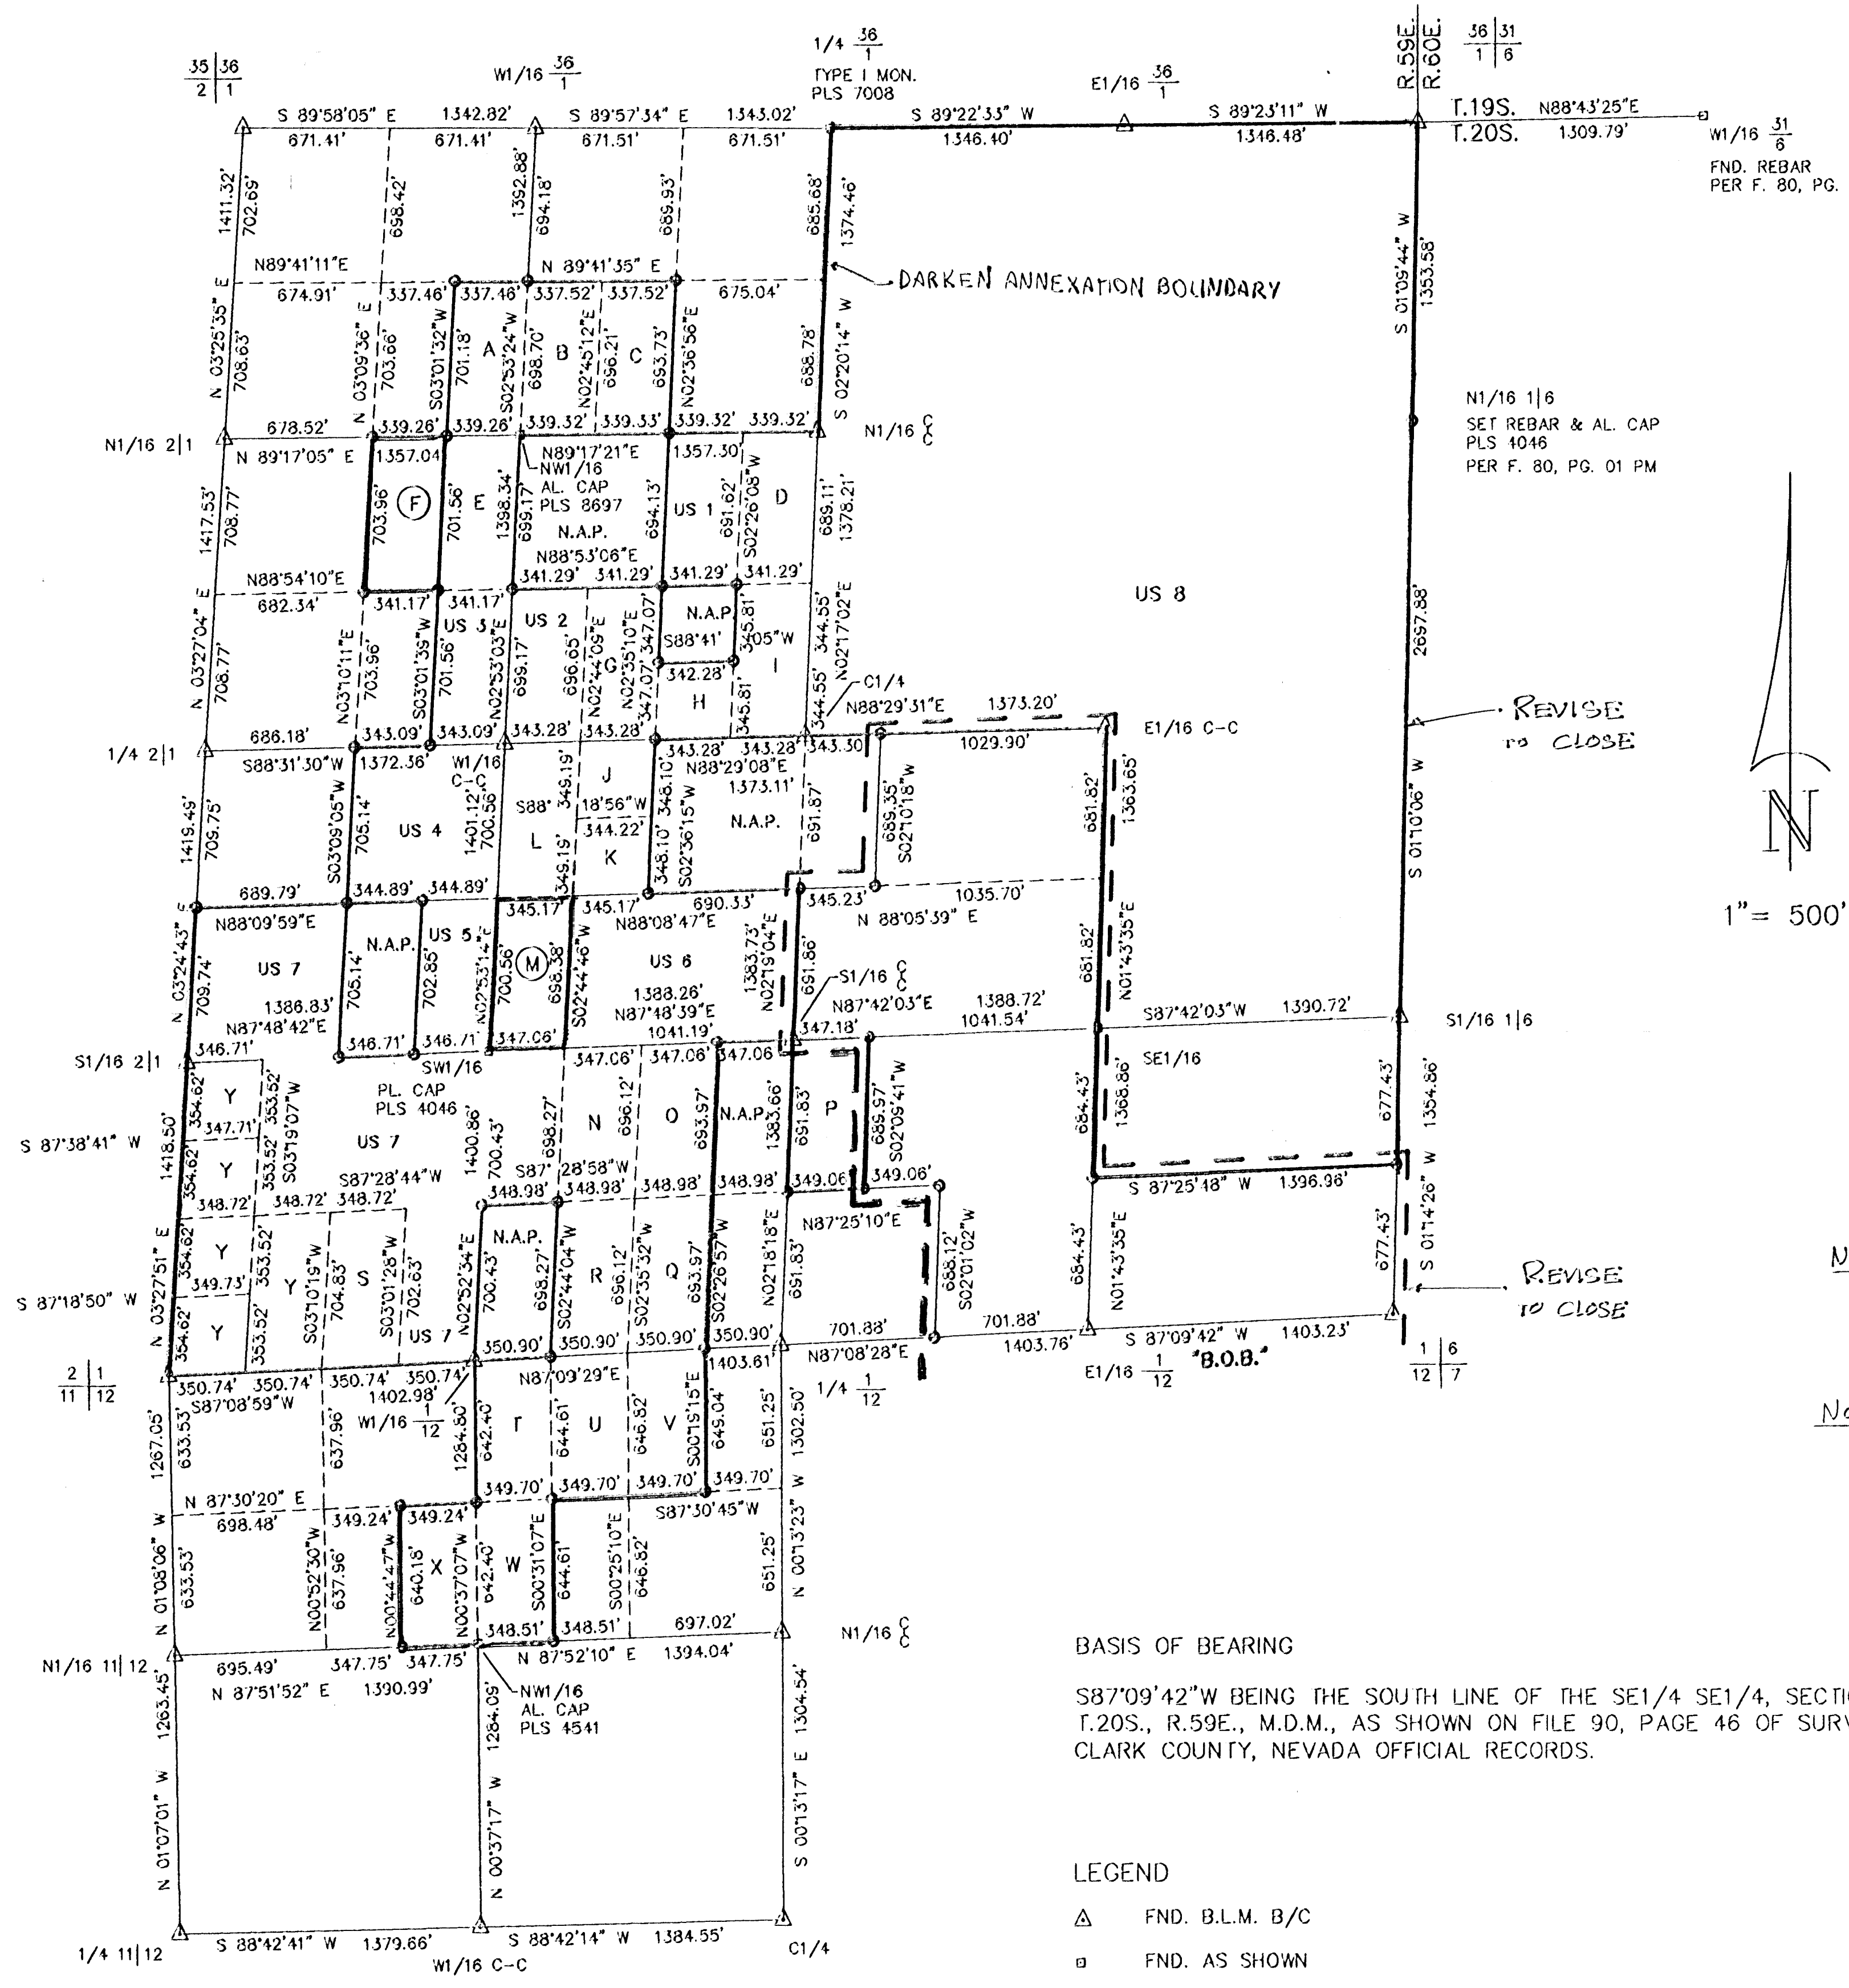

SURVEYOR'S CERTIFICATE:

- I, JERRY E. BARNSON, A PROFESSIONAL LAND SURVEYOR REGISTERED IN THE STATE OF NEVADA AS AGENT FOR "BARNSON SURVEYING, INC." CERTIFY THAT:
- THIS PLAT REPRESENTS THE RESULTS OF A SURVEY CONDUCTED UNDER MY DIRECT SUPERVISION AT THE INSTANCE OF FOCUS COMMERCIAL GROUP
 - THE LANDS SURVEYED LIE WITHIN SECTION 1, T.20S., R.59E., M.D.M. AND THE NW1/4, SECTION 12, T.20S., R.59E., M.D.M., CLARK COUNTY, NEVADA AND WAS COMPLETED ON 8/18/98
 - THIS PLAT COMPLIES WITH APPLICABLE STATE STATUTES OF THIS STATE AND ANY LOCAL ORDINANCES IN EFFECT ON THE DATE THAT THE SURVEY WAS COMPLETED, AND THE SURVEY WAS CONDUCTED IN ACCORDANCE WITH CHAPTER 625 OF THE NEVADA ADMINISTRATIVE CODE.
 - THE MONUMENTS DEPICTED ON THE PLAT ARE OF THE CHARACTER SHOWN, OCCUPY THE POSITIONS INDICATED, AND ARE OF SUFFICIENT DURABILITY.
 - THIS SURVEY IS NOT A DIVISION OF LAND AS DEFINED BY NRS. 278.010 THRU 278.630 INCLUSIVE.

Jerry E. Barnson
JERRY E. BARNSON
NEVADA P.L.S. #4046

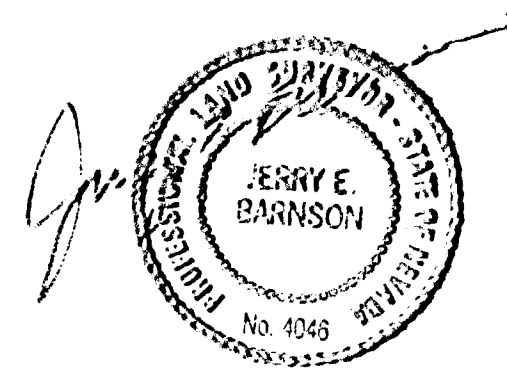

DESCRIPTIONS

SECTION 1, T.20S., R.59E., M.D.M.
U.S.A.
US 1 W1/2 NE1/4 SE1/4 NW1/4
US 2 W1/2 SW1/4 SE1/4 NW1/4
US 3 E1/2 SE1/4 SW1/4 NW 1/4
US 4 NE1/4 NW1/4 SW1/4
US 5 E1/2 SE1/4 NW1/4 SW1/4
US 6 E1/2 SW1/4 NE1/4 SW1/4
SE1/4 NE1/4 SW1/4
US 7 NE1/4 SW1/4 SW1/4
W1/2 NW1/4 SE1/4 SW1/4
E1/2 SE1/4 SW1/4 SW1/4
E1/2 NW1/4 SW1/4 SW1/4
SW1/4 NW1/4 SW1/4
US 8 NE1/4
NE1/4 SE1/4
N1/2 SE1/4 SE1/4

PRIVATE

A E1/2 SE1/4 NW1/4 NW1/4
B W1/2 SW1/4 NE1/4 NW1/4
C E1/2 SW1/4 NE1/4 NW1/4
D E1/2 NE1/4 SE1/4 NW1/4
E E1/2 NE1/4 SW1/4 NW1/4
F W1/2 NE1/4 SW1/4 NW1/4
G E1/2 SW1/4 SE1/4 NW1/4
H SW1/4 SE1/4 SE1/4 NW1/4
I E1/2 SE1/4 SE1/4 NW1/4
J N1/2 E1/2 NW1/4 NE1/4 SW1/4
K S1/2 E1/2 NW1/4 NE1/4 SW1/4
L W1/2 NW1/4 NE1/4 SW1/4
M W1/2 SW1/4 NE1/4 SW1/4
N E1/2 NW1/4 SE1/4 SW1/4
O W1/2 NE1/4 SE1/4 SW1/4
P W1/2 NW1/4 SW1/4 SE1/4
Q W1/2 SE1/4 SE1/4 SW1/4
R E1/2 SW1/4 SE1/4 SW1/4
S W1/2 SE1/4 SW1/4 SW1/4
Y NW1/4 NW1/4 SW1/4 SW1/4
SW1/4 NW1/4 SW1/4 SW1/4
NW1/4 SW1/4 SW1/4 SW1/4
SW1/4 SW1/4 SW1/4 SW1/4
E1/2 SW1/4 SW1/4 SW1/4

SECTION 12, T.20S., R.59E., M.D.M.


T W1/2 NW1/4 NE1/4 NW1/4
U E1/2 NW1/4 NE1/4 NW1/4
V W1/2 NE1/4 NE1/4 NW1/4
W W1/2 SW1/4 NE1/4 NW1/4
X E1/2 SE1/4 NW1/4 NW1/4

RECORD OF SURVEY	
ANNEXATION MAP	
PORTIONS OF SECTIONS 1 & 12, T.20S., R.59E., M.D.M.	
ANNEXED TO THE CITY OF LAS VEGAS, NEVADA	
BY ORDINANCE NO. _____	
BARNSON SURVEYING, INC.	
5160 SO. EASTERN AVE., STE. F	
LAS VEGAS, NV. 89119	
(702) 597-0041	
DATE: 8/18/98	SCALE: 1" = 500'
DRAWN BY: J.E.B.	DATE: 8/18/98
Filed at the request of: BARNSON SURVEYING, INC.	
Date: _____ at _____	File _____ Page _____
of SURVEYS	
Official Records Book # _____	
Instrument # _____	
Clark County, Nevada Records	
Judith A. Vandaver, Recorder	
Fee _____	Deputy _____

RECORDING NOTE: Any subsequent changes to this map should be examined and may be determined by reference to the County Recorder's Cumulative Map Index.

990121

00444

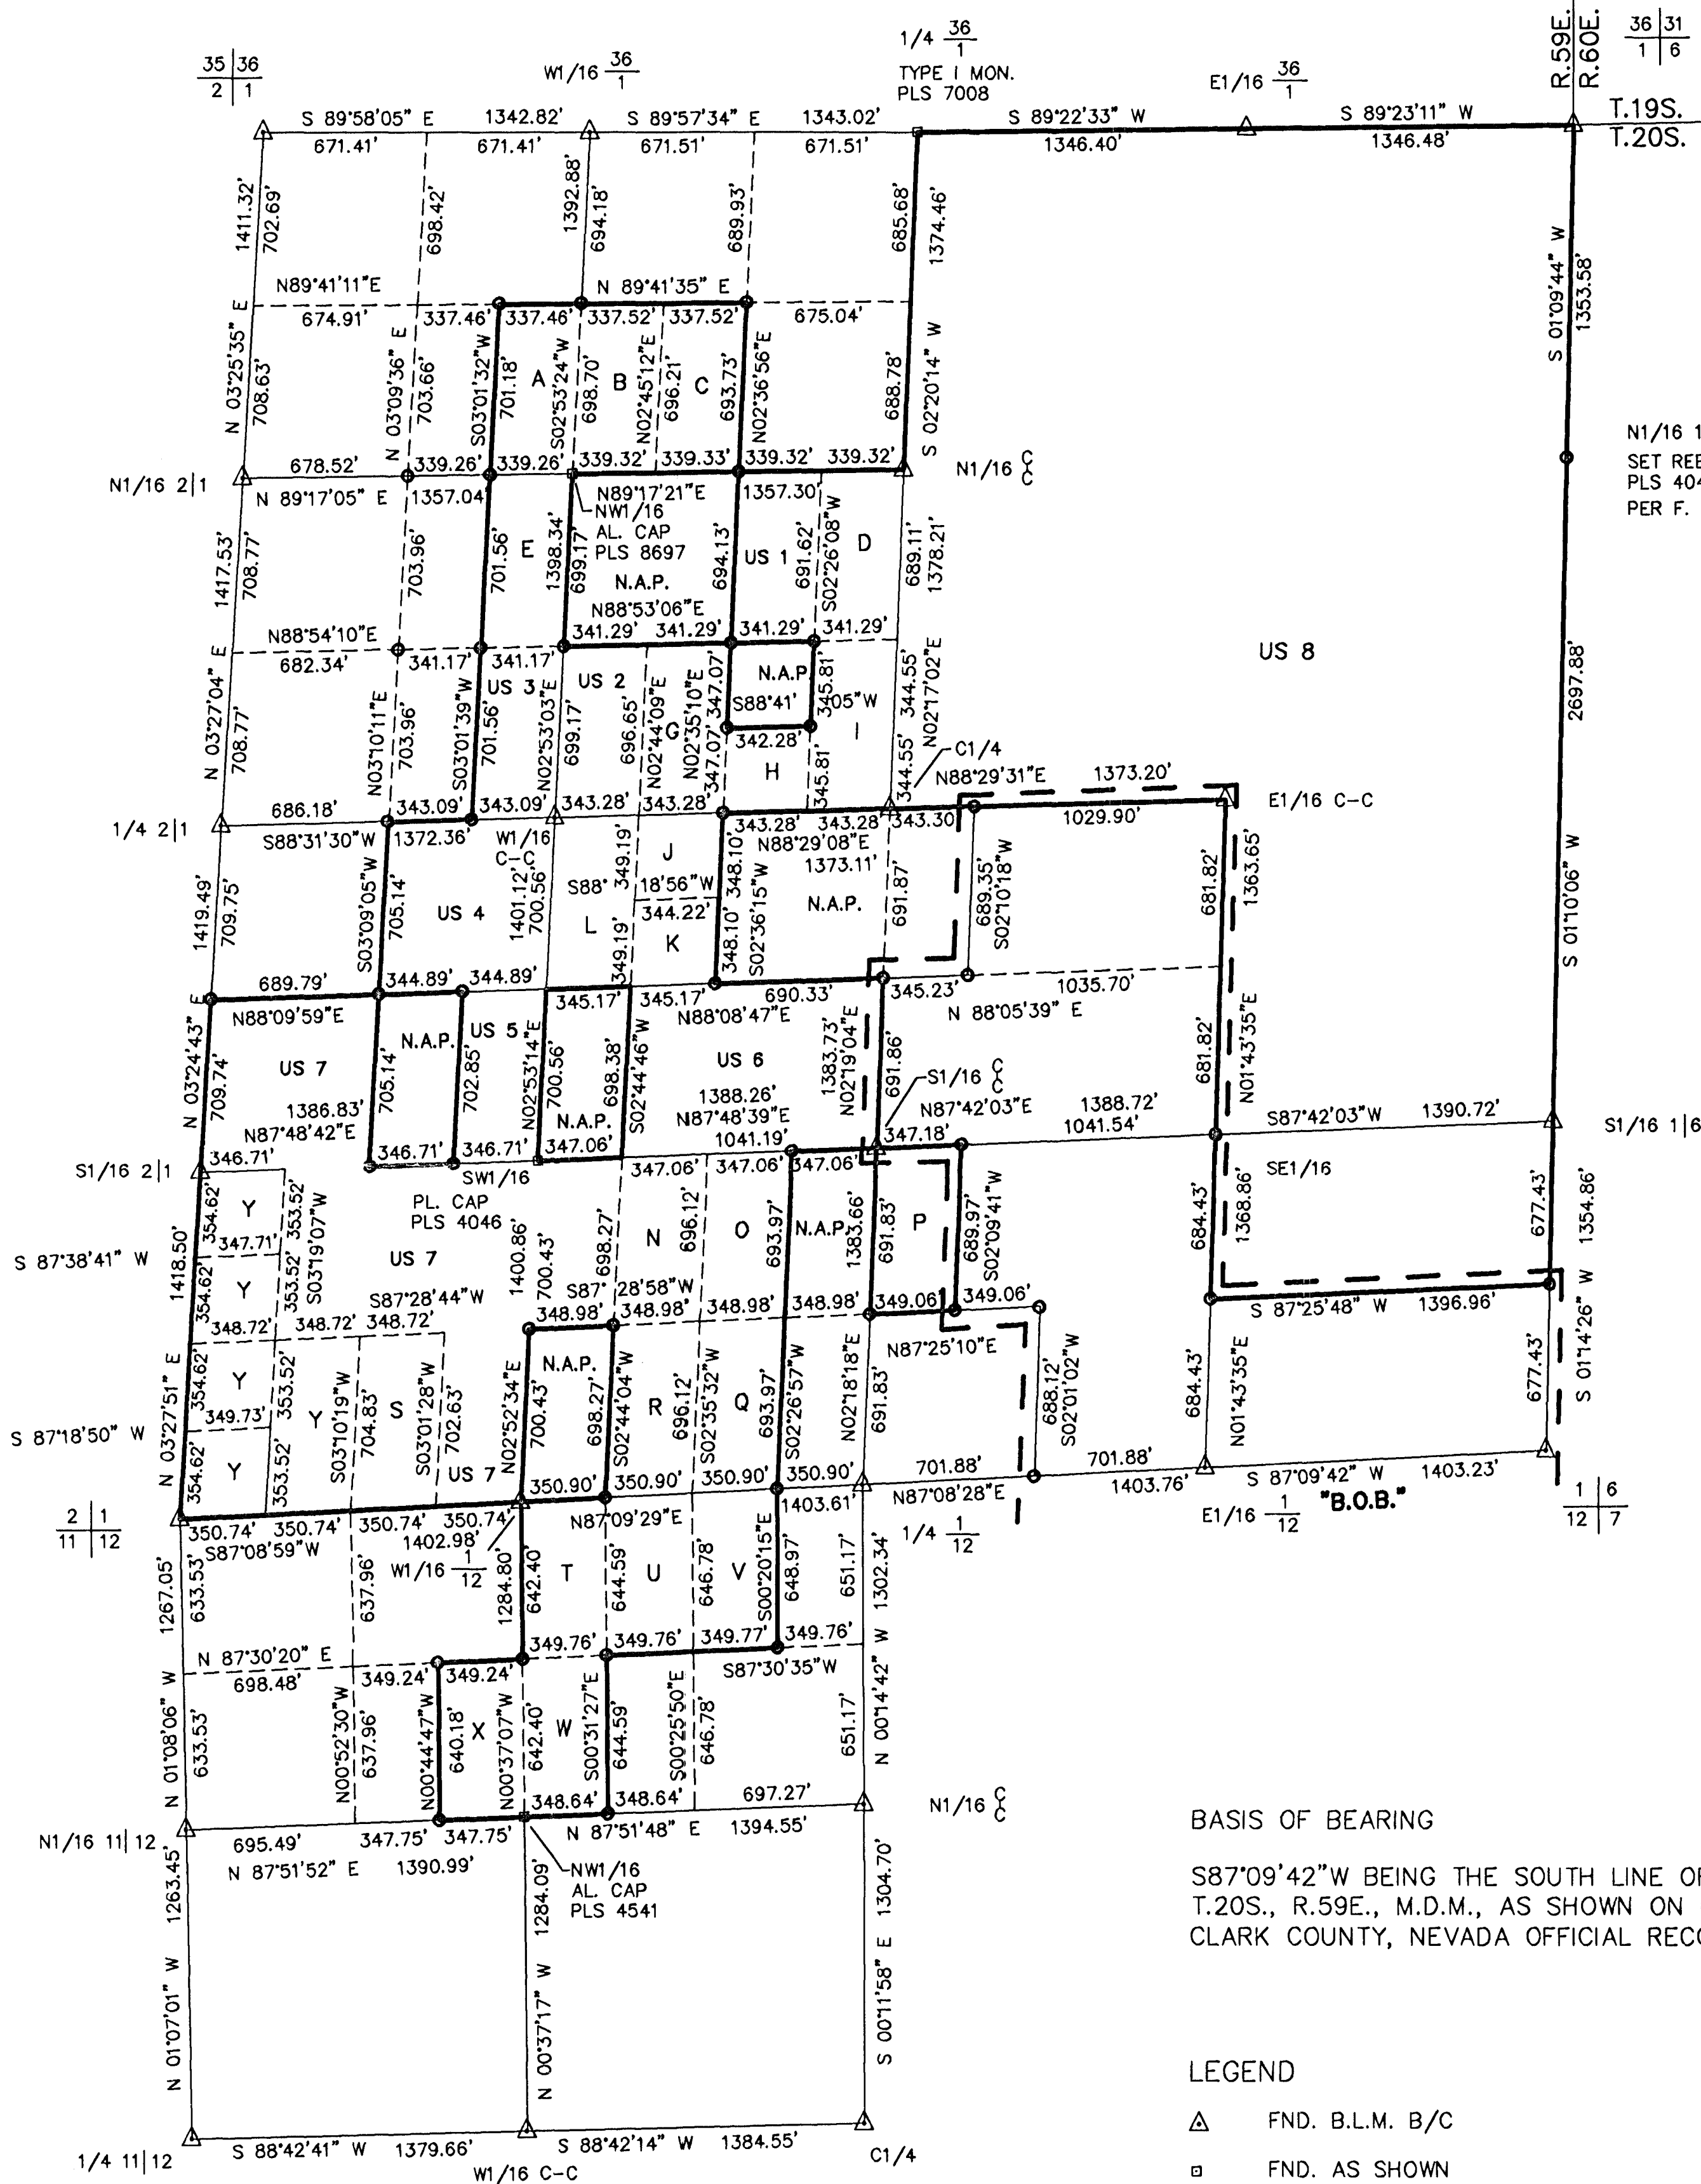

BASIS OF BEARING

S87°09'42" W BEING THE SOUTH LINE OF THE SE1/4 SE1/4, SECTION 1, T.20S., R.59E., M.D.M., AS SHOWN ON FILE 90, PAGE 46 OF SURVEYS, CLARK COUNTY, NEVADA OFFICIAL RECORDS.

LEGEND

- △ FND. B.L.M. B/C
- FND. AS SHOWN
- SET OR FOUND REBAR & CAP P.L.S. 4046

— ANNEXATION BOUNDARY

— CITY OF LAS VEGAS BOUNDARY

RECORDING NOTE: Any subsequent changes to this map should be examined and may be determined by reference to the County Recorder's Cumulative Map Index. NRS 278.5695

SURVEYOR'S CERTIFICATE:

I, JERRY E. BARNSON, A PROFESSIONAL LAND SURVEYOR REGISTERED IN THE STATE OF NEVADA AS AGENT FOR "BARNSON SURVEYING, INC." CERTIFY THAT:

- THIS PLAT REPRESENTS THE RESULTS OF A SURVEY CONDUCTED UNDER MY DIRECT SUPERVISION AT THE INSTANCE OF FOCUS COMMERCIAL GROUP
- THE LANDS SURVEYED LIE WITHIN SECTION 1, T.20S., R.59E., M.D.M. AND THE NW1/4, SECTION 12, T.20S., R.59E., M.D.M., CLARK COUNTY, NEVADA AND WAS COMPLETED ON 8/18/98
- THIS PLAT COMPLIES WITH APPLICABLE STATE STATUTES OF THIS STATE AND ANY LOCAL ORDINANCES IN EFFECT ON THE DATE THAT THE SURVEY WAS COMPLETED, AND THE SURVEY WAS CONDUCTED IN ACCORDANCE WITH CHAPTER 625 OF THE NEVADA ADMINISTRATIVE CODE.
- THE MONUMENTS DEPICTED ON THE PLAT ARE OF THE CHARACTER SHOWN, OCCUPY THE POSITIONS INDICATED, AND ARE OF SUFFICIENT DURABILITY.
- THIS SURVEY IS NOT A DIVISION OF LAND AS DEFINED BY NRS. 278.010 THRU 278.630 INCLUSIVE.

Jerry E. Barnson
JERRY E. BARNSON
NEVADA P.L.S. #4046



DESCRIPTIONS

SECTION 1, T.20S., R.59E., M.D.M.

U.S.A.

- US 1 W1/2 NE1/4 SE1/4 NW1/4
- US 2 W1/2 SW1/4 SE1/4 NW1/4
- US 3 E1/2 SE1/4 SW1/4 NW 1/4
- US 4 NE1/4 NW1/4 SW1/4
- US 5 E1/2 SE1/4 NW1/4 SW1/4
- US 6 E1/2 SW1/4 NE1/4 SW1/4
- US 7 NE1/4 SW1/4 SW1/4
- US 8 NE1/4
- NE1/4 SE1/4
- N1/2 SE1/4 SE1/4

PRIVATE

- A E1/2 SE1/4 NW1/4 NW1/4
- B W1/2 SW1/4 NE1/4 NW1/4
- C E1/2 SW1/4 NE1/4 NW1/4
- D E1/2 NE1/4 SE1/4 NW1/4
- E E1/2 NE1/4 SW1/4 NW1/4
- G E1/2 SW1/4 SE1/4 NW1/4
- H SW1/4 SE1/4 SE1/4 NW1/4
- I E1/2 SE1/4 SE1/4 NW1/4
- J N1/2 E1/2 NW1/4 NE1/4 SW1/4
- K S1/2 E1/2 NW1/4 NE1/4 SW1/4
- L W1/2 NW1/4 NE1/4 SW1/4
- N E1/2 NW1/4 SE1/4 SW1/4
- O W1/2 NE1/4 SE1/4 SW1/4
- P W1/2 NW1/4 SW1/4 SE1/4
- Q W1/2 SE1/4 SE1/4 SW1/4
- R E1/2 SW1/4 SE1/4 SW1/4
- S W1/2 SE1/4 SW1/4 SW1/4
- Y NW1/4 NW1/4 SW1/4 SW1/4
- SW1/4 NW1/4 SW1/4 SW1/4
- NW1/4 SW1/4 SW1/4 SW1/4
- SW1/4 SW1/4 SW1/4 SW1/4
- E1/2 SW1/4 SW1/4 SW1/4

SECTION 12, T.20S., R.59E., M.D.M.

- T W1/2 NW1/4 NE1/4 NW1/4
- U E1/2 NW1/4 NE1/4 NW1/4
- V W1/2 NE1/4 NE1/4 NW1/4
- W W1/2 SW1/4 NE1/4 NW1/4
- X E1/2 SE1/4 NW1/4 NW1/4

RECORD OF SURVEY

ANNEXATION MAP
PORTIONS OF SECTIONS 1 & 12, T.20S., R.59E., M.D.M.
ANNEXED TO THE CITY OF LAS VEGAS, NEVADA
BY ORDINANCE NO. 5123

BARNSON SURVEYING, INC.
5160 SO. EASTERN AVE., STE. F
LAS VEGAS, NV. 89119
(702) 597-0041

DATE: 8/18/98
SCALE: 1" = 500'
DRAWN BY: J.E.B.
JOB # JB58-98

Filed at the request of:
BARNSON SURVEYING, INC.

Date: 1-21-99 at 11:50
File 99 Page 90

of 990121 SURVEYS
Official Records Book # 00944
Instrument # 00944
Clark County, Nevada Records
Judith A. Vandever, Recorder
Fee 17.00 Deputy ESP


File 99 Page 90

SURVEYOR'S CERTIFICATE:

I, JERRY E. BARNSON, A PROFESSIONAL LAND SURVEYOR REGISTERED IN THE STATE OF NEVADA AS AGENT FOR "BARNSON SURVEYING, INC". CERTIFY THAT:

1. THIS PLAT REPRESENTS THE RESULTS OF A SURVEY CONDUCTED UNDER MY DIRECT SUPERVISION AT THE INSTANCE OF FOCUS COMMERCIAL GROUP
2. THE LANDS SURVEYED LIE WITHIN SECTION 1, T.20S., R.59E., M.D.M. AND THE NW1/4, SECTION 12, T.20S., R.59E., M.D.M., CLARK COUNTY, NEVADA AND WAS COMPLETED ON 8/18/98
3. THIS PLAT COMPLIES WITH APPLICABLE STATE STATUTES OF THIS STATE AND ANY LOCAL ORDINANCES IN EFFECT ON THE DATE THAT THE SURVEY WAS COMPLETED, AND THE SURVEY WAS CONDUCTED IN ACCORDANCE WITH CHAPTER 625 OF THE NEVADA ADMINISTRATIVE CODE.
4. THE MONUMENTS DEPICTED ON THE PLAT ARE OF THE CHARACTER SHOWN, OCCUPY THE POSITIONS INDICATED, AND ARE OF SUFFICIENT DURABILITY.
5. THIS SURVEY IS NOT A DIVISION OF LAND AS DEFINED BY NRS. 278.010 THRU 278.630 INCLUSIVE.

Jerry E. Barnson
JERRY E. BARNSON
NEVADA P.L.S. #4046

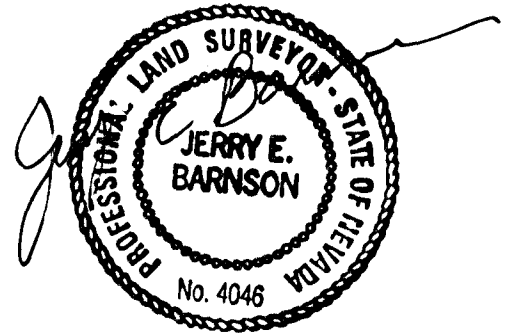

DESCRIPTIONS

SECTION 1, T.20S., R.59E., M.D.M.

U.S.A.

- US 1 W1/2 NE1/4 SE1/4 NW1/4
US 2 W1/2 SW1/4 SE1/4 NW1/4
US 3 E1/2 SE1/4 SW1/4 NW 1/4
US 4 NE1/4 NW1/4 SW1/4
US 5 E1/2 SE1/4 NW1/4 SW1/4
US 6 E1/2 SW1/4 NE1/4 SW1/4
SE1/4 NE1/4 SW1/4
US 7 NE1/4 SW1/4 SW1/4
W1/2 NW1/4 SE1/4 SW1/4
E1/2 SE1/4 SW1/4 SW1/4
E1/2 NW1/4 SW1/4 SW1/4
SW1/4 NW1/4 SW1/4
US 8 NE1/4
NE1/4 SE1/4
N1/2 SE1/4 SE1/4

PRIVATE

- A E1/2 SE1/4 NW1/4 NW1/4
B W1/2 SW1/4 NE1/4 NW1/4
C E1/2 SW1/4 NE1/4 NW1/4
D E1/2 NE1/4 SE1/4 NW1/4
E E1/2 NE1/4 SW1/4 NW1/4

G E1/2 SW1/4 SE1/4 NW1/4
H SW1/4 SE1/4 SE1/4 NW1/4
I E1/2 SE1/4 SE1/4 NW1/4
J N1/2 E1/2 NW1/4 NE1/4 SW1/4
K S1/2 E1/2 NW1/4 NE1/4 SW1/4
L W1/2 NW1/4 NE1/4 SW1/4

N E1/2 NW1/4 SE1/4 SW1/4
O W1/2 NE1/4 SE1/4 SW1/4
P W1/2 NW1/4 SW1/4 SE1/4
Q W1/2 SE1/4 SE1/4 SW1/4
R E1/2 SW1/4 SE1/4 SW1/4
S W1/2 SE1/4 SW1/4 SW1/4
Y NW1/4 NW1/4 SW1/4 SW1/4
SW1/4 NW1/4 SW1/4 SW1/4
NW1/4 SW1/4 SW1/4 SW1/4
SW1/4 SW1/4 SW1/4 SW1/4
E1/2 SW1/4 SW1/4 SW1/4

SECTION 12, T.20S., R.59E., M.D.M.

- T W1/2 NW1/4 NE1/4 NW1/4
U E1/2 NW1/4 NE1/4 NW1/4
V W1/2 NE1/4 NE1/4 NW1/4
W W1/2 SW1/4 NE1/4 NW1/4
X E1/2 SE1/4 NW1/4 NW1/4

RECORD OF SURVEY

ANNEXATION MAP
PORTIONS OF SECTIONS 1 & 12, T.20S., R.59E., M.D.M.
ANNEXED TO THE CITY OF LAS VEGAS, NEVADA
BY ORDINANCE NO. 5123

BARNSON SURVEYING, INC.
5160 SO. EASTERN AVE., STE. F
LAS VEGAS, NV. 89119
(702) 597-0041

DATE: 8/18/98
SCALE: 1"= 500'
DRAWN BY: J.E.B.
JOB # JB58-98

Filed at the request of:
BARNSON SURVEYING, INC.

Date: 1-21-99 at 11:50

File 99 Page 90


of SURVEYS

Official Records Book # 990121

Instrument # 00946

Clark County, Nevada Records
Judith A. Vandever, Recorder

Fee 17.00 Deputy ESP

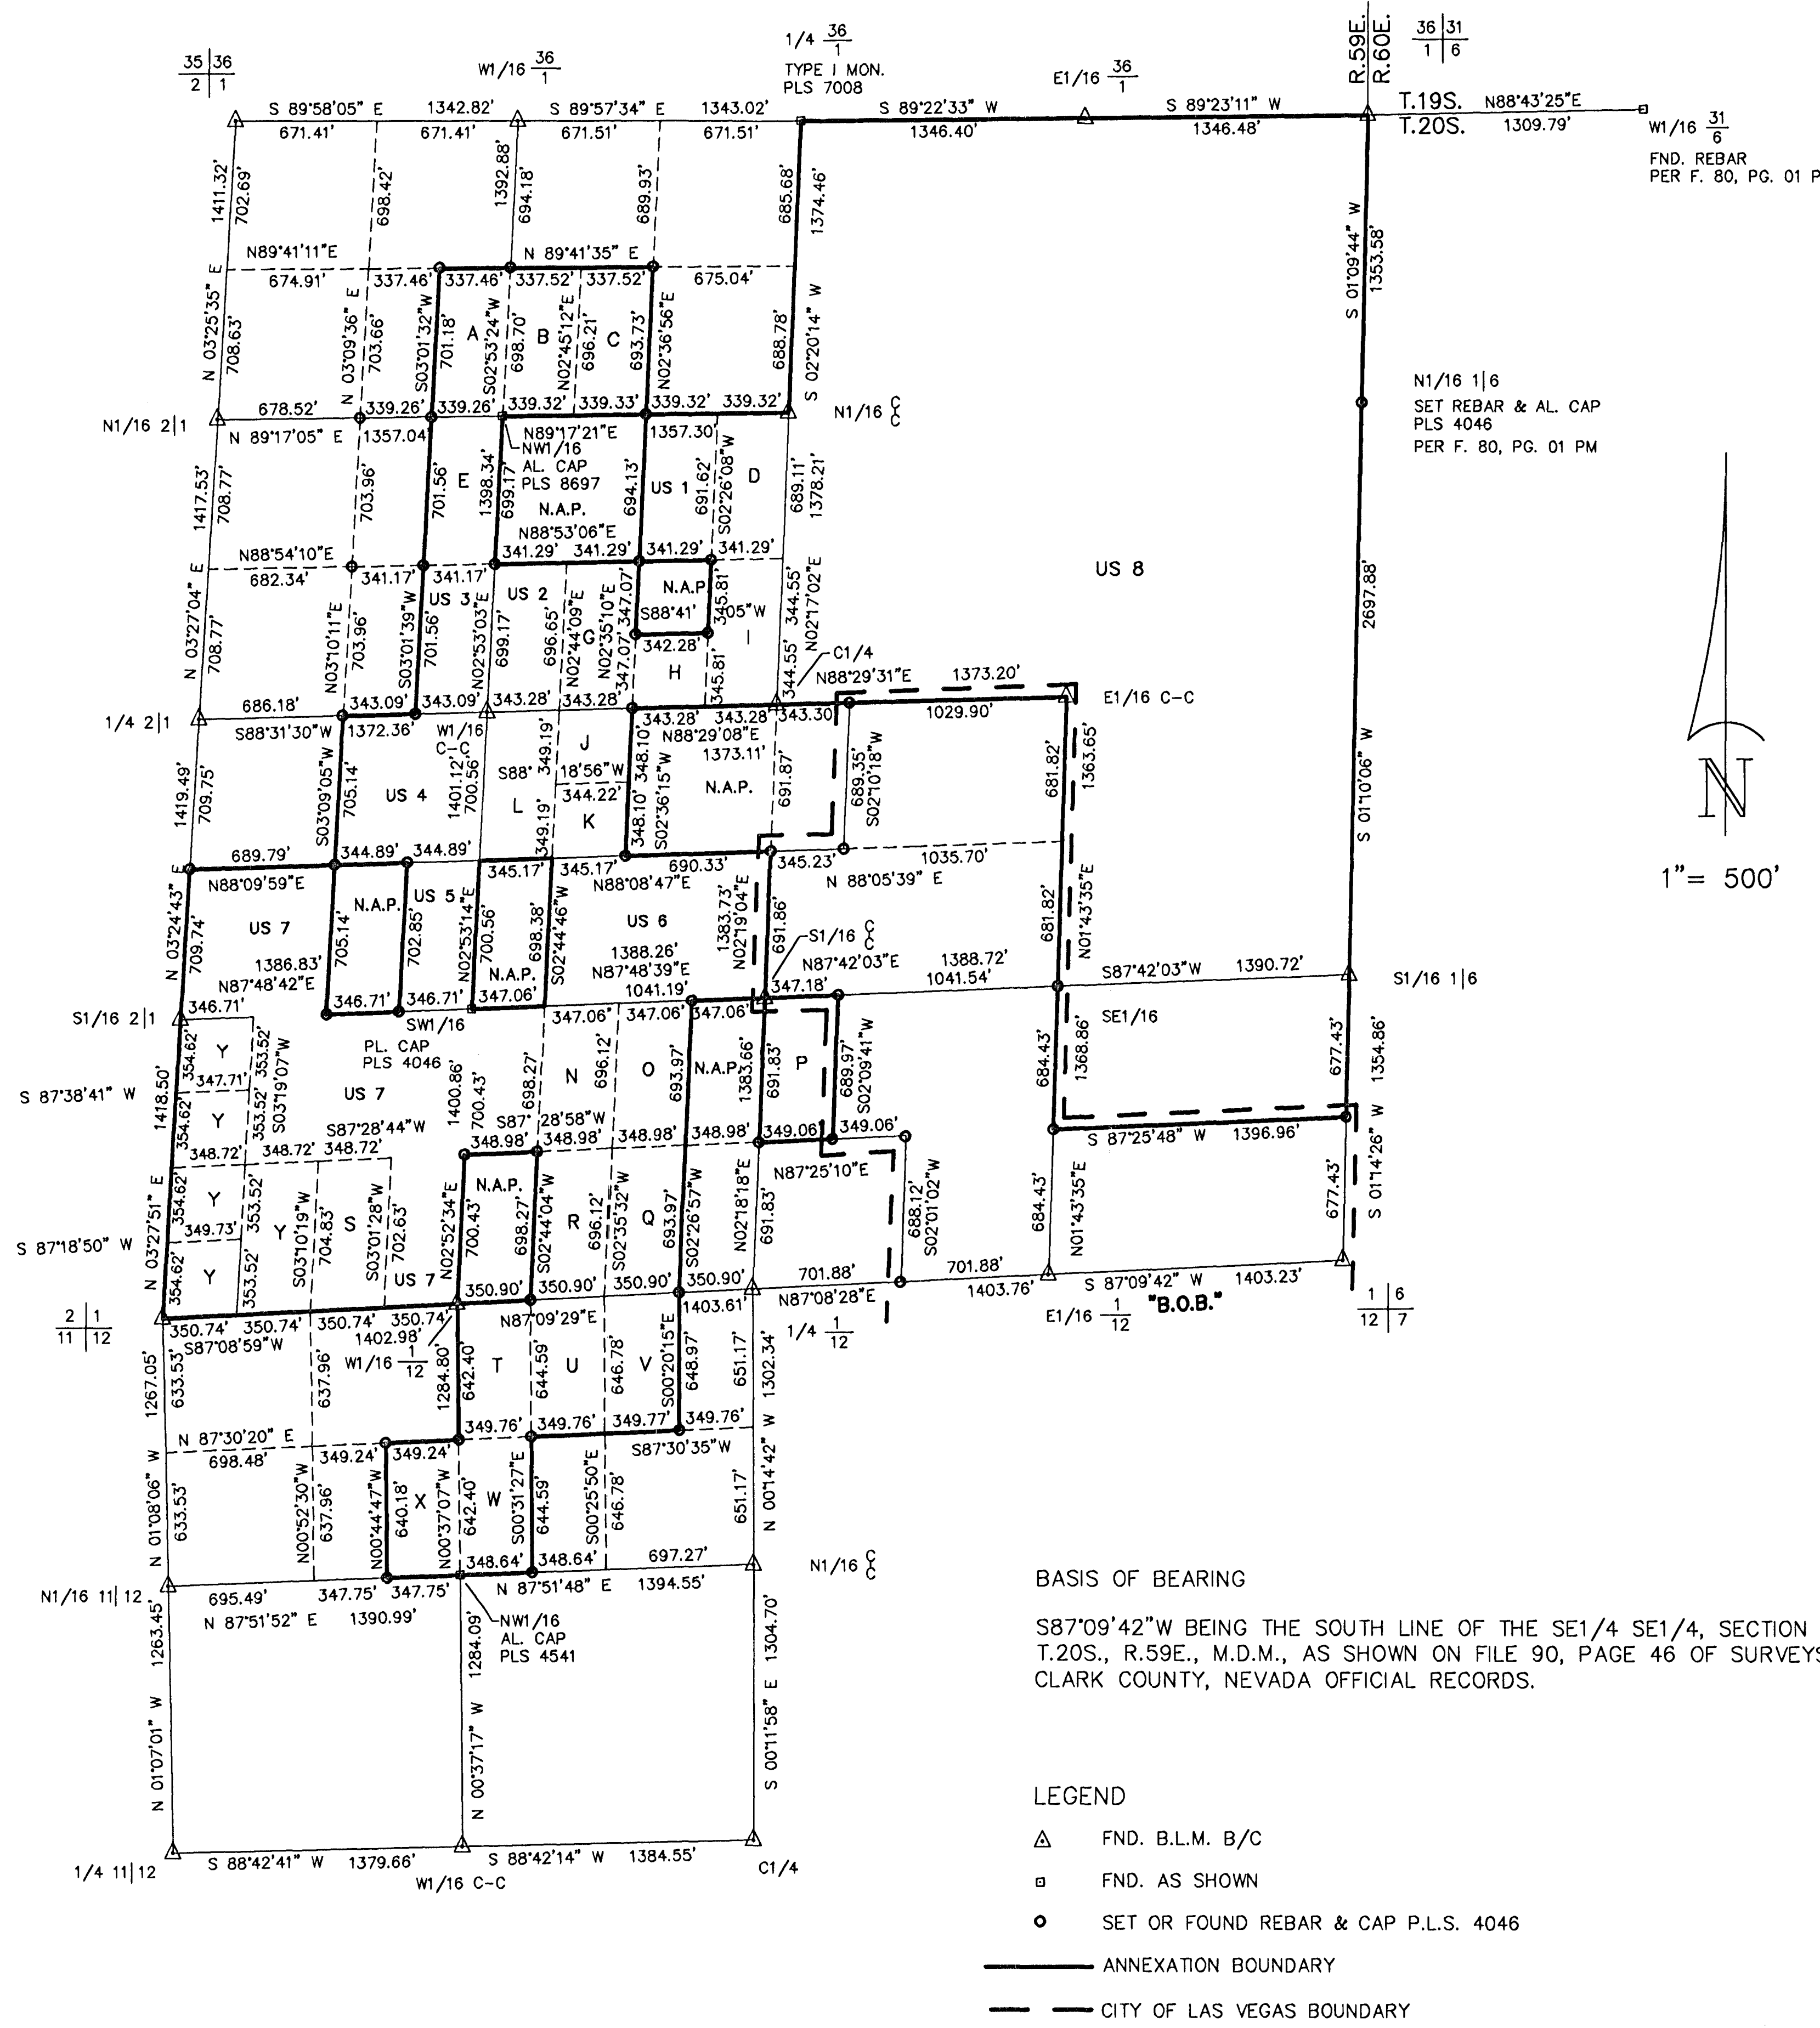

File 99 Page 90