

SURVEYOR'S CERTIFICATE

Key L. Adamo

BASIS OF BEARING

[illegible]

LEGEND

- MON. FND. AS SHOWN
- SET STD. CONC. MON. W/BC
- SET 5/8" REBAR #AL CAP #2050

CTR 1/4-SECT 23, T20S, R60E.
FND. CLV MON. 33' N 22' E.
FND. 5/8" REBAR AT CAP AT
INTERSECTION

1/4 COR 23 1/24
END CLV CONC
MON. & B.C


12-12-19 2:38 PM
35 35


1160

5.00
BV 3

2049.

FILE 35 PAGE 25


053-216 A-21-79(A)

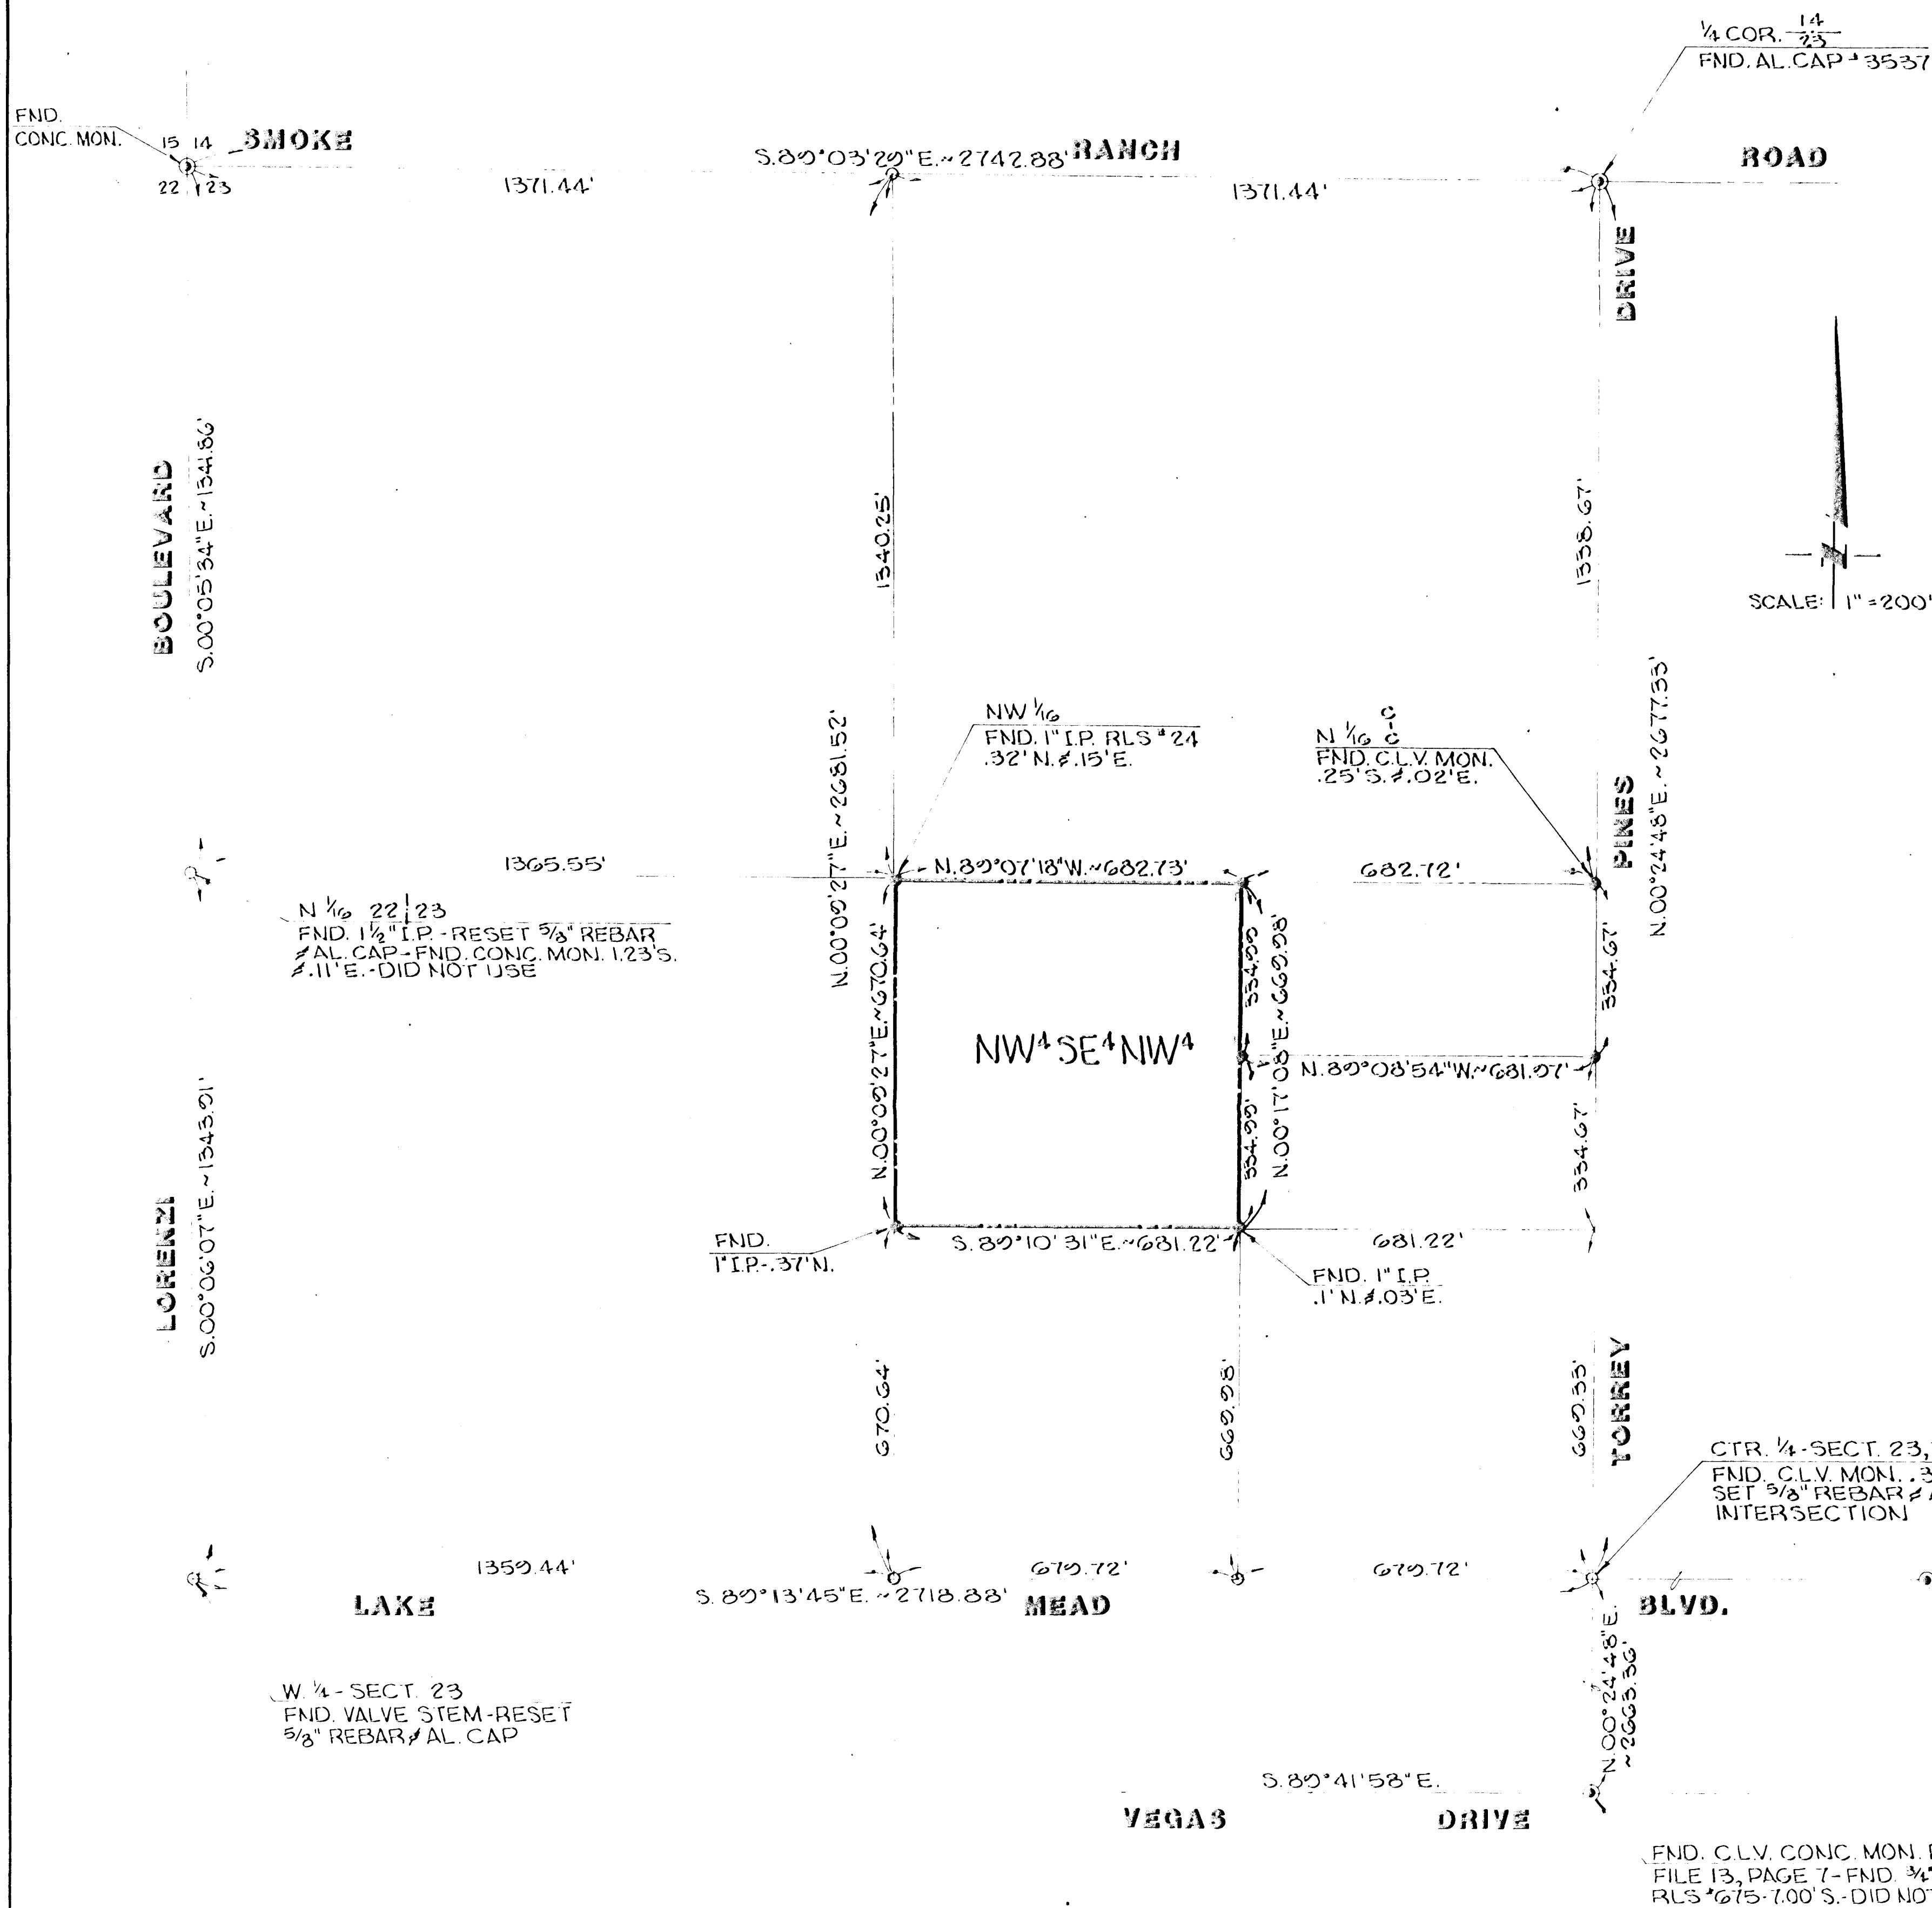

SURVEYOR'S CERTIFICATE

I, KAY L. ADAMS, A DULY REGISTERED LAND SURVEYOR, DO HEREBY CERTIFY THAT THIS MAP TRULY AND CORRECTLY REPRESENTS THE RESULTS OF A SURVEY MADE UNDER MY SUPERVISION AND COMPLETED ON THE 26th DAY OF Sept., 1979, OF AND FOR VERTEX, INC. THIS SURVEY IS NOT A SUBDIVISION AS DEFINED BY NEVADA STATE LAWS.

Kay L. Adams
KAY L. ADAMS, REGISTERED LAND SURVEYOR, NO. 2050

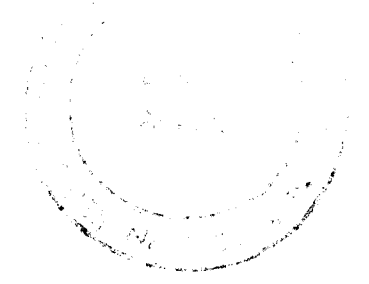

SCALE: 1" = 200'

BA313 OF BEARING

NORTH 00°24'48" EAST, BEING THE BEARING OF THE EAST LINE OF THE SOUTHWEST QUARTER (SW 1/4) OF SECTION 23, TOWNSHIP 20 SOUTH, RANGE 60 EAST, M.D.M., AS SHOWN BY A MAP ON FILE IN THE CLARK COUNTY, NEVADA, RECORDER'S OFFICE AS BOOK 23, PAGE 99 OF PLATS.

LEGEND

- MON. FND. AS SHOWN
- SET STD. CONC. MON. W/B.C.
- SET 5/8" REBAR #AL. CAP #2050

LEGAL DESCRIPTION

BEING THE NORTHWEST QUARTER (NW 1/4) OF THE SOUTHEAST QUARTER (SE 1/4) OF THE NORTHWEST QUARTER (NW 1/4) OF SECTION 23, TOWNSHIP 20 SOUTH, RANGE 60 EAST, M.D.M., CLARK COUNTY, NEVADA.

SAID PARCEL CONTAINS 10.4938 ACRES.

NO. _____	BOUNDARY SURVEY OF A PORTION OF THE
FILED AT THE REQUEST OF VERTEX, INC.	SOUTHEAST QUARTER OF THE NORTHWEST QUARTER
DATE _____ AT _____	OF SECTION 23
FILE _____ PAGE _____	TOWNSHIP 20 SOUTH, RANGE 60 EAST, M.D.M.
OF SURVEYS	CLARK COUNTY, NEVADA
OFFICIAL RECORDS BOOK NO. _____	ANNEXED TO THE CITY OF LAS VEGAS, NEVADA
CLARK COUNTY NEVADA, RECORDS	UNDER ORDINANCE NO. _____
JOAN SWIFT RECORDER	
FEE _____	
DEPUTY _____	