


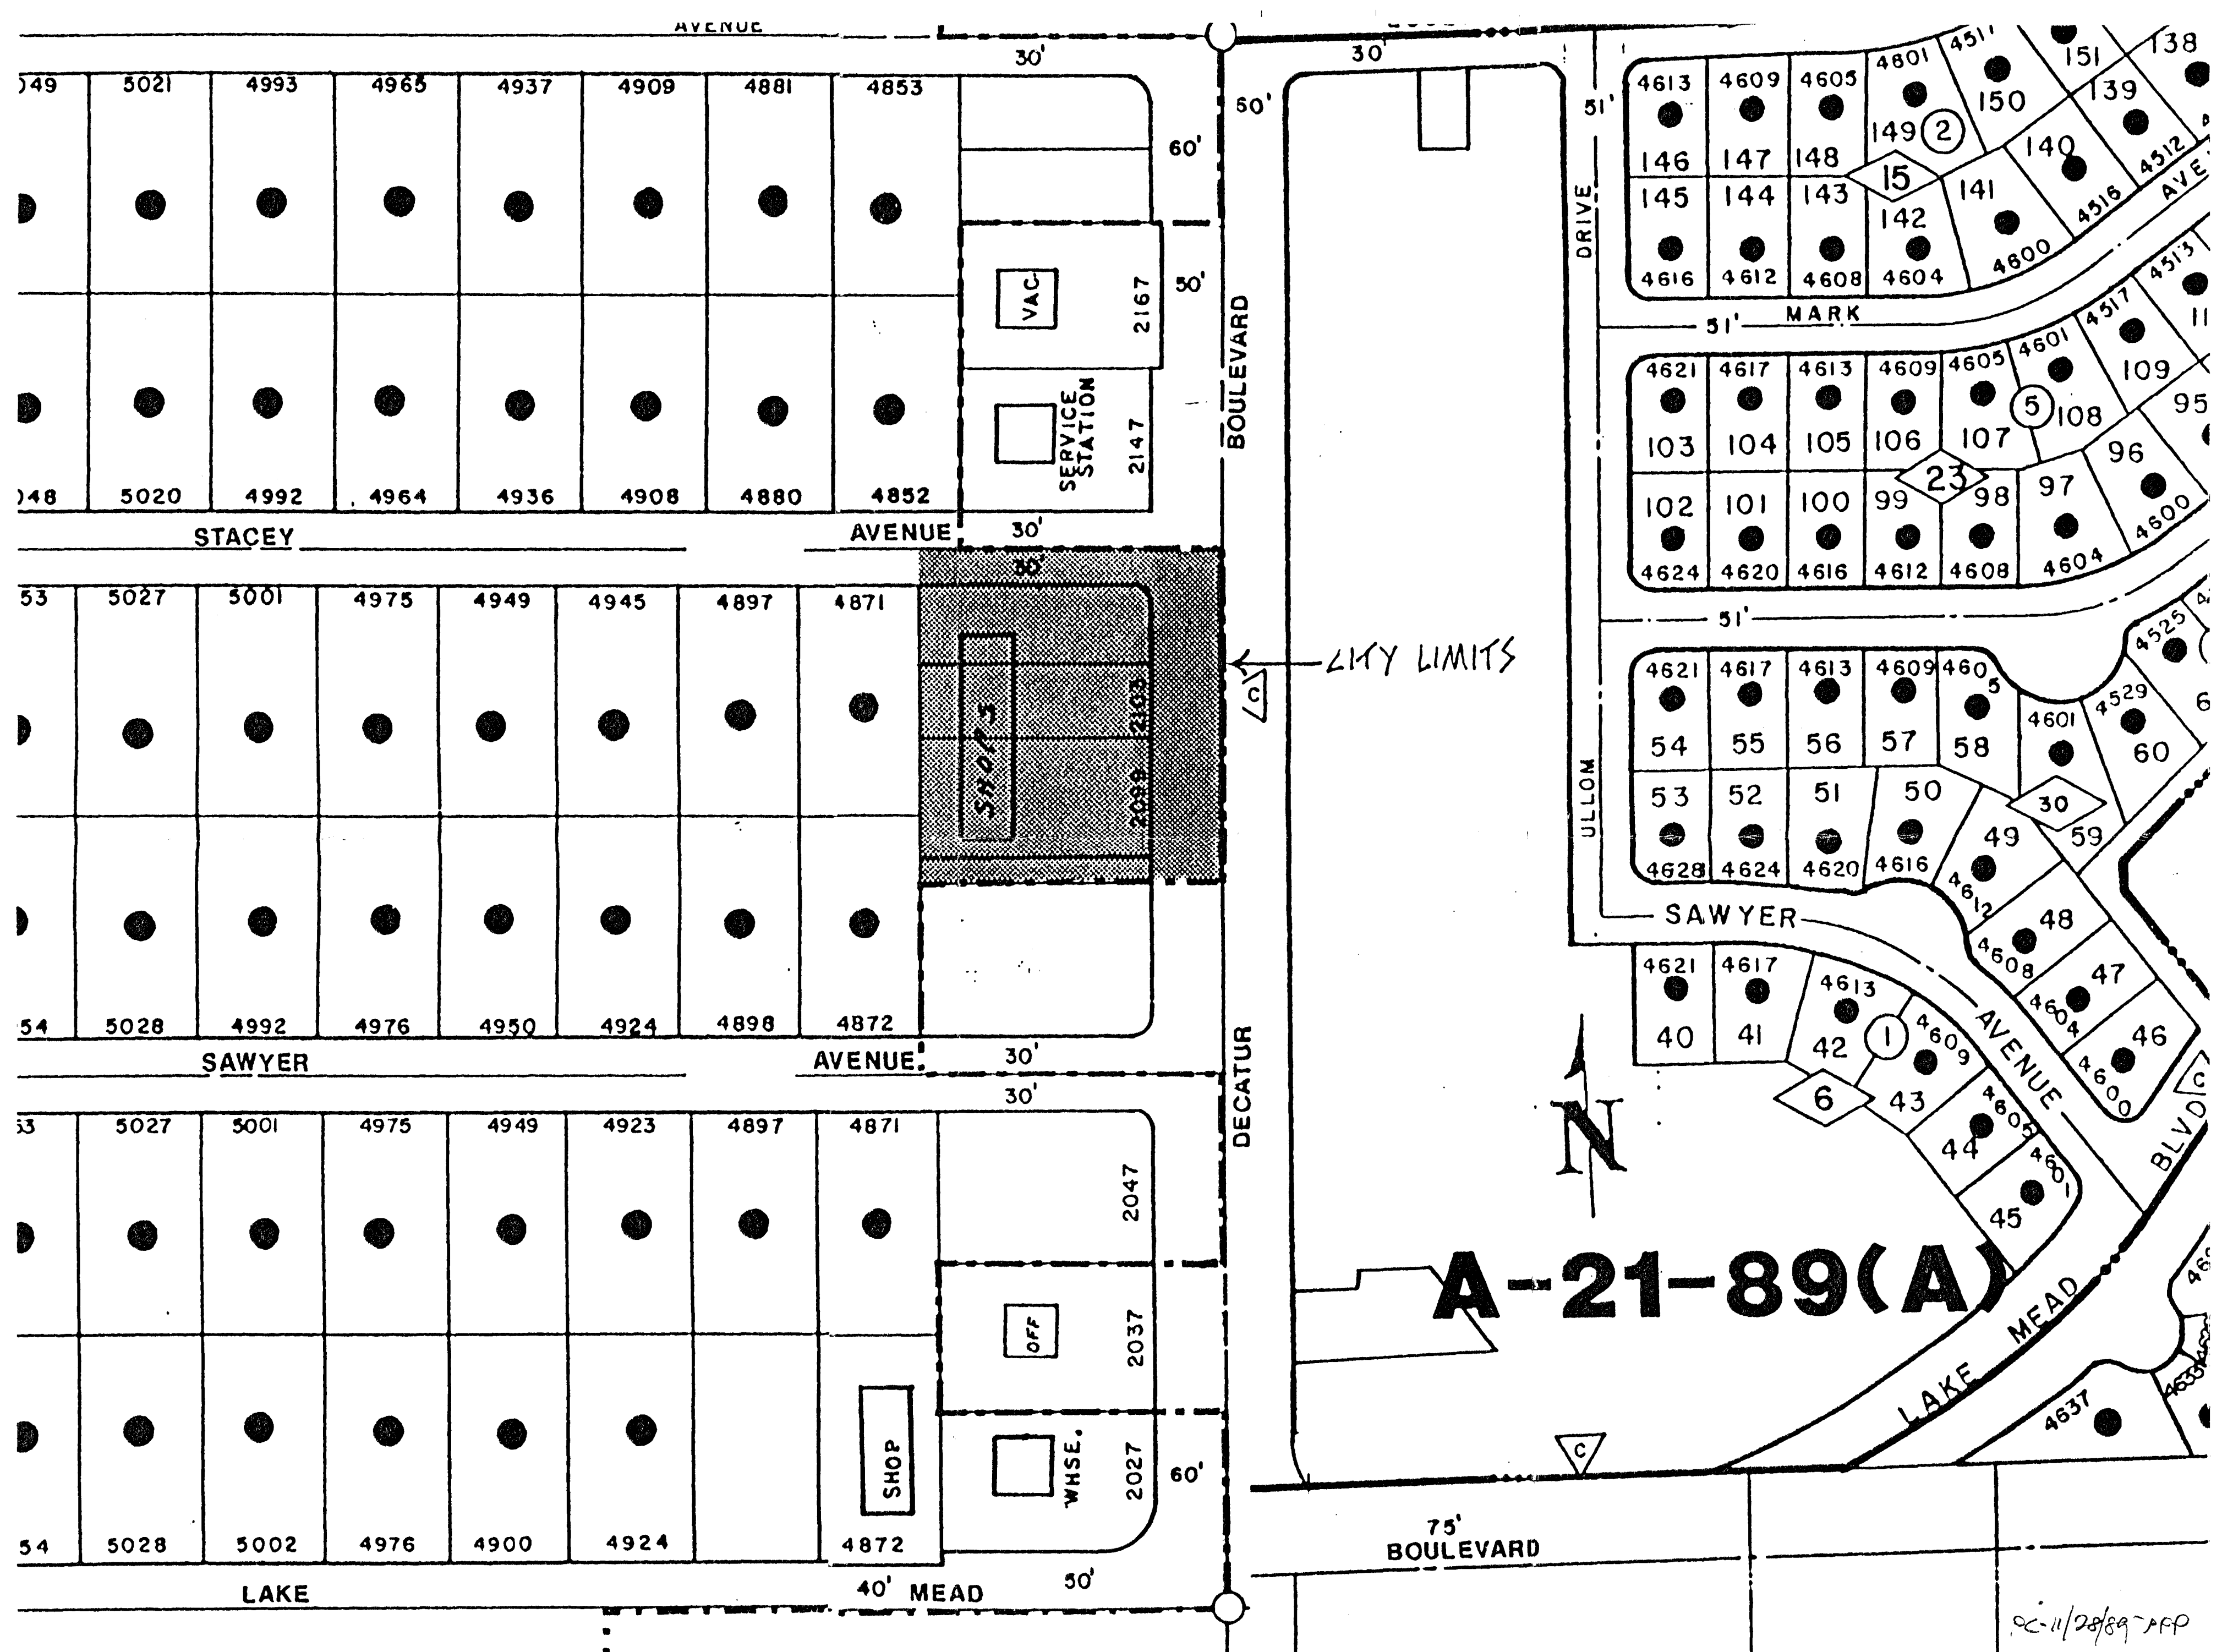

OC-11/28/89-APP